

United States Department of Agriculture



Natural Resources Conservation Service
3737 Government Street
Alexandria, LA 71302

April 8, 2002

Mr. Van Cook
Project Manager
LDNR / Coastal Restoration Division
UNO Box 1102
New Orleans, LA 70148

Mr. Tom Podany
Chief, CWPPRA Program Manager
US Army Engineer District, New Orleans
P.O. Box 60267
New Orleans, Louisiana 70506

Gentlemen:

Re: PL-646 – BA-23
Barataria Bay Waterway West Side Shoreline Protection

Enclosed are the “As Built” drawings for the referenced project.



Please direct any questions concerning this Project Completion Report to Brad Sticker at (318) 473-7791.

Sincerely,

/s/
Ed Giering, P.E.
State Conservation Engineer

Enclosure

cc: Bruce Lehto, ASTC/Water Resources, NRCS, Alexandria, LA (electronic distribution)
Britt Paul, Water Resources Planning Staff Leader, NRCS, Alexandria, LA (electronic distribution)
Dr. Bill Good, LDNR – CRD, Baton Rouge, LA (electronic distribution)
Garrett Broussard, LDNR-CRD, Baton Rouge, LA (electronic distribution)
Richard Abshire, Project Manager, NRCS, Baton Rouge, LA (electronic distribution)
Brad Sticker, Civil Engineer, NRCS, Alexandria, LA (electronic distribution)
Dale Garber, COTR, NRCS, Crowley, LA (electronic distribution)

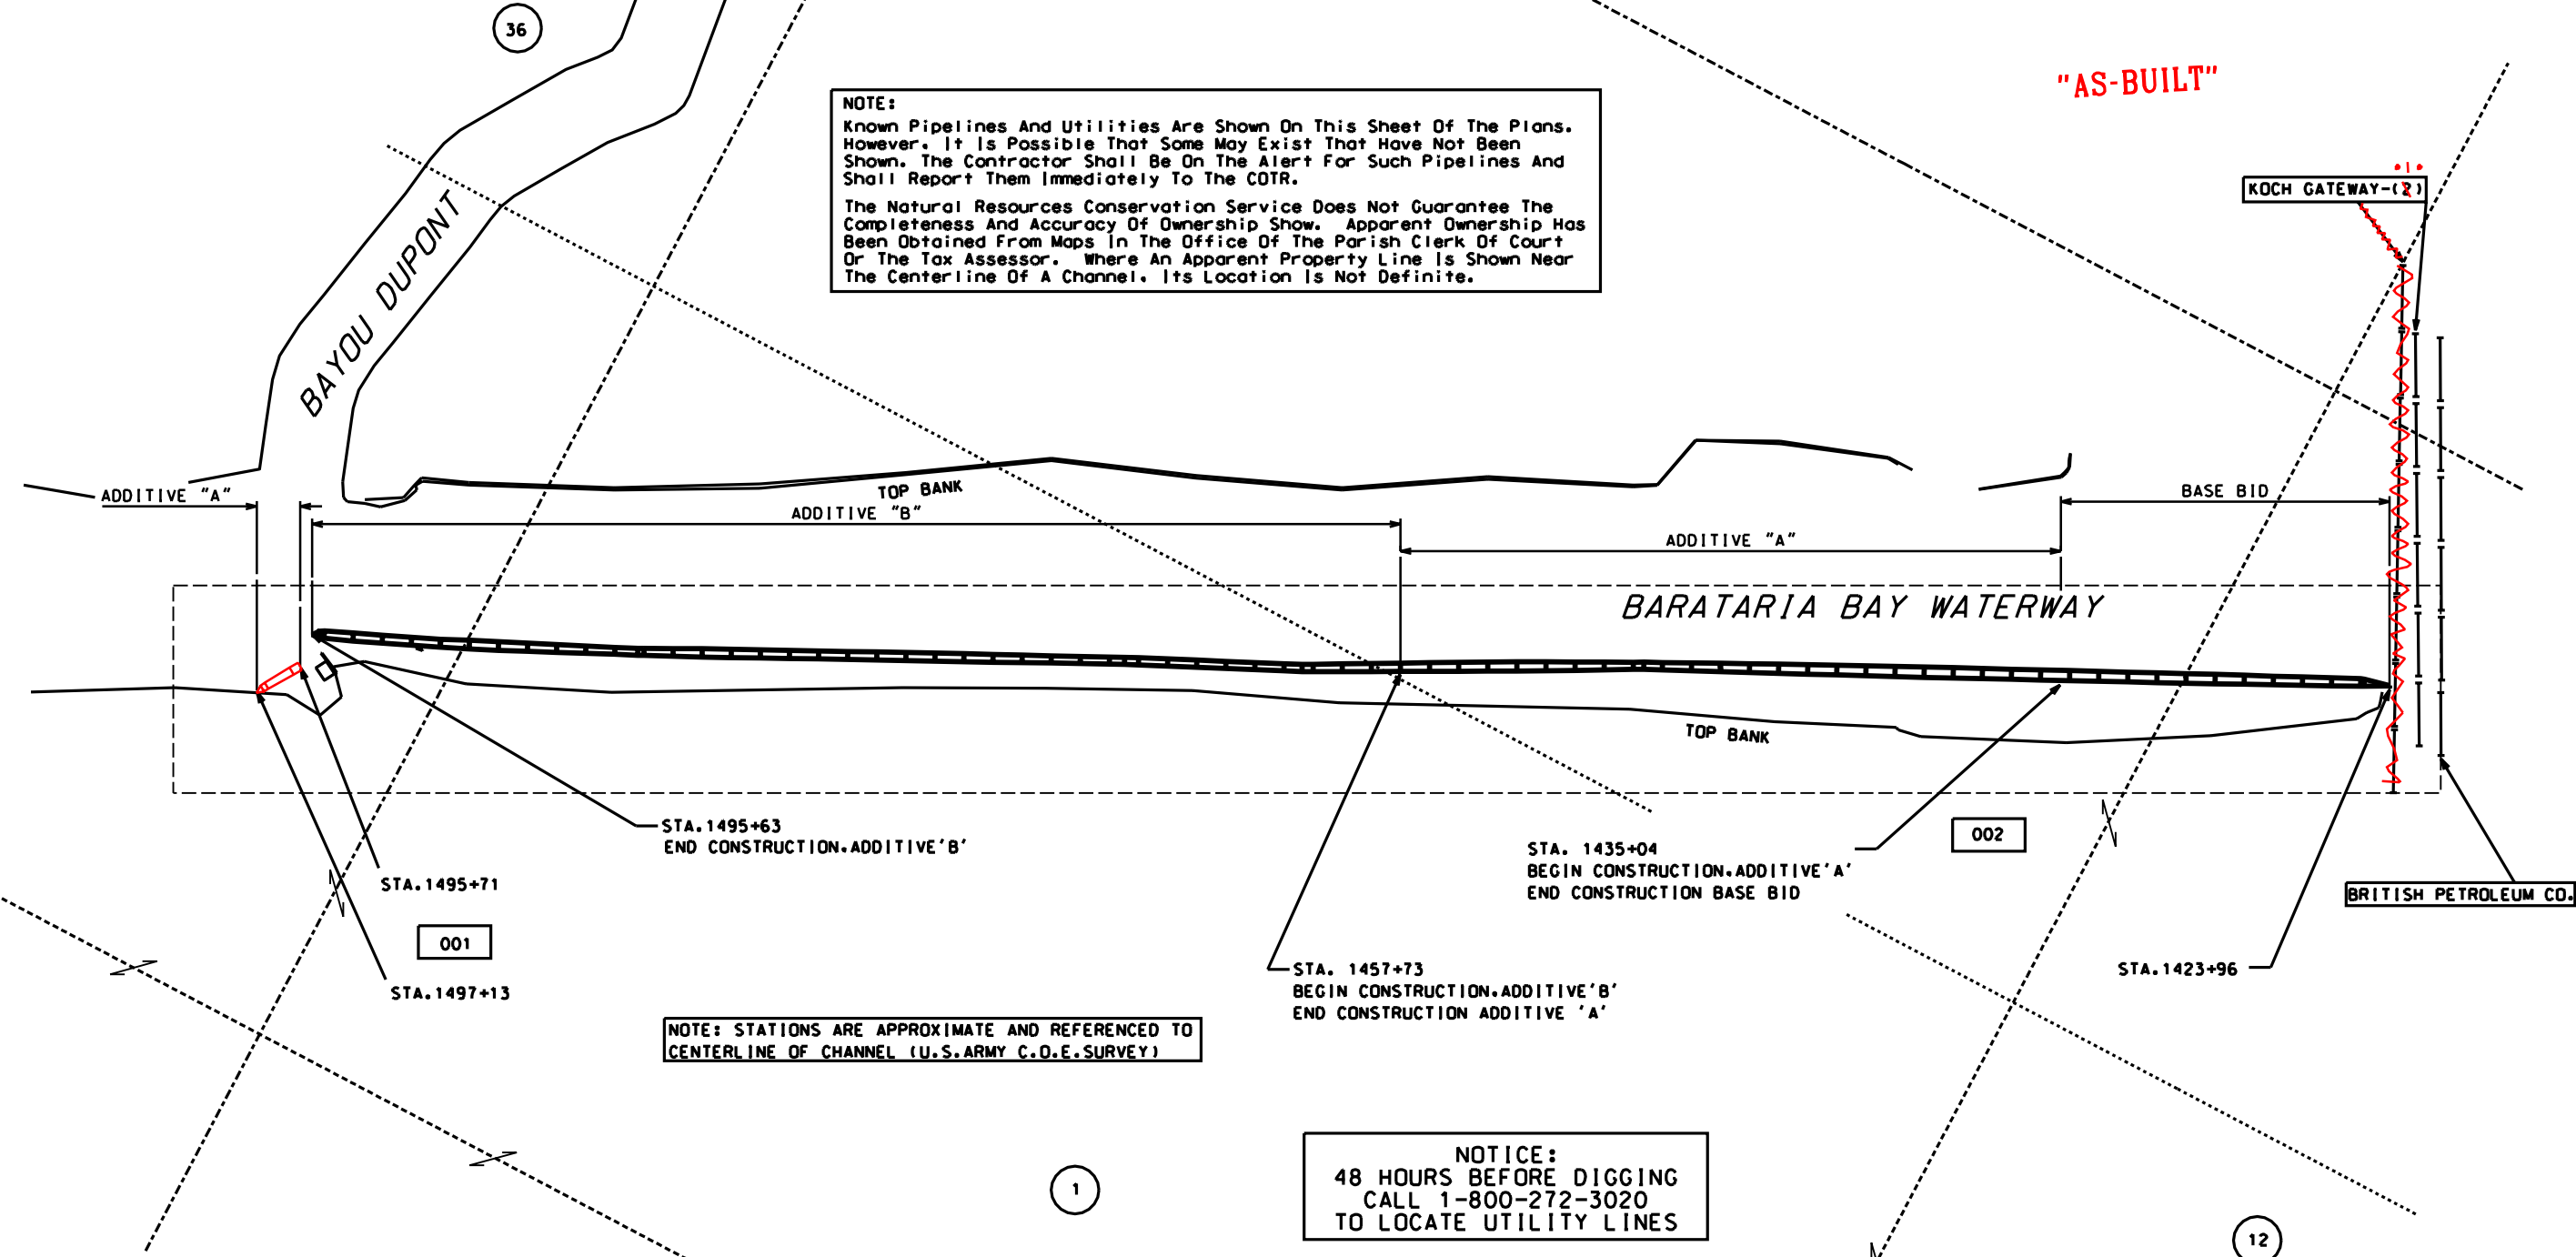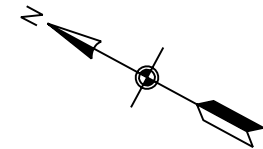

PIPELINES:
KOCH GATEWAY 1-800-850-0051
BRITISH PETROLEUM PIPELINE CO. 1-504-393-6283

LEGEND

- SECTION NO.
- TOWNSHIP BOUNDARY
- SECTION LINE
- LANDOWNER CODE
- PROPERTY BOUNDARY
- PROJECT BOUNDARY
- PIPELINE

NOTE:
Known Pipelines And Utilities Are Shown On This Sheet Of The Plans. However, It Is Possible That Some May Exist That Have Not Been Shown. The Contractor Shall Be On The Alert For Such Pipelines And Shall Report Them Immediately To The COTR.
The Natural Resources Conservation Service Does Not Guarantee The Completeness And Accuracy Of Ownership Show. Apparent Ownership Has Been Obtained From Maps In The Office Of The Parish Clerk Of Court Or The Tax Assessor. Where An Apparent Property Line Is Shown Near The Centerline Of A Channel, Its Location Is Not Definite.

NOTE: STATIONS ARE APPROXIMATE AND REFERENCED TO CENTERLINE OF CHANNEL (U.S. ARMY C.O.E. SURVEY)

LANDOWNERS:
001 - JAMES WEBB, ET AL
002 - BURLINGTON RESOURCES


Date		Approved by E.J. CIERING, III 11/99	
Designed J. CHUA		Drawn D.J. WILMORE	
Traced J. MOORE		Checked J. MOORE	
Title		Title	
State Conservation Engineer		State Conservation Engineer	
PLAN VIEW - WEST BANK ALIGNMENT BARATARIA BAY WATERWAY-WEST BANK PROJECT #PBA-12A JEFFERSON PARISH, LOUISIANA U.S. DEPARTMENT OF AGRICULTURE - NATURAL RESOURCES CONSERVATION SERVICE			
DATE	APPR.	TITLE	
CAD FILENAME LA28602.DGN			
PROJECT NO. LA286			
SHEET NO. 2 OF 16			

PIPELINES:
KOCH GATEWAY 1-800-850-0051
BRITISH PETROLEUM CO. 1-504-393-6283

**NOTICE:
48 HOURS BEFORE DIGGING
CALL 1-800-272-3020
TO LOCATE UTILITY LINES**

NOTE:
Known Pipelines And Utilities Are Shown On This Sheet Of The Plans. However, It Is Possible That Some May Exist That Have Not Been Shown. The Contractor Shall Be On The Alert For Such Pipelines And Shall Report Them Immediately To The COTR.
The Natural Resources Conservation Service Does Not Guarantee The Completeness And Accuracy Of Ownership Show. Apparent Ownership Has Been Obtained From Maps In The Office Of The Parish Clerk Of Court Or The Tax Assessor. Where An Apparent Property Line Is Shown Near The Centerline Of A Channel, Its Location Is Not Definite.

LEGEND

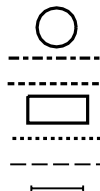

- SECTION NO.
- TOWNSHIP BOUNDARY
- SECTION LINE
- LANDOWNER CODE
- PROPERTY BOUNDARY
- PROJECT BOUNDARY
- PIPELINE

"AS-BUILT"

REVISIONS DATE APPR. TITLE 		PLAN VIEW - WEST BANK ALIGNMENT BARATARIA BAY WATERWAY-WEST BANK PROJECT #PBA-12A JEFFERSON PARISH, LOUISIANA		Date 05/99	
CAD FILENAME LA28603.DGN		PROJECT NO. LA286		Approved by E.J. GIERING, III 11/99	
SHEET NO. 3 OF 16		U.S. DEPARTMENT OF AGRICULTURE - NATURAL RESOURCES CONSERVATION SERVICE		Title STATE CONSERVATION ENGINEER	
		Designed J. CHUA		Date 05/99	
		Drawn D.J. WILLMORE		Title STATE CONSERVATION ENGINEER	
		Traced		Date 05/99	
		Checked J. MOORE		Title STATE CONSERVATION ENGINEER	

PLAN VIEW - WEST BANK ALIGNMENT
BARATARIA BAY WATERWAY-WEST BANK
PROJECT #PBA-12A
JEFFERSON PARISH, LOUISIANA
CULTURE - NATURAL RESOURCES CONSERVATION SERVICE

[illegible]

CAD FILENAME
LA28603.DGN
PROJECT NO.
LA286
SHEET NO. 3 OF 16

LANDOWNER:
002 - BURLINGTON RESOURCES

A horizontal number line labeled "SCALE IN FEET" is shown. The line has tick marks at 400, 0, 400, 800, 1200, and 1600. The segments between the tick marks are of equal length, representing 400 feet each.

T17S,R24E
SECTION 18

BARATARIA BAY WATERWAY

"AS-BUILT"

**EXISTING STRUCTURE TO
BE REMOVED**

OILFIELD LOCATION CANAL

ACCESS

ACCESS CHANNEL TO HAVE THE MINIMUM DIMENSIONS
AS SHOWN ON TYPICAL X-SECTION A-A ON SHEET 6


APPROXIMATE CHANNEL LENGTH - 1400'

PROJECT SITE

**PROPOSED
STRUCTURE LOCATION**

**NOTICE:
48 HOURS BEFORE DIGGING
CALL 1-800-272-3020
TO LOCATE UTILITY LINES**


SITE PLAN - WATER CONTROL STR.
BARATARIA BAY WATERWAY-WEST BANK
PROJECT #PBA-12A
JEFFERSON PARISH, LOUISIANA
RICULTURE - NATURAL RESOURCES CONSERVATION SERVICE

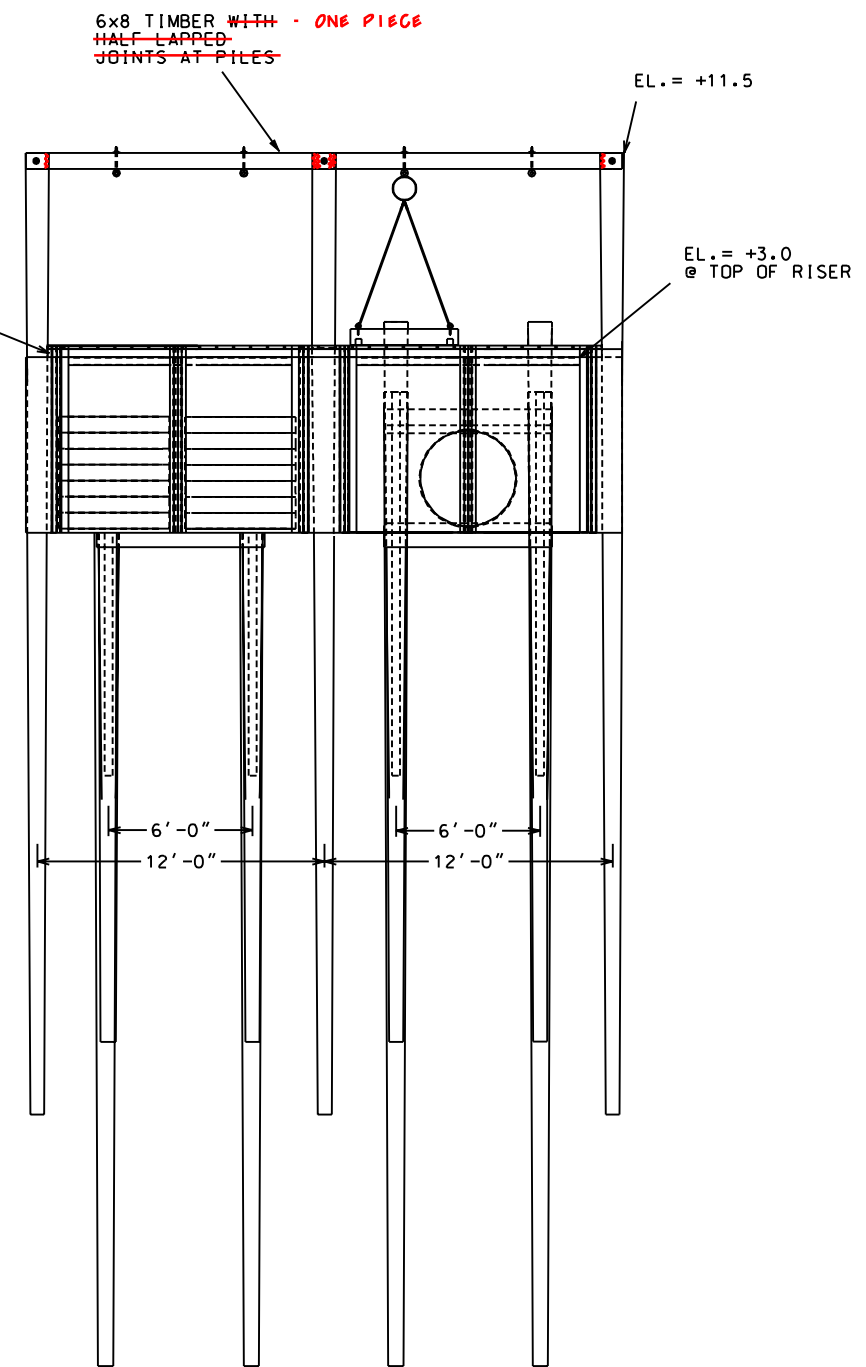


"AS-BUILT"

FRONT VIEW


...\\AS-BUILT\\drawings\\LA28605.DGN 04/02/02 02:54:59 PM

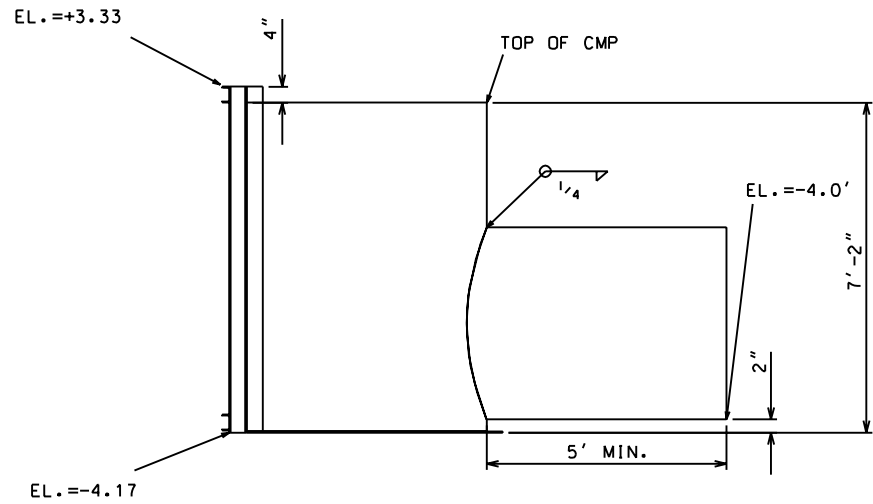


SIDE VIEW
HALF-ROUND STRUCTURE

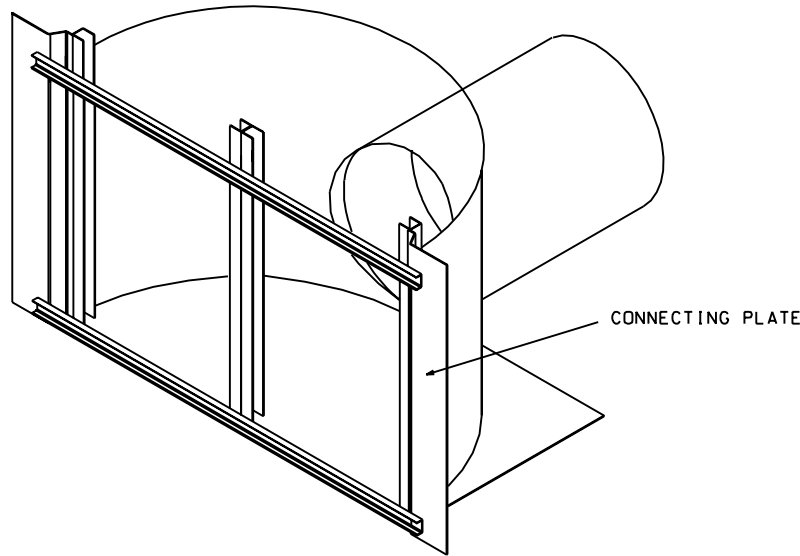

ISOMETRIC VIEW
HALF-ROUND STRUCTURE

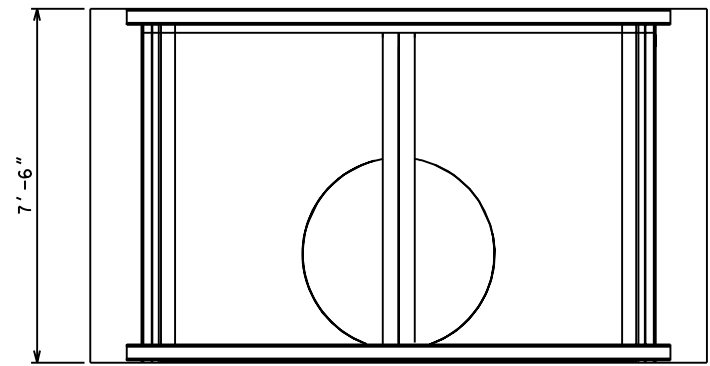


FRONT VIEW
HALF-ROUND STRUCTURE

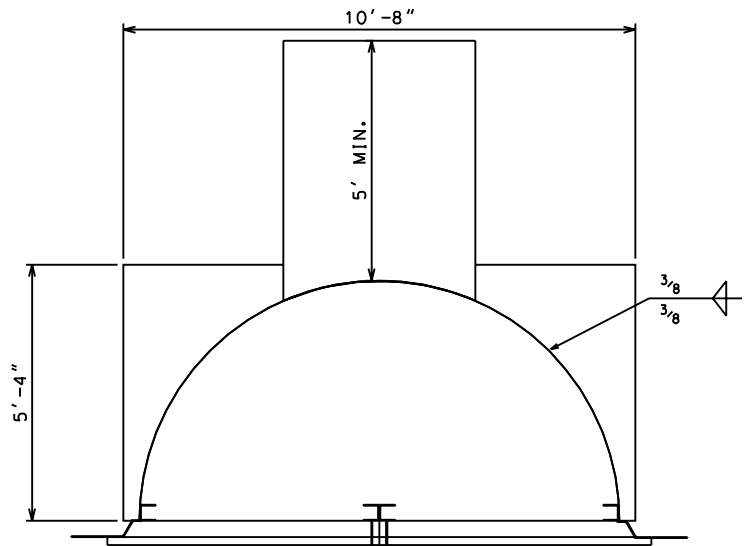



PLAN VIEW
HALF-ROUND STRUCTURE

"AS-BUILT"


REVISIONS		HALF-ROUND CONTROL STRUCTURE BARATARIA BAY WATERWAY-WEST BANK PROJECT #PBA-12A JEFFERSON PARISH, LOUISIANA			
DATE	APPR.	TITLE	DESIGNED	DRAWN	DATE
			J. CHUA	H. MOORE	05/99
					05/98
					05/99
U.S. DEPARTMENT OF AGRICULTURE - NATURAL RESOURCES CONSERVATION SERVICE		U.S. DEPARTMENT OF AGRICULTURE - NATURAL RESOURCES CONSERVATION SERVICE			
CAD FILENAME		LA28608.DGN			
PROJECT NO.		LA286			
SHEET NO.		8 OF 16			
APPROVED BY		E. J. GIERING, III, 11/99			
TITLE		STATE CONSERVATION ENGINEER			
DATE		05/99			
DESIGNED		J. CHUA			
DRAWN		H. MOORE			
CHECKED		J. MOORE			
TITLE					

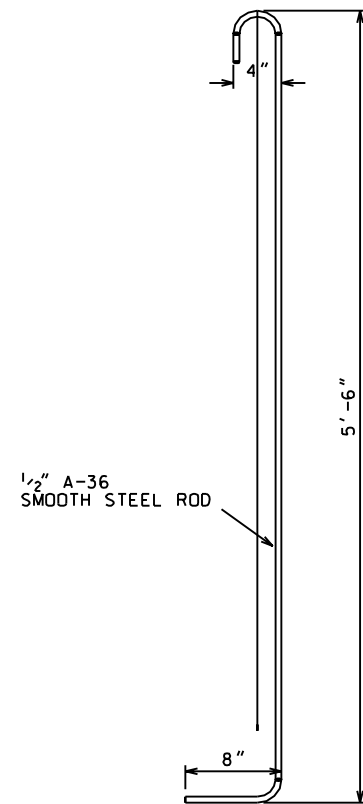

LIFT ROD
(2 REQUIRED)

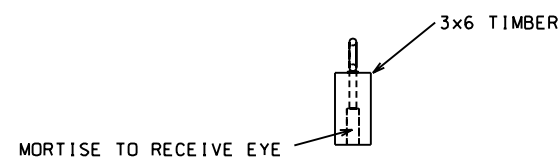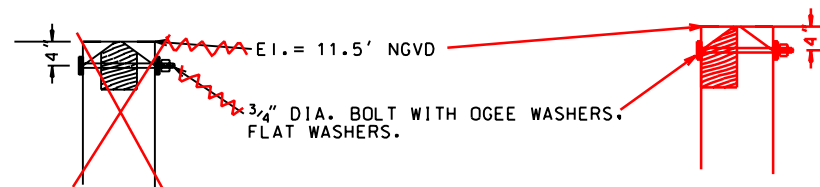


```
STOP LOG
END
```

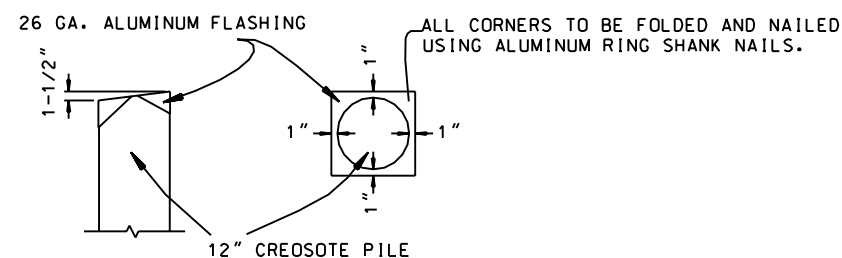


DETAILS OF SHEET METAL FLASHING (ALL PILES)

(FLASHING TO BE TWO (2) INCHES LARGER
THAN TOP OF PILE)

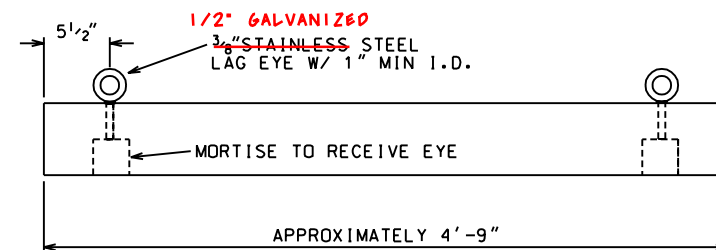

STOP LOG
FRONT

(14 REQUIRED PER RISER)

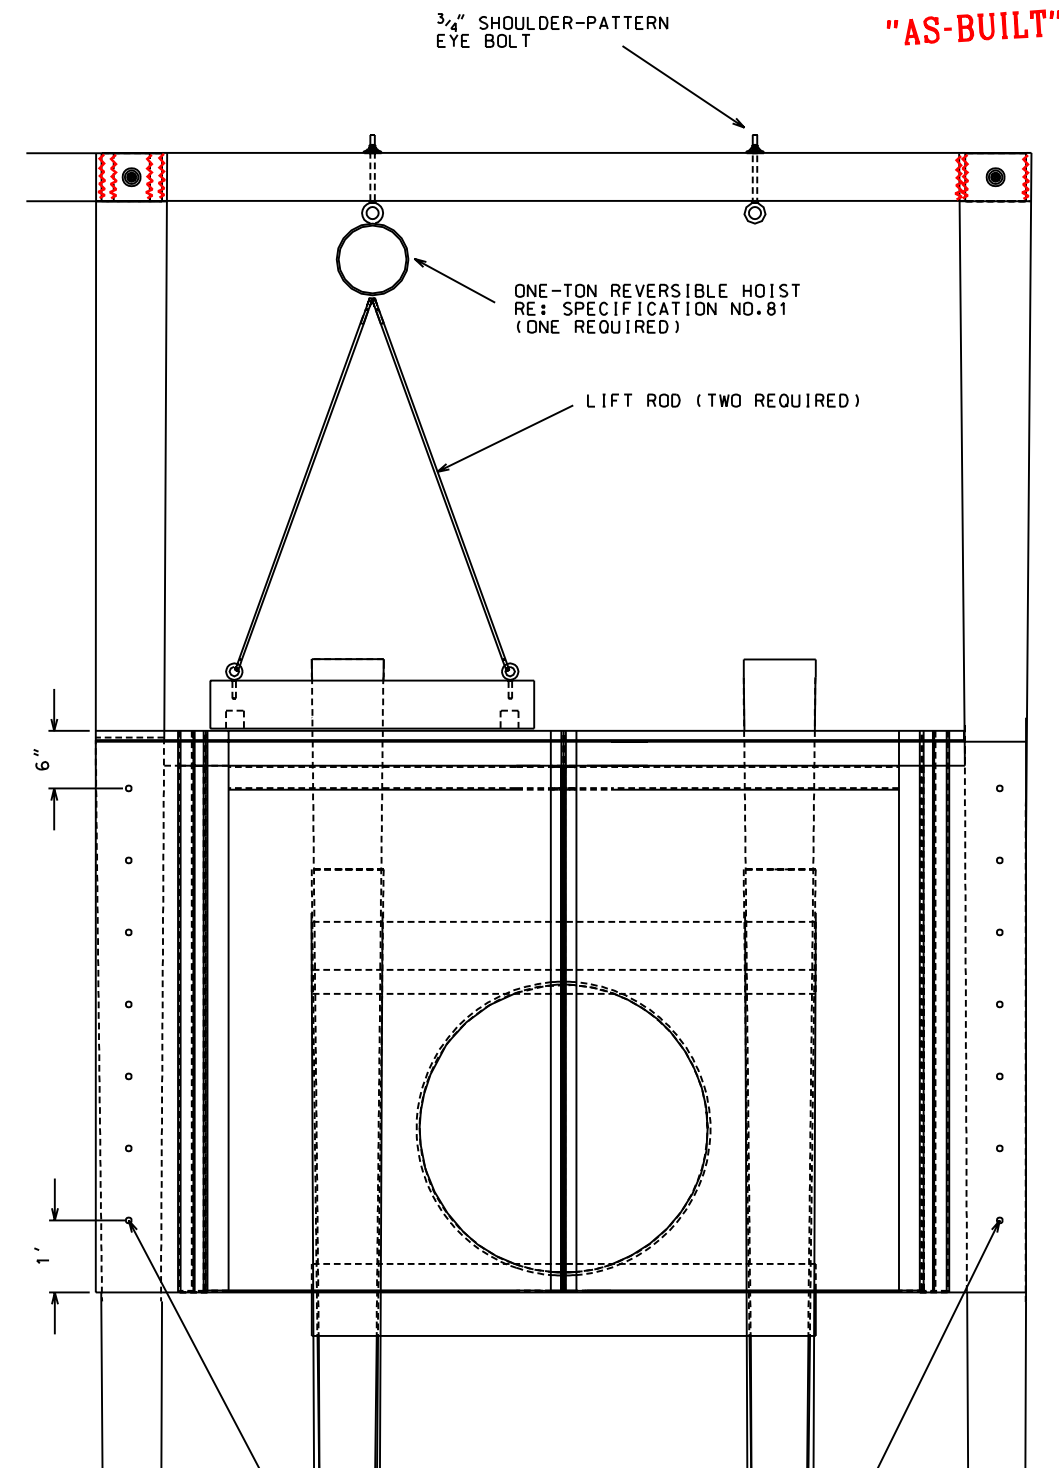


7- 1" DIAMETER HOT- DIPPED GALVINIZED BOLT W/
FLAT WASHER AND O.G. WASHER PER ATTACHMENT PLATE


- NOTES:
1. STOP LOGS SHALL BE CUT TO FIT IN FIELD
 2. FOR EYE BOLTS WITH NON-CONTINUOUS EYE, GAP SHALL BE CLOSED BY WELDING
 3. ATTACHMENT BOLT HOLES TO BE FIELD DRILLED

NOT TO SCALE

[illegible]

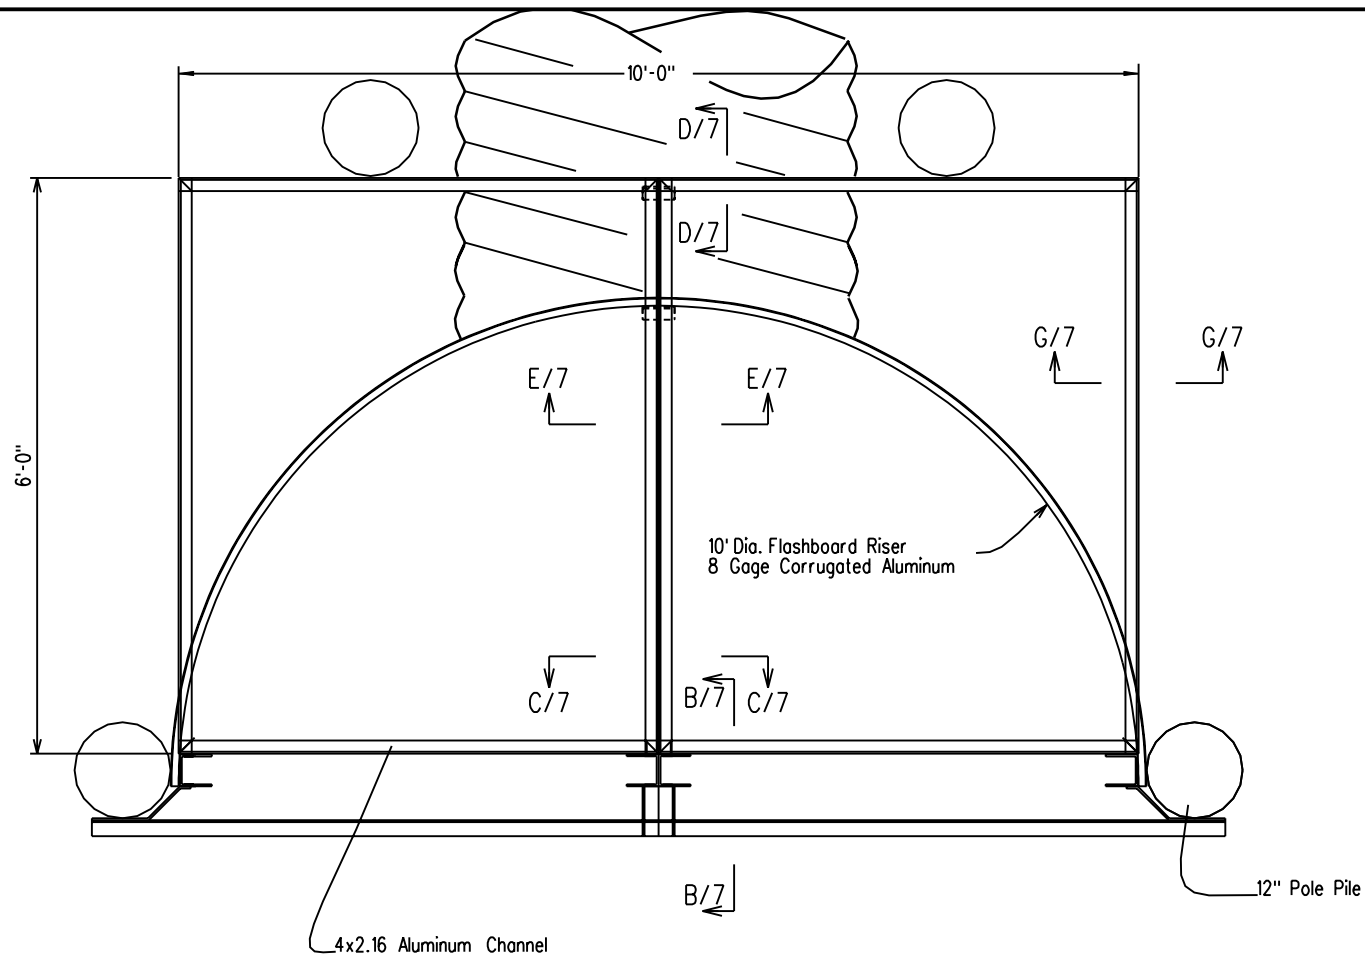


PLAN - WALKWAY PLATFORM

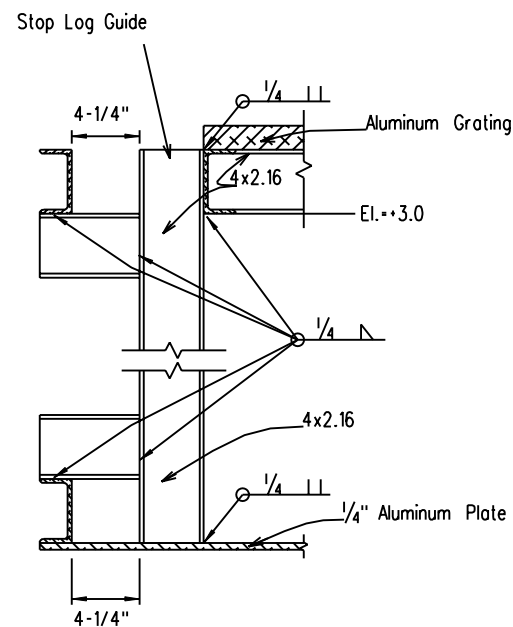

SECTION "B-B/7"


(Not To Scale)

All Aluminum Channels Shall
Be 4x2 x 1/4 (6061-T6).
(With 4" Slot)
And Are Designated On This
Sheet As 4x2.16

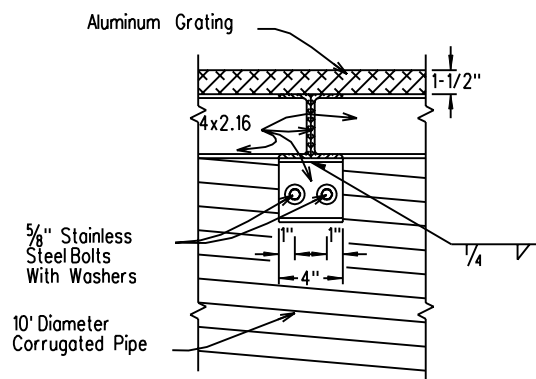


SECTION "E-E/7"

(Not To Scale)

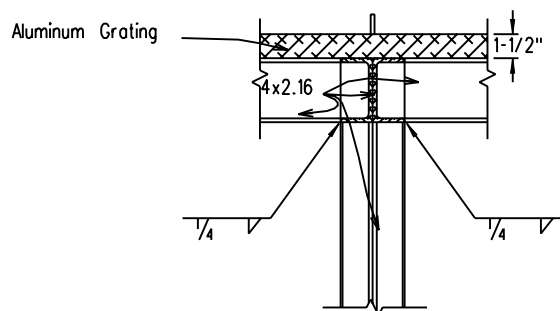



SECTION "C-C/7"

(Not To Scale)

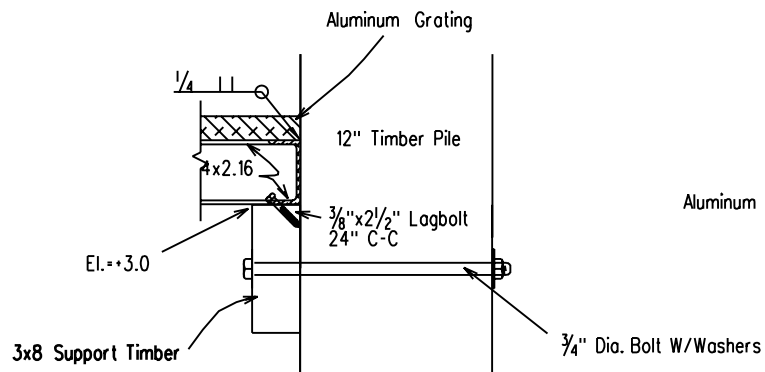


SECTION "D-D/7"

(Not To Scale)

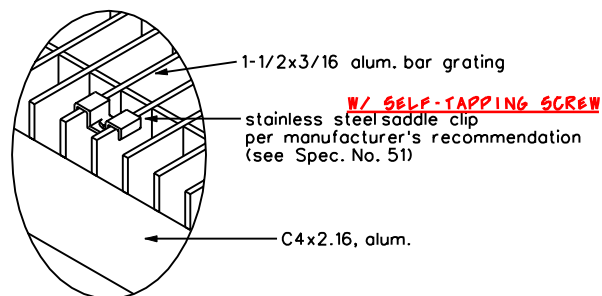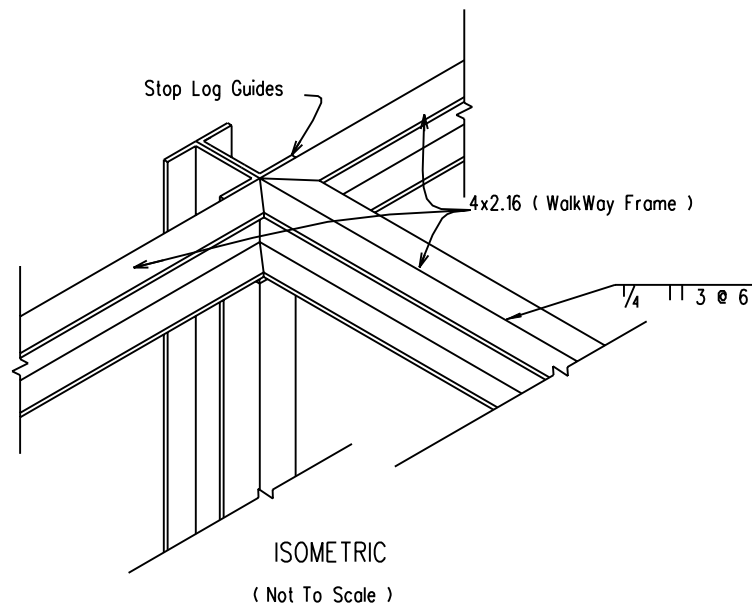


"AS-BUILT"

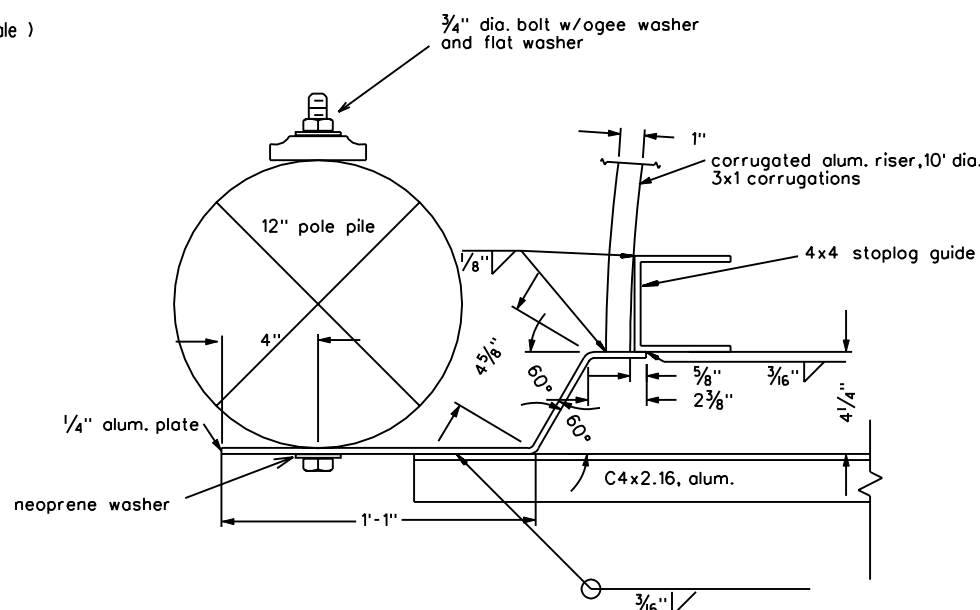

PILE, PLATE & RISER CONNECTION DETAIL

NOTE:
Cross Member And 1/4" Aluminum
Plate Not Shown For Clarity

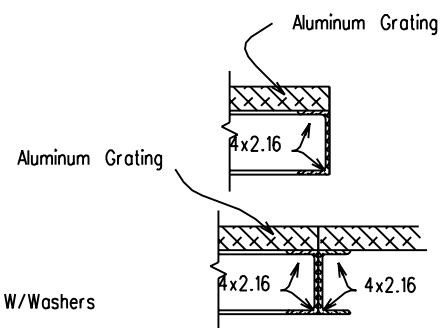


SECTION "G-G/7"

INSIDE TO INSIDE


(Not To Scale)

DATE		REVISIONS		RISER PLATFORM DETAILS		Date	
	APPR.		TITLE	BARATARIA BAY WATERWAY - WEST BANK		Approved by	11/99
				PROJECT #PBA-12A		Title	STATE CONSERVATION
				JEFFERSON PARISH, LOUISIANA		ENGINEER	

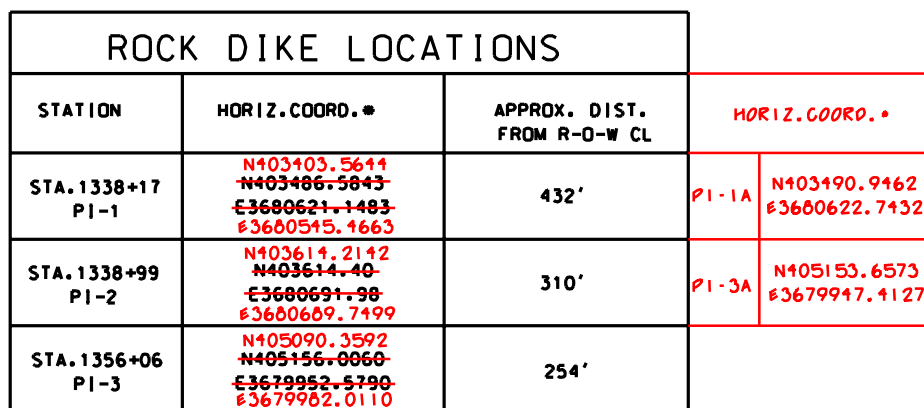

"AS-BUILT"

●NOTE: NAD83 DATUM

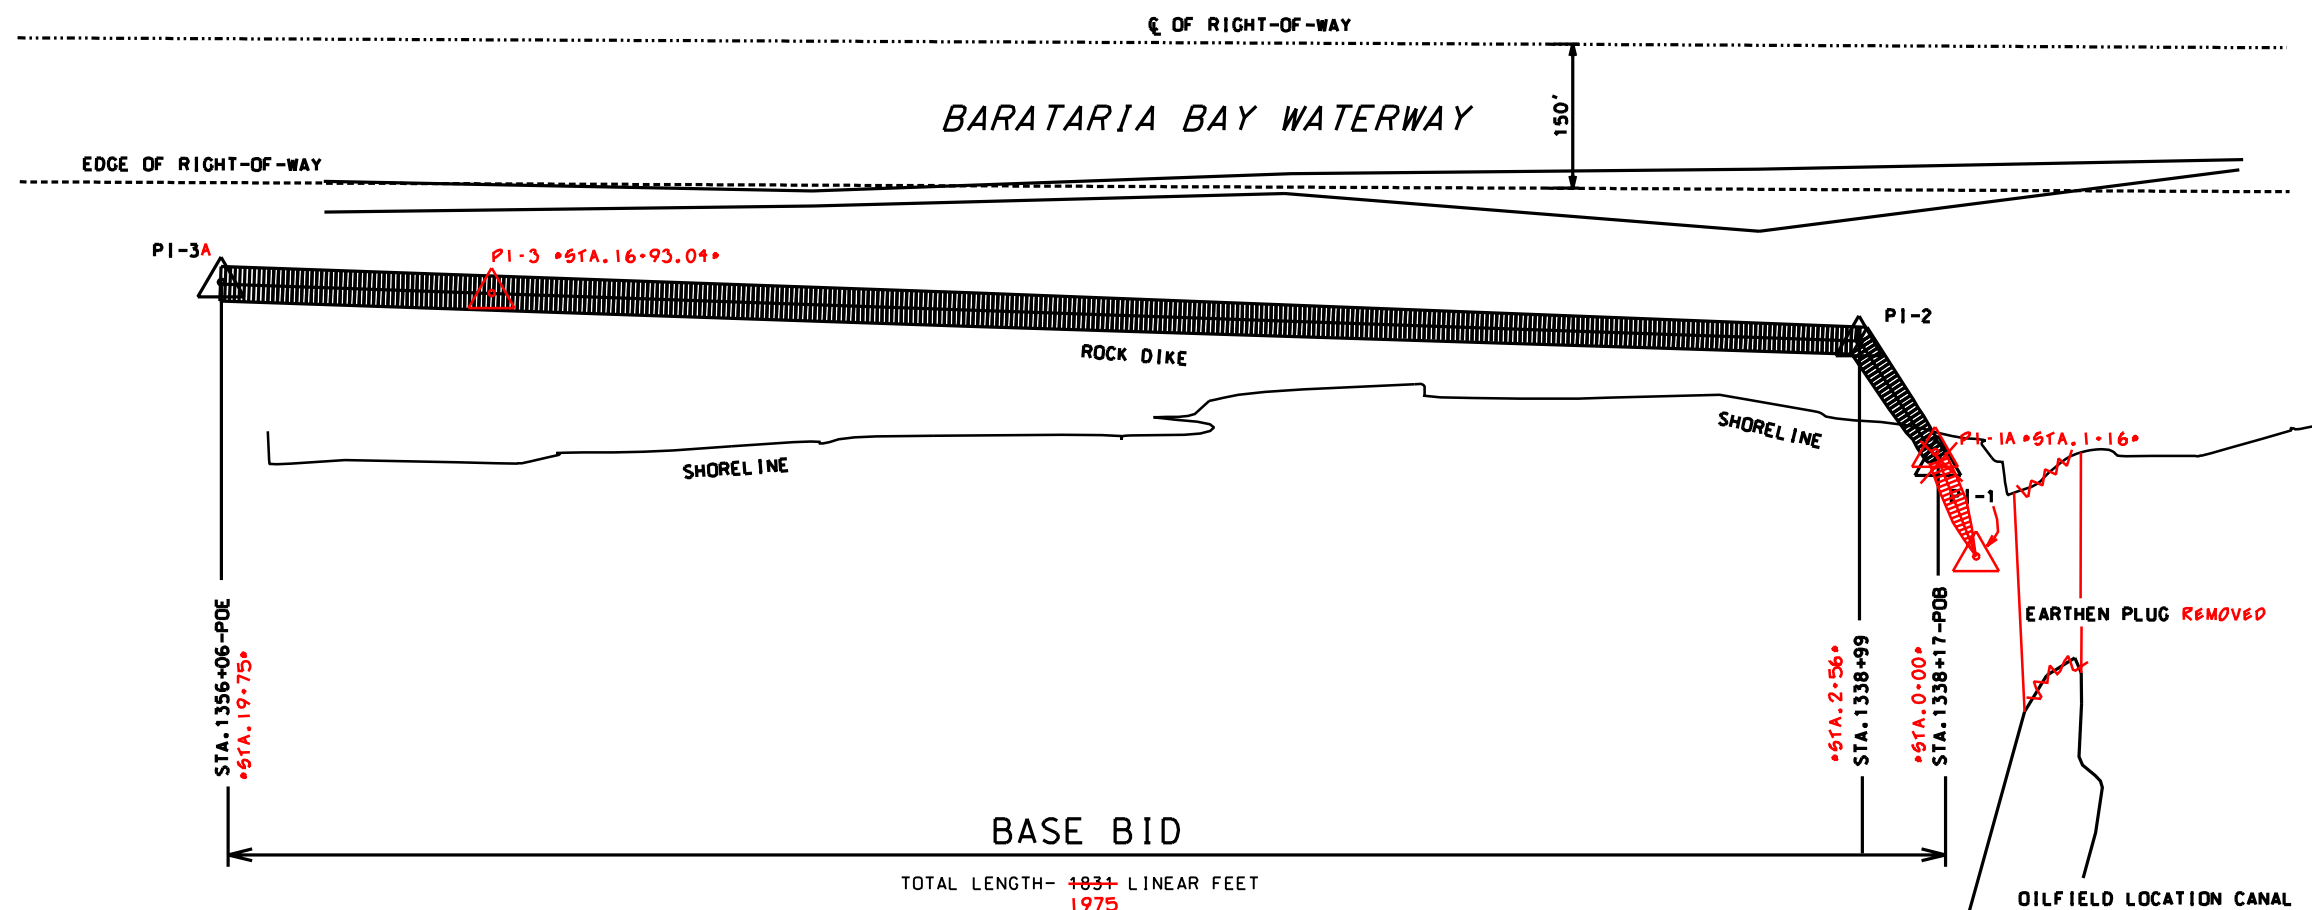


CONSTRUCTION AT PI-3 TO BE TIED INTO EXISTING DIKE AS STAKED BY COTR.
TIE-IN LOCATED AT STA.1356+06 ON U.S.ARMY CORPS OF ENG. DREDGE SURVEY
CONSTRUCTION AT PI-1 TO BE TIED INTO EXISTING BANK AS STAKED BY COTR.

NOTE:

STATIONING SHOWN IN RED CORRESPONDS TO CONSTRUCTION
STATIONING AND WITH THE STATIONS SHOWN ON THE
SUPPLEMENTAL PROFILE AND CROSS SECTION SHEETS
•SHEETS 16A1 THROUGH 16A6 OF 16•

REVISIONS <table><thead><tr><th>DATE</th><th>APPR.</th><th>TITLE</th></tr></thead><tbody><tr><td> </td><td> </td><td> </td></tr><tr><td> </td><td> </td><td> </td></tr><tr><td> </td><td> </td><td> </td></tr><tr><td> </td><td> </td><td> </td></tr><tr><td> </td><td> </td><td> </td></tr></tbody></table>			DATE	APPR.	TITLE																PLAN-DIKE, STA. 1338+17-ST.A. 1356+06 BARATARIA BAY WATERWAY-WEST BANK PROJECT #PBA-12A JEFFERSON PARISH, LOUISIANA			<table><tr><td>Date</td><td colspan="2">Date</td><td>Date</td></tr><tr><td>Approved by E.J. GIERING III</td><td>Designed J. CHUA</td><td>05/99</td><td>11/99</td></tr><tr><td>Title STATE CONSERVATION ENGINEER</td><td>Drawn D. J. WILMORE</td><td>05/99</td><td></td></tr><tr><td></td><td>Traced</td><td></td><td></td></tr><tr><td>Title</td><td>Checked J. MOORE</td><td>05/99</td><td></td></tr></table>			Date	Date		Date	Approved by E.J. GIERING III	Designed J. CHUA	05/99	11/99	Title STATE CONSERVATION ENGINEER	Drawn D. J. WILMORE	05/99			Traced			Title	Checked J. MOORE	05/99	
DATE	APPR.	TITLE																																												
Date	Date		Date																																											
Approved by E.J. GIERING III	Designed J. CHUA	05/99	11/99																																											
Title STATE CONSERVATION ENGINEER	Drawn D. J. WILMORE	05/99																																												
	Traced																																													
Title	Checked J. MOORE	05/99																																												
CAD FILENAME LA28612.DGN			U.S. DEPARTMENT OF AGRICULTURE - NATURAL RESOURCES CONSERVATION SERVICE																																											
PROJECT NO. LA286																																														
SHEET NO. 12 OF 16																																														

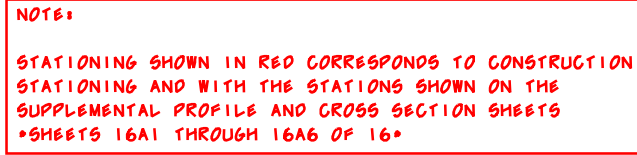


A horizontal number line labeled "SCALE IN FEET" is shown. The line has markings at 200, 0, 200, 400, 600, and 800. The markings are evenly spaced, with 0 in the center and 200 on either side. The line extends from 200 on the left to 800 on the right.


"AS-BUILT"

NOTE:
DIKE WILL BE TIED INTO EXISTING ROCK @ PI-5, PI-4
& PI-4B AS STAKED IN THE FIELD BY COTR

Designed	J. CHUA	05/99	Date
Drawn	D. J. WILLMORE	05/99	Approved by E. L. GIERING, III
Traced			Title
Checked	J. MOORE	05/99	STATE CONSERVATION ENGINEER

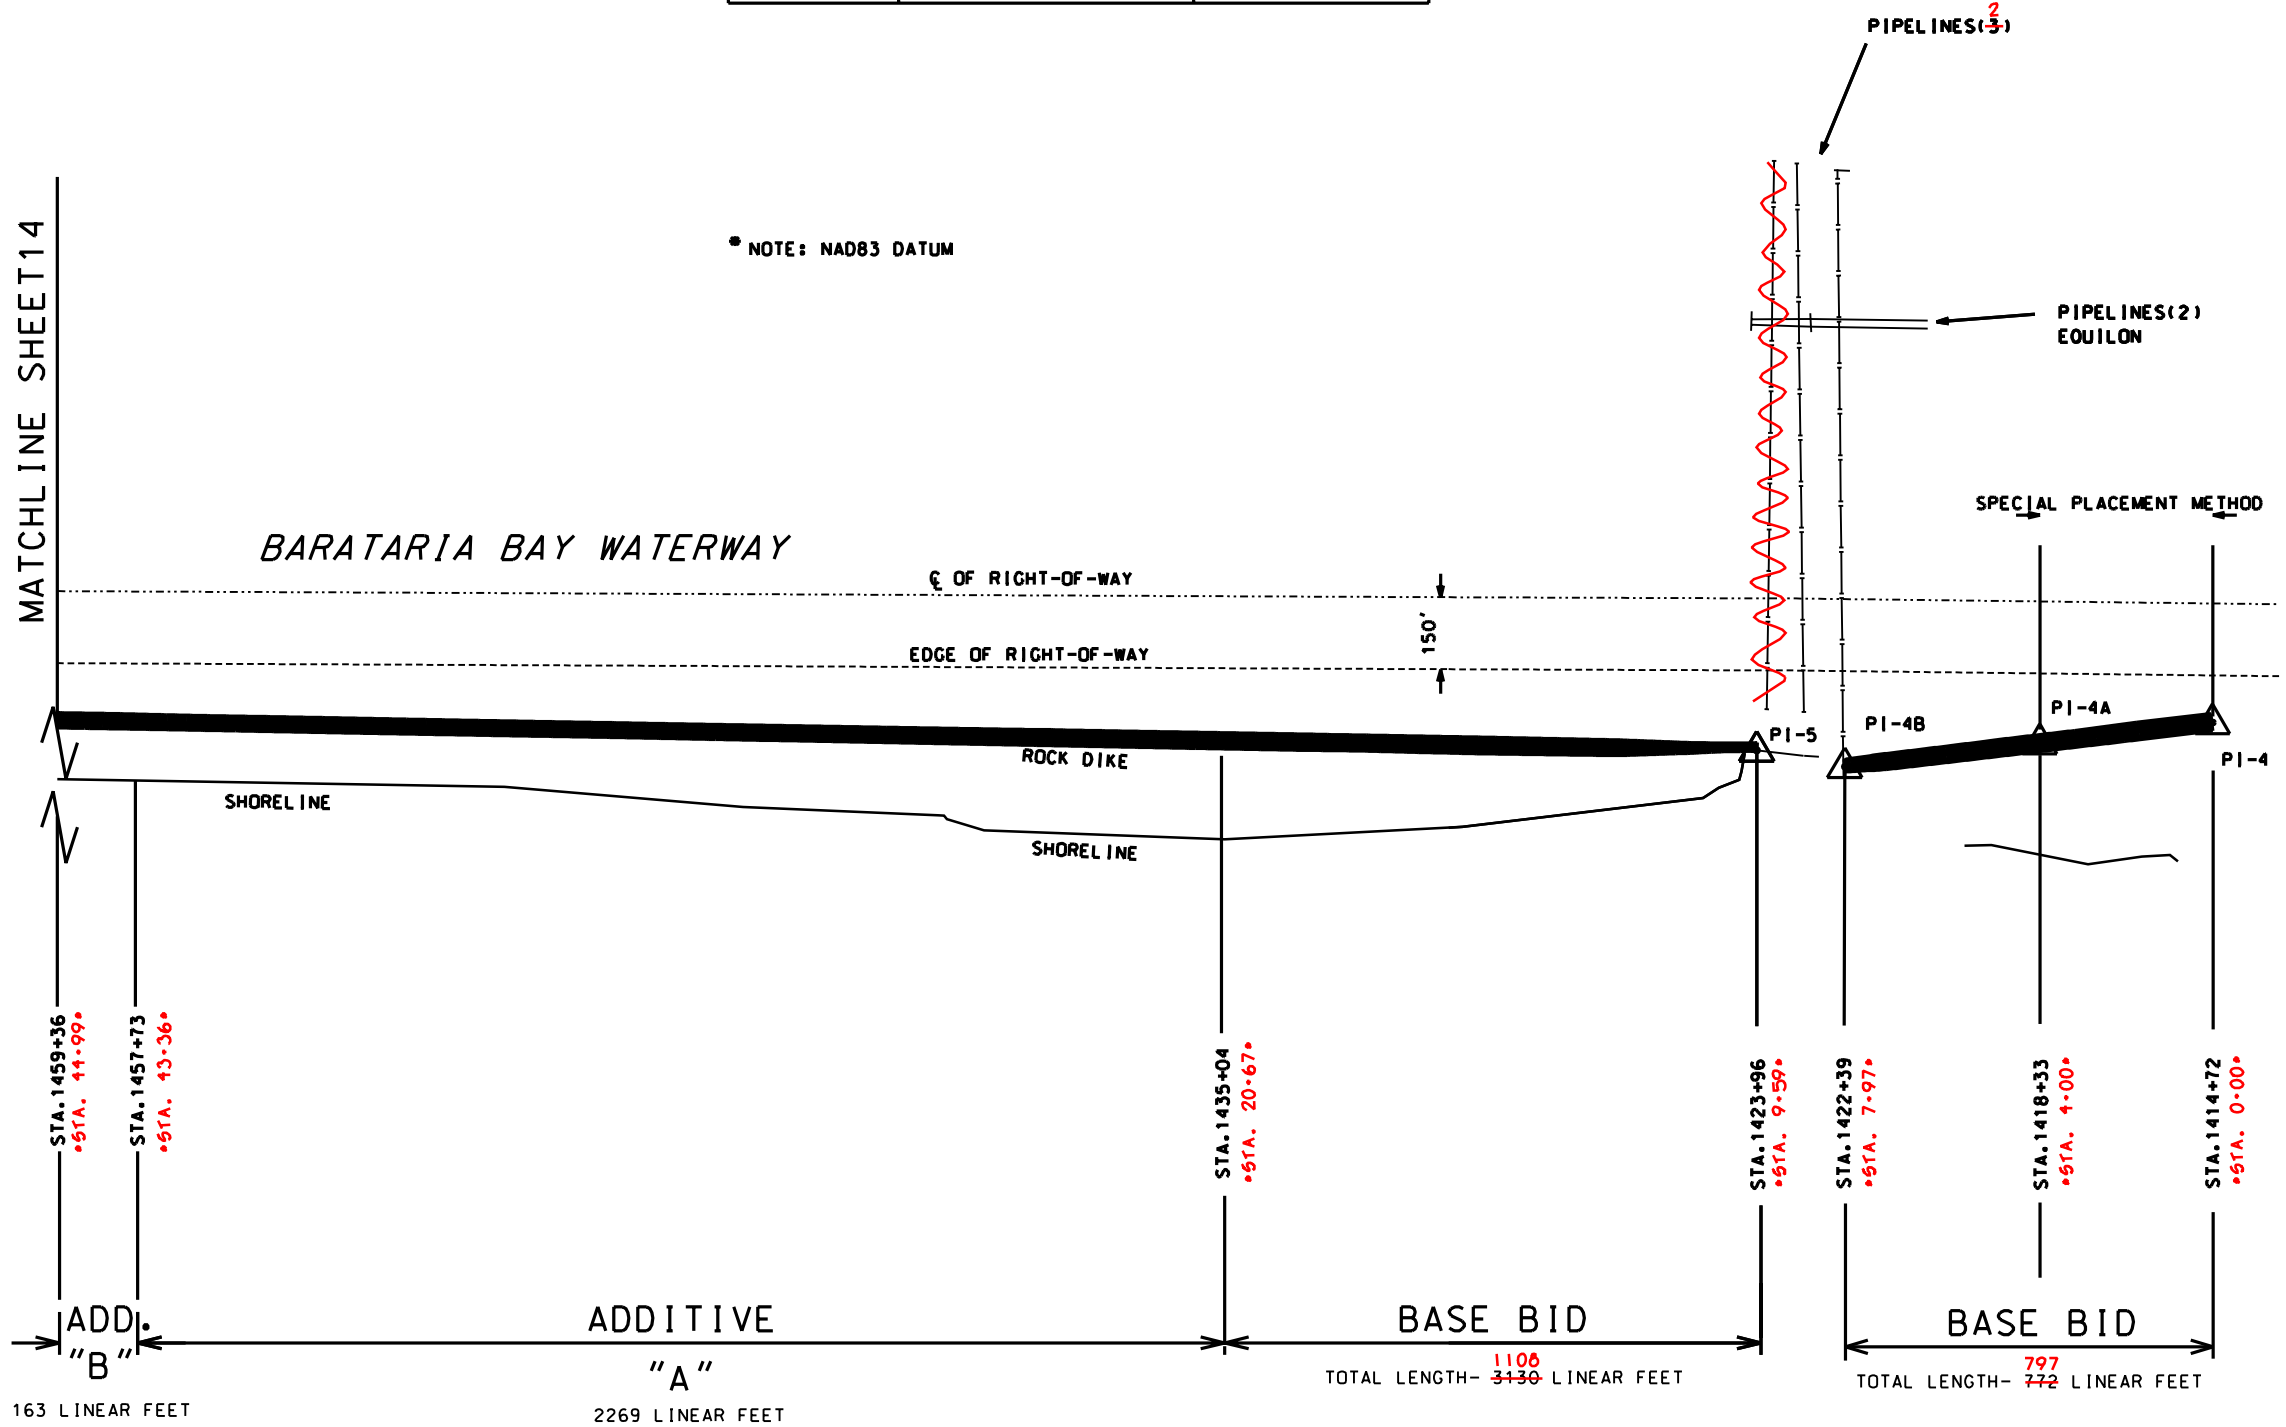

CAD FILENAME LA28613.DGN		PLAN-DIKE, STA. 1414+33 - STA. 1459+36 BARATARIA WATERWAY - WEST BANK PROJECT #PBA-12A JEFFERSON PARISH, LOUISIANA
PROJECT NO. LA286		
SHEET NO. 13 OF 16		
DATE	APPR.	
TITLE		
U.S. DEPARTMENT OF AGRICULTURE - NATURAL RESOURCES CONSERVATION SERVICE		

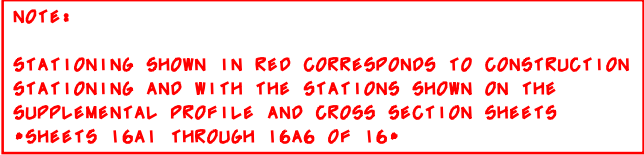


ROCK DIKE LOCATIONS		
STATION	HORIZ. COORD. ●	APPROX. DIST. FROM R-O-W CL
STA. 1492+47 PI-6	N417201.46 N417201.71 E3673642.86 E3673646.42	207'
STA. 1492+67 PI-7	N417197.80 N417198.36 E3673594.30 E3673596.31	251'
STA. 1494+02 PI-8	N417283.34 N417332.02 E3673553.35 E3673565.69	223'
STA. 1494+47 PI-9	N417337.0113 N417380.11 E3673550.73 E3673551.36	202'
STA. 1495+63 PI-10	N417442.16 N417470.65 E3673504.39 E3673515.20	200'



A horizontal number line labeled "SCALE IN FEET" is shown. The line has tick marks at 200, 0, 200, 400, 600, and 800. The segments between the tick marks are of equal length, representing 100 feet each.

"AS-BUILT"

CONCRETE RUBBLE TO BE REMOVED FROM LIMITS
OF ROCK RIPRAP DIKE. DISPOSE OF RUBBLE BEHIND
ROCK RIPRAP DIKE AND BURY WITH DREDGE SPOIL
TO CLOSE OPENING BETWEEN DIKE AND BANK
SEE SHEET 15 OF 16 FOR MORE DETAIL.


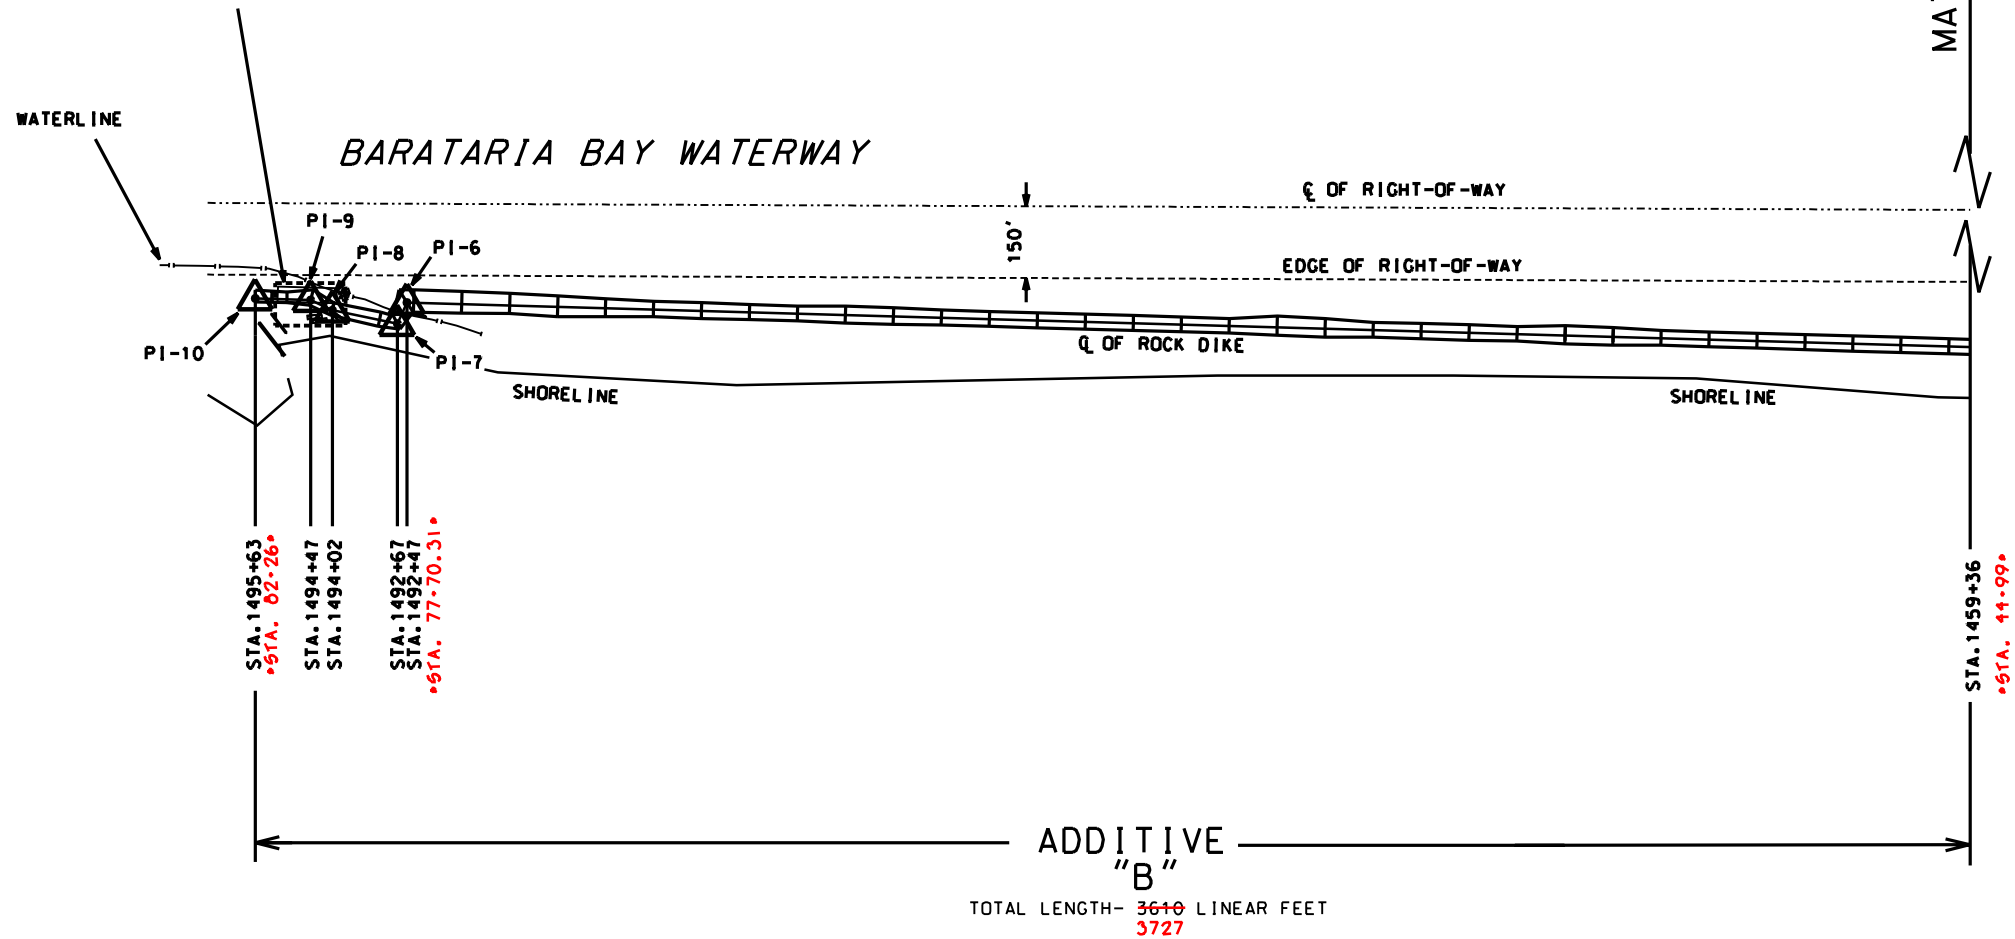


PLAN-DIKE, STA. 1459+36 - STA. 1495+63 BARATARIA BAY WATERWAY - WEST BANK PROJECT #PBA-12A JEFFERSON PARISH, LOUISIANA		U.S. DEPARTMENT OF AGRICULTURE - NATURAL RESOURCES CONSERVATION SERVICE	
CAD FILENAME LA28614.DGN		PROJECT NO. LA286	
SHEET NO. 14 OF 16		REVISIONS	
DATE	APPR.	TITLE	
02/28/00	E.J.G.	S. CON. ENG.	
DESIGNED J. CHUA		DATE 05/99	
DRAWN D.J. WILLMORE		APPROVED BY E.J. GIERING III	
TRACED		TITLE STATE CONSERVATION ENGINEER	
CHECKED J. MOORE		DATE 05/99	

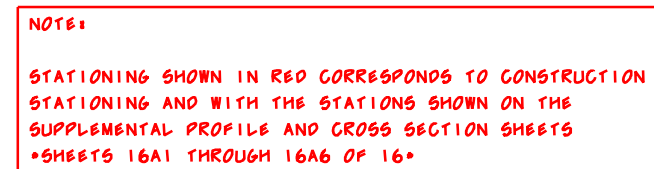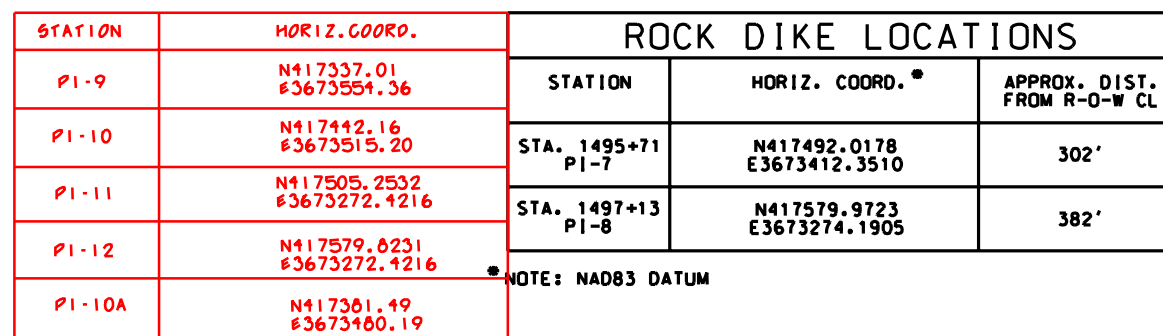

NOTE:
CONSTRUCTION AT PI-8 TO BE TIED INTO EXISTING BANK AS STAKED BY COTR.
DO NOT BLOCK ACCESS TO BOAT DOCK DURING CONSTRUCTION.


REVISIONS		PLAN-DIKE, STA. 1495+71-ST.A. 1497+13		Date	
DATE	APPR.	TITLE		Designed	J. CHUA
				Drawn	D.J. WILMORE
				Traced	
				Checked	J. MOORE
CAD FILENAME			U.S. DEPARTMENT OF AGRICULTURE - NATURAL RESOURCES CONSERVATION SERVICE		
LA28615.DGN					
PROJECT NO.			Title		
LA286					
SHEET NO 15 OF 16			Approved by E.J. GIERING III 11/99		
			Title STATE CONSERVATION ENGINEER		

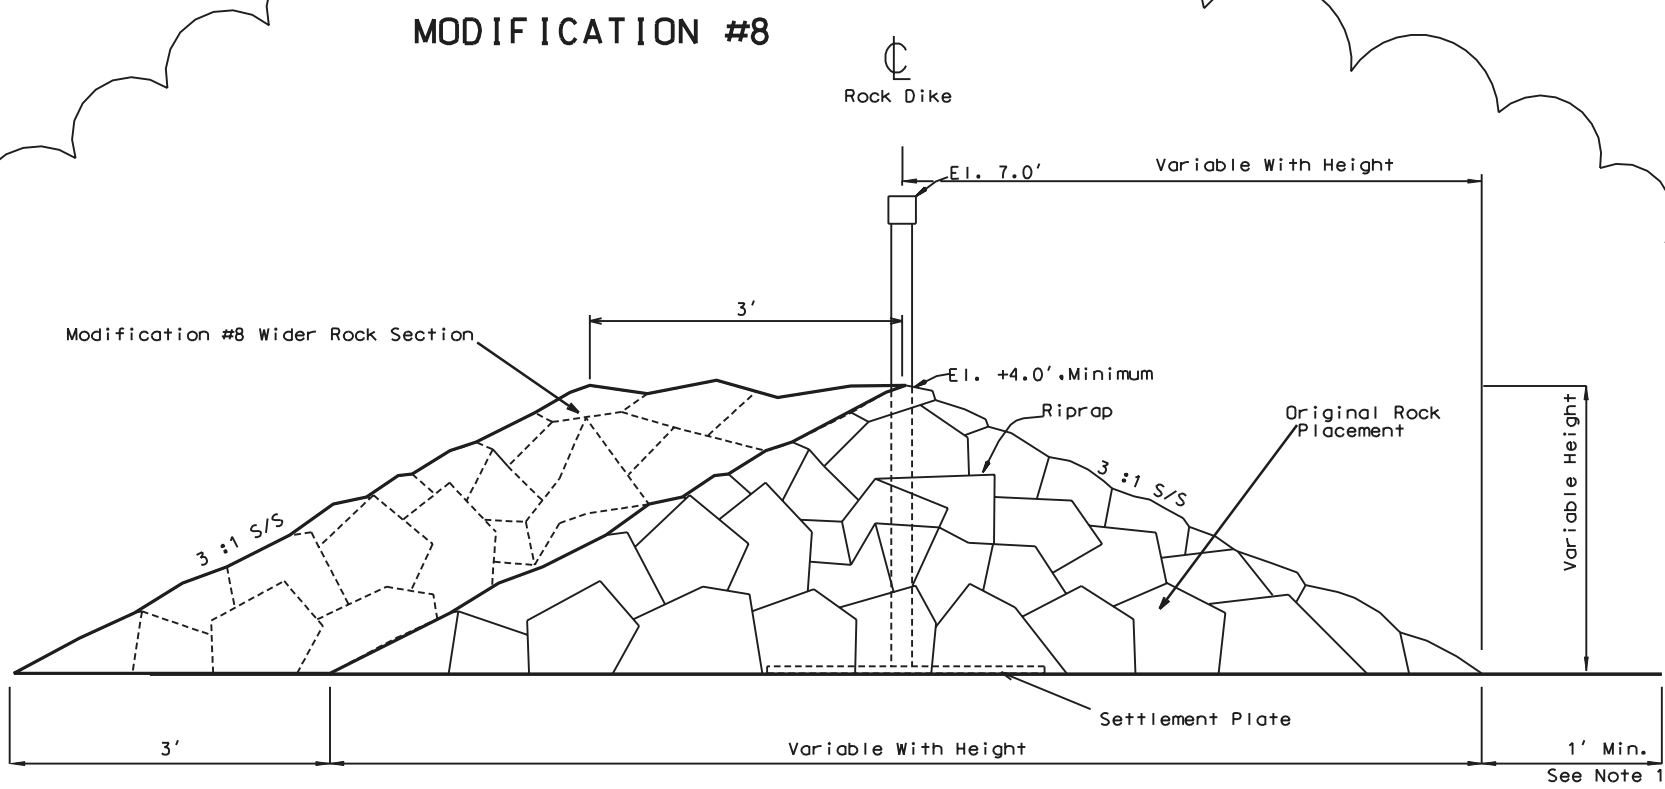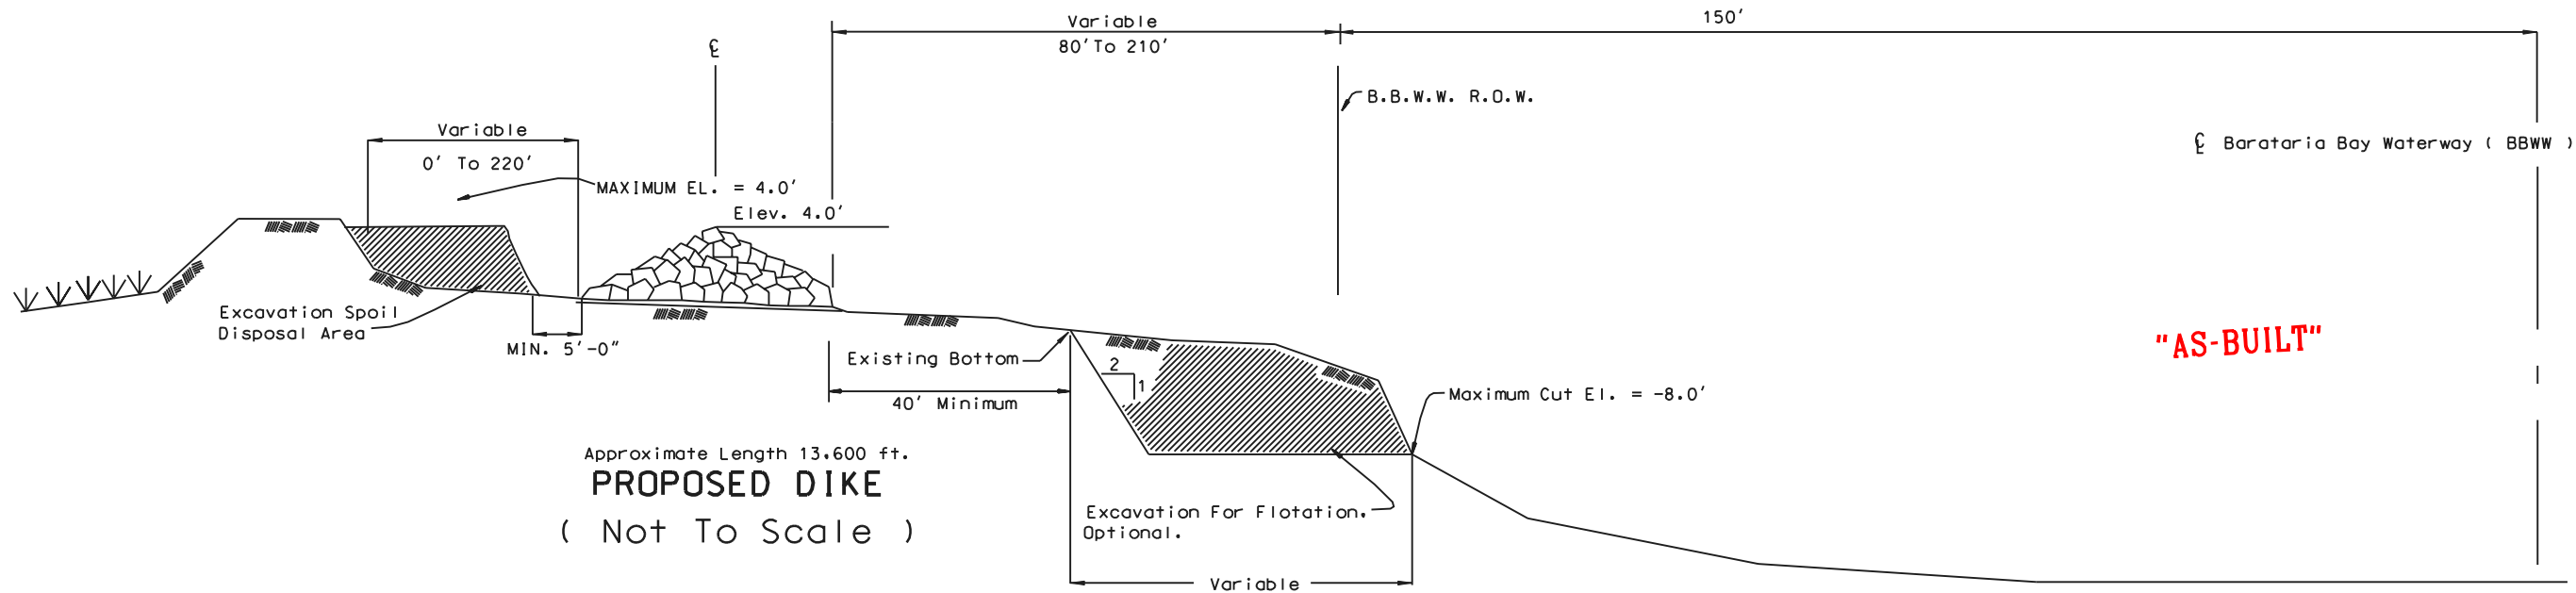

NOTES:

1. Place A Sufficient Amount Of Rock On Excess Geotextile To Prevent Flapping Action In Water
2. Wider Rock Section For Modification #8 Shall Be Placed On The Land Side Of The Original Contract Rock Placement As Shown From Sta. 1414+33 To Sta. 1422+25 And From Sta. 1423+96 Northward Until All Delivered Riprap As Of 8/17/2000 Has Been Placed (Estimated 2000 Tons).


MOD #8 SECTION PLACED AT STA. 1418+33 TO STA. 1420+33 APPROX. 200 LF. AND PLACED 607 TONS OF ROCK

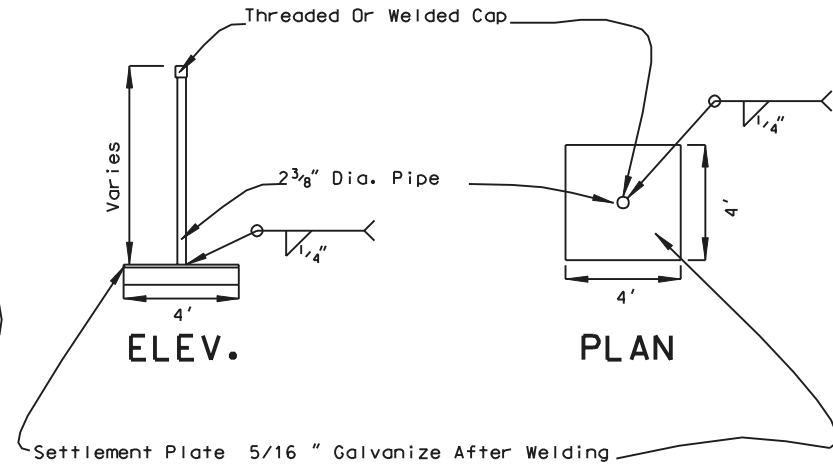


SETTLEMENT PLATE DETAILS

(Not To Scale)



DETAILS - ROCK DIKE BARATARIA BAY WATERWAY - WEST BANK PROJECT #PBA-12A JEFFERSON PARISH, LOUISIANA U.S. DEPARTMENT OF AGRICULTURE - NATURAL RESOURCES CONSERVATION SERVICE		Date 11/99 Approved by E.J. GIERING, III STATE CONSERVATION ENGINEER ALEXANDRIA, LOUISIANA Title Title
Date 05/99 Designed J. CHUA Drawn P. COLE Traced J. MOORE Checked J. MOORE	Date 05/99 Approved by E.J. GIERING, III STATE CONSERVATION ENGINEER ALEXANDRIA, LOUISIANA Title Title	Date 11/99 Approved by E.J. GIERING, III STATE CONSERVATION ENGINEER ALEXANDRIA, LOUISIANA Title Title
NO. MOD #8 DATE 8/17/00 APPR. S.C.E.	TITLE S.C.E.	CAD FILENAME LA28616M8.DGN PROJECT NO. LA286 SHEET NO. 16 OF 16

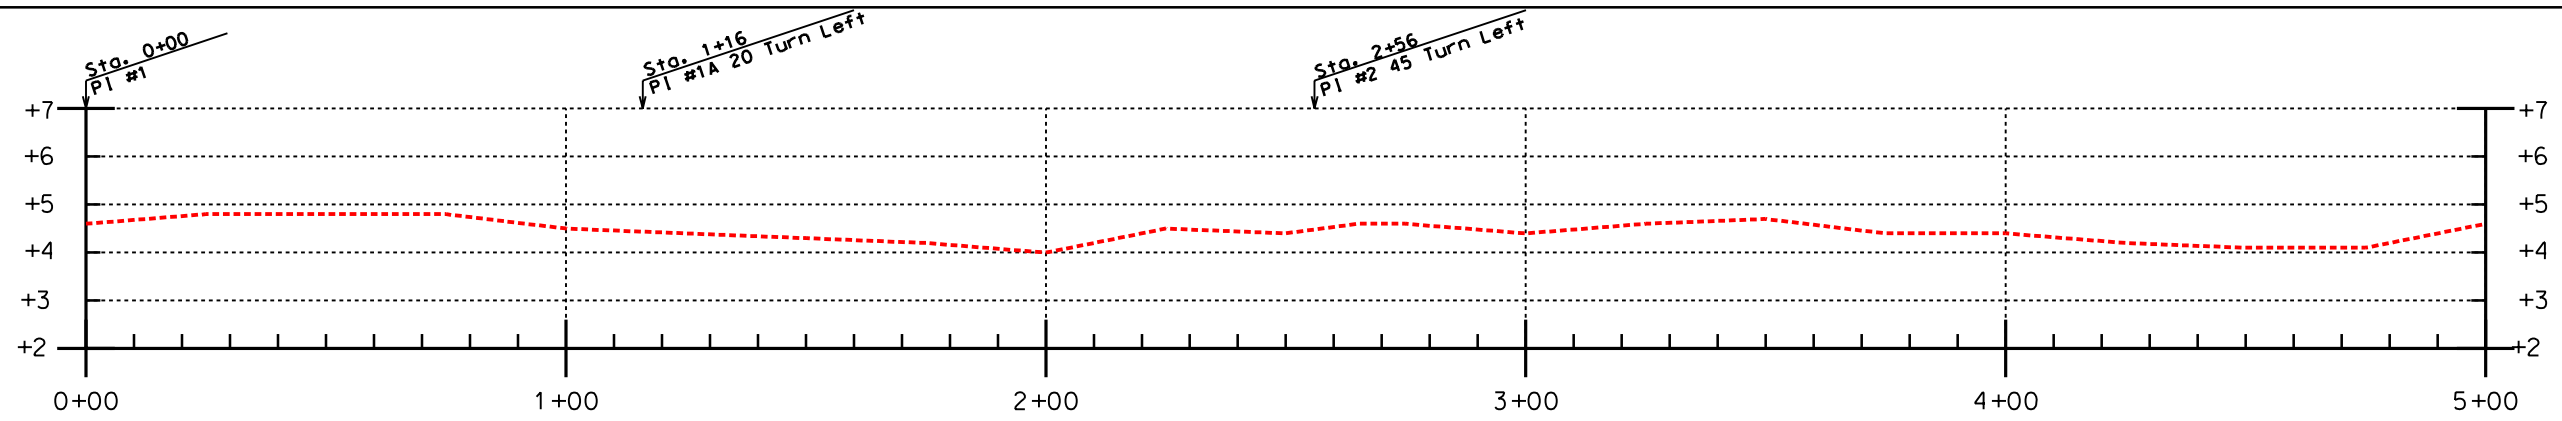

SOUTH END - PROFILE ON C
STA. 0+00 - 5+00

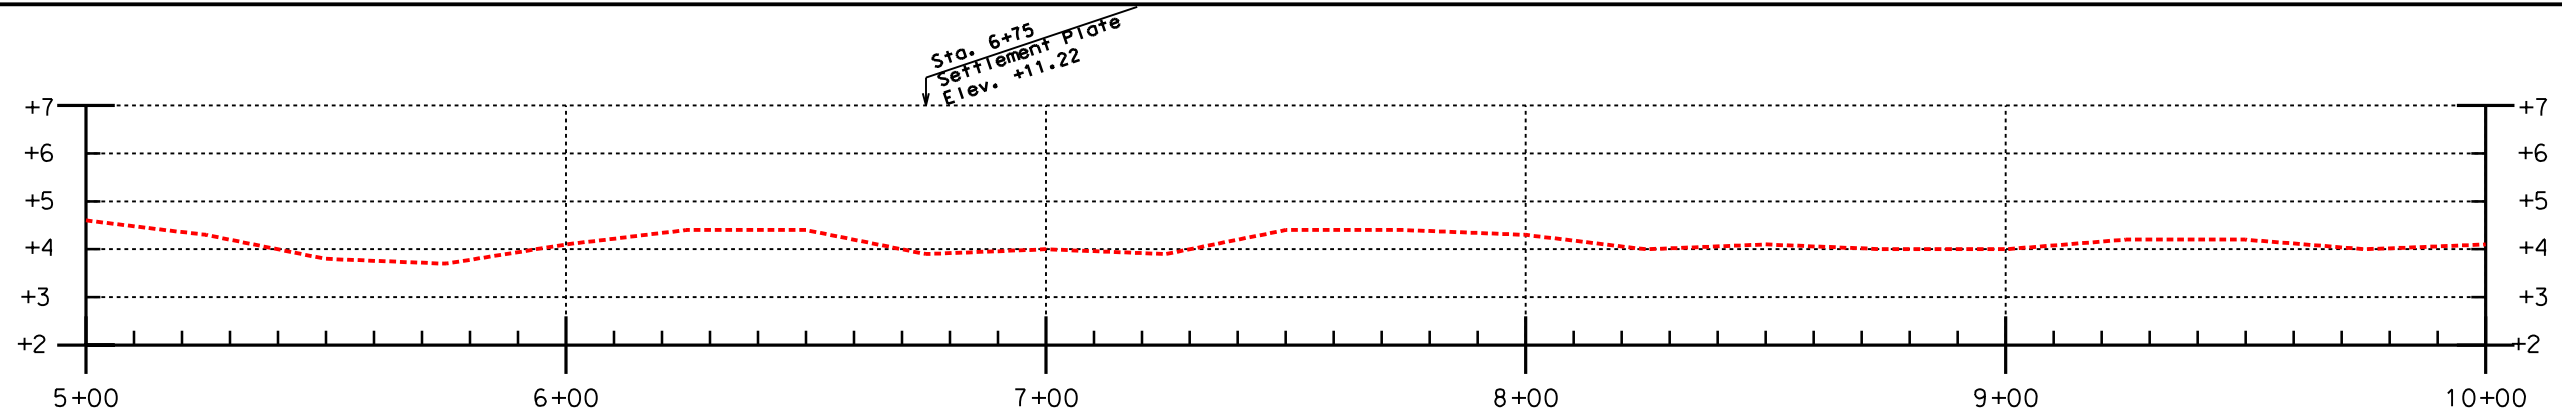


SOUTH END - PROFILE ON C
STA. 5+00 - 10+00

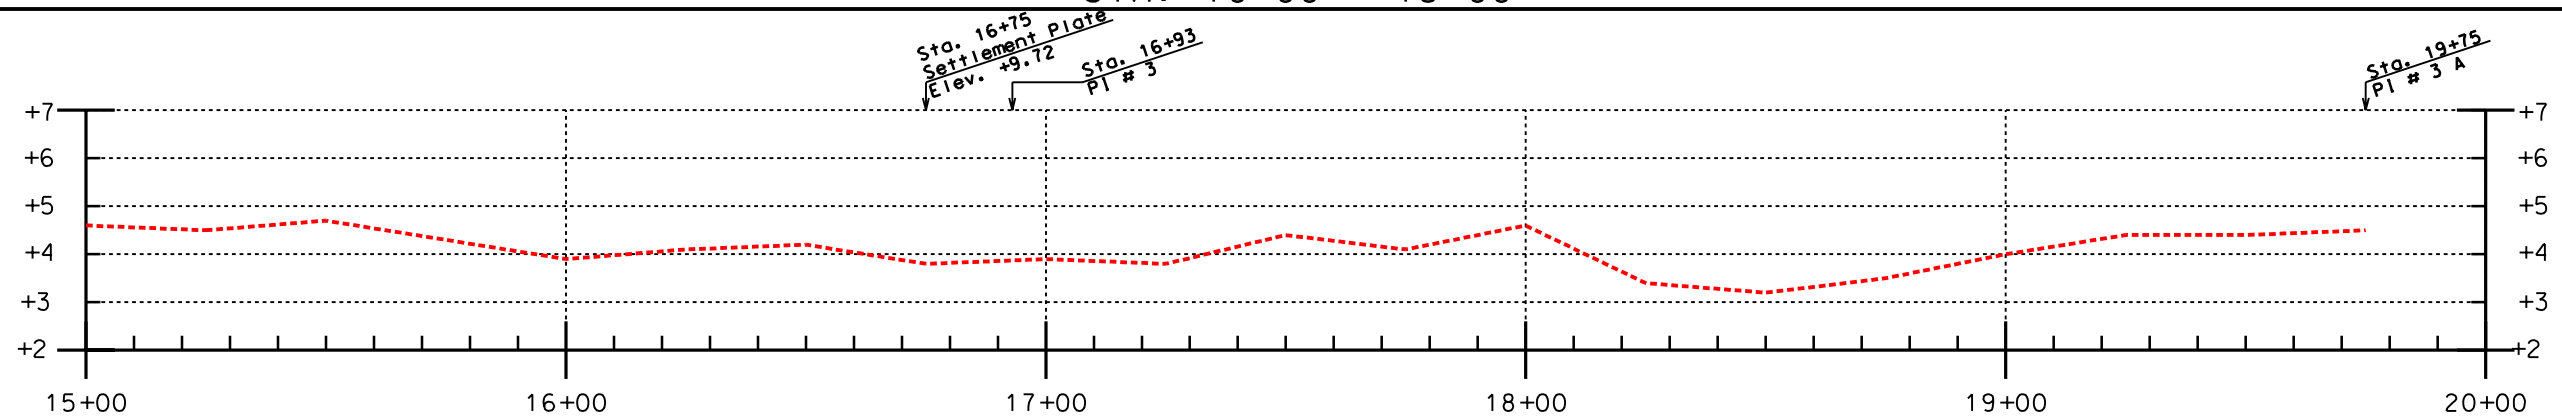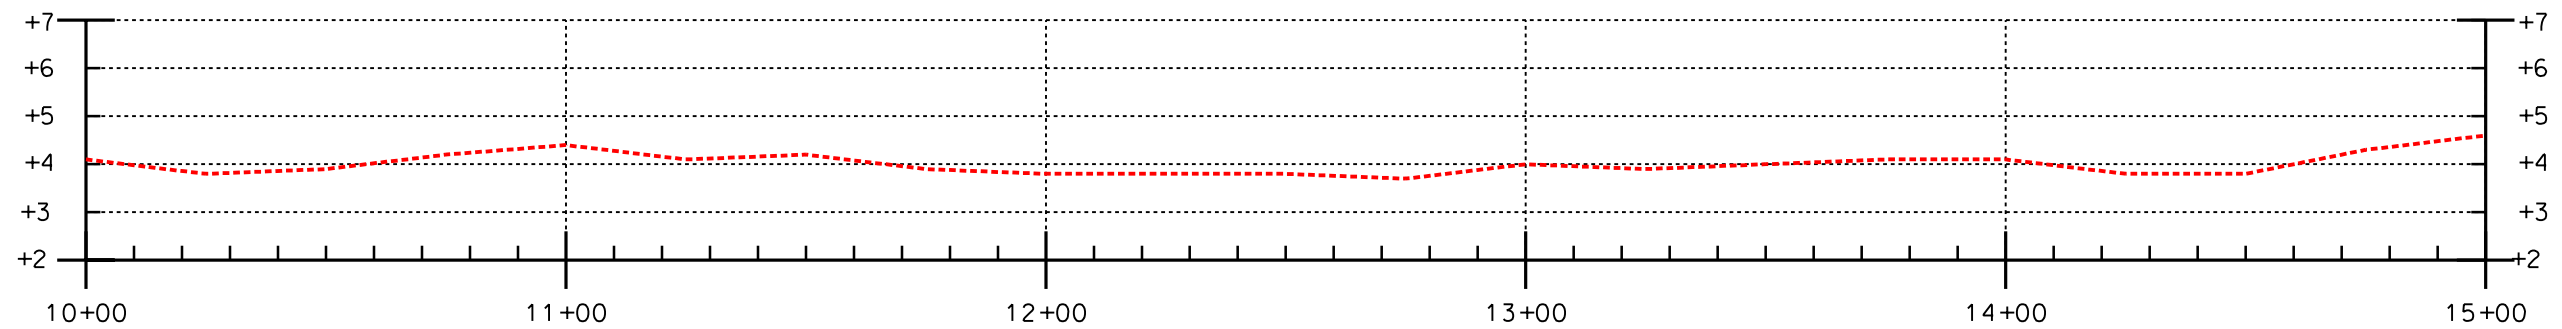


SOUTH END - PROFILE ON C
STA. 15+00 - 19+75


"AS-BUILT"

DRAWING NO.		LA-286	
AD FILE NO.		LA286016A1	
U.S. DEPARTMENT OF AGRICULTURE - NATURAL RESOURCES CONSERVATION SERVICE			
SOUTH END PROFILE - AS-BUILT BARATARIA BAY WATERWAY-WEST BANK PROJECT # PBA-12A JEFFERSON PARISH, LOUISIANA			
DATE	APPR.	TITLE	
Designed		J. Chua	
Drawn		A. J. Gremillion	
Traced			
Checked		B. Stricker	
Title		Title	
Approved by		E.J. GIERING III	
05/98		03/02	
03/02		STATE CONSERVATION ENGINEER	

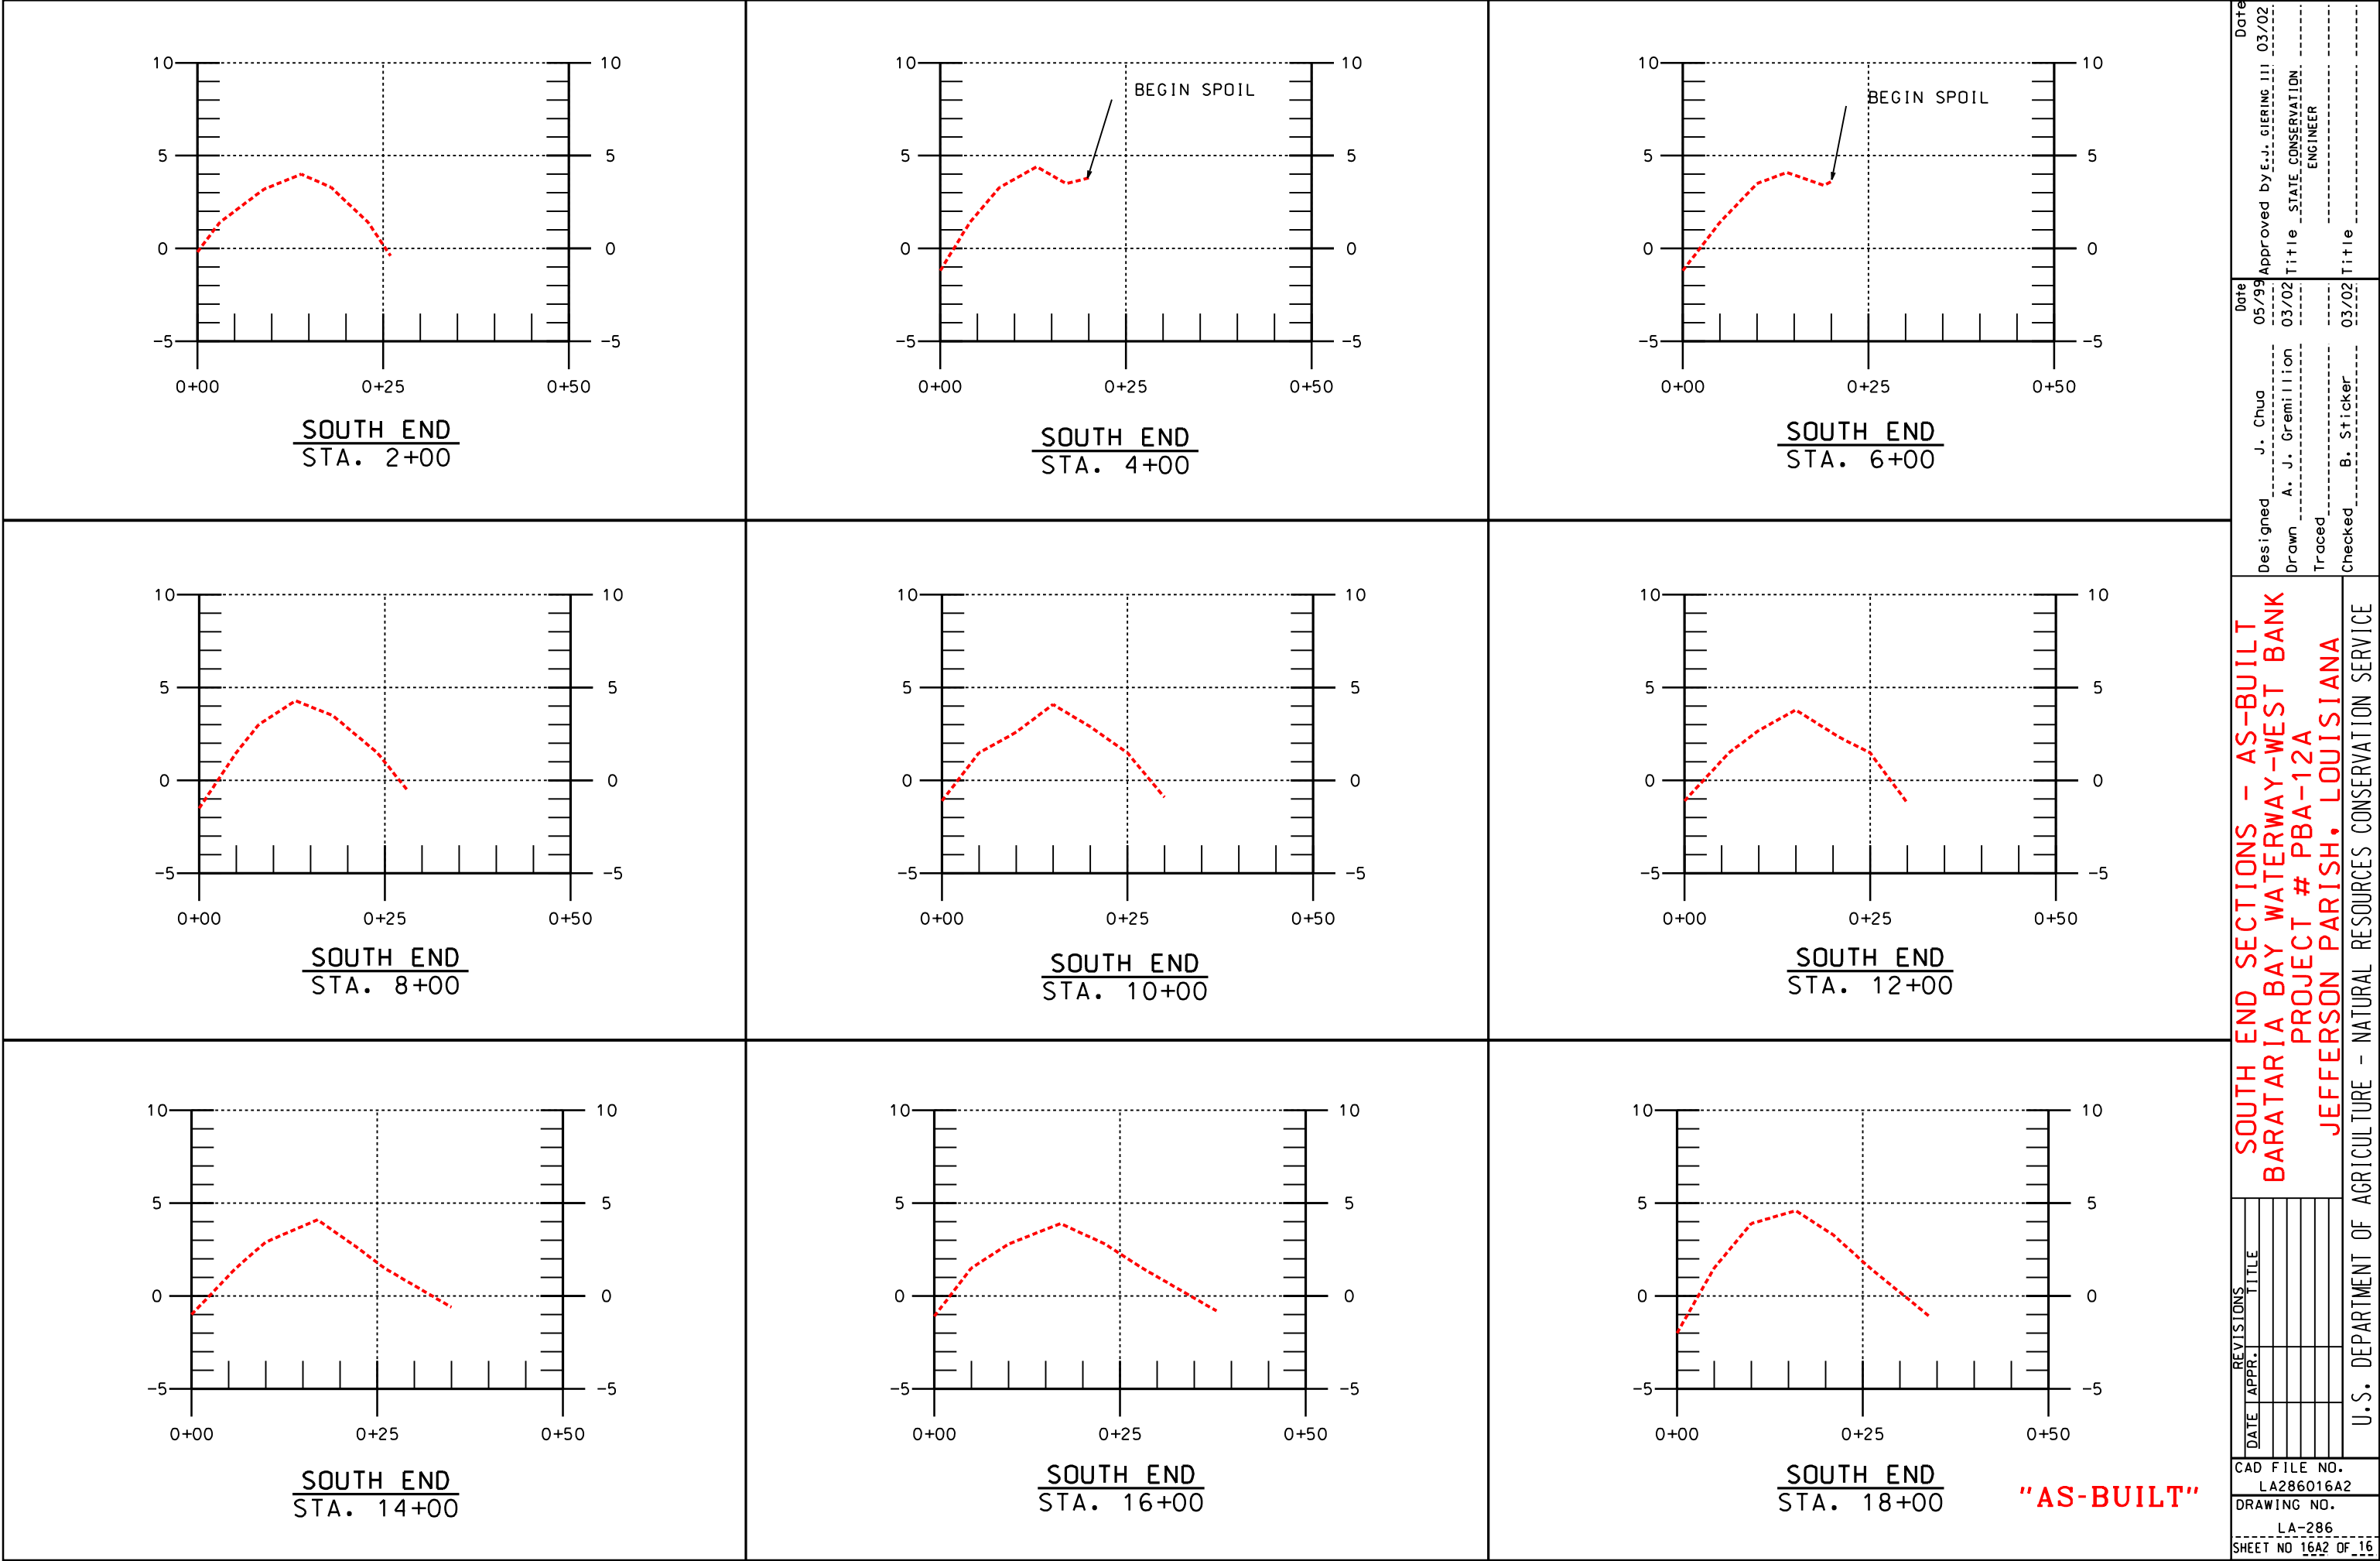


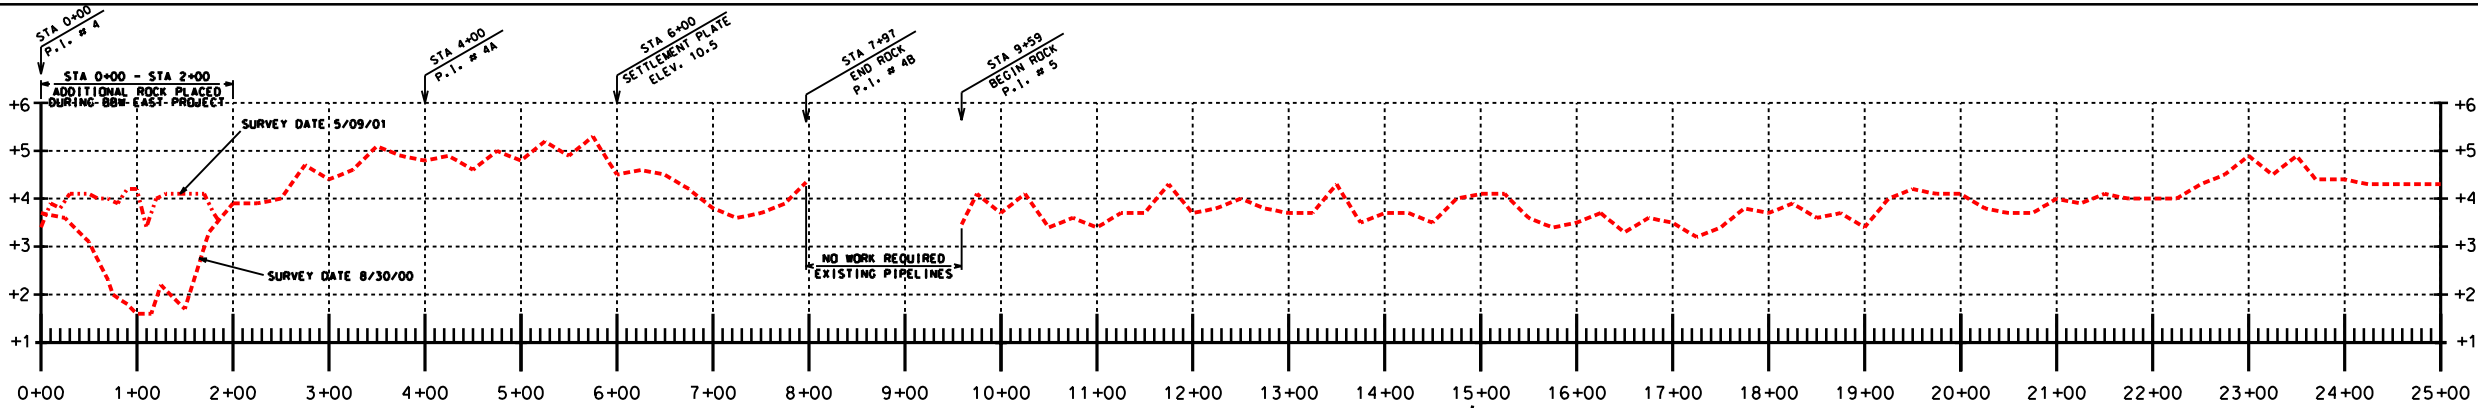


NORTH END - PROFILE ON ϕ
STA. 0+00 - 25+00

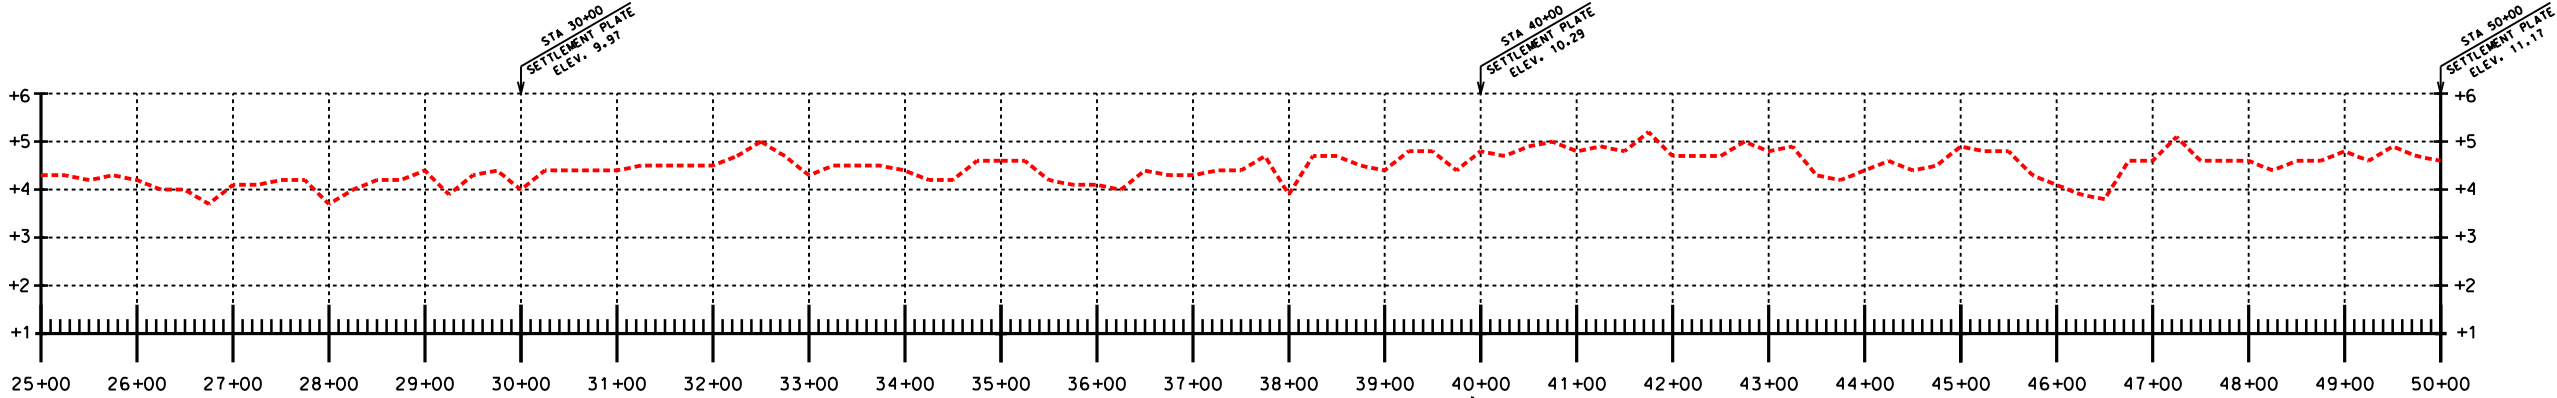


NORTH END - PROFILE ON ϕ
STA. 25+00 - 50+00

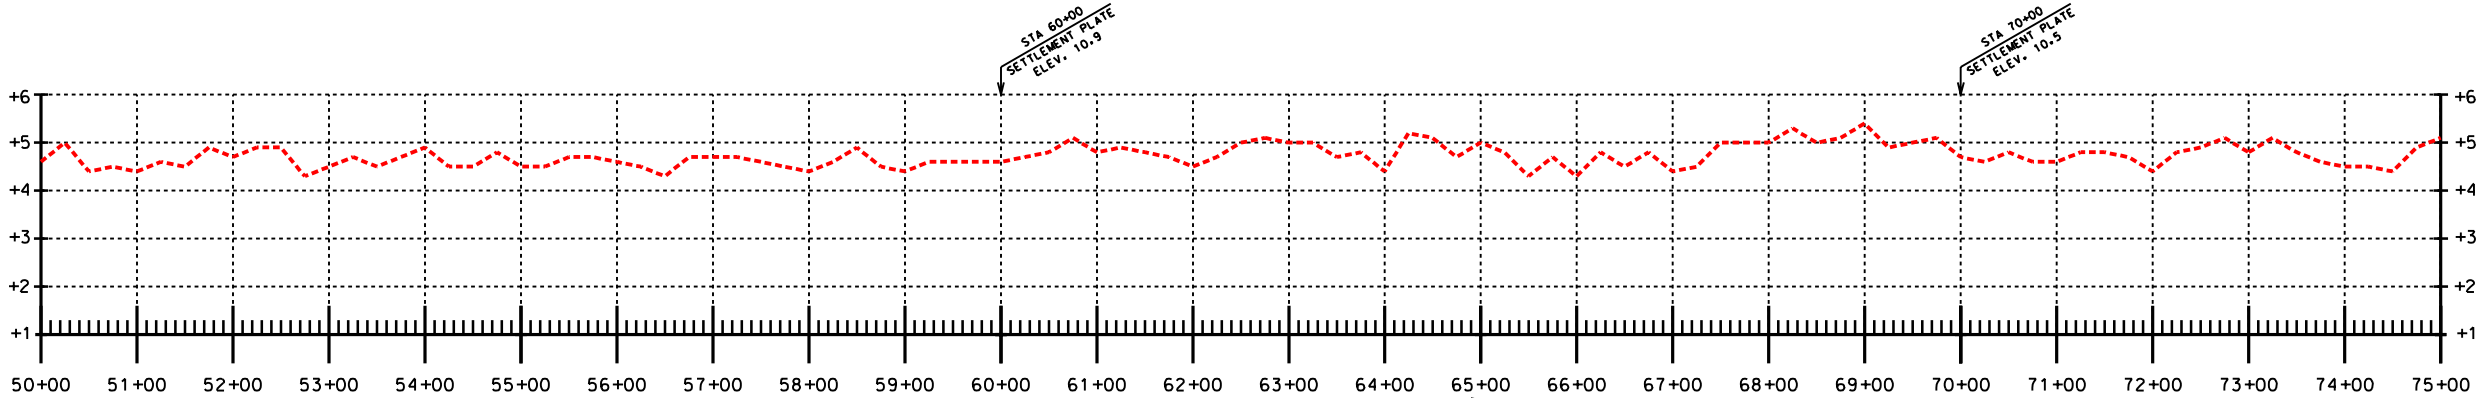

NORTH END - PROFILE ON ϕ
STA. 50+00 - 75+00

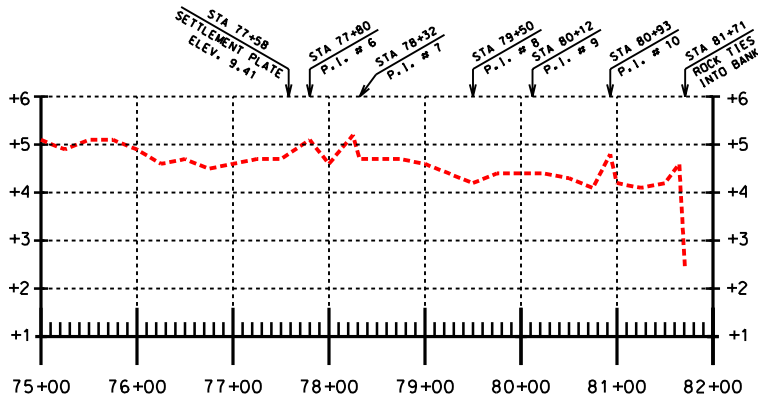

NORTH END - PROFILE ON ϕ
STA. 75+00 - 82+00

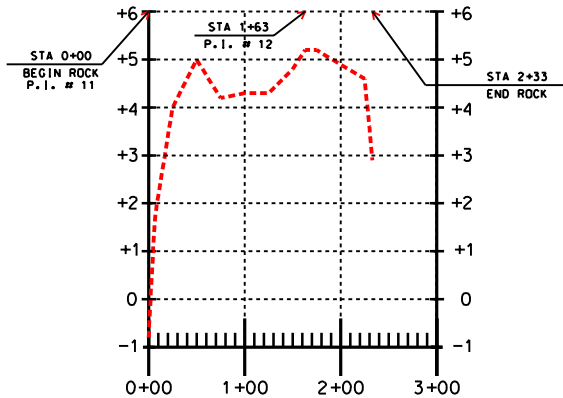

UPPER NORTH END - PROFILE ON ϕ
STA. 0+00 - 2+33

"AS-BUILT"

DATE

APPR.

REVISIONS

TITLE

U.S. DEPARTMENT OF AGRICULTURE - NATURAL RESOURCES CONSERVATION SERVICE

JEFFERSON PARISH, LOUISIANA

PROJECT # PBA-12A

BARATARIA BAY WATERWAY-WEST BANK

NORTH END PROFILE - AS-BUILT

DESIGNED

DRAWN

TRACED

CHECKED

J. Chua

A. J. Gremillion

B. Sticker

APPROVED BY

DATE

E. J. GIERING III

03/02

TITLE

STATE CONSERVATION ENGINEER


CAD FILE NO.

LA286016A3

DRAWING NO.

LA-286

SHEET NO 16A3 OF 16

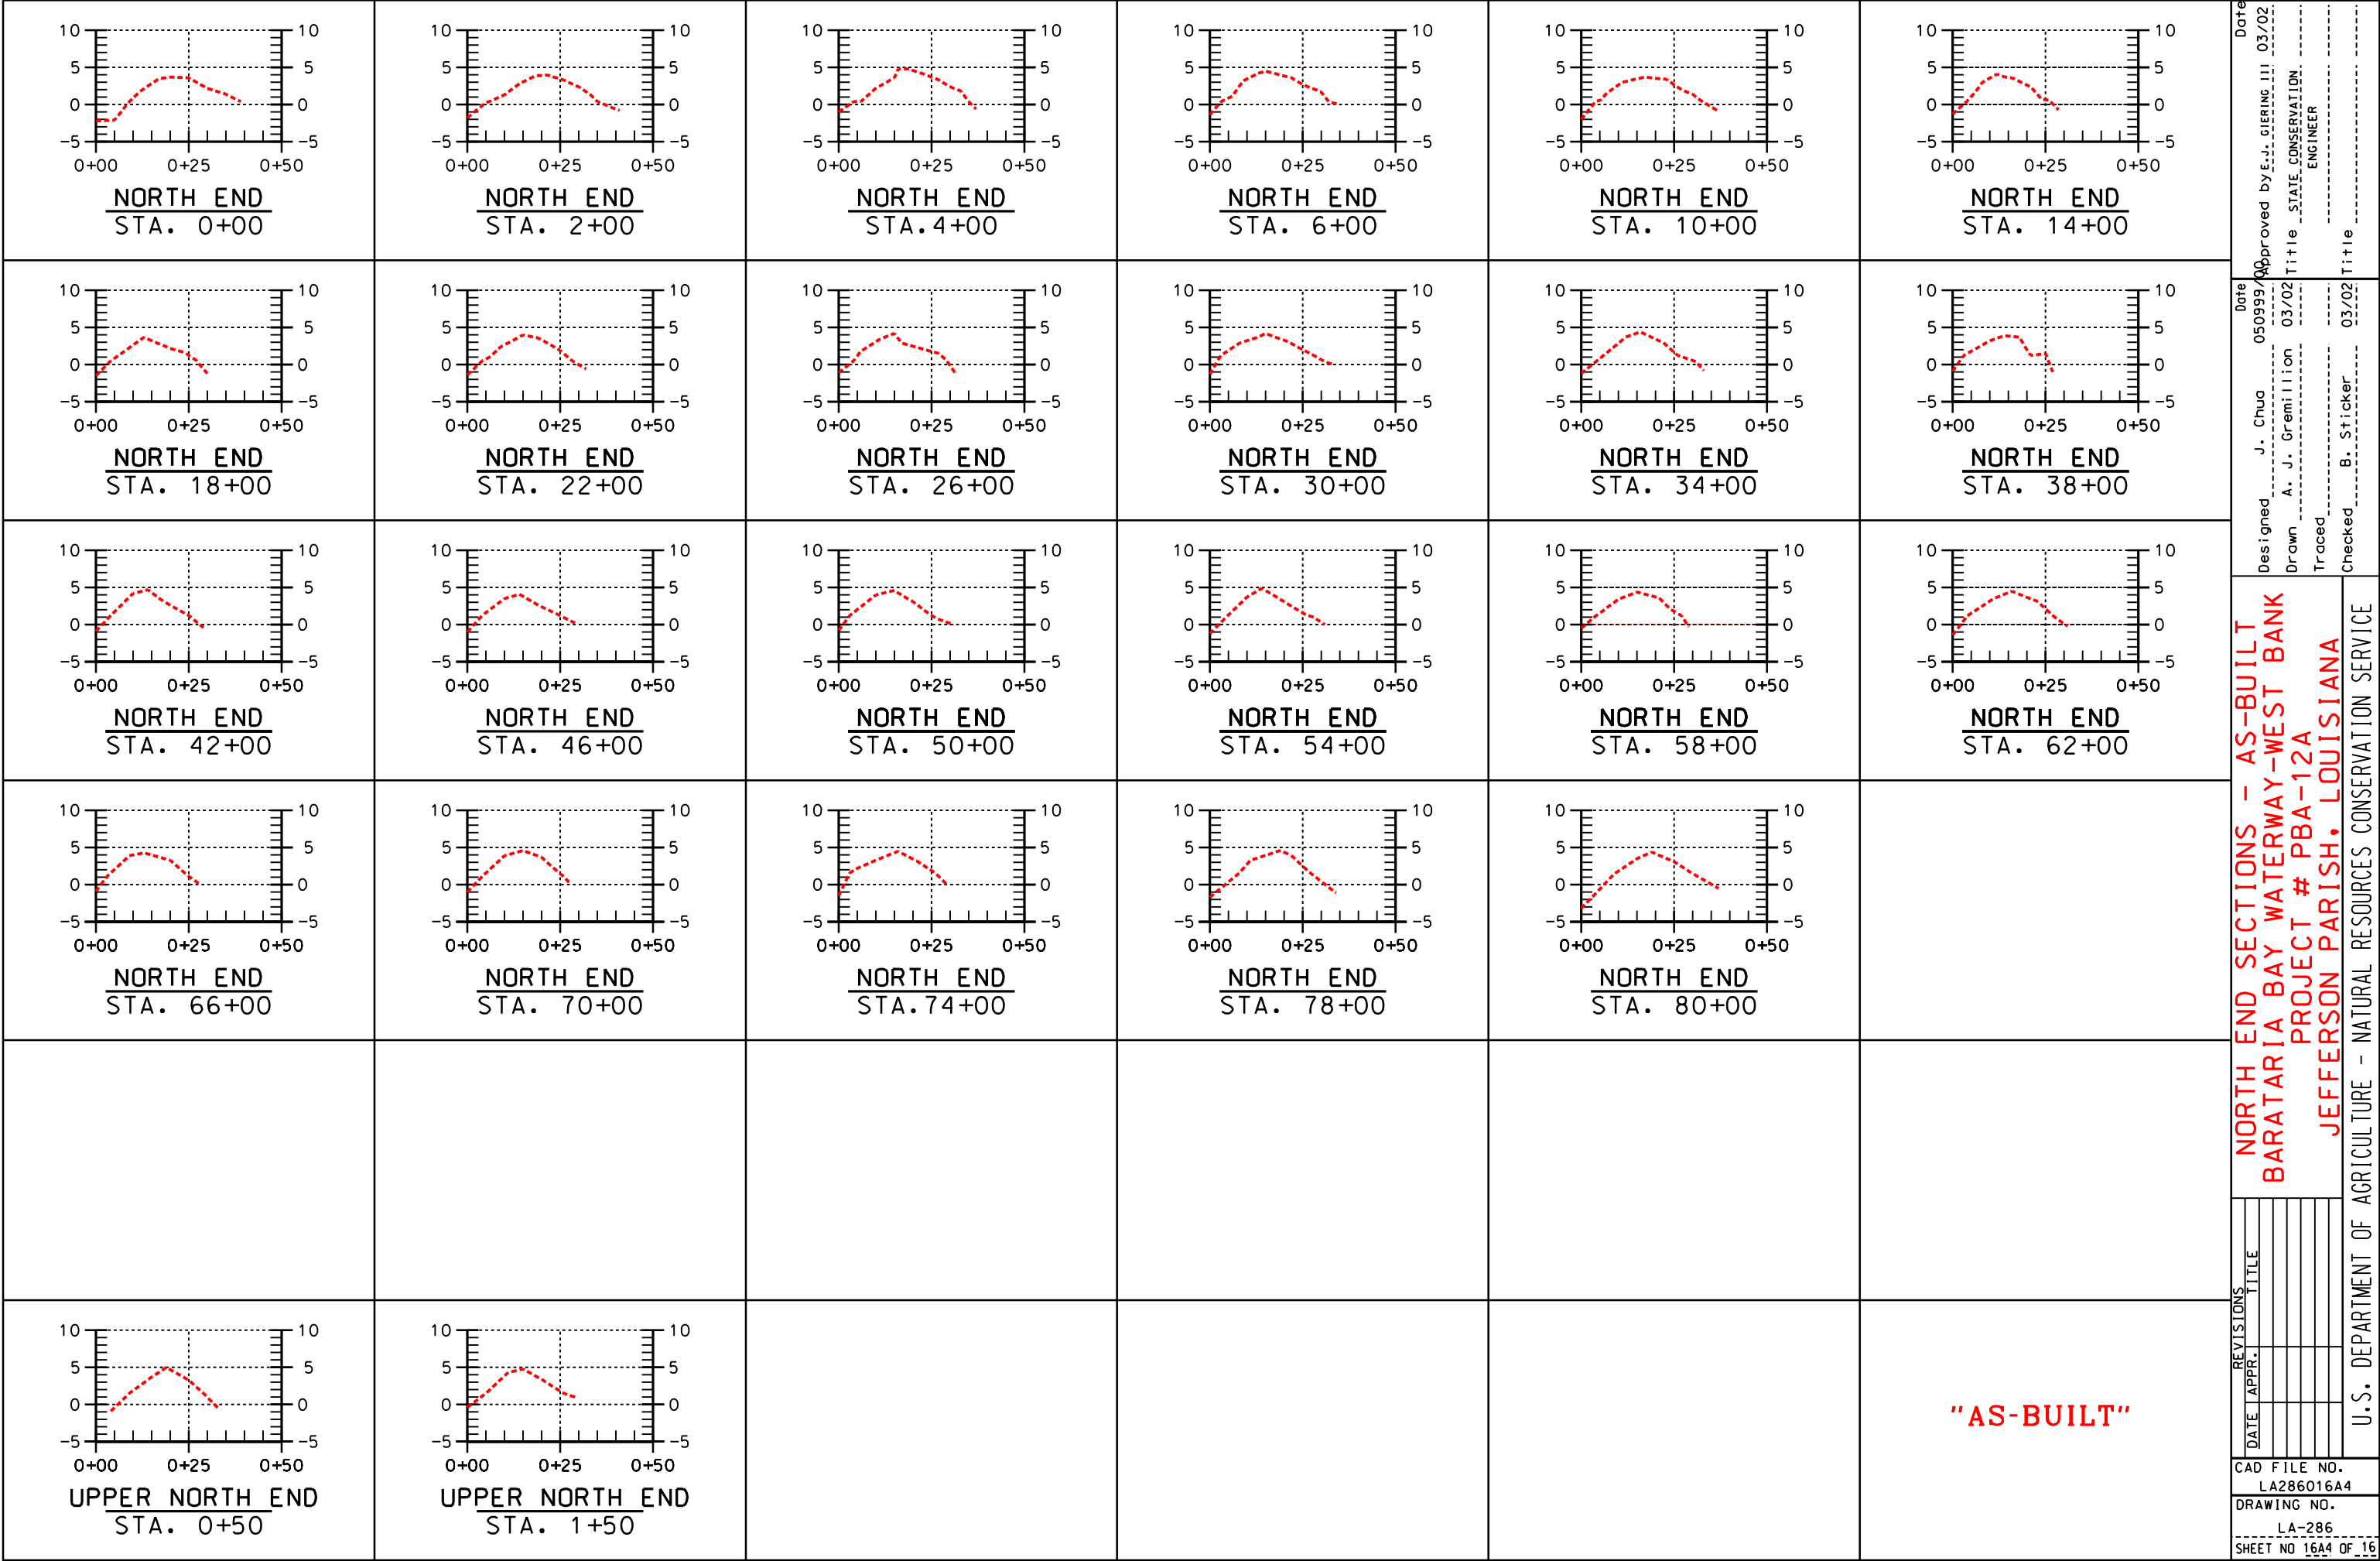

REVISIONS

DATE	APPR.	TITLE

CAD FILE NO.

LA286016A4

DRAWING NO.

LA-286

SHEET NO 16A4 OF 16

NORTH END SECTIONS - AS-BUILT

BARATARIA BAY WATERWAY-WEST BANK

PROJECT # PBA-12A

JEFFERSON PARISH, LOUISIANA

U.S. DEPARTMENT OF AGRICULTURE - NATURAL RESOURCES CONSERVATION SERVICE

DESIGNED
J. Chu

DRAWN
A. J. Gremlion

TRACED
B. Sticker

CHECKED

DATE
05/09/00

APPROVED BY
E. J. GIERING III


TITLE
STATE CONSERVATION ENGINEER

DATE
03/02


TITLE

DATE
03/02


TITLE

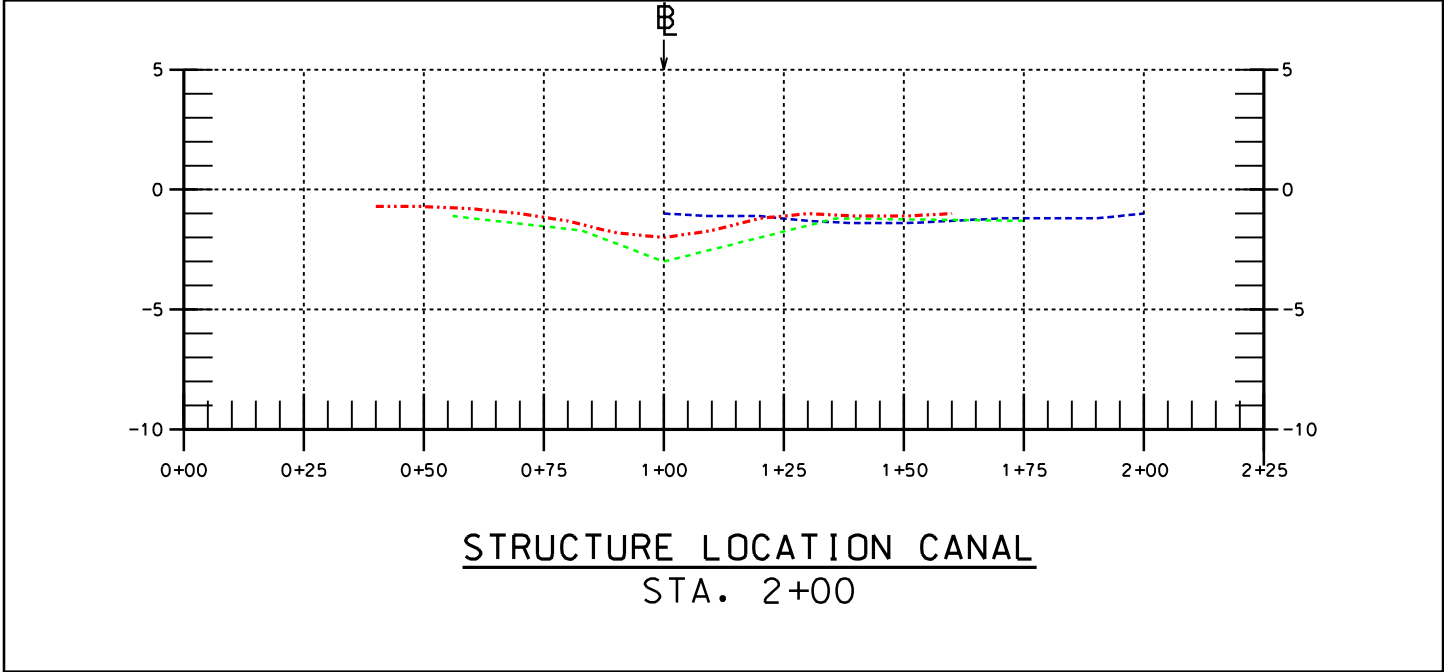


STRUCTURE LOCATION CANAL
STA. 2+00

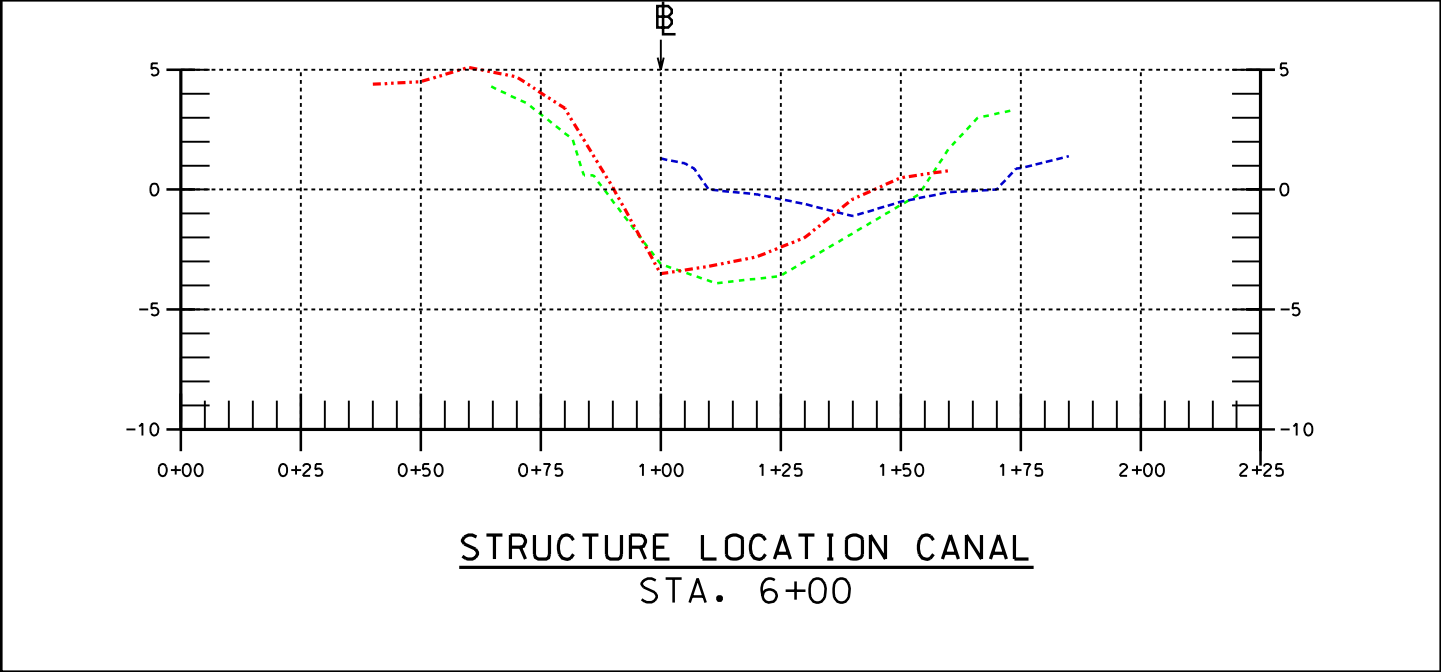


STRUCTURE LOCATION CANAL
STA. 6+00

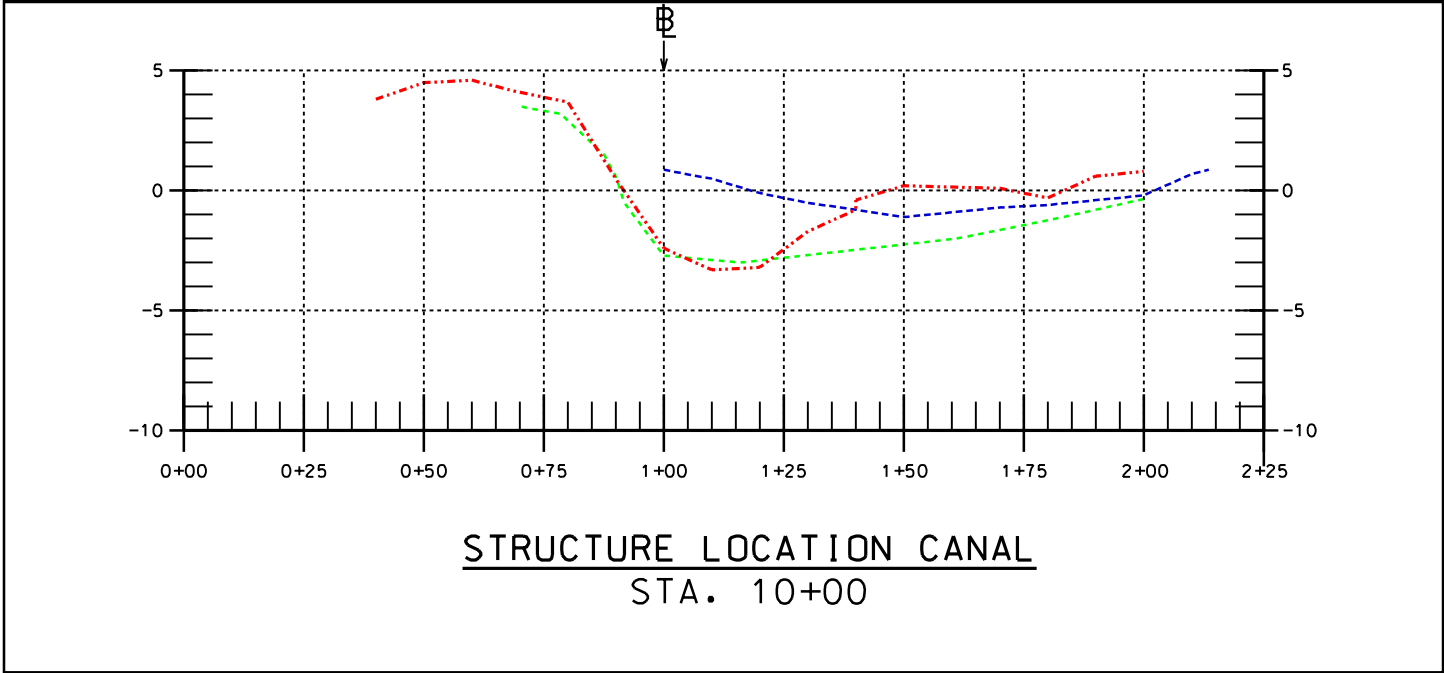

STRUCTURE LOCATION CANAL
STA. 10+00

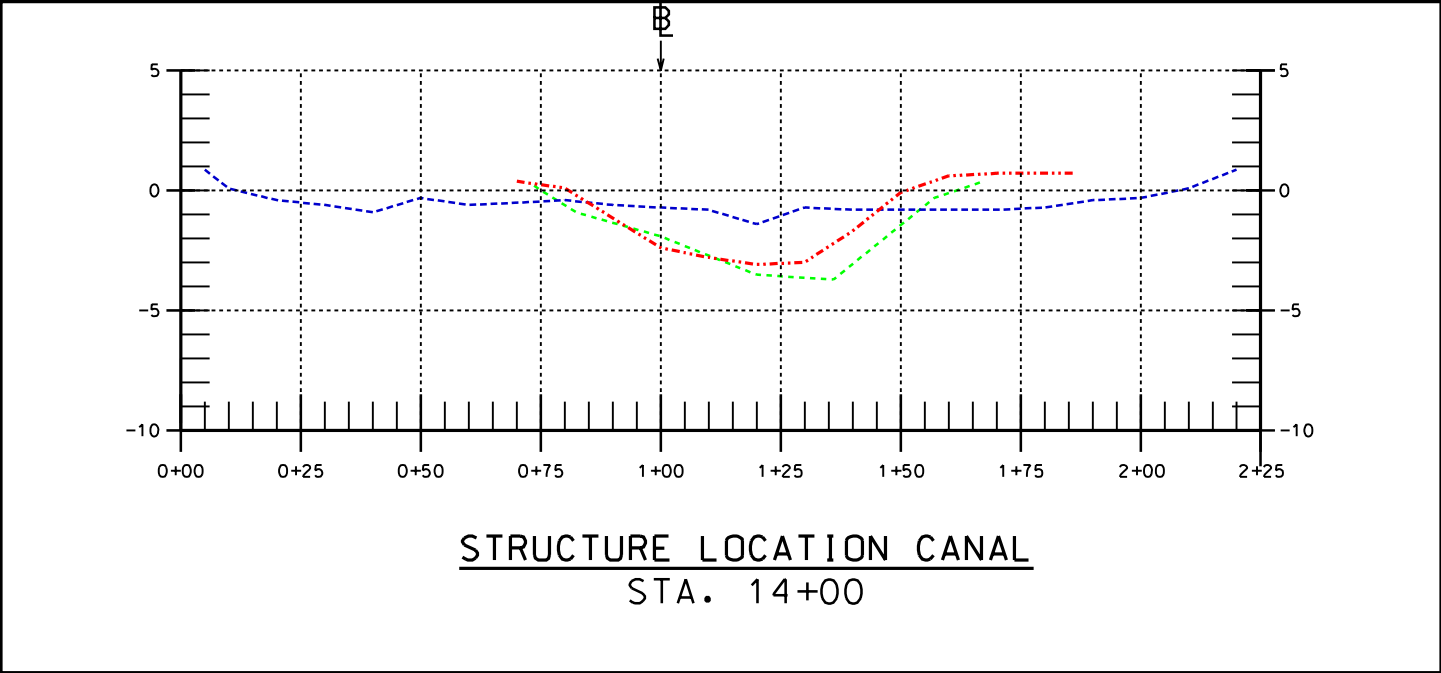

STRUCTURE LOCATION CANAL
STA. 14+00

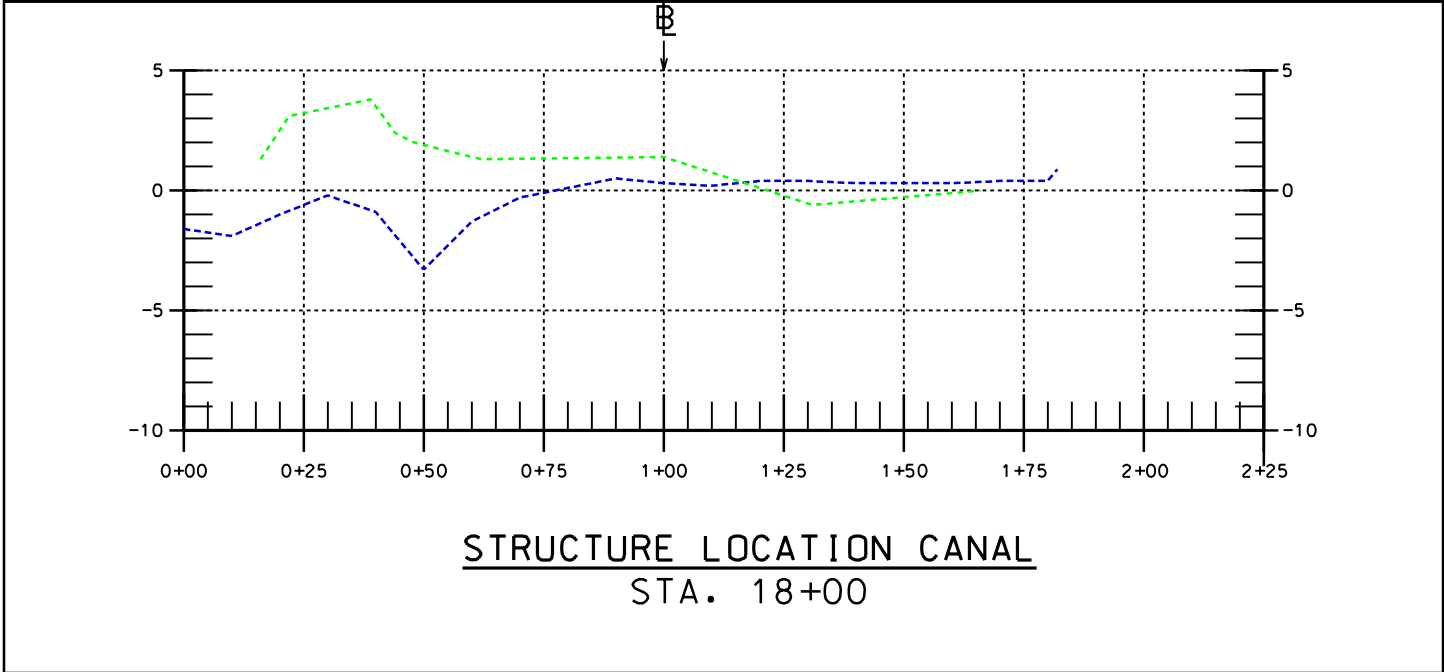

STRUCTURE LOCATION CANAL
STA. 18+00

- ORIGINAL CROSS SECTIONS (SURVEY DATE: 6/08/00)
- CONSTRUCTION CHECK CROSS SECTIONS (SURVEY DATE: 11/15/00)
- FINAL CHECK CROSS SECTIONS (SURVEY DATE: 9/12/01)

"AS-BUILT"

LOCATION CANAL (OUTLET) - AS-BUILT
BARATARIA BAY WATERWAY-WEST BANK
PROJECT # PBA-12A
JEFFERSON PARISH, LOUISIANA

REVISIONS	
DATE	TITLE

CAD FILE NO.
LA286016A5

DRAWING NO.
LA-286


SHEET NO 16A5 OF 16

U.S. DEPARTMENT OF AGRICULTURE - NATURAL RESOURCES CONSERVATION SERVICE


Designed J. Chua
Drawn A. J. Gremillion
Traced
Checked B. Sticker

Date 05/99
Approved by E. J. GIERING III
Title STATE CONSERVATION
ENGINEER


Date 03/02
Title

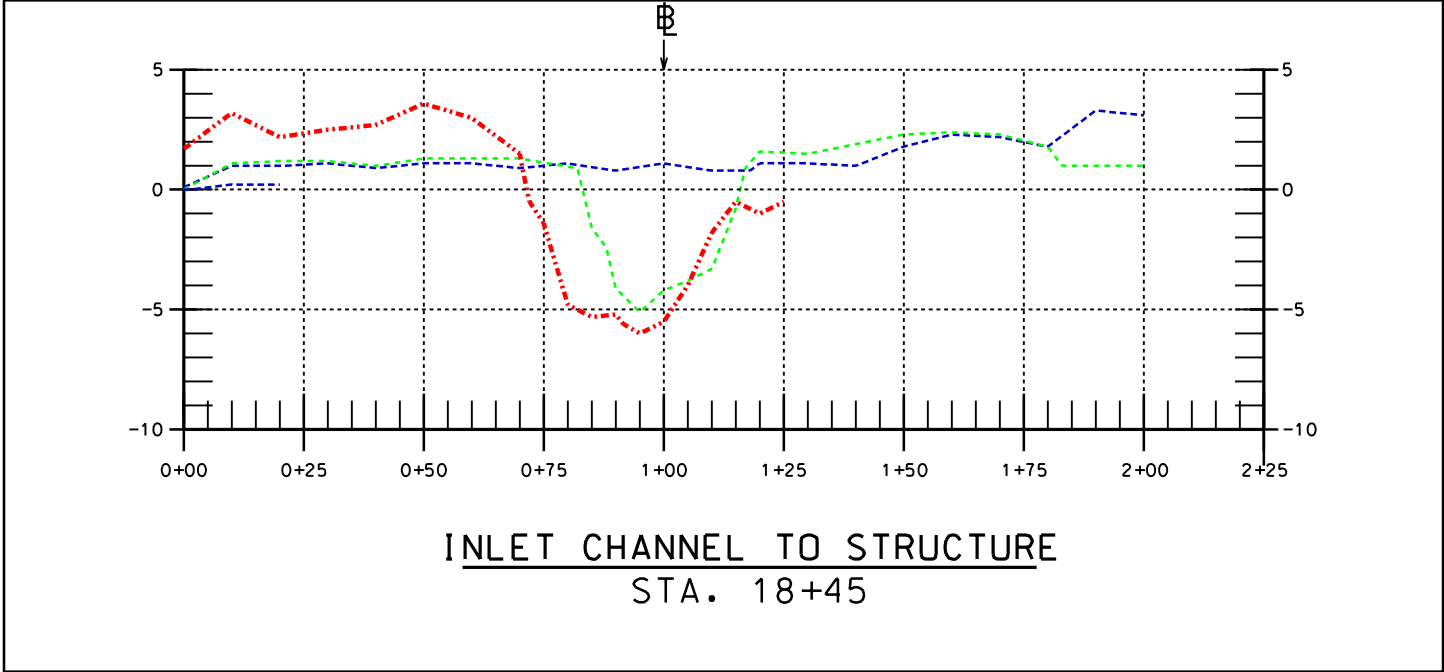

INLET CHANNEL TO STRUCTURE
STA. 18+45

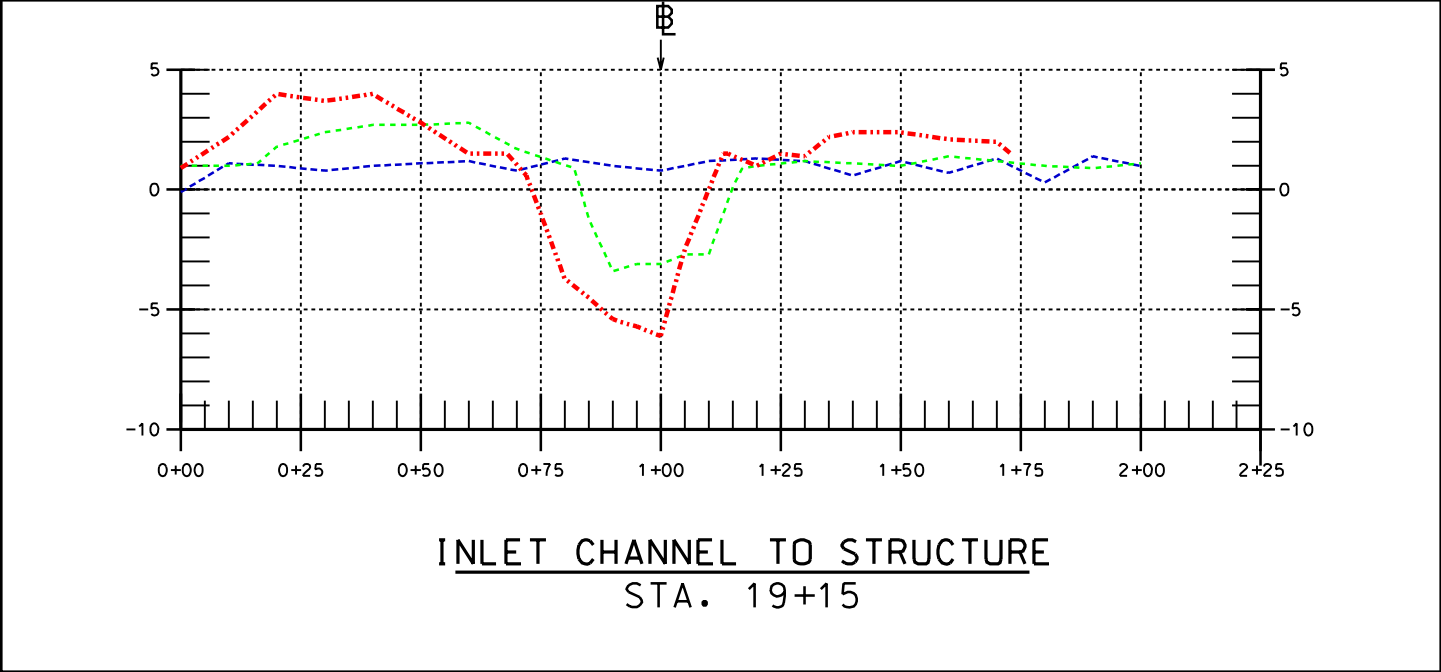

INLET CHANNEL TO STRUCTURE
STA. 19+15

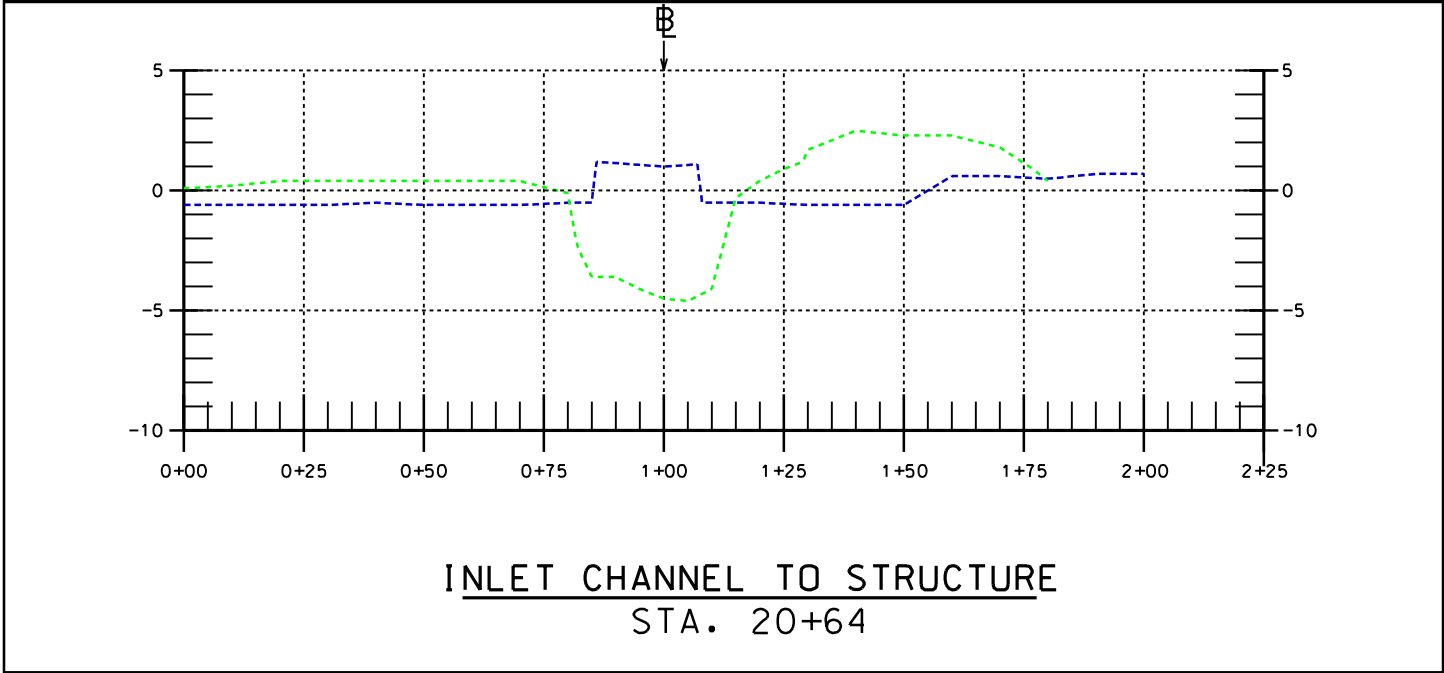

INLET CHANNEL TO STRUCTURE
STA. 20+64

- ORIGINAL CROSS SECTIONS (SURVEY DATE: 8/17/00)
- CONSTRUCTION CHECK CROSS SECTIONS (SURVEY DATE: 08/29/00)
- .-.-.-.- FINAL CHECK CROSS SECTIONS (SURVEY DATE: 10/31/00)

"AS-BUILT"

REVISIONS

DATE	APPR.	TITLE

CAD FILE NO.
LA286016A6

DRAWING NO.
LA-286

SHEET NO 16A6 OF 16

LOCATION CANAL (INLET) - AS-BUILT
BARATARIA BAY WATERWAY-WEST BANK
PROJECT # PBA-12A
JEFFERSON PARISH, LOUISIANA

U.S. DEPARTMENT OF AGRICULTURE - NATURAL RESOURCES CONSERVATION SERVICE

Designed	J. Chua	Approved by	E. J. GIERING III	Date	05/99
Drawn	A. J. Gremillion	Title	STATE CONSERVATION ENGINEER		03/02
Traced					
Checked	B. Sticker				03/02