

United States Department of Agriculture



Natural Resources Conservation Service
3737 Government Street
Alexandria, LA 71302

April 8, 2002

Mr. Van Cook
Project Manager
LDNR / Coastal Restoration Division
UNO Box 1102
New Orleans, LA 70148

Mr. Tom Podany
Chief, CWPPRA Program Manager
US Army Engineer District, New Orleans
P.O. Box 60267
New Orleans, Louisiana 70506

Gentlemen:

Re: PL-646 – BA-26
Barataria Bay Waterway “Dupree Cut” Bank Protection East

Enclosed are the “As Built” drawings for the referenced project.


Please direct any questions concerning this Project Completion Report to Brad Sticker at (318) 473-7791.

Sincerely,



/s/
Ed Giering, P.E.
State Conservation Engineer

Enclosure

cc: Bruce Lehto, ASTC/Water Resources, NRCS, Alexandria, LA (electronic distribution)
Britt Paul, Water Resources Planning Staff Leader, NRCS, Alexandria, LA (electronic distribution)
Dr. Bill Good, LDNR – CRD, Baton Rouge, LA (electronic distribution)
Garrett Broussard, LDNR-CRD, Baton Rouge, LA (electronic distribution)
Richard Abshire, Project Manager, NRCS, Baton Rouge, LA (electronic distribution)
Brad Sticker, Civil Engineer, NRCS, Alexandria, LA (electronic distribution)
Dale Garber, COTR, NRCS, Crowley, LA (electronic distribution)

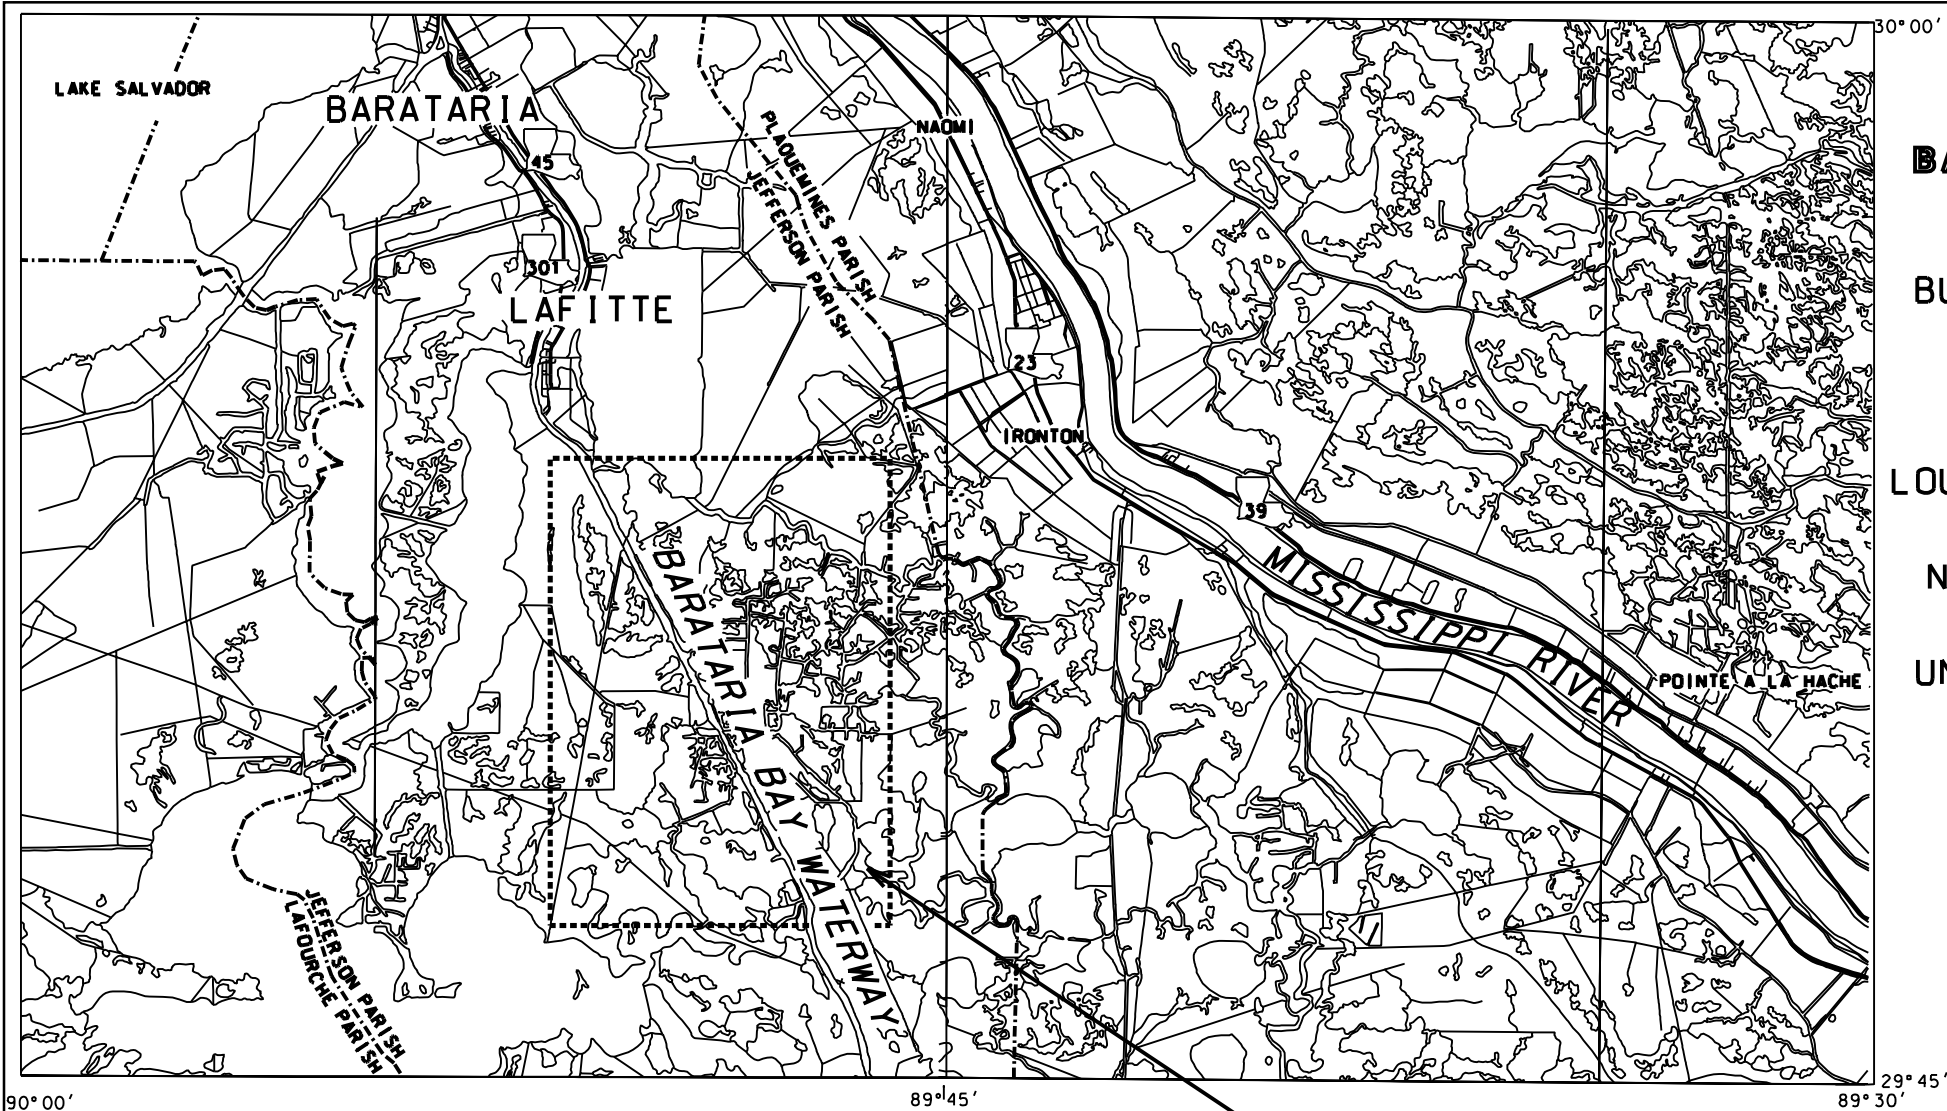

VICINITY MAP

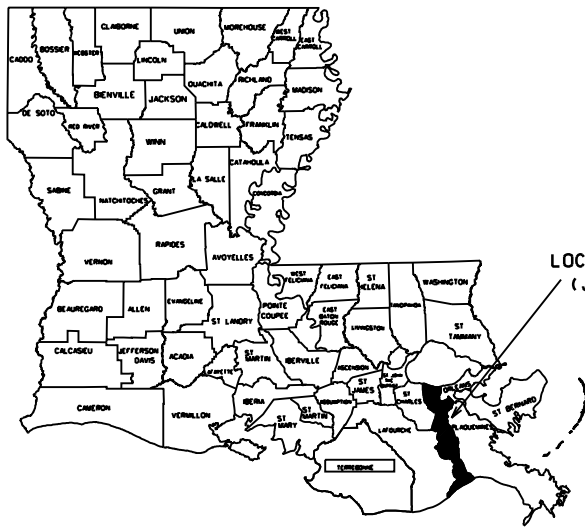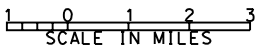

LOCATION IN LOUISIANA
(JEFFERSON PARISH)



"AS-BUILT PLANS"

SUBMITTED BY: DALE J. GARBER 9/27/01
GOVERNMENT REPRESENTATIVE DATE
APPROVED BY: BRADLEY A. STICKER 9/28/01
ASSISTANT STATE CONSERVATION DATE
ENGINEER
E. J. GIERING III 9/28/01
STATE CONSERVATION ENGINEER DATE

Contract No. 50-7217-1-3 Date 9/27/01
Contractor LEON DUPLESSIS AND SONS, INC.
Inspector ROBERT PAYTON
Date of Completion 5/21/01

"AS-BUILT"

LEGEND

- PROJECT AREA
— STATE HIGHWAY
— PARISH BOUNDARY

INDEX OF DRAWINGS

SHEET	NAME
1	COVER SHEET-VICINITY MAP
2	SITE PLAN-EAST BANK ROCK DIKE
3	PLAN VIEW-SOIL BORING SITES
4	PLAN VIEW-NORTH DIKE
5	PLAN VIEW-SOUTH DIKE
6	DETAILS-ROCK DIKE
SUPPLEMENTAL AS BUILT DRAWINGS	
6A	MOD. #2 - ROCK FILL, WEST BANK - AS-BUILT
6A1	PROFILE ON CL - AS BUILT
6A2	PROFILE ON CL - AS BUILT
6A3	PROFILE ON CL - AS BUILT
6A4	X-SECTIONS - AS BUILT
6A5	X-SECTIONS - AS BUILT
6A6	X-SECTIONS & SETTLEMENT PLATE LOCATIONS - AS BUILT

BARATARIA BAY WATERWAY EAST BANK
PROTECTION PROJECT PBA-12B/BA-26
CONSTRUCTION UNIT NO. 1
BUILT UNDER COASTAL WETLANDS PLANNING,
PROTECTION AND RESTORATION ACT OF
PUBLIC LAW 101-646
BY
LOUISIANA DEPARTMENT OF NATURAL RESOURCES
WITH THE ASSISTANCE OF
NATURAL RESOURCES CONSERVATION SERVICE
OF THE
UNITED STATES DEPARTMENT OF AGRICULTURE
2000

COVER SHEET - VICINITY MAP		Date	02/00
BBWW EAST BANK PROTECTION		Approved by E.J. GIERING III	02/00
PROJECT NO. PBA-12B/BA-26		Title	STATE CONSERVATION ENGINEER
JEFFERSON PARISH, LOUISIANA		Title	
U.S. DEPARTMENT OF AGRICULTURE - NATURAL RESOURCES CONSERVATION SERVICE		Date	02/00
		Designed	J. CHUA
		Drawn	D. WILLMORE
		Traced	
		Checked	J. MOORE
CAD FILE NO.		LA-306A	
DRAWING NO.		LA306A01.DGN	
SHEET NO. 1 OF 6			

REVISIONS <table border="1"> <tr> <th>DATE</th> <th>APPR.</th> <th>TITLE</th> </tr> <tr> <td>11/00</td> <td>JEC</td> <td>CIVIL ENGINEER</td> </tr> <tr> <td> </td> <td> </td> <td> </td> </tr> <tr> <td> </td> <td> </td> <td> </td> </tr> <tr> <td> </td> <td> </td> <td> </td> </tr> <tr> <td> </td> <td> </td> <td> </td> </tr> </table>			DATE	APPR.	TITLE	11/00	JEC	CIVIL ENGINEER													SITE PLAN - EAST BANK ROCK DIKE BBWW EAST BANK PROTECTION PROJECT NO. PBA-12B/BA-26 JEFFERSON PARISH, LOUISIANA		Date Approved by E.J. GIERING III 02/00 Title STATE CONSERVATION ENGINEER	
DATE	APPR.	TITLE																						
11/00	JEC	CIVIL ENGINEER																						
CAD FILENAME LA306A02G.DGN			Date Designed J. CHUA 05/99 Drawn D.J. WILMORE 05/99 Traced Checked J. MOORE 02/00		Title Title																			
PROJECT NO. LA306A			U.S. DEPARTMENT OF AGRICULTURE - NATURAL RESOURCES CONSERVATION SERVICE																					
SHEET NO. 2 OF 6																								

LANDOWNERS:

- | | |
|-----|------------------------|
| 001 | - JAMES WEBB. ET AL |
| 002 | - BURLINGTON RESOURCES |

PIPELINES:

CREOLE GAS PIPELINE	1-888-650-8099
EOUILON PIPELINE CO.	504-340-8761
BRITISH PETROLEUM	1-800-272-3020

"AS-BUILT"



ADDED AMENDMENT #1

NOTE:
Known Pipelines And Utilities Are Shown On This Sheet Of The Plans. However, It Is Possible That Some May Exist That Have Not Been Shown. The Contractor Shall Be On The Alert For Such Pipelines And Shall Report Them Immediately To The COTR.

The Natural Resources Conservation Service Does Not Guarantee The Completeness And Accuracy Of Ownership Show. Apparent Ownership Has Been Obtained From Maps In The Office Of The Parish Clerk Of Court Or The Tax Assessor. Where An Apparent Property Line Is Shown Near The Centerline Of A Channel, Its Location Is Not Definite.

**NOTICE:
48 HOURS BEFORE DIGGING
CALL 1-800-272-3020
TO LOCATE UTILITY LINES**

- SECTION NO.
- TOWNSHIP BOUNDARY
- SECTION LINE
- LANDOWNER CODE
- PROPERTY BOUNDARY
- PROJECT BOUNDARY
- PIPELINE

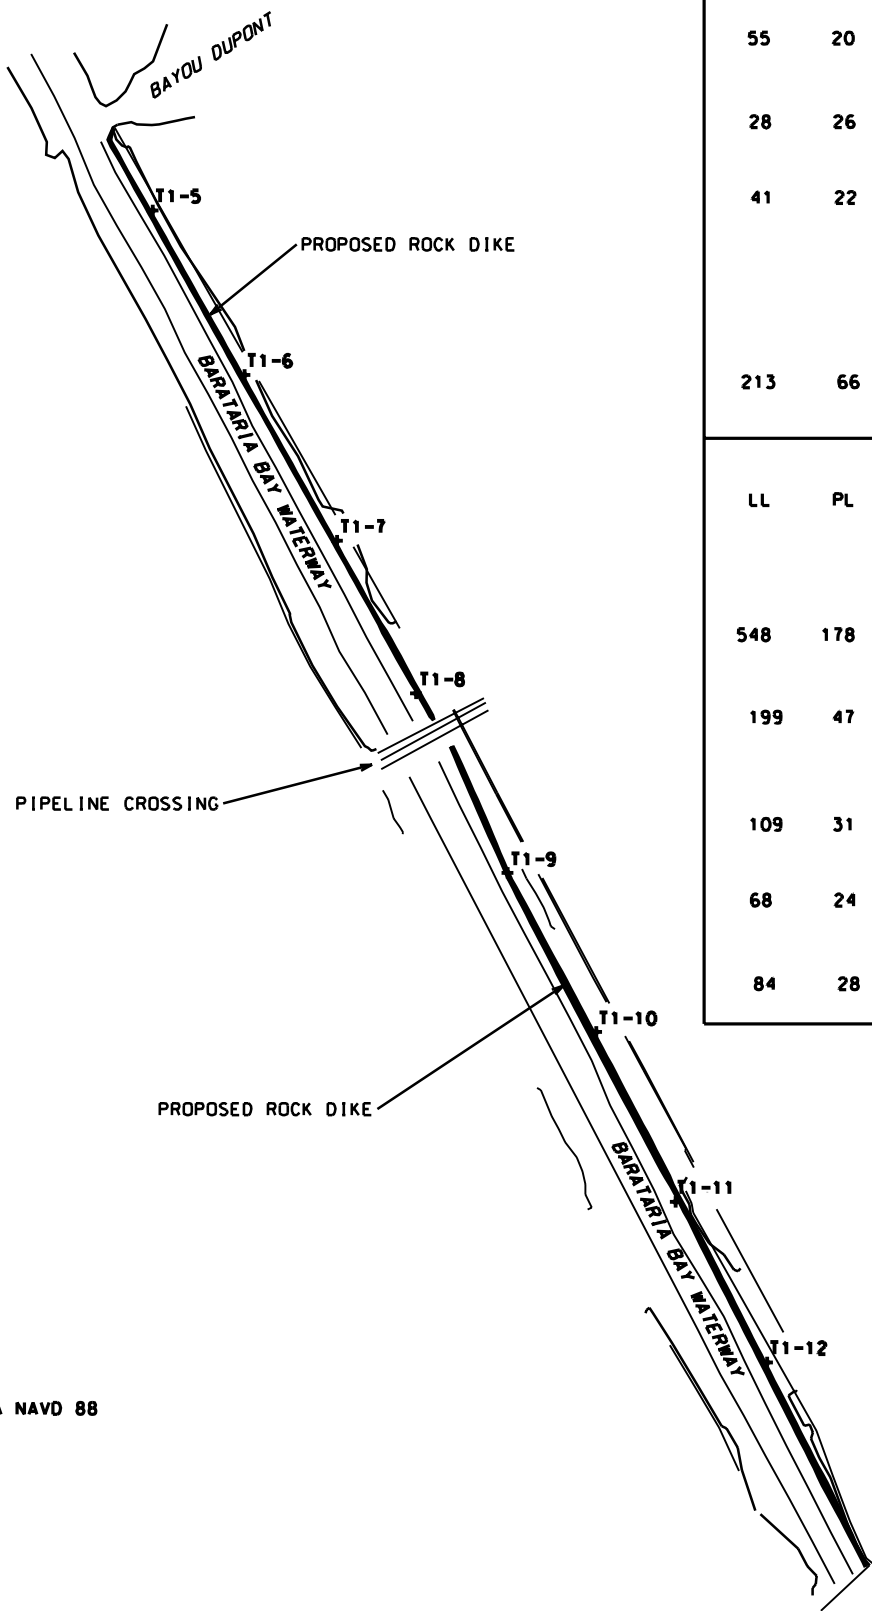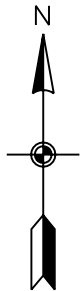

"AS-BUILT"

T1-5						T1-6						T1-7					
LL	PL	W		DD	C	LL	PL	W		DD	C	LL	PL	W		DD	C
55	20	43	-1.3	80	140			592	-1.3					267	-1.6	22	100
		35	-5.3			306	112	602	-5.3	10	60				-5.6		
28	26	25	-7.3	79	420	43	20	41	-7.3			314	82	213		42	30
		43	-9.3			69	25	60	-11.3	55	140	291	114	147			
41	22	34	-11.3					84	-17.3					163	-13.6		
		44	-15.3	73	520			195	-21.3	30	130			39	-15.6	53	80
		47						177		86	310			89			
		94				34	NP	39				91		91			
213	66	129		38	330			36				91	28	88		56	30
		127	-21.3												-21.6		

T1-8						T1-9						T1-10					
LL	PL	W		DD	C	LL	PL	W		DD	C	LL	PL	W		DD	C
548	178	611	-2.7			381	83	83	-2.3					581	-2.6	10	40
		187	-4.7	31	40			148		35	90			128	-4.6		
199	47	164				292	65	157	-8.3	18	80	139	39	148		22	60
		144		35	80			307						257			
		171	-12.7			367	101	226	-18.3	29	30	301	74	223	-12.6		
109	31	92		49	70			230						75			
		95						182				114	31	111			
68	24	72						129	-22.3	52	80			102		45	50
		90				100	30	73				98	36	92			
84	28	86	-22.7					88						81	-22.6		

T1-11						T1-12					
LL	PL	W		DD	C	LL	PL	W		DD	C
35	26	33	-2.9					194	-2.7	28	30
		83	-4.9	58	90			215	-4.7		
		41	-8.9					178	-6.7	30	60
		183	-10.9					89	-8.7		
47	25	57	-12.9			98	76	72		57	90
		39						56			
40	28	36	-16.9			95	35	76	-16.7		
		55	-18.9	70	250	39	24	43	-20.7		
39	27	41						32	-22.7	96	350
		31	-22.9			29	26	29			

PLAN VIEW-SOIL BORING SITES
BBWW EAST BANK PROTECTION
PROJECT NO. PBA-12B/BA-26
JEFFERSON PARISH, LOUISIANA

REVISIONS

DATE	APPR.	TITLE

CAD FILENAME
LA306A03.DGN

PROJECT NO.
LA306A


SHEET NO. 3 OF 6

U.S. DEPARTMENT OF AGRICULTURE - NATURAL RESOURCES CONSERVATION SERVICE

DESIGNED: J. CHUA
DRAWN: D.J. WILMORE
TRACED: J. MOORE
CHECKED: J. MOORE

DATE: 07/99
APPROVED BY: E.J. GIERING III
TITLE: STATE CONSERVATION ENGINEER

DATE: 02/00

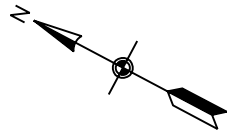

ROCK DIKE LOCATIONS		
STATION#	HORIZ.COORD.**	APPROX. DIST. FROM R-O-W CL
STA.1494+16 PI-7	N417631.021 E3674002.405	283'
STA.1493+26 PI-6	N417507.915 E3673962.303	190'
STA.1424+09 PI-5	N411469.88 E3677339.810	350'


•NOTE: STATIONING REFERENCED TO U.S. ARMY C.O.E.
DREDGE SURVEY
•NOTE: NAD83 DATUM

PIPELINES:

CREOLE GAS PIPELINE
EQUILON PIPELINE CO.
BRITISH PETROLEUM

1-888-650-8099
504-340-8761
1-800-272-3020

SEE SPECIAL PROVISIONS FOR ADDITIONAL
INSTRUCTIONS WHEN WORKING NEAR PIPELINES

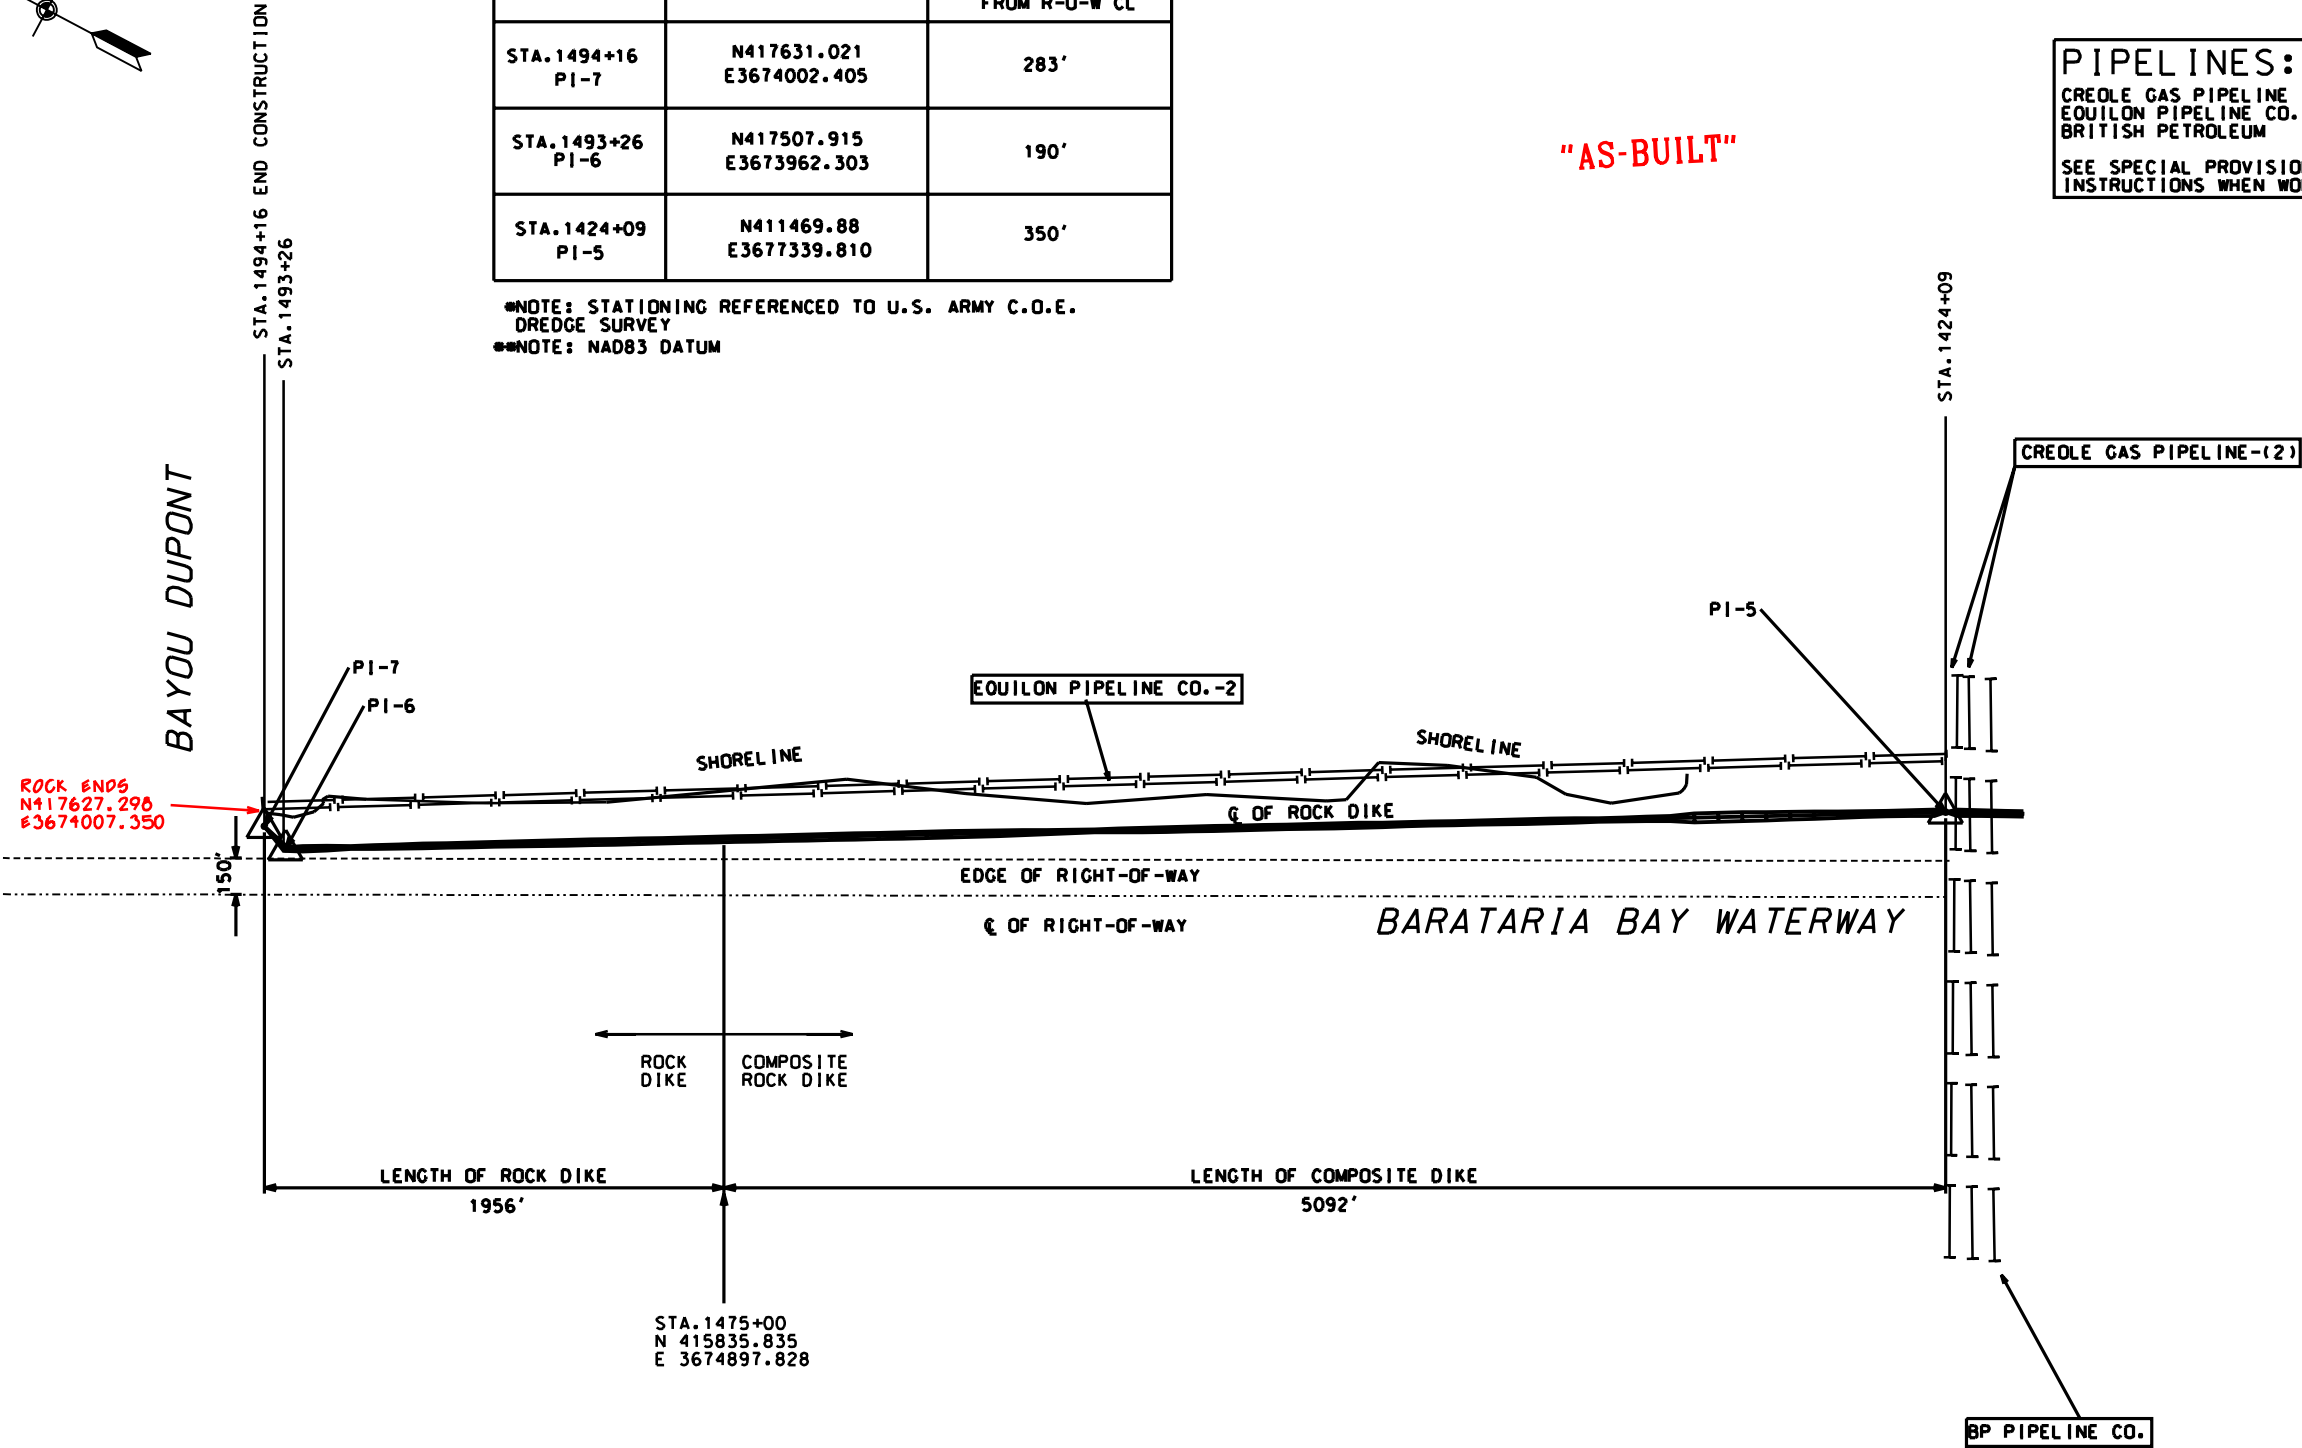

NOTE :
CONSTRUCTION AT PI-7 TO BE TIED
INTO EXISTING BANK AS STAKED BY COTR.

Date		Approved by	E.J. GIERING, III	11/99
Title		STATE CONSERVATION ENGINEER		
Date		Designed	J. CHUA	06/99
Title		Drawn	D.J. WILMORE	06/99
Title		Traced	J. MOORE	06/99
Title		Checked	J. MOORE	06/99

PLAN VIEW - NORTH DIKE
BBWW EAST BANK PROTECTION
PROJECT NO. PBA-12B/BA-26
JEFFERSON PARISH, LOUISIANA


U.S. DEPARTMENT OF AGRICULTURE - NATURAL RESOURCES CONSERVATION SERVICE

DATE	APPR.	REVISIONS	TITLE


CAD FILENAME
LA306A04.DGN

PROJECT NO.
LA306A


SHEET NO. 4 OF 6

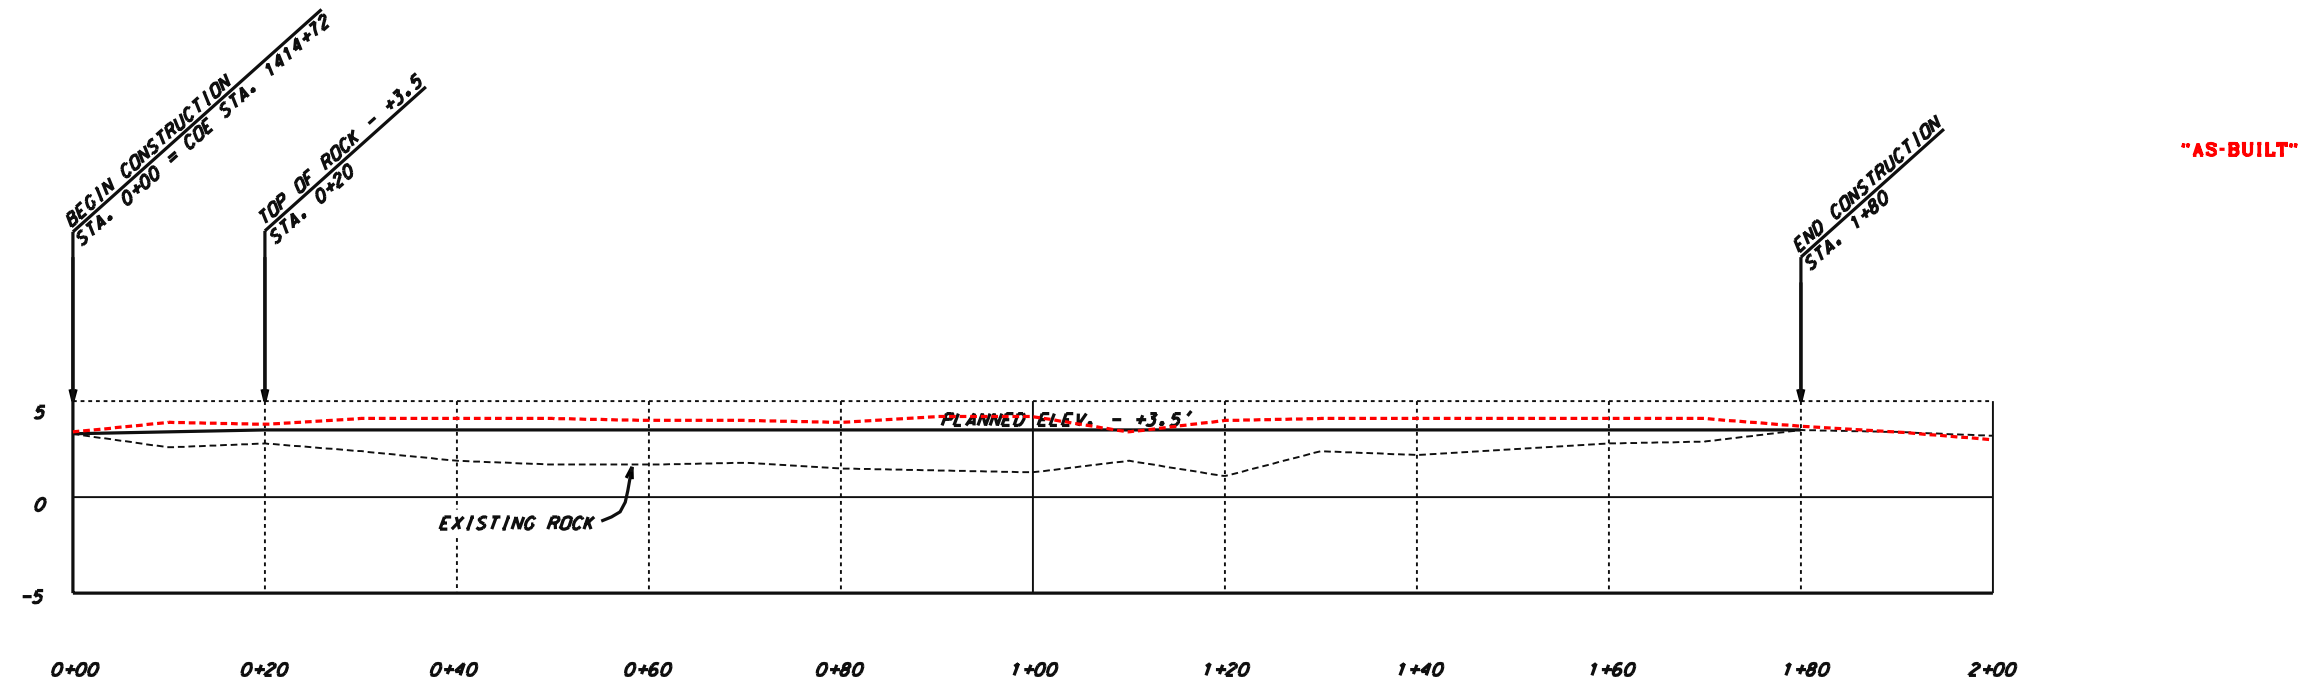


PROFILE
BARATARIA WATERWAY - WEST BANK

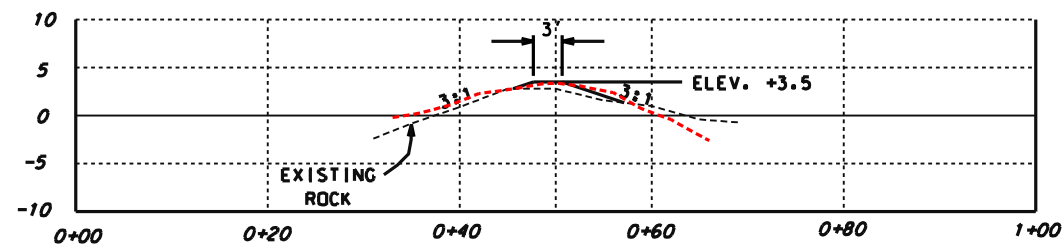


STA. 0+20
AS-BUILT SECTION @ STA 0+00

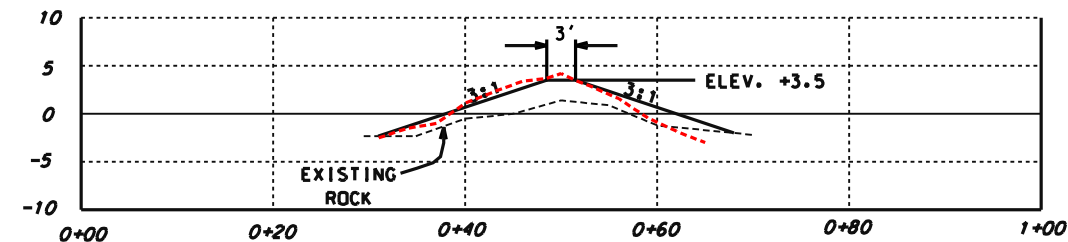

STA. 0+90
AS-BUILT SECTION @ STA 1+00

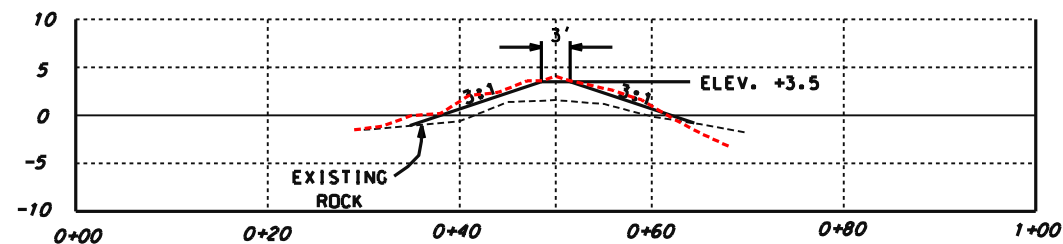




STA. 0+70
AS-BUILT SECTION @ STA 0+50

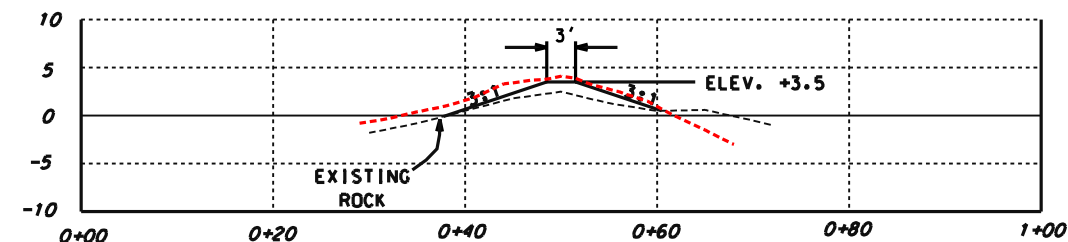

STA. 1+50
AS-BUILT SECTION @ STA 1+50

CROSS-SECTIONS

REVISED		NO. DATE APPR.		TITLE	
2	4/10/01				
MOD. #2 - ROCK FILL, WEST BANK					
BBWW EAST BANK PROTECTION					
PROJECT NO. PBA-12B/BA-26					
JEFFERSON PARISH, LOUISIANA					
U.S. DEPARTMENT OF AGRICULTURE - NATURAL RESOURCES CONSERVATION SERVICE					
CAD FILENAME		LA306A6AM2.DGN			
PROJECT NO.		LA306A			
SHEET NO		6A OF 6			
DESIGNED		B. STICKER		DATE	
DRAWN		D.J. WILMORE		04/01	
TRACED		B. STICKER		04/01	
CHECKED		B. STICKER		04/01	
APPROVED BY		E.J. GIERING III		DATE	
TITLE		STATE CONSERVATION ENGINEER		04/01	
		ALEXANDRIA, LOUISIANA			

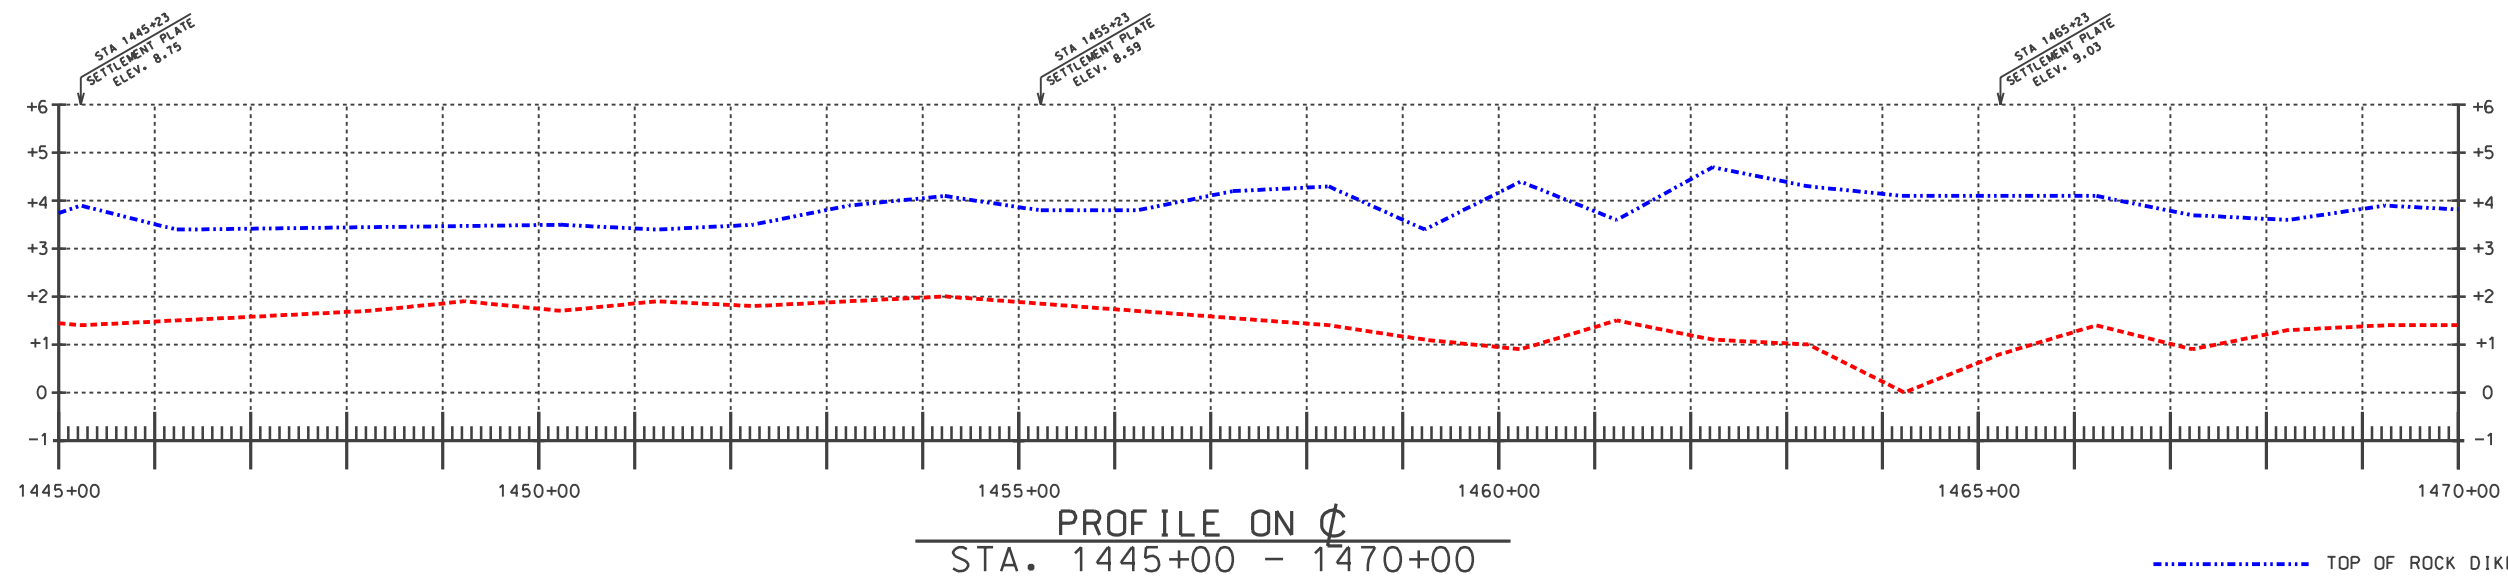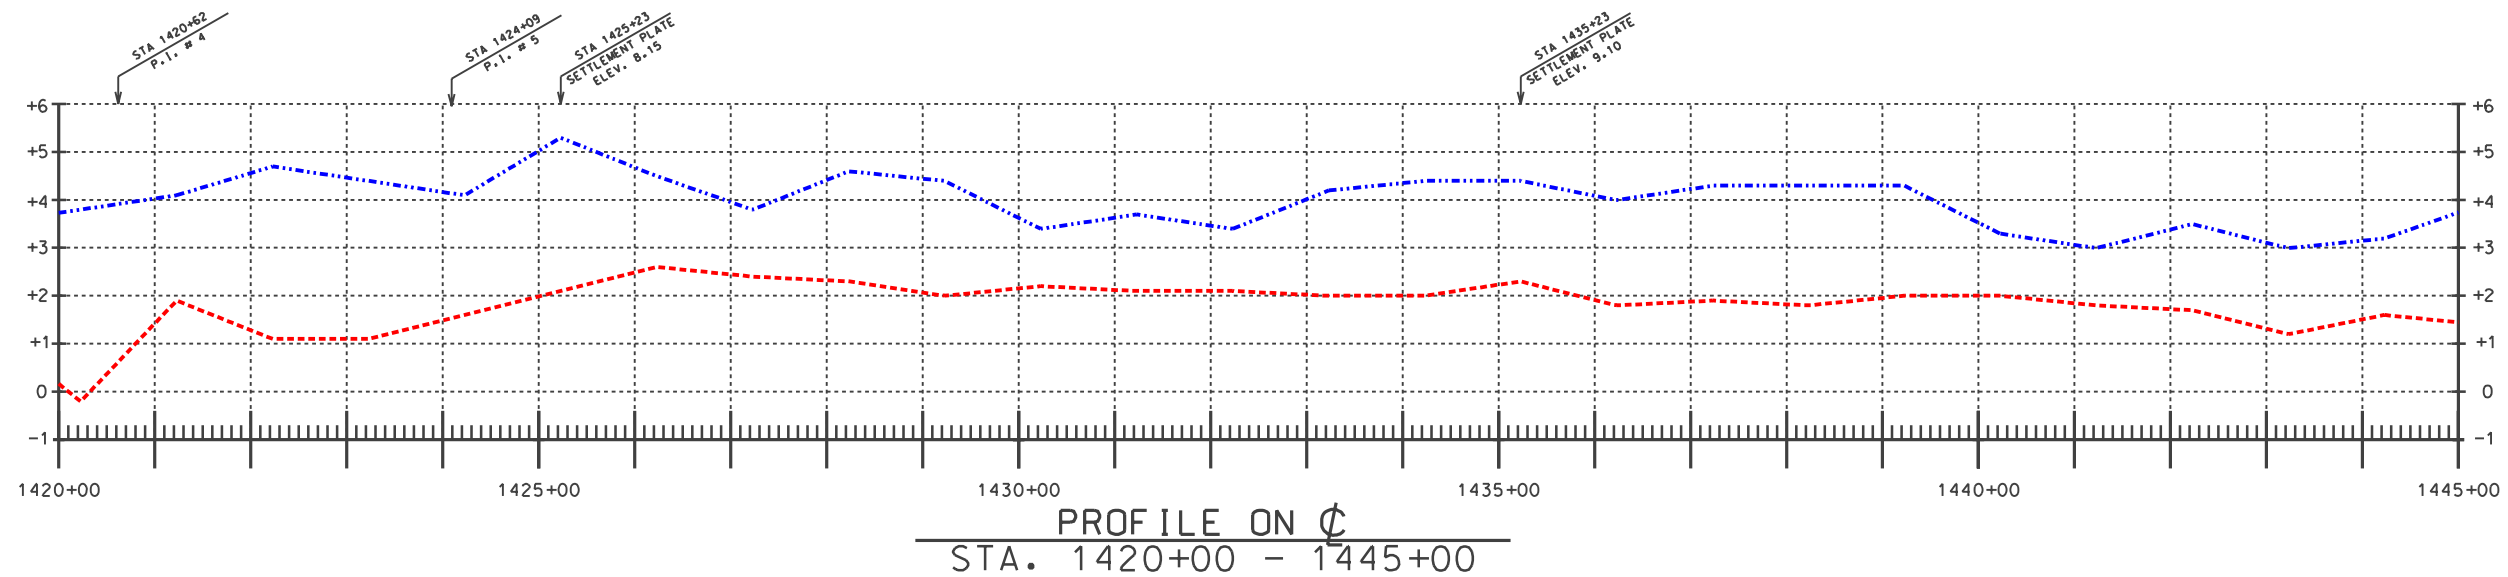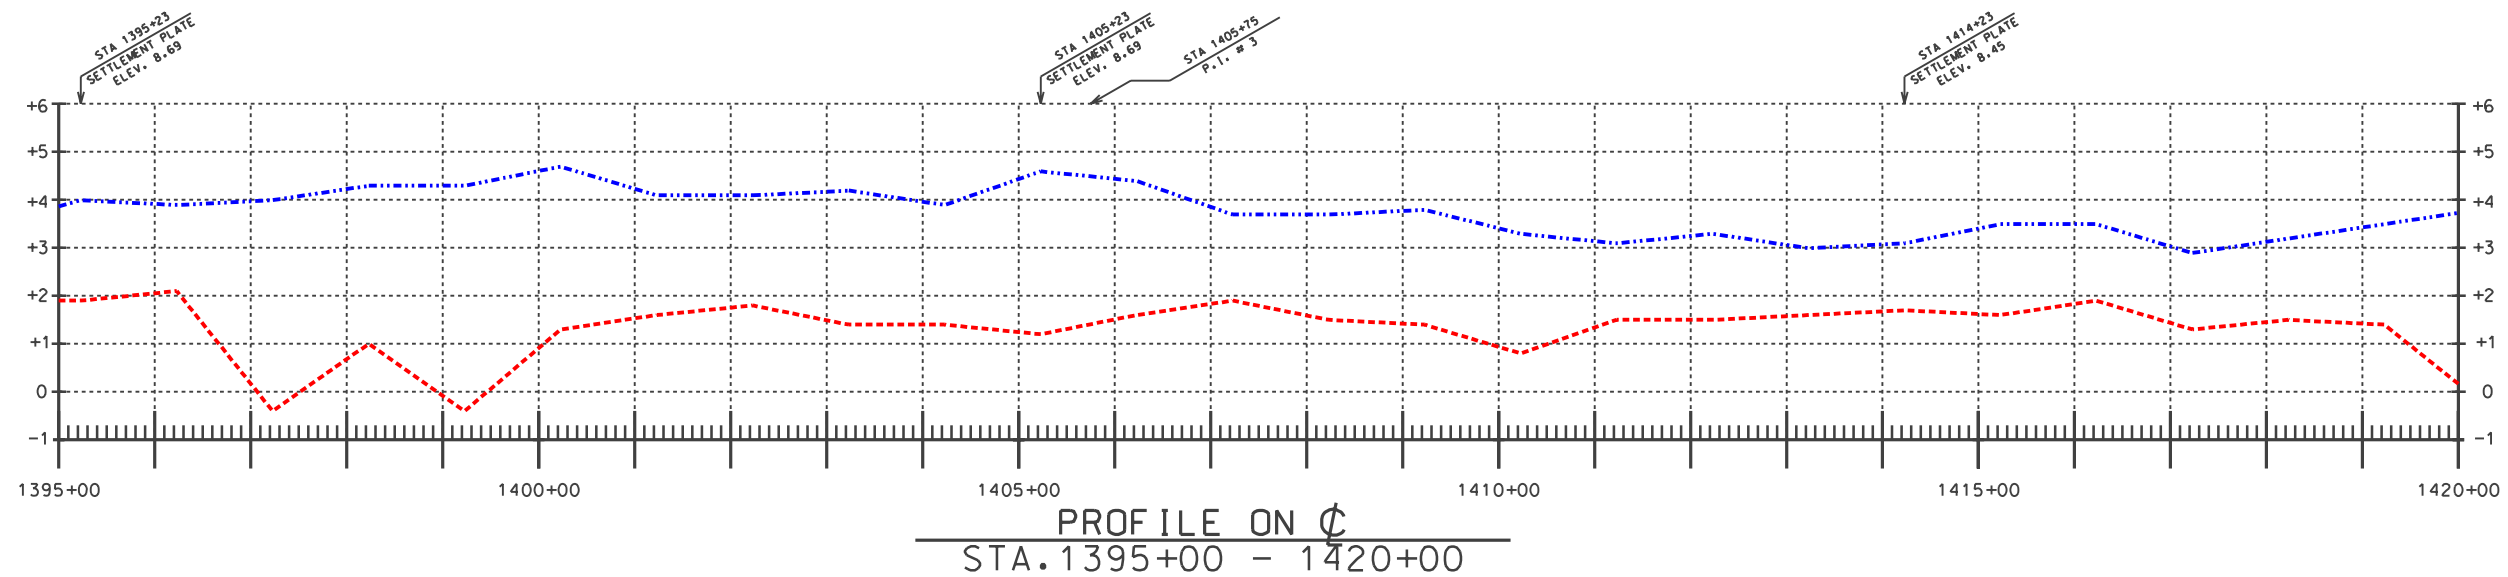

















"AS-BUILT"

..... TOP OF ROCK DIKE

----- TOP OF WEIGHT AGGREGATE BAGS

REVISIONS DATE APPR. TITLE		PROFILE ON CS - AS-BUILT BBWW EAST BANK PROTECTION PROJECT NO. PBA-12B/BA-26 JEFFERSON PARISH, LOUISIANA		U.S. DEPARTMENT OF AGRICULTURE - NATURAL RESOURCES CONSERVATION SERVICE	
CAD FILE NO. LA306A6A2		DRAWING NO. LA-306		SHEET NO 6A20F 6	
DESIGNED J. Moore DRAWN A. J. Gremillion TRACED CHECKED B. Sticker		DATE 09/00 03/02 03/02		Date Approved by E. J. GIERING III Title STATE CONSERVATION ENGINEER Title	

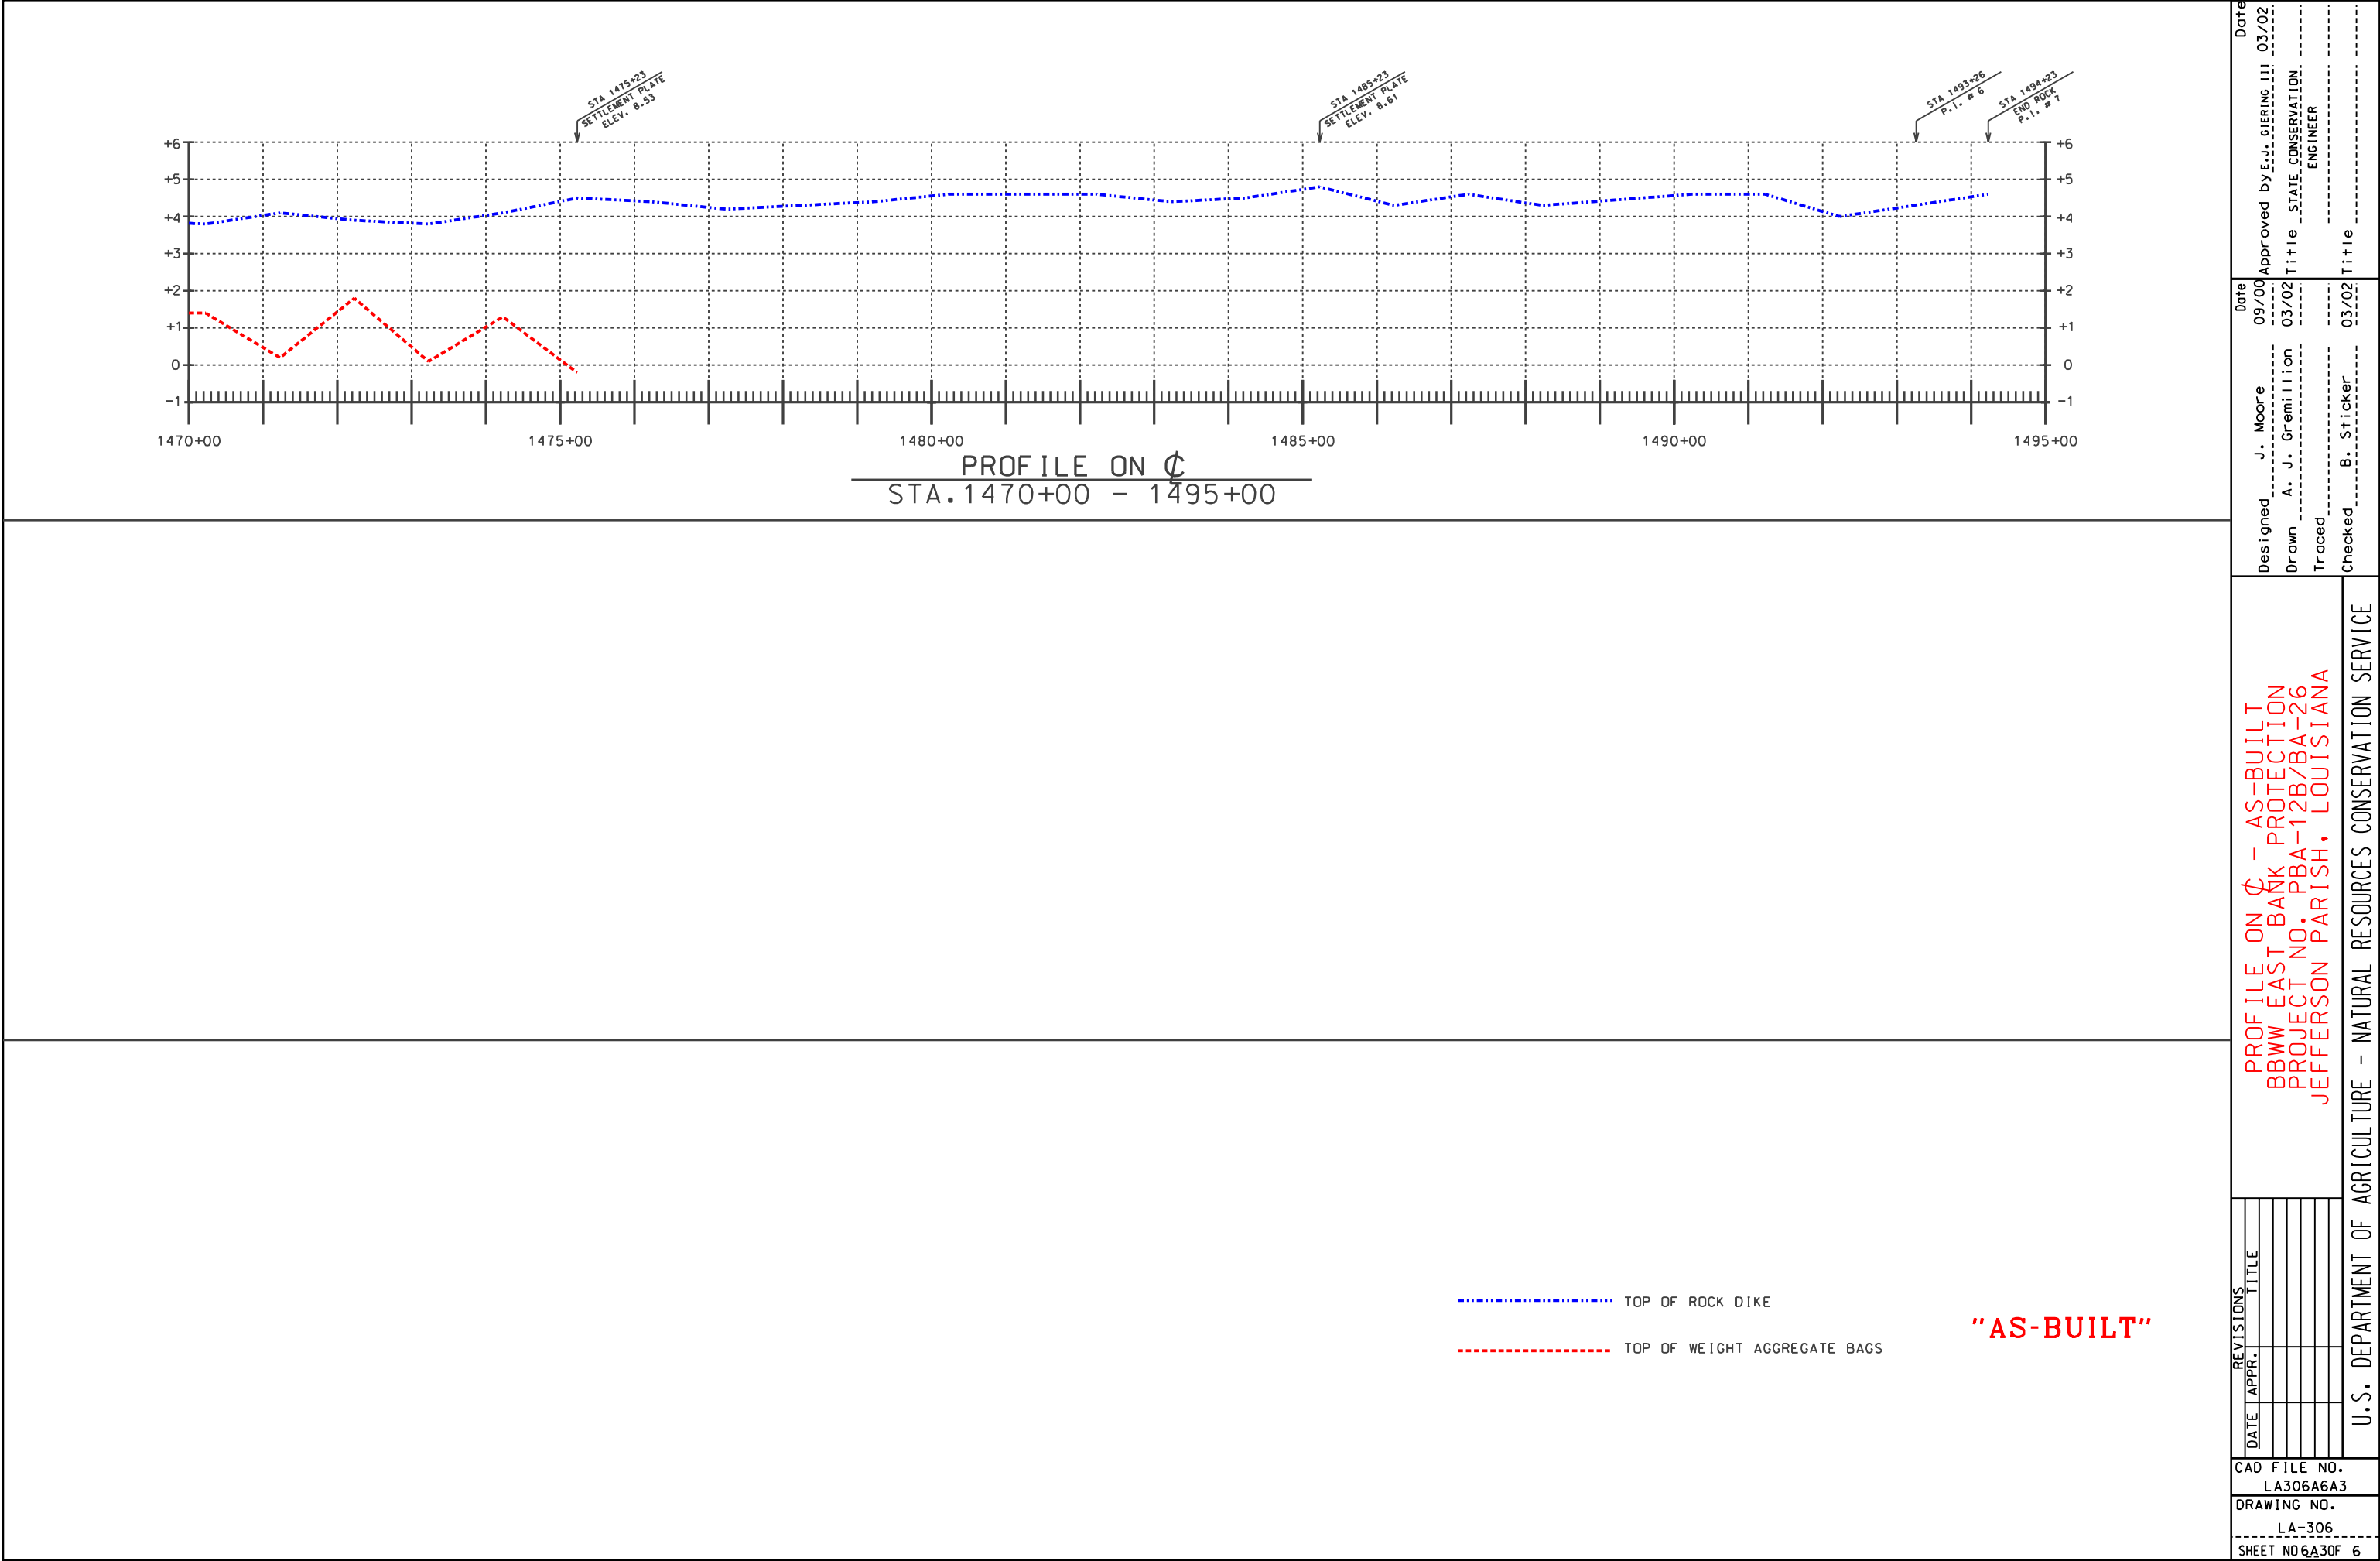

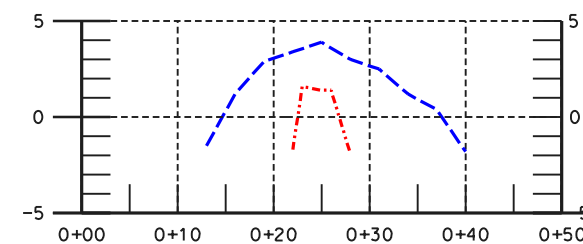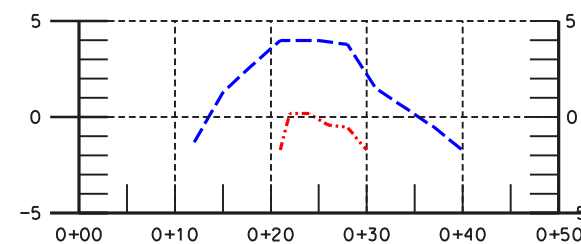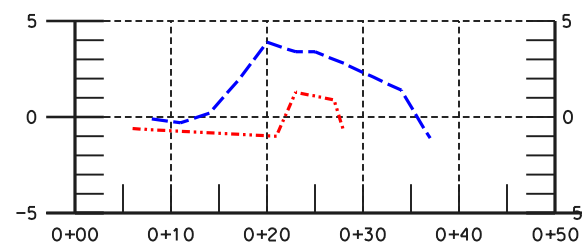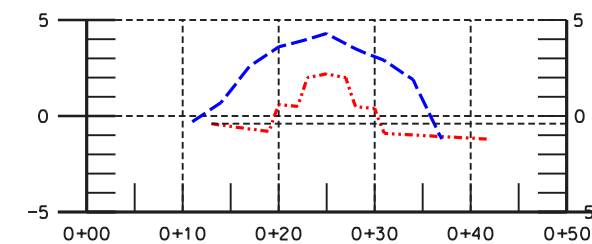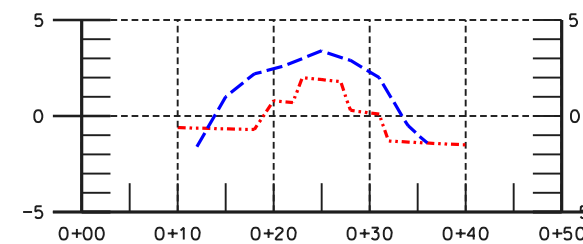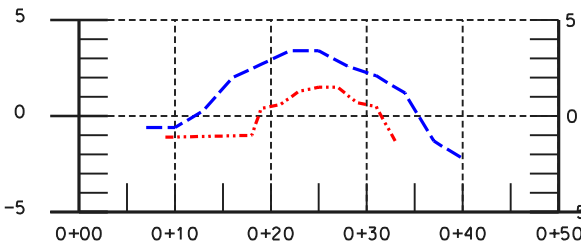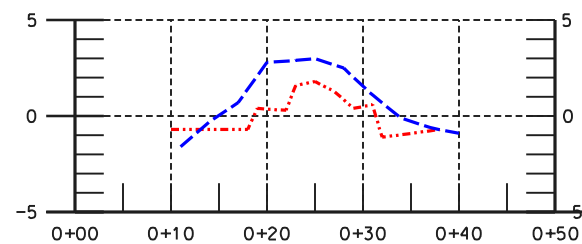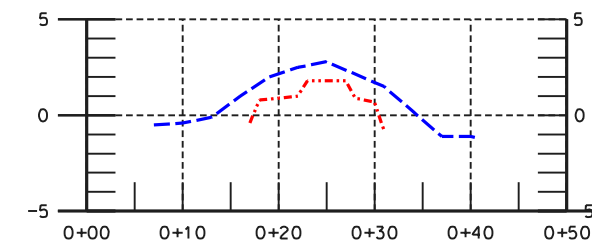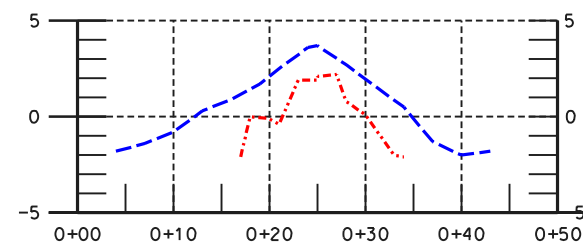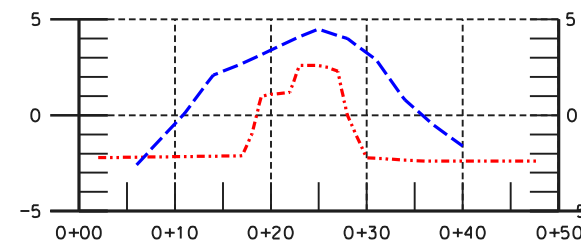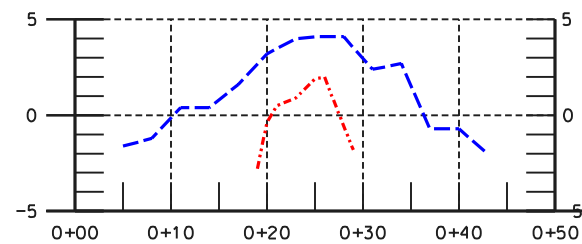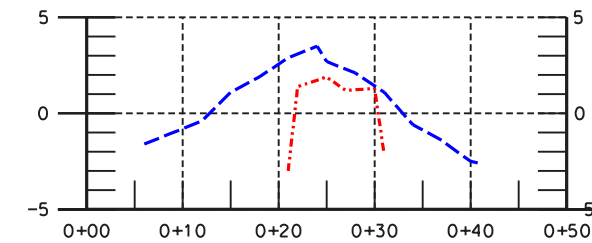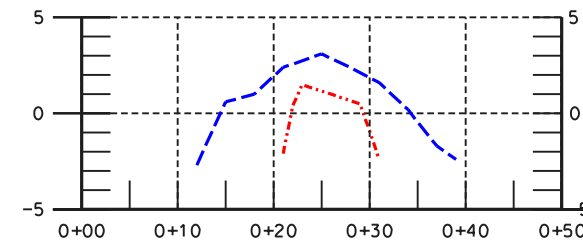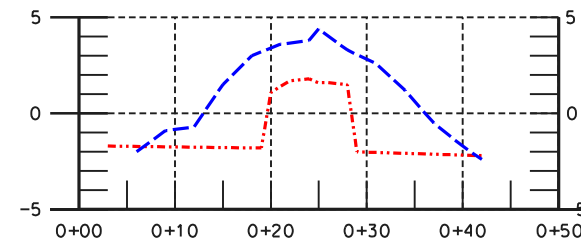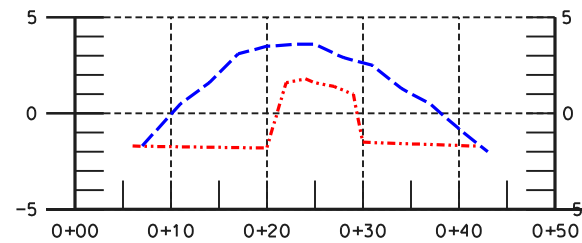

"AS-BUILT"

----- CROSS SECTIONS-ENCAPSULATED AGGREGATE

----- CROSS SECTIONS-ROCK (CONSTRUCTION CHECK)

REVISIONS		
NO.	DATE	TITLE







U.S. DEPARTMENT OF AGRICULTURE

CAD FILENAME
LA306A6A5.DGN

PROJECT NO.
LA306A

SHEET NO 6A5 OF 6

X-SECTIONS-ASBUILT
BBWW EAST BANK PROTECTION
PROJECT NO. PBA-12B/BA-26
JEFFERSON PARISH, LOUISIANA

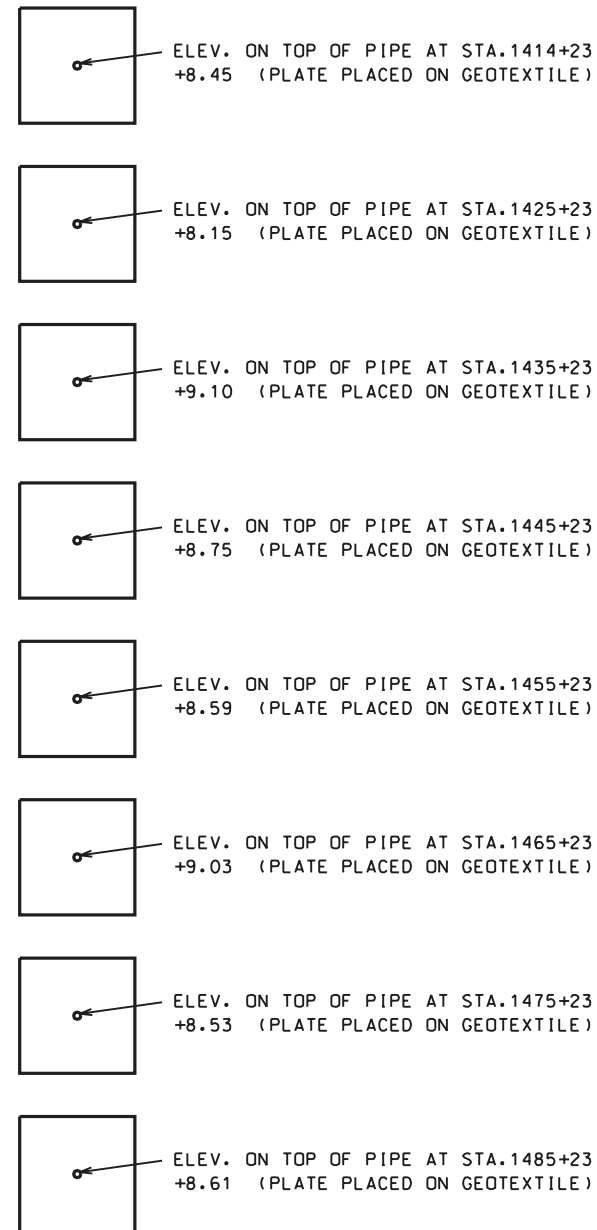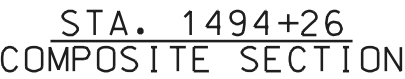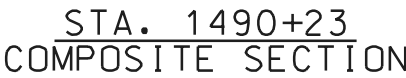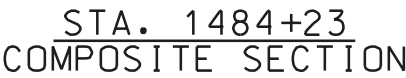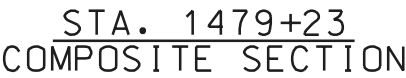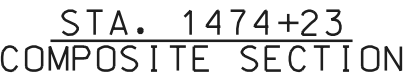

"AS-BUILT"

----- CROSS SECTIONS-ENCAPSULATED AGGREGATE
----- CROSS SECTIONS-ROCK (CONSTRUCTION CHECK)

CAD FILENAME LA306A6A6.DGN				U.S. DEPARTMENT OF AGRICULTURE - NATURAL RESOURCES CONSERVATION SERVICE			
PROJECT NO. LA306A				X-SECTIONS-SETTLEMENT PLATE LOCATION ASBUILT BBWW EAST BANK PROTECTION PROJECT NO. PBA-12B/BA-26 JEFFERSON PARISH, LOUISIANA			
SHEET NO. 6A6 OF 6				REVISIONS			
NO.		DATE		APPR.		TITLE	