



LAKE PELTO

WINE ISLAND PASS




GULF OF MEXICO

EAST ISLAND

TRINITY ISLAND

CALIFORNIA CANAL

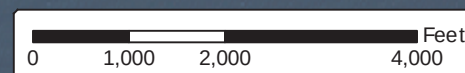

283 Corporate Drive
P.O. Box 3106
Houma, LA 70361
Voice: (985) 879-2731
Fax: (985) 876-9052

mph
Morris P. Hobert, Inc.
client focused solutions

One Sterling Place
10101 SW Freeway, Ste 400
Houston, TX 77074
Voice: (713) 219-1470
Fax: (713) 219-4171

Surveying - Engineering - Environmental Services - GIS
<http://www.mphinc.com>


2005 DOQQ
C2909059.NES
C2909059.SES
C2909059.NWS
C2909059.SWS

BLACK LAKE MARSH, INC.

AS-BUILT FOR DNR-CED (TE-37) / EPA (TE-11A)
NEW CUT VEGETATIVE PLANTINGS
TERREBONNE PARISH, LOUISIANA

NOTE:
DGPS points were taken at the
beginning and ending of the plant
rows and along each plant rows
every 1000 feet ± and at significant
changes in direction.

DRAWN BY:	GML	SHEET:	1
CHECKED BY:	DEC	SCALE:	1" equals 2,000'
APPROVED BY:	J. MURPHY	DATE:	7/24/2007
DRAWING NO.:	W:9525_BLACK LAKE\9525DNR0001A0.MXD		

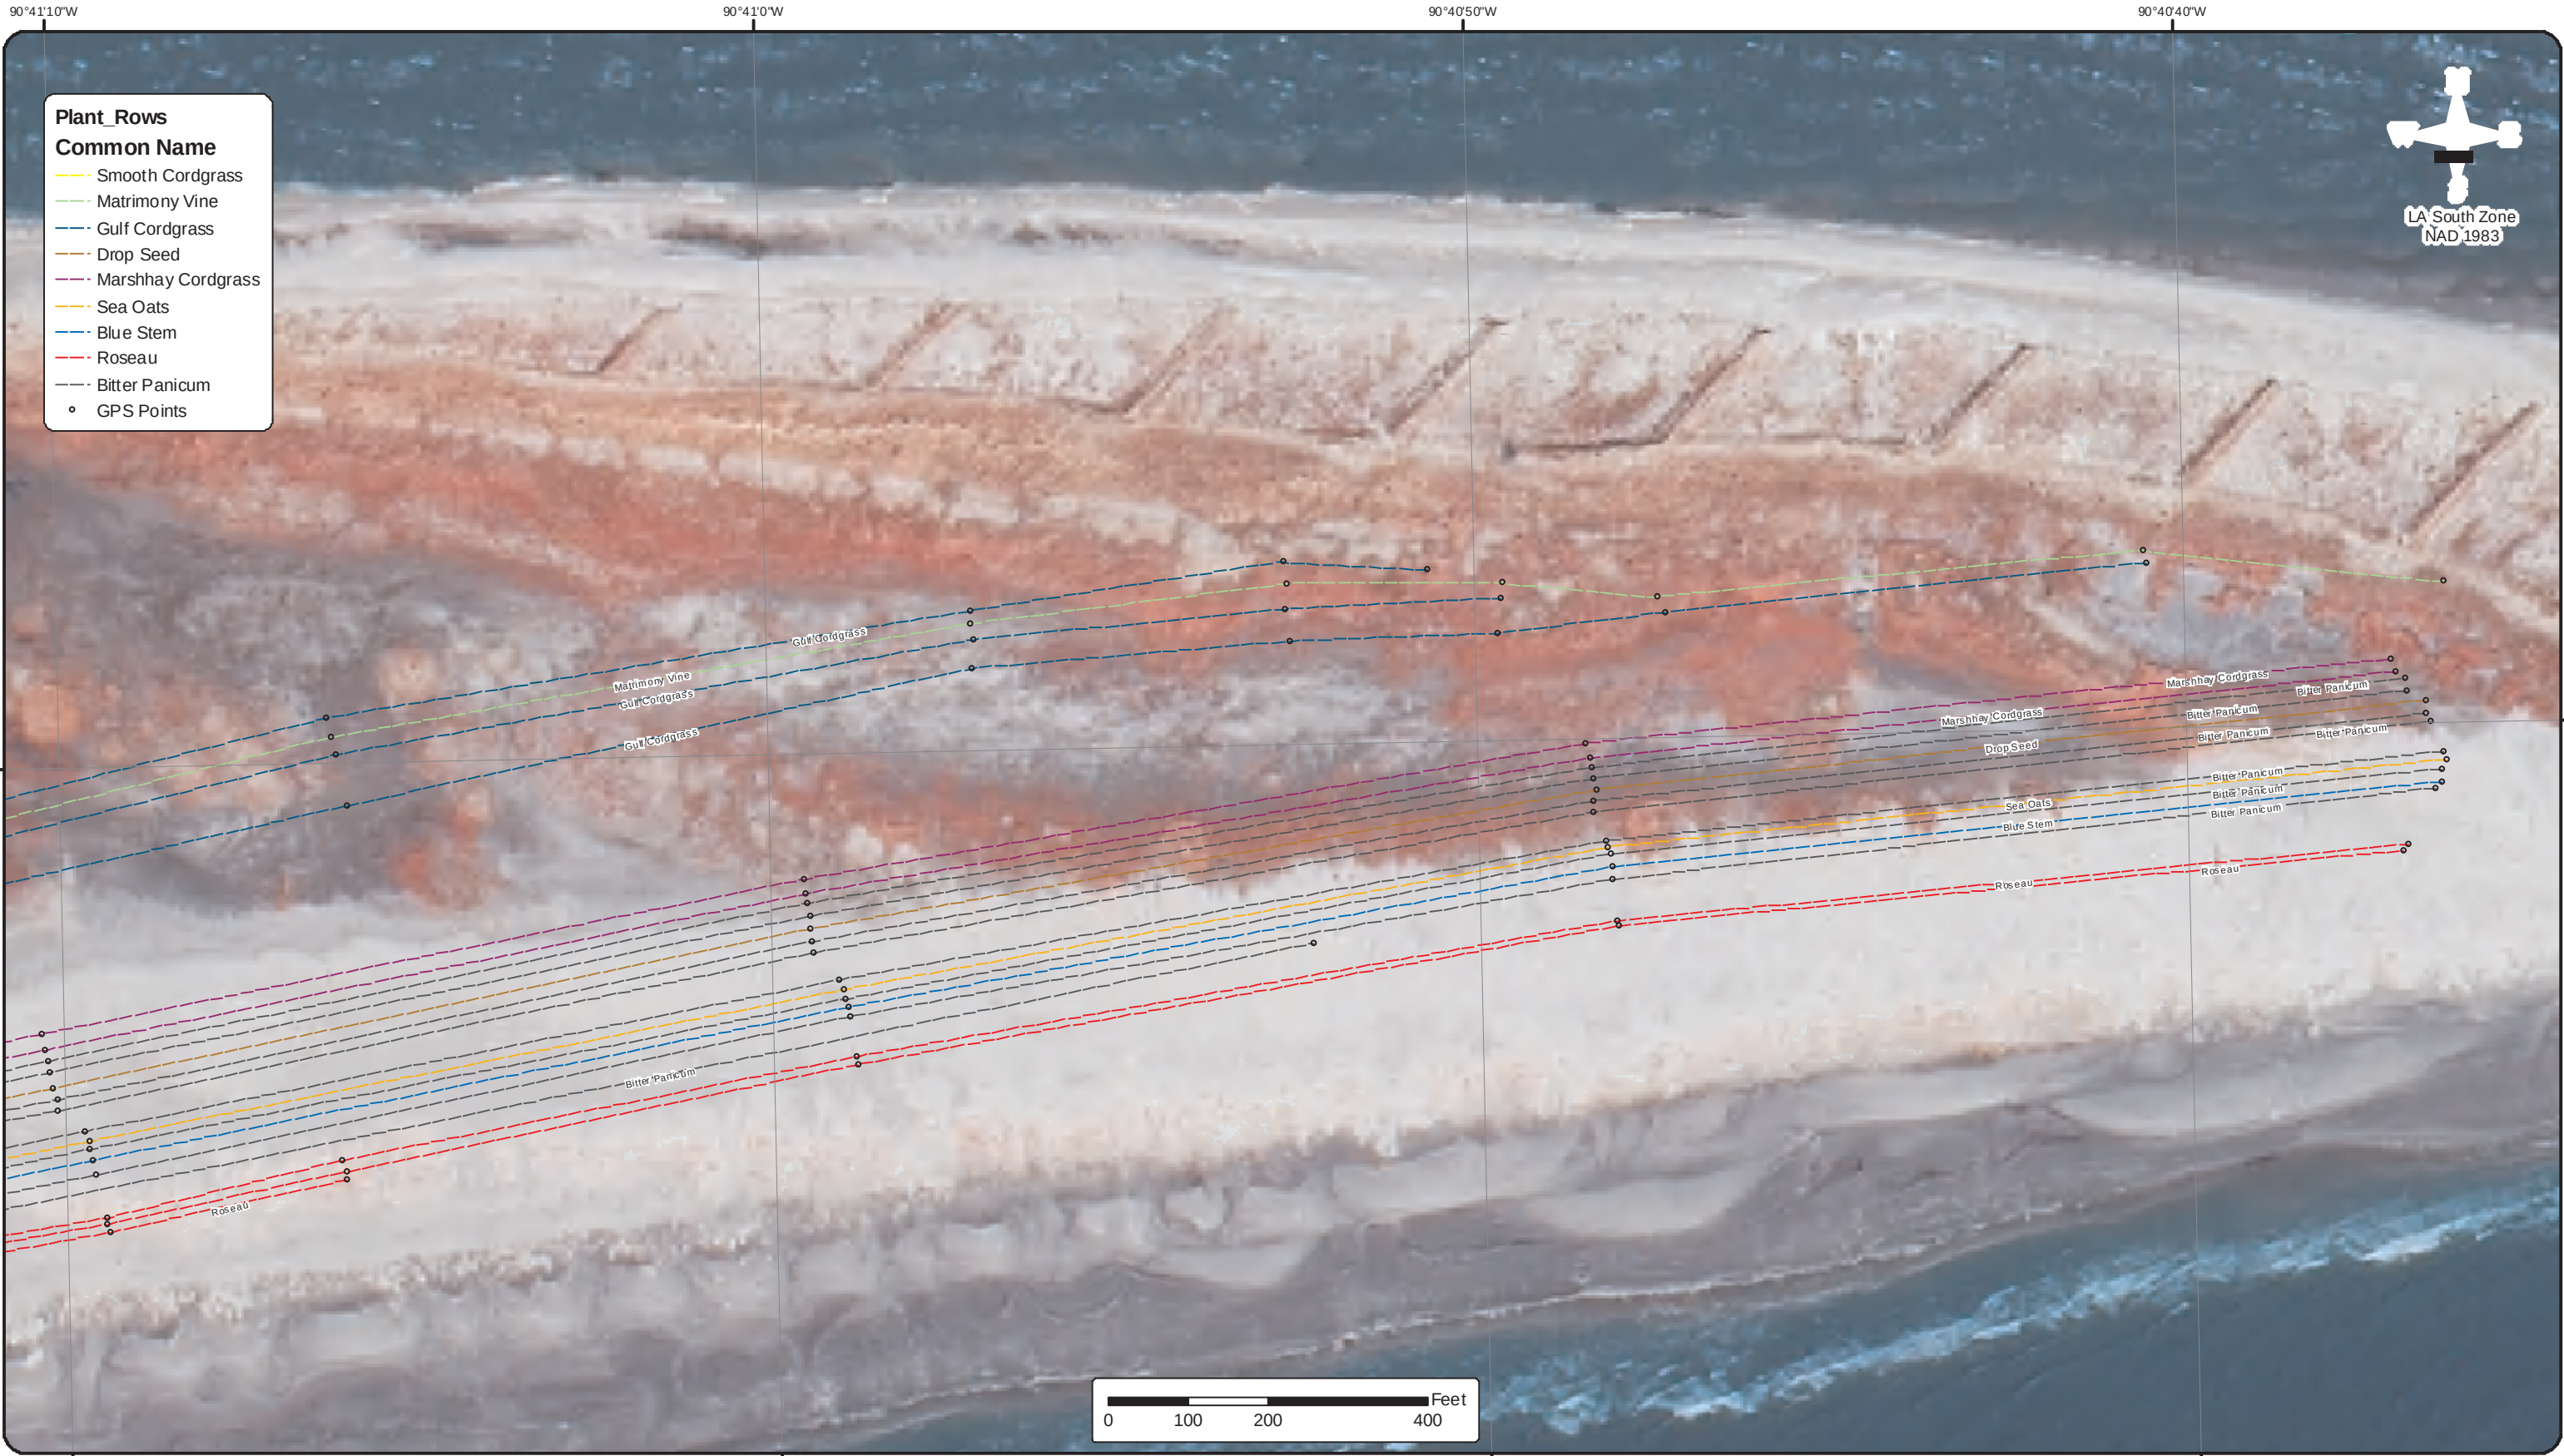

283 Corporate Drive
P.O. Box 3106
Houma, LA 70361

Voice: (985) 879-2731
Fax: (985) 876-9052



Morris P. Hobert, Inc.
client focused solutions

One Sterling Place
10101 SW Freeway, Ste 400
Houston, TX 77074

Voice: (713) 219-1470
Fax: (713) 219-4171

Surveying - Engineering - Environmental Services - GIS
<http://www.mphinc.com>


2005 DOQQ
C2909059.NES
C2909059.SES
C2909059.NWS
C2909059.SWS

BLACK LAKE MARSH, INC.

AS-BUILT FOR DNR-CED (TE-37) /EPA (TE-11A)
NEW CUT VEGETATIVE PLANTINGS
TERREBONNE PARISH, LOUISIANA

NOTE:
DGPS points were taken at the beginning and ending of the plant rows and along each plant rows every 1000 feet ± and at significant changes in direction.

DRAWN BY:	GML	SHEET:	2
CHECKED BY:	DEC	SCALE:	1" equals 200'
APPROVED BY:	J. MURPHY	DATE:	7/24/2007
DRAWING NO.:	W:9525_BLACK LAKE\9525DNR0002A0.MXD		

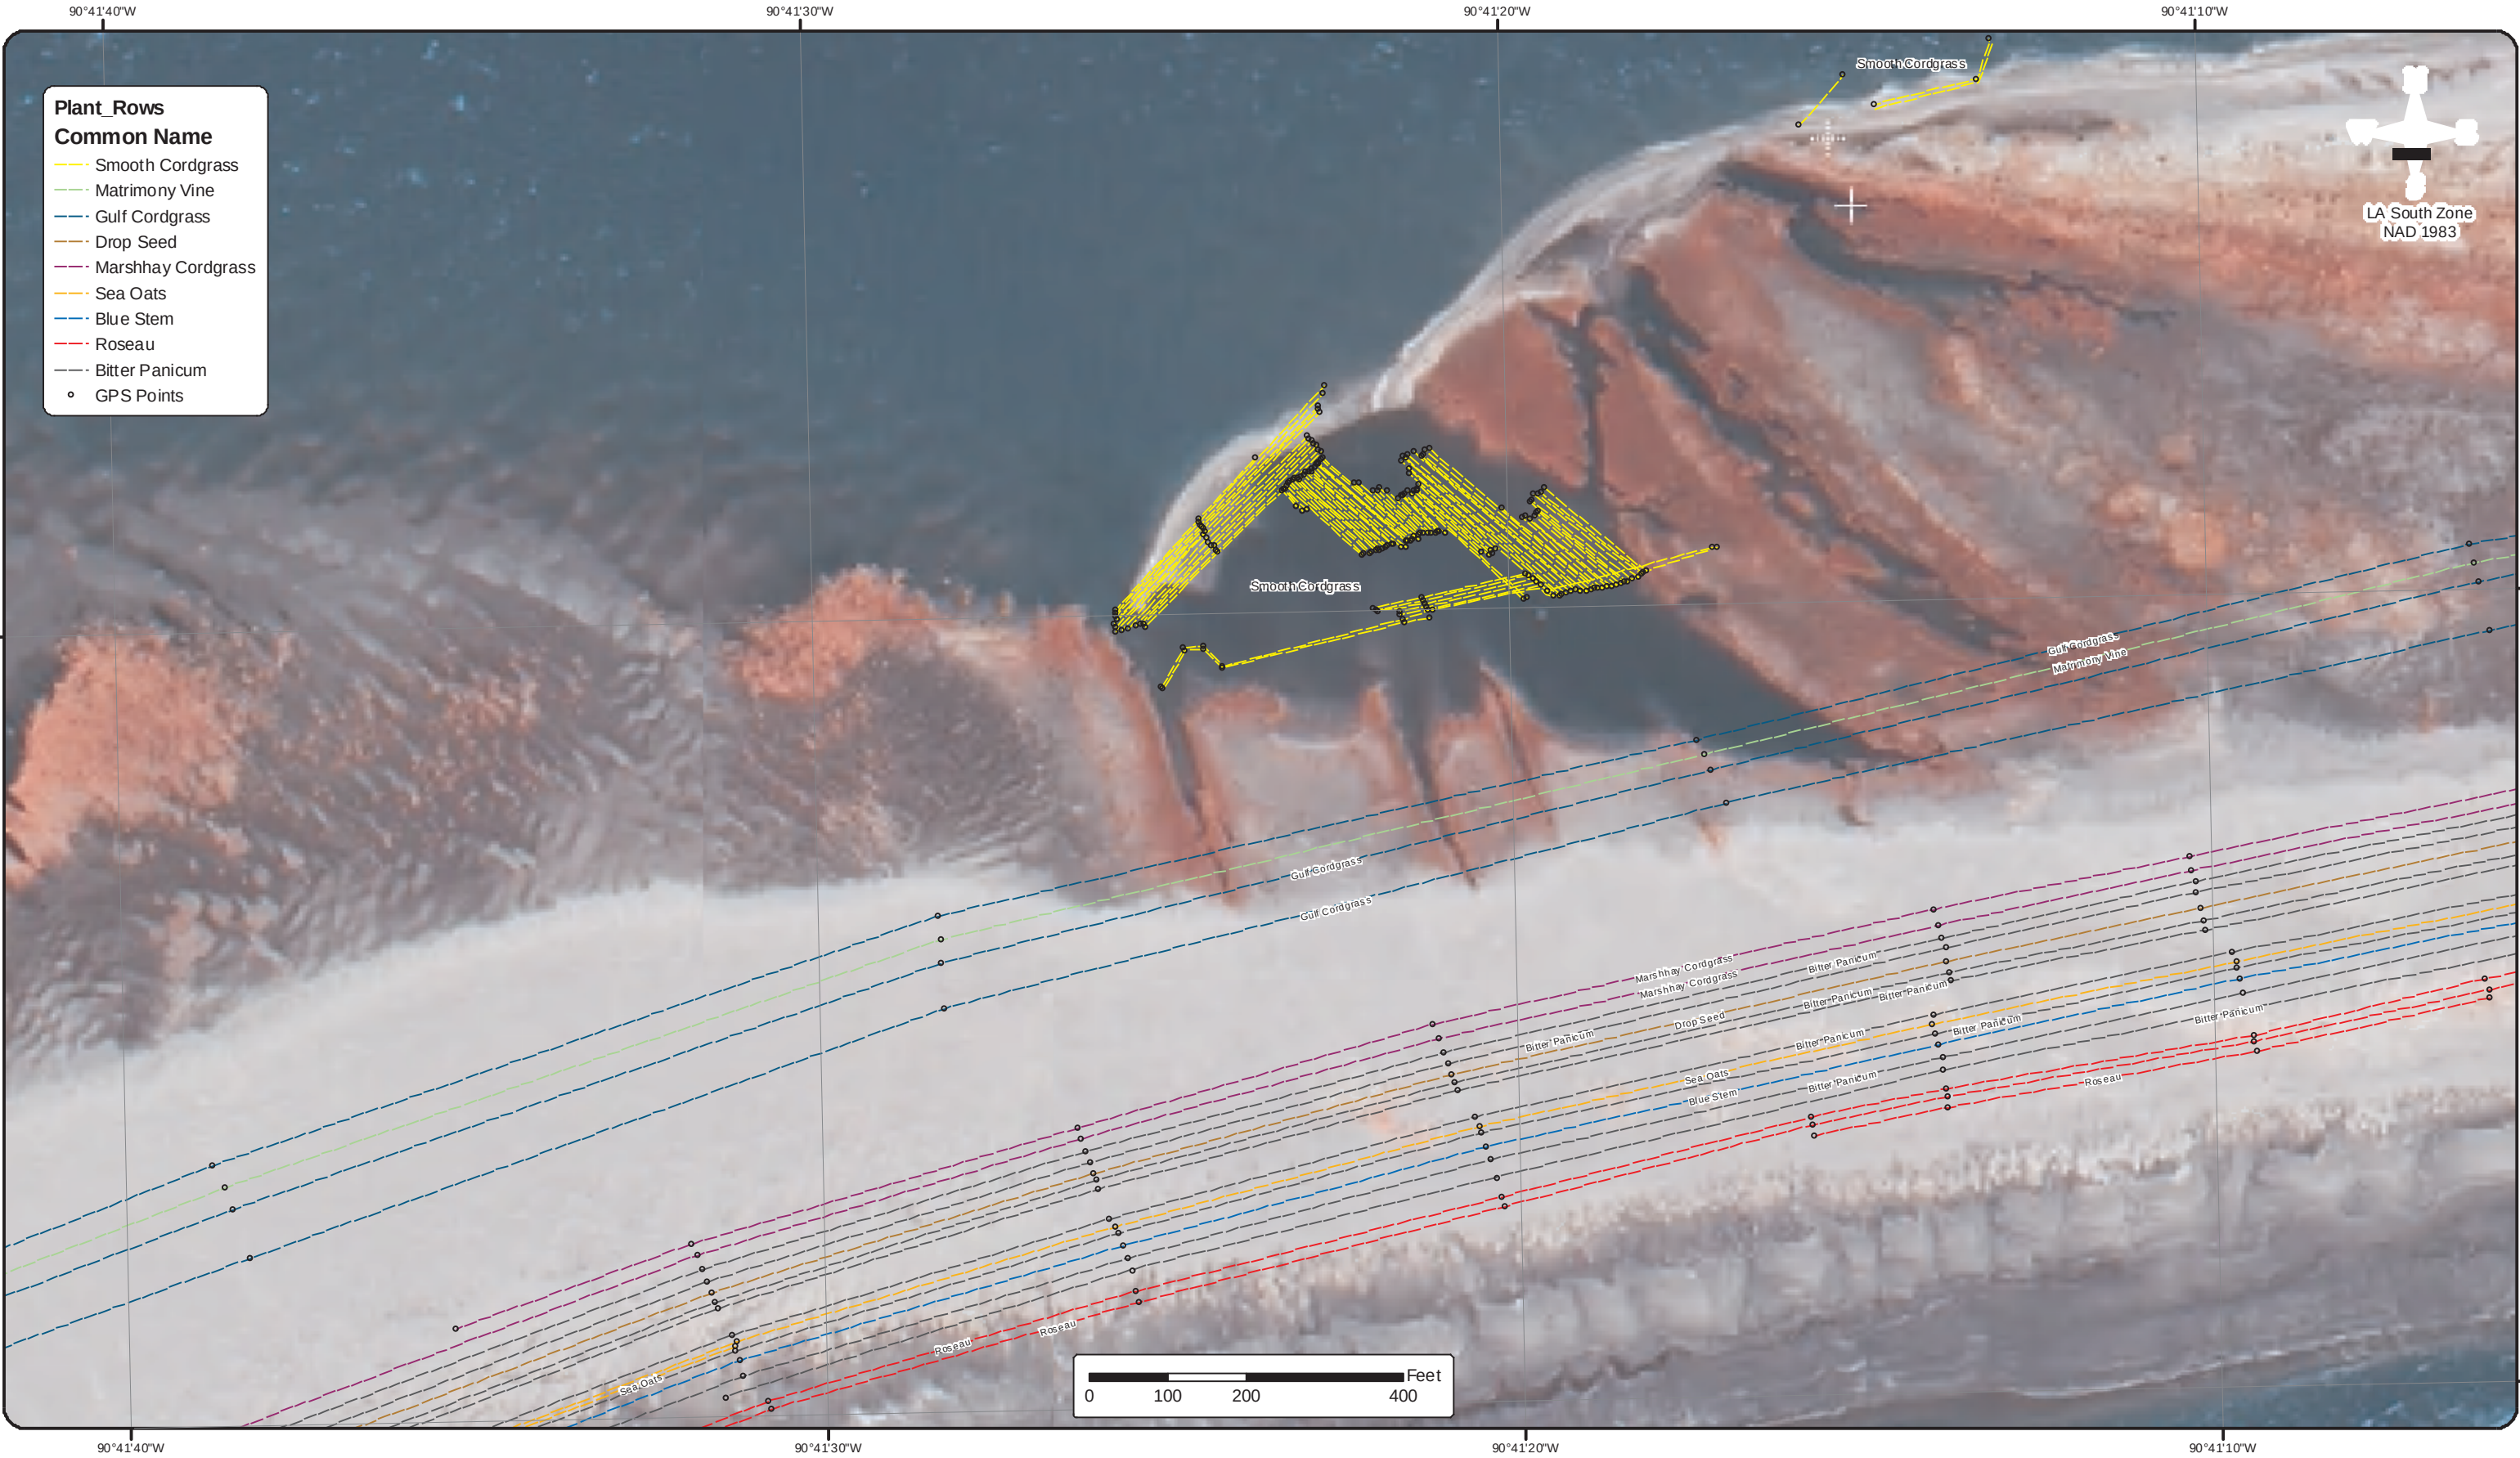

283 Corporate Drive
P.O. Box 3106
Houma, LA 70361

Voice: (985) 879-2731
Fax: (985) 876-9052



Morris P. Hobert, Inc.
client focused solutions

Surveying - Engineering - Environmental Services - GIS
<http://www.mphinc.com>

One Sterling Place
10101 SW Freeway, Ste 400
Houston, TX 77074

Voice: (713) 219-1470
Fax: (713) 219-4171


2005 DOQQ
C2909059.NES
C2909059.SES
C2909059.NWS
C2909059.SWS

BLACK LAKE MARSH, INC.

AS-BUILT FOR DNR-CED (TE-37) / EPA (TE-11A)
NEW CUT VEGETATIVE PLANTINGS
TERREBONNE PARISH, LOUISIANA

NOTE:
DGPS points were taken at the
beginning and ending of the plant
rows and along each plant rows
every 1000 feet ± and at significant
changes in direction.

DRAWN BY:	GML	SHEET:	3
CHECKED BY:	DEC	SCALE:	1" equals 200'
APPROVED BY:	J. MURPHY	DATE:	7/24/2007
DRAWING NO.:	W:9525_BLACK LAKE\9525DNR0003A0.MXD		

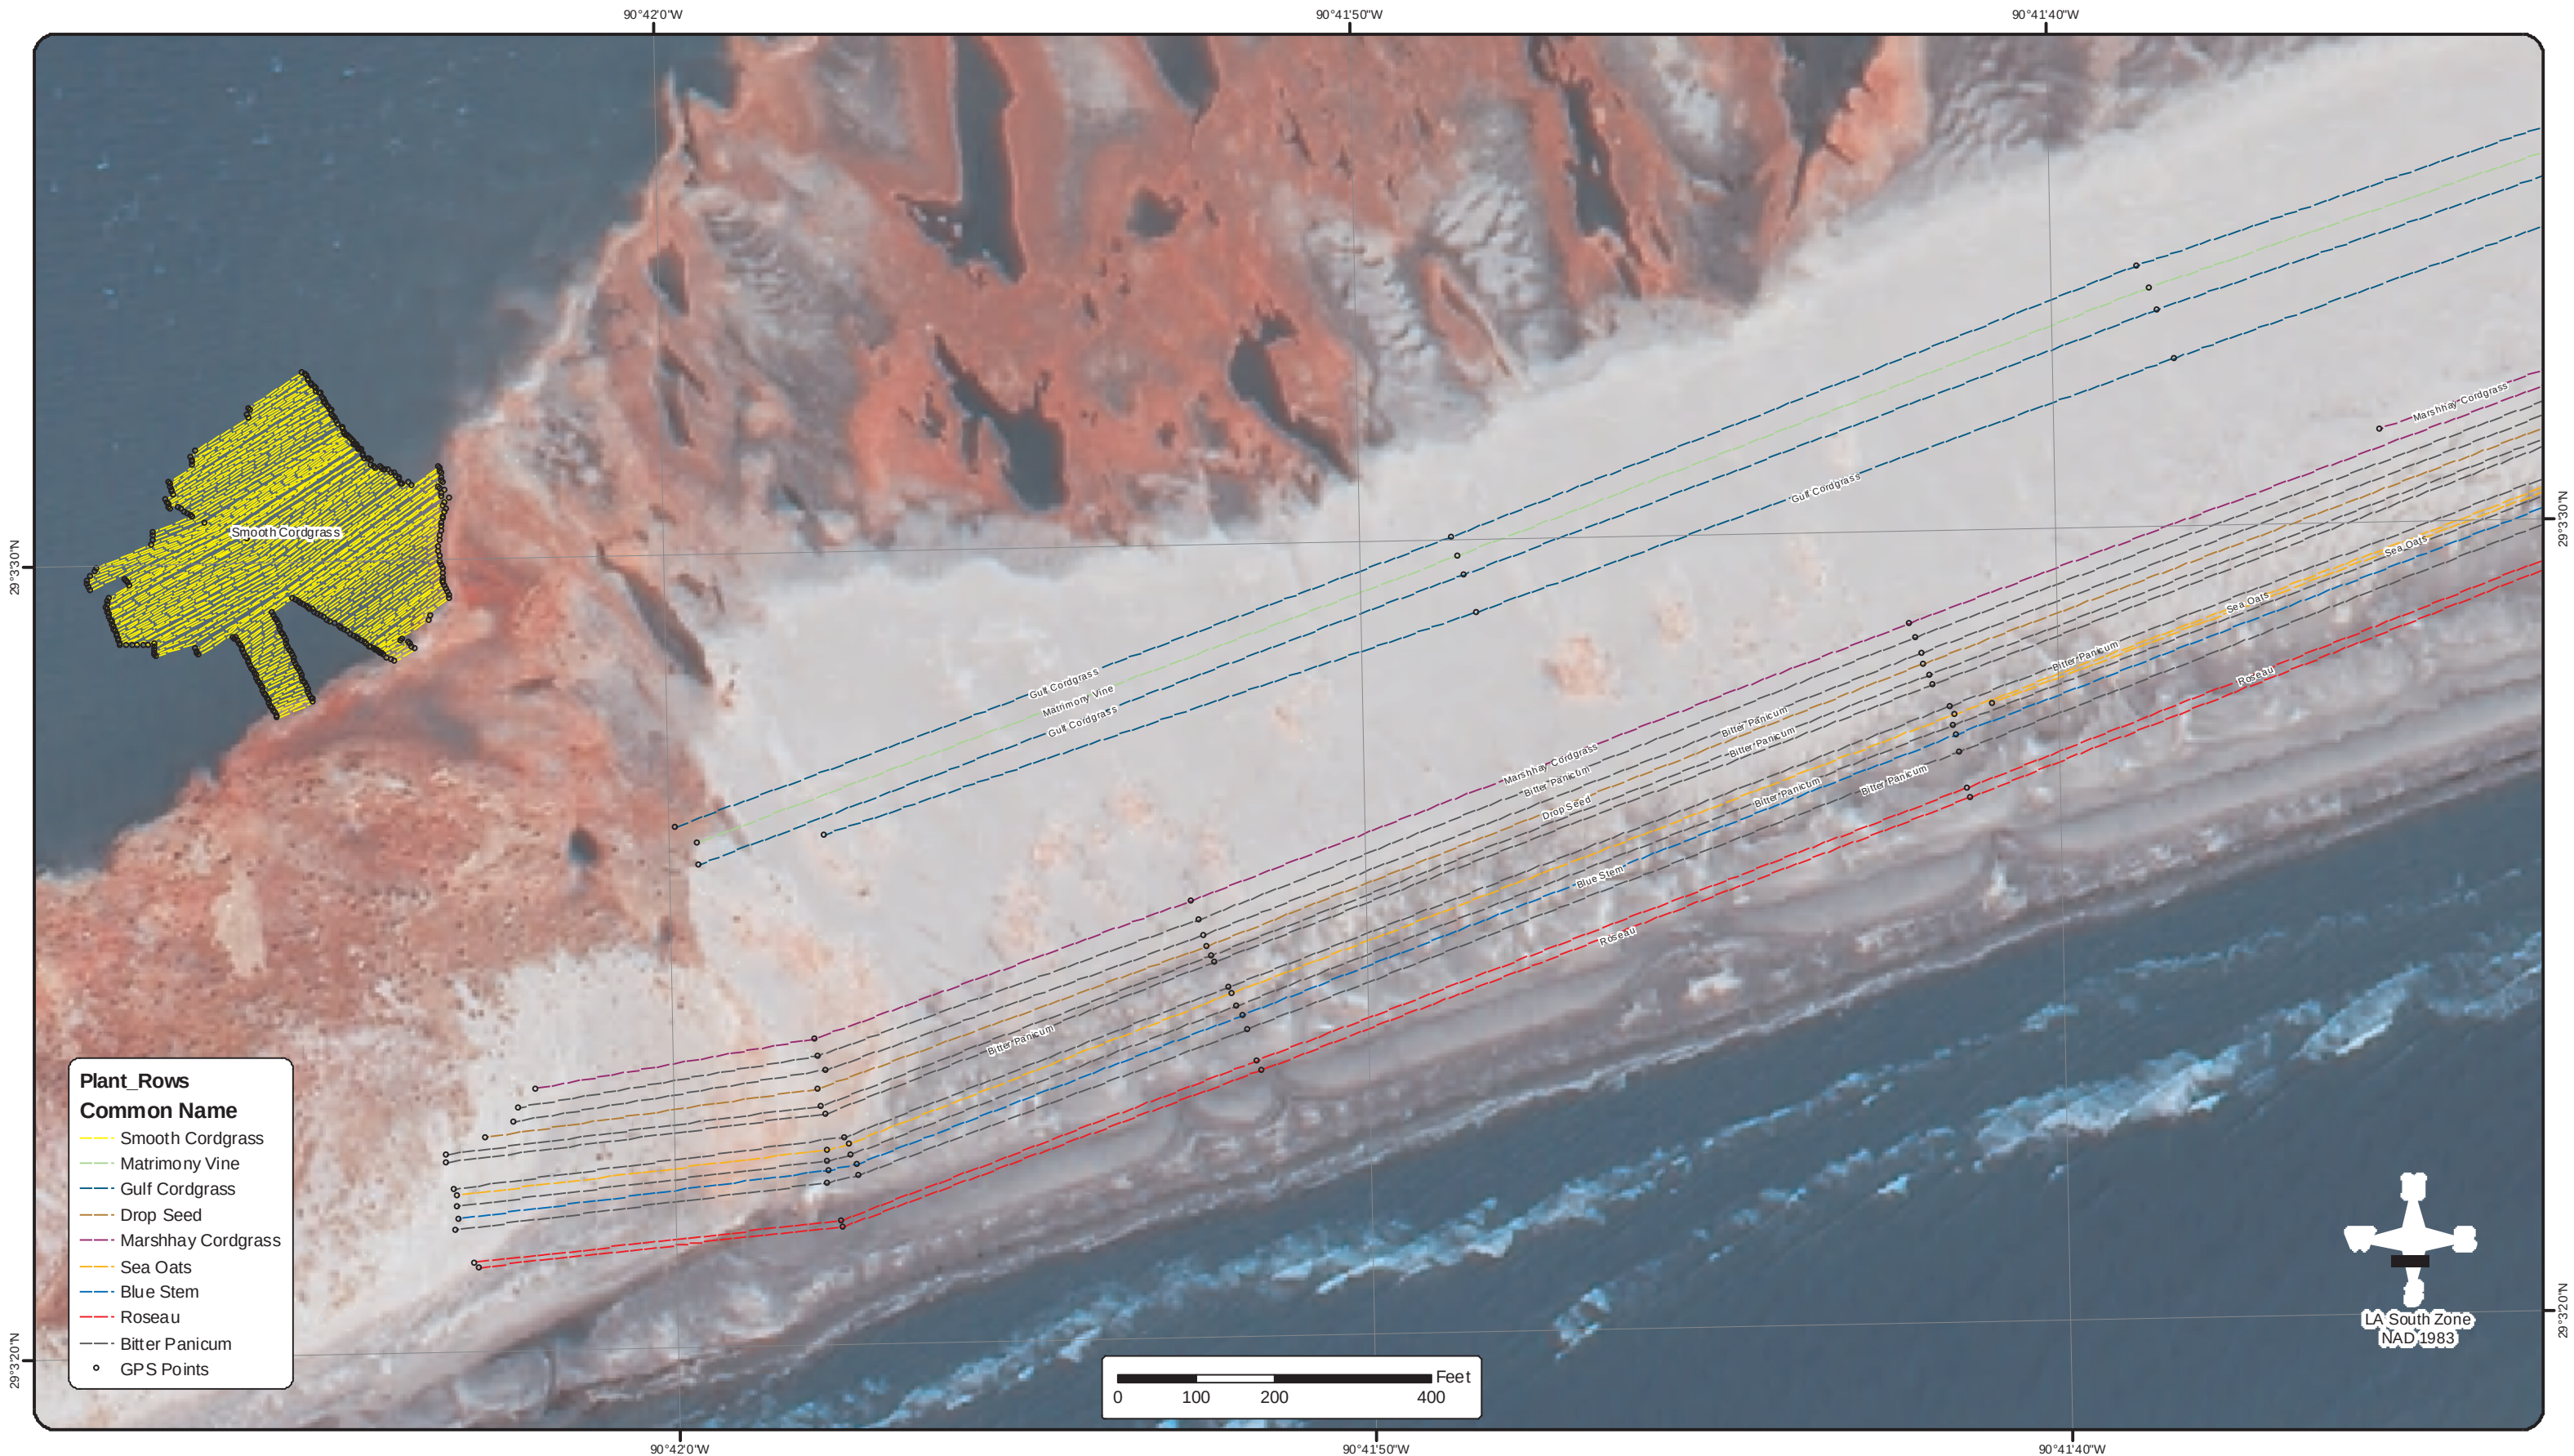

283 Corporate Drive
P.O. Box 3106
Houma, LA 70361
Voice: (985) 879-2731
Fax: (985) 876-9052

mph
Morris P. Hobert, Inc.
client focused solutions

One Sterling Place
10101 SW Freeway, Ste 400
Houston, TX 77074
Voice: (713) 219-1470
Fax: (713) 219-4171

Surveying - Engineering - Environmental Services - GIS
<http://www.mphinc.com>


2005 DOQQ
C2909059.NES
C2909059.SES
C2909059.NWS
C2909059.SWS

BLACK LAKE MARSH, INC.

AS-BUILT FOR DNR-CED (TE-37) / EPA (TE-11A)
NEW CUT VEGETATIVE PLANTINGS
TERREBONNE PARISH, LOUISIANA

NOTE:
DGPS points were taken at the
beginning and ending of the plant
rows and along each plant rows
every 1000 feet ± and at significant
changes in direction.

DRAWN BY:	GML	SHEET:	4
CHECKED BY:	DEC	SCALE:	1" equals 200'
APPROVED BY:	J. MURPHY	DATE:	7/24/2007
DRAWING NO.:	W:9525_BLACK LAKE\9525DNR0004A0.MXD		

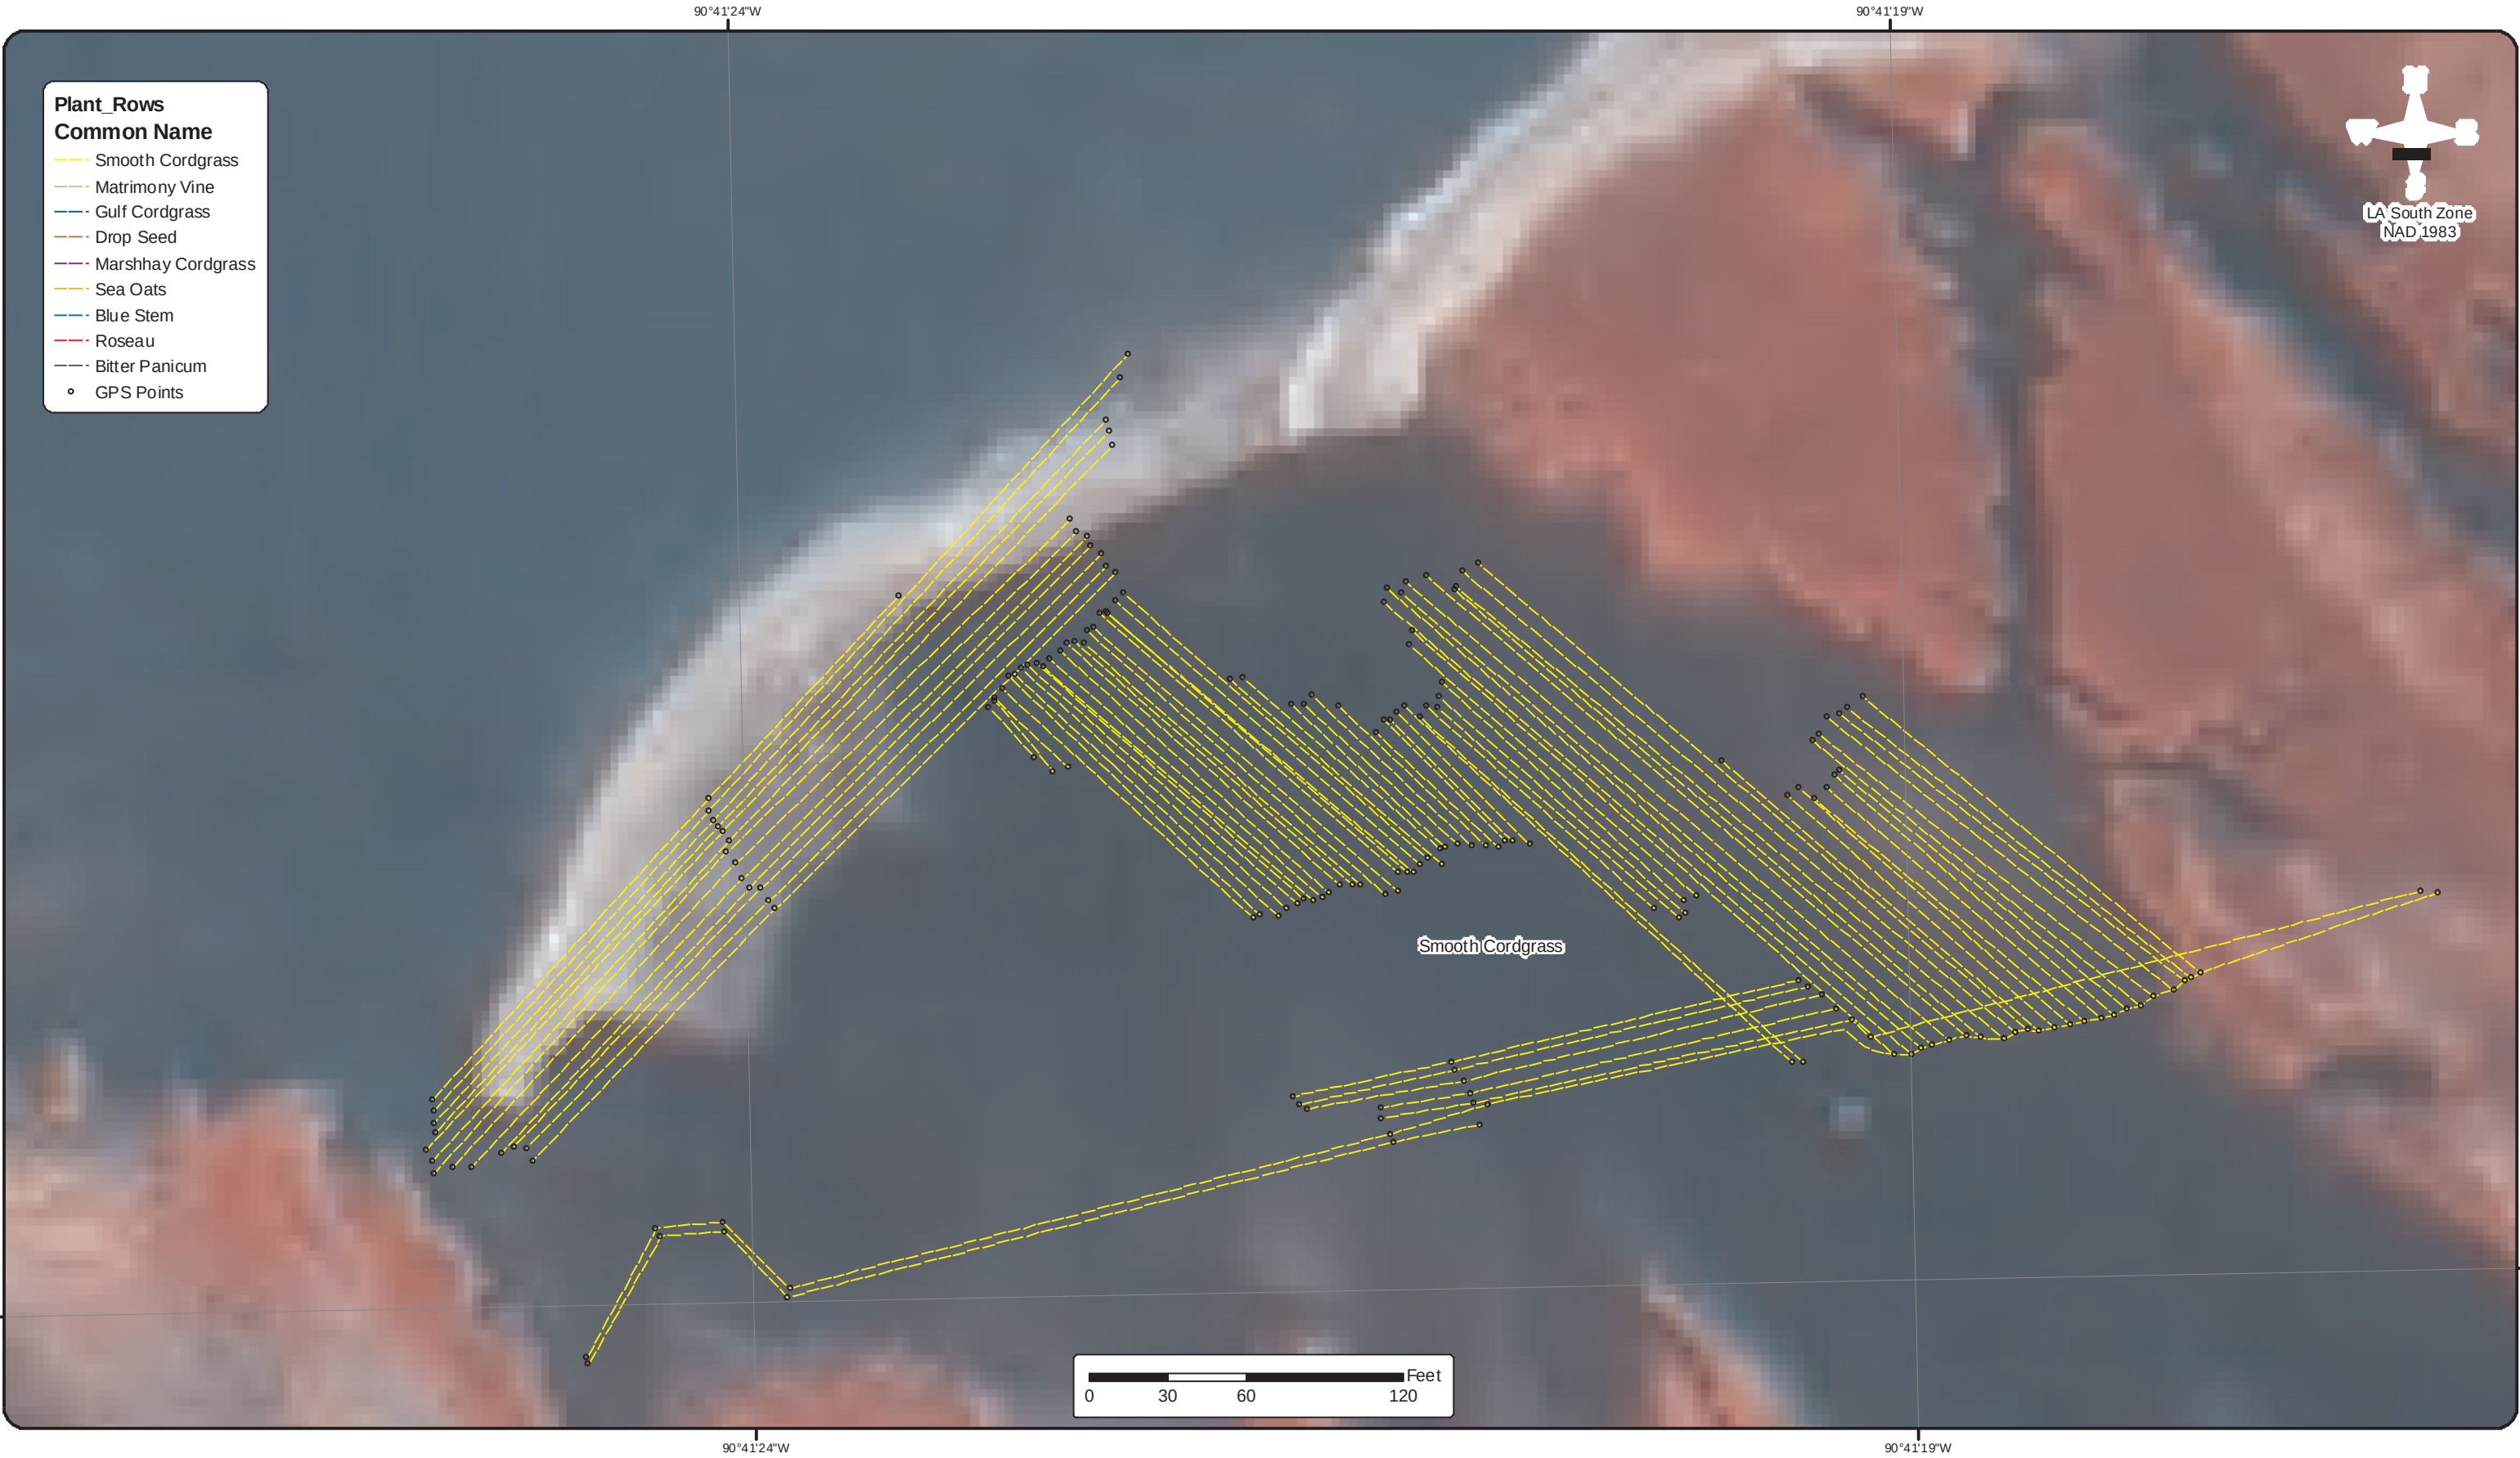

283 Corporate Drive
P.O. Box 3106
Houma, LA 70361

Voice: (985) 879-2731
Fax: (985) 876-9052

mph
Morris P. Hobert, Inc.
client focused solutions

Surveying - Engineering - Environmental Services - GIS
<http://www.mphinc.com>

One Sterling Place
10101 SW Freeway, Ste 400
Houston, TX 77074

Voice: (713) 219-1470
Fax: (713) 219-4171


2005 DOQQ
C2909059.NES
C2909059.SES
C2909059.NWS
C2909059.SWS

BLACK LAKE MARSH, INC.

AS-BUILT FOR DNR-CED (TE-37) / EPA (TE-11A)
NEW CUT VEGETATIVE PLANTINGS
TERREBONNE PARISH, LOUISIANA

NOTE:
DGPS points were taken at the
beginning and ending of the plant
rows and along each plant rows
every 1000 feet ± and at significant
changes in direction.

DRAWN BY:	GML	SHEET:	5
CHECKED BY:	DEC	SCALE:	1" equals 60'
APPROVED BY:	J. MURPHY	DATE:	7/24/2007
DRAWING NO.:	W:9525_BLACK LAKE\9525DNR0005A0.MXD		

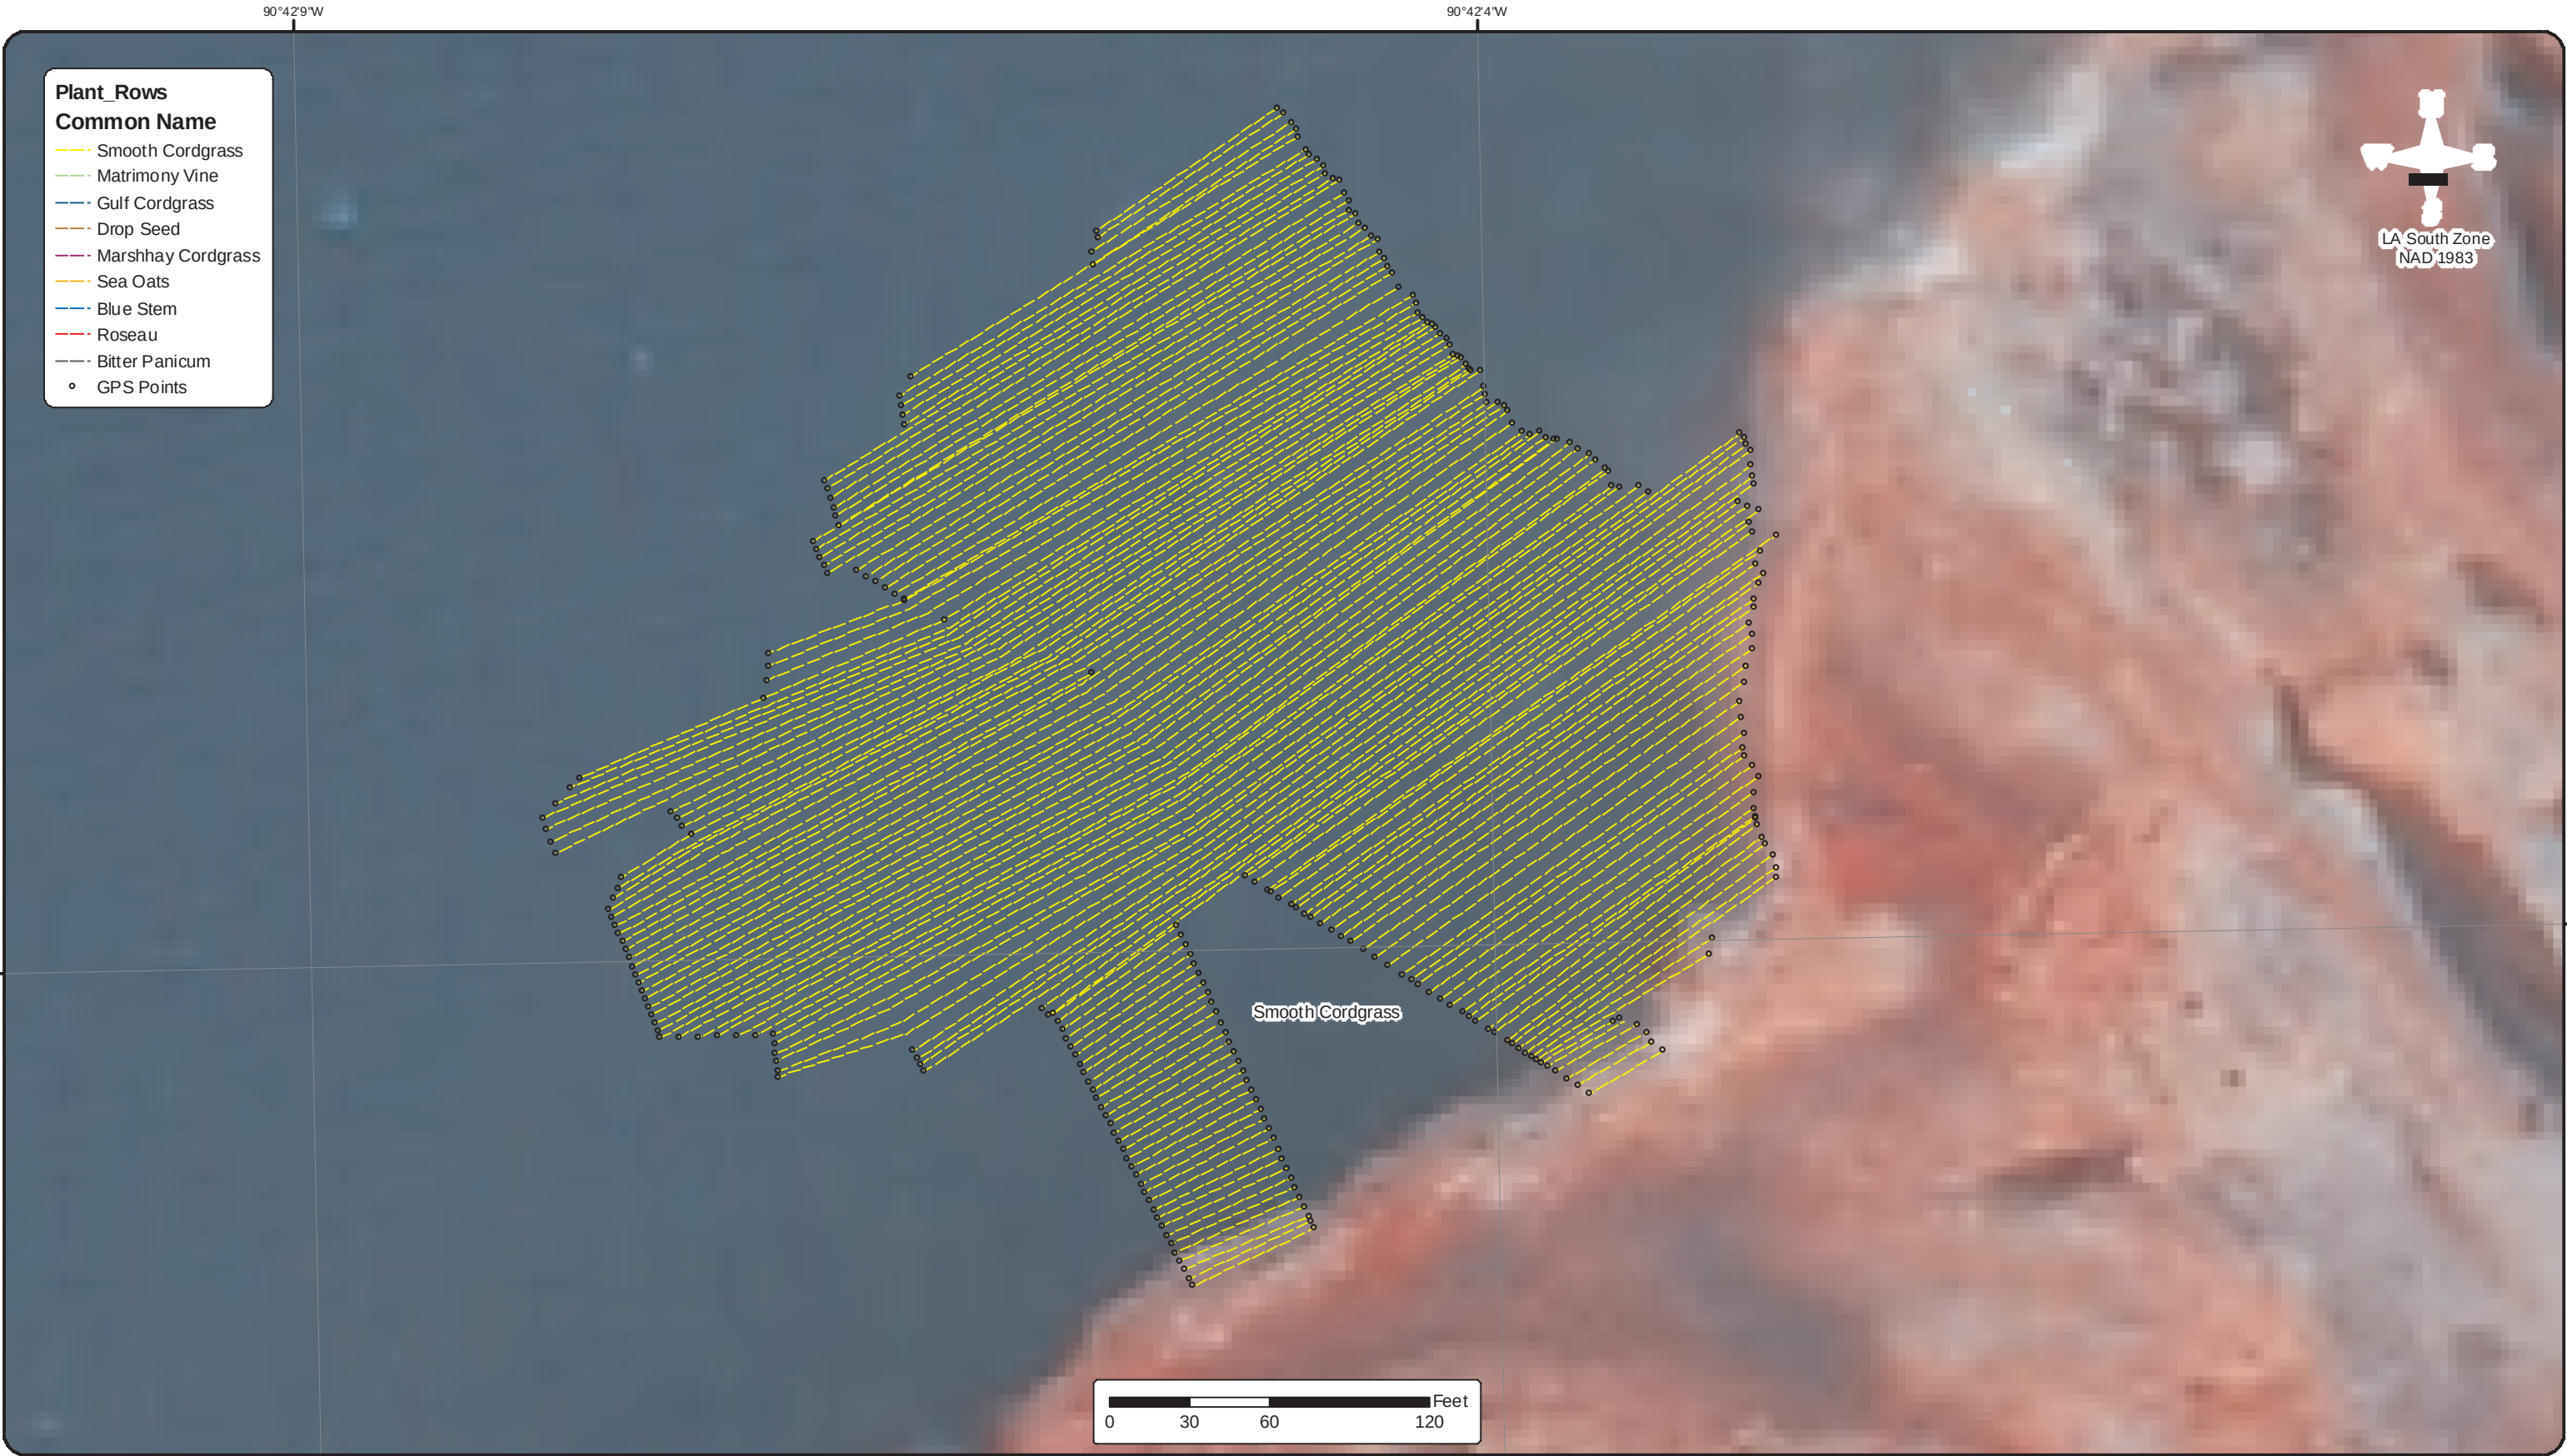

283 Corporate Drive
P.O. Box 3106
Houma, LA 70361


Morris P. Hobert, Inc.
client focused solutions

Voice: (985) 879-2731
Fax: (985) 876-9052

One Sterling Place
10101 SW Freeway, Ste 400
Houston, TX 77074

Voice: (713) 219-1470
Fax: (713) 219-4171

Surveying - Engineering - Environmental Services - GIS

<http://www.mphinc.com>

2005 DOQQ
C2909059.NES
C2909059.SES
C2909059.NWS
C2909059.SWS

BLACK LAKE MARSH, INC.

AS-BUILT FOR DNR-CED (TE-37) / EPA (TE-11A)
NEW CUT VEGETATIVE PLANTINGS
TERREBONNE PARISH, LOUISIANA

NOTE:
DGPS points were taken at the beginning and ending of the plant rows and along each plant rows every 1000 feet ± and at significant changes in direction.

DRAWN BY:	GML	SHEET:	6
CHECKED BY:	DEC	SCALE:	1 " equals 60 '
APPROVED BY:	J. MURPHY	DATE:	7/24/2007
DRAWING NO.:	W:9525_BLACK LAKE\9525DNR0006A0.MXD		