


NOTICE:
48 HOURS BEFORE DIGGING
CALL 1-800-272-3020
TO LOCATE UTILITY LINES

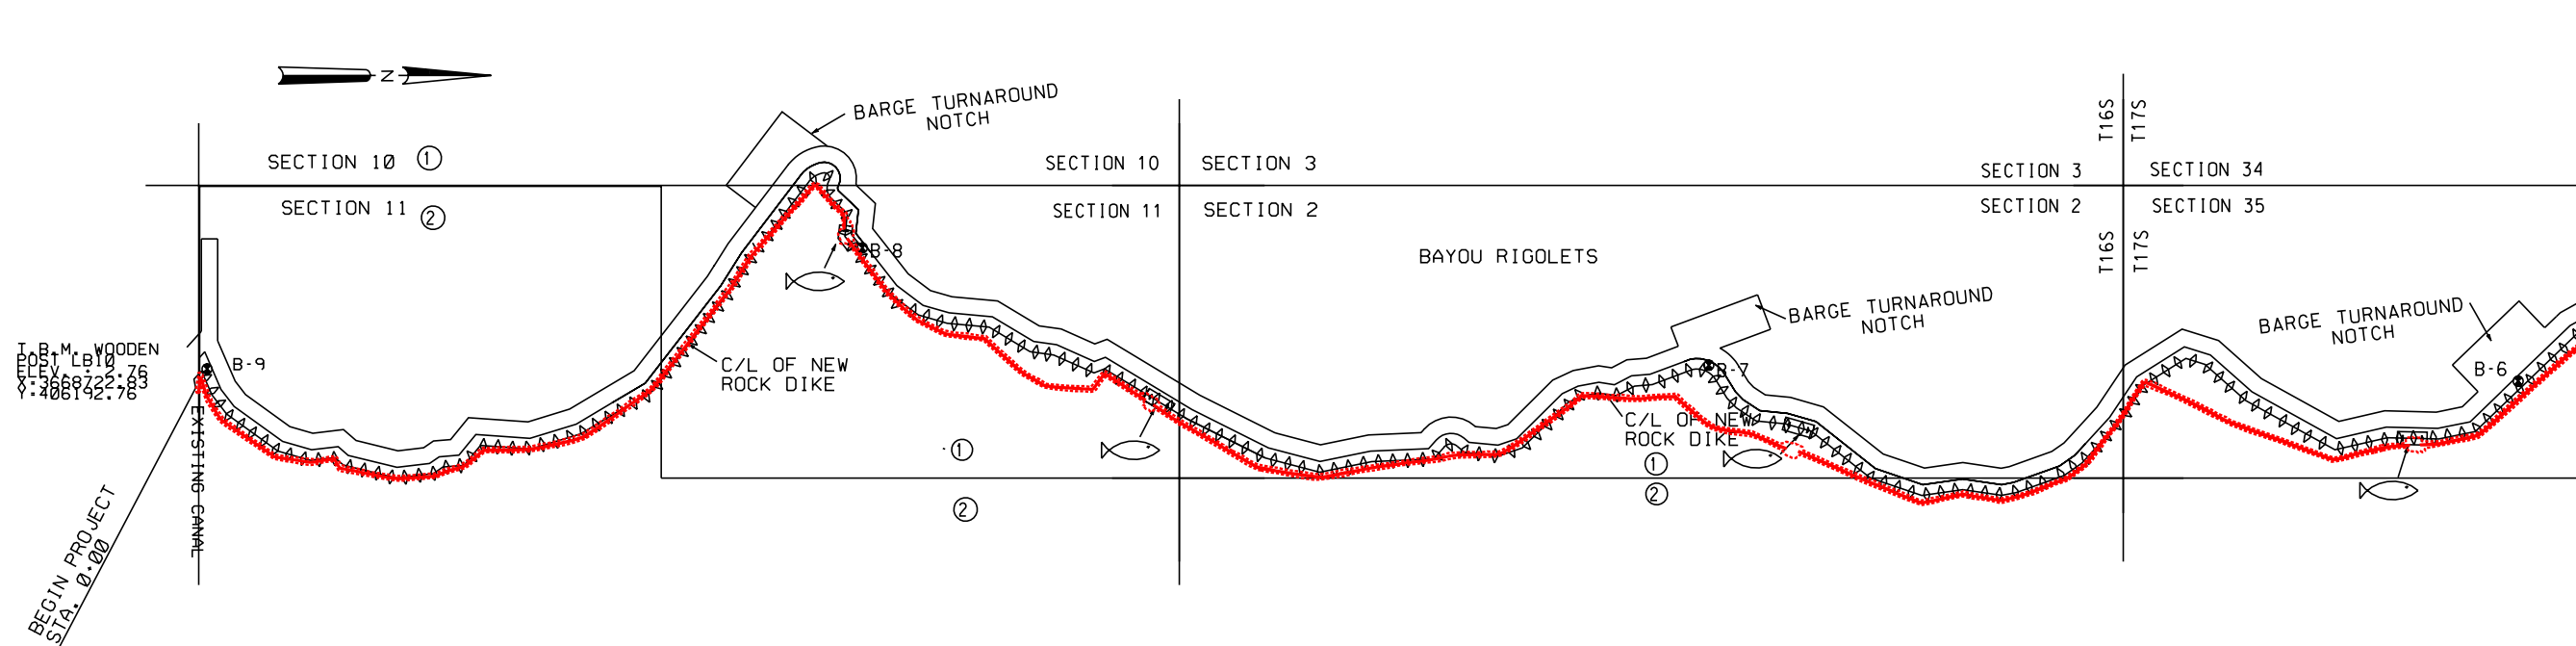

THE NATURAL RESOURCES CONSERVATION SERVICE DOES NOT GUARANTEE THE COMPLETENESS AND ACCURACY OF OWNERSHIP SHOWN. APPARENT OWNERSHIP HAS BEEN OBTAINED FROM MAPS IN THE OFFICE OF THE PARISH CLERK OF COURT OR THE TAX ASSESSOR. WHERE AN APPARENT PROPERTY LINE IS SHOWN NEAR THE CENTERLINE OF A CHANNEL, ITS LOCATION IS NOT DEFINITE.


NOTE :
KNOWN PIPELINES AND UTILITIES ARE SHOWN ON THE PLANS.
IT IS POSSIBLE THAT PIPELINES AND UTILITIES MAY EXIST
THAT HAVE NOT BEEN SHOWN. THE CONTRACTOR SHALL BE ON
THE ALERT FOR SUCH PIPELINES AND UTILITIES, AND SHALL
REPORT THEM IMMEDIATELY TO THE CONTRACTING OFFICER.

GENERAL NOTES

1. KNOWN PIPELINES AND UTILITIES ARE SHOWN ON THE PLANS. IT IS POSSIBLE THAT SOME MAY EXIST THAT HAVE NOT BEEN SHOWN. THE CONTRACTOR SHALL BE ON THE ALERT FOR SUCH PIPELINES AND UTILITIES, AND SHALL REPORT THEM IMMEDIATELY TO THE CONTRACTING OFFICER.
2. NO DREDGING WILL BE ALLOWED WITHIN 50 FEET OF A KNOWN PIPELINE. SEE PLAN/PROFILES FOR PIPELINE LOCATIONS.
3. THE VERTICAL DATUM IS NAVD 88.
THE HORIZONTAL DATUM IS NAD 83.
4. SEE SHT. 16 FOR TYPICAL SECTION DETAILS AND FLOTATION ACCESS CHANNEL DETAILS.
5. TBM WOODEN POST WAS ESTABLISHED FROM HORN MARK "LAFITTE 2".

LEGEND

-  B-5 SOIL BORING
 END STA. 1+80.00
 LANDOWNERS :
 ① RIGOLETS LIMITED PARTNERSHIP
 ② MADISON LAND COMPANY ET.AL.
 _____ SECTION LINE
 _____ APPARENT PROPERTY LINE
 ◆◆◆◆◆ PROPOSED REVETMENT
 _____ ACCESS CHANNEL
 FISH DIP

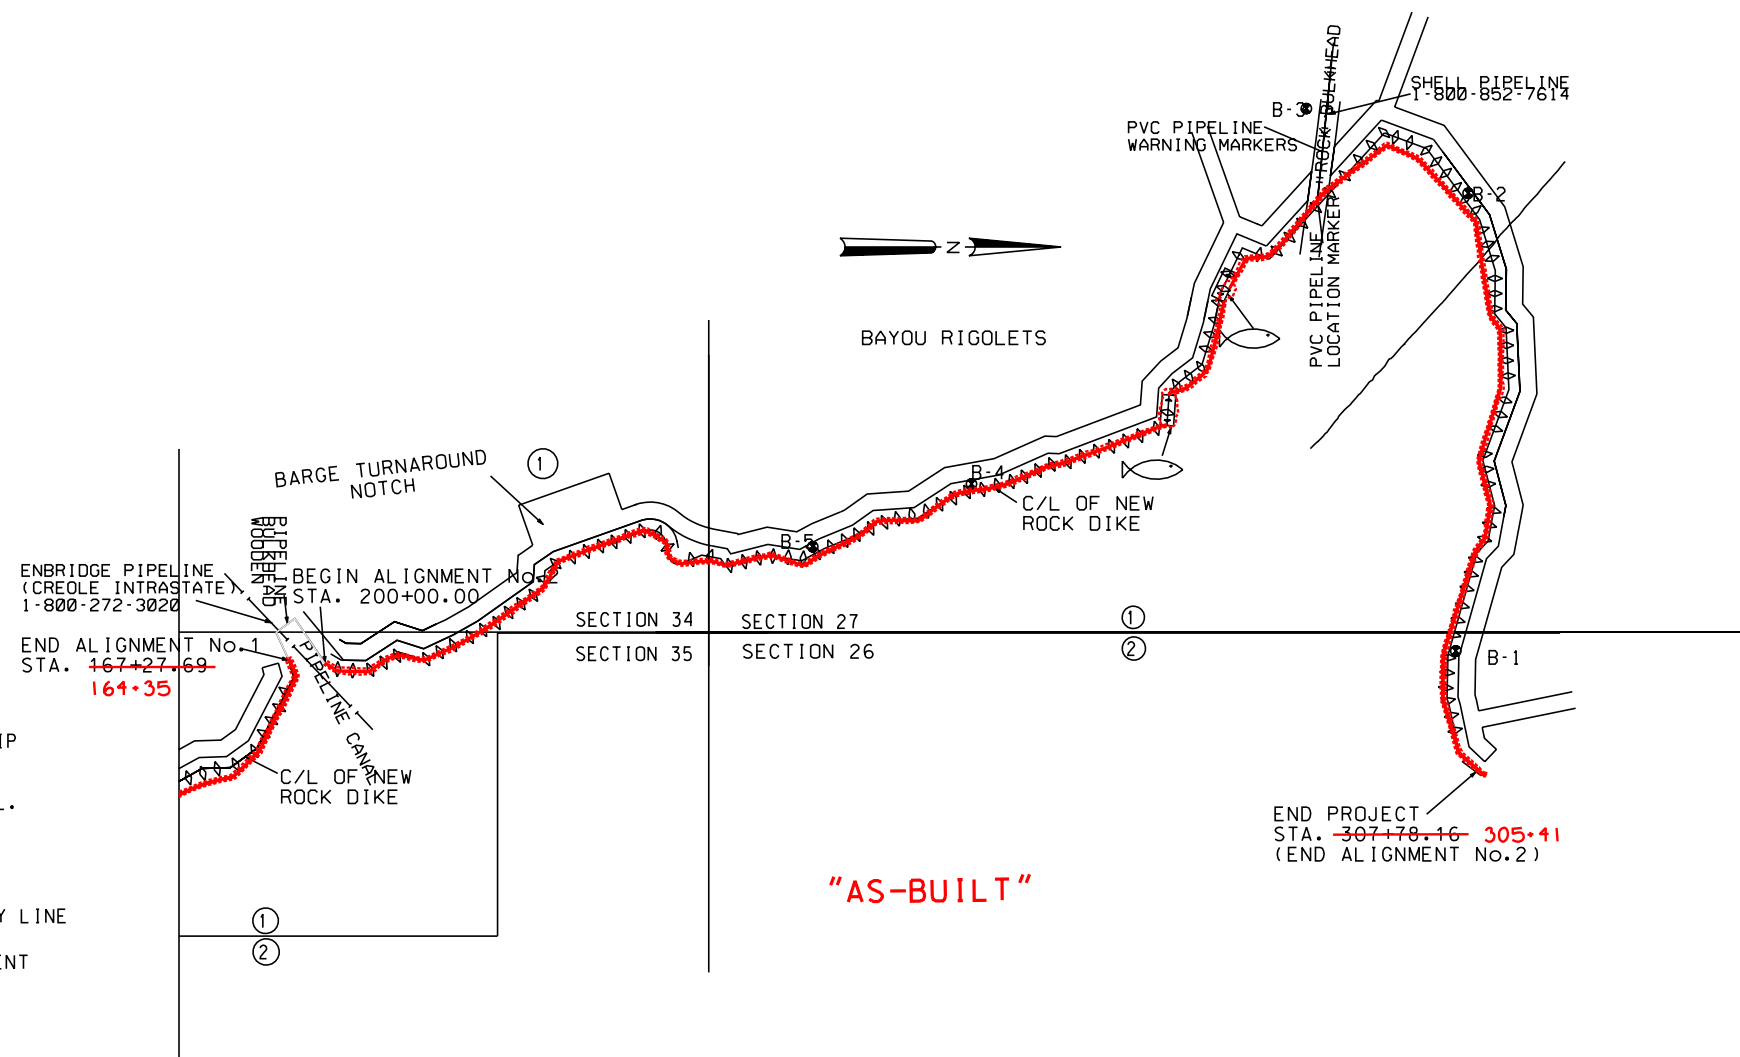

BURK-KLEINPETER, INC.
ENGINEERS, ARCHITECTS, PLANNERS, ENVIRONMENTAL
4176 CANAL STREET, NEW ORLEANS, LOUISIANA 70114
(504) 486-5901 FAX (504) 488-1714

DESIGNED	M. ROBERTS	DETAILED	A. BRANCH	DATE	08/04
CHECKED	M. CHOPIN			SCALE	AS SHOWN
				SHEET NO.	2


PLAN MAP / LANDRIGHTS MAP
BARATARIA BASIN LANDBRIDGE
PROJECT BA-27D-CU6
JEFFERSON PARISH, LA.

[illegible]

CAD FILE NO.									


DRAWING NO.
LA-352

U.S. DEPARTMENT OF AGRICULTURE - NATURAL RESOURCES CONSERVATION SERVICE

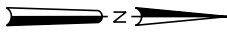

	NO.	X (NAD 83)	Y (NAD 83)	COVER
ENBRIDGE PIPELINE	1	3667610.64	419779.01	8.0'
	2	3667603.30	419775.88	MAG HIT
	3	3667542.78	419727.78	MAG HIT
	4	3667429.30	419654.31	MAG HIT
SHELL PIPELINE	5	3665382.94	425147.81	5.0'
	6	3665101.87	425193.10	MAG HIT
	7	3664806.10	425233.32	MAG HIT

NOTE: THE INFORMATION SHOWN ON THIS SHEET
WAS OBTAINED FROM THE MAGNETOMETER SURVEY
PERFORMED IN DEC. 2003. SINCE THAT TIME THE
SHELL PIPELINE HAS BEEN LOWERED, AS IS
REPRESENTED ON DRAWING SHEET 28 OF 29

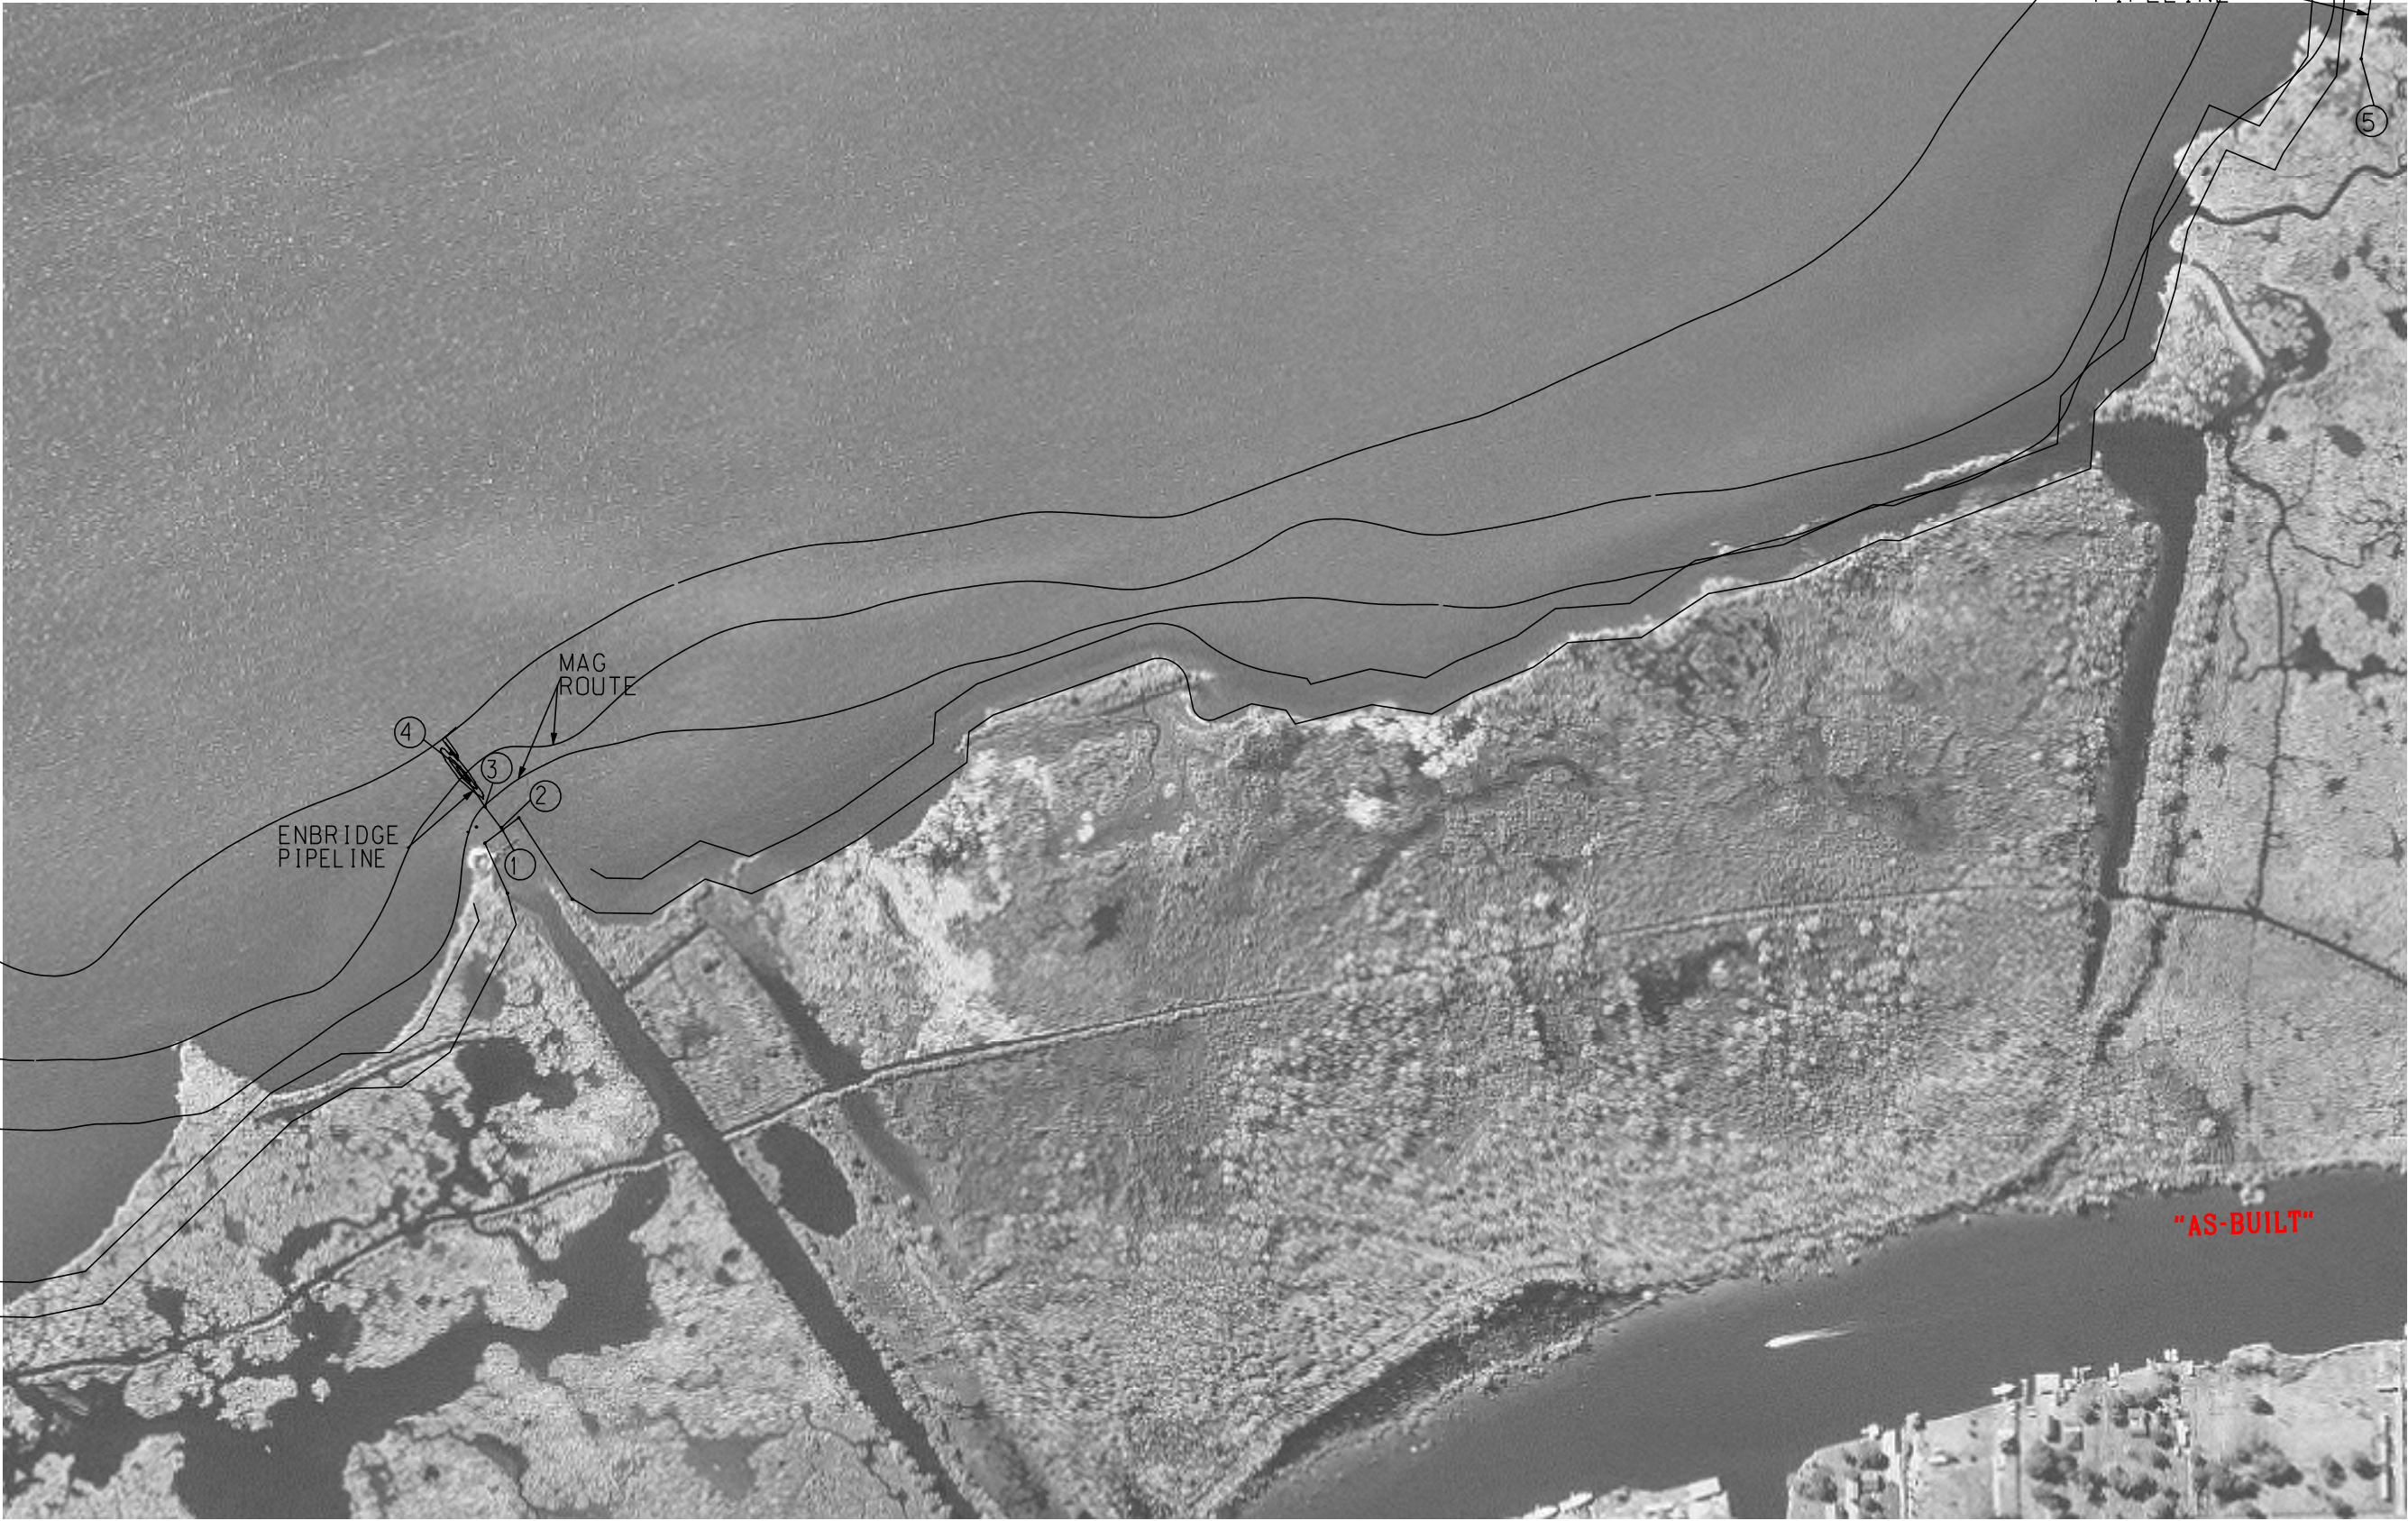

MAGNETOMETER SURVEY RESULTS
BARATARIA BASIN LANDBRIDGE
PROJECT BA-27D-CU6
JEFFERSON PARISH, LA.


BURK KLEINPETER, INC.
ENGINEERS, ARCHITECTS, PLANNERS, ENVIRONMENTAL SCIENTISTS
4176 CANAL STREET, NEW ORLEANS, LOUISIANA 70115-5994
(504) 486-5901 FAX (504) 486-1714

DESIGNED	M. ROBERTS	DATE	1/04
CHECKED	M. CHOPIN	SCALE	AS SHOWN
		BK1 JOB NO.	10142
		SHEET NO.	3

REVISIONS		TITLE
NO.	DATE	APPR.

CAD FILE NO.
DRAWING NO. LA-352
Sht. 3 of 29

U.S. DEPARTMENT OF AGRICULTURE - NATURAL RESOURCES CONSERVATION SERVICE

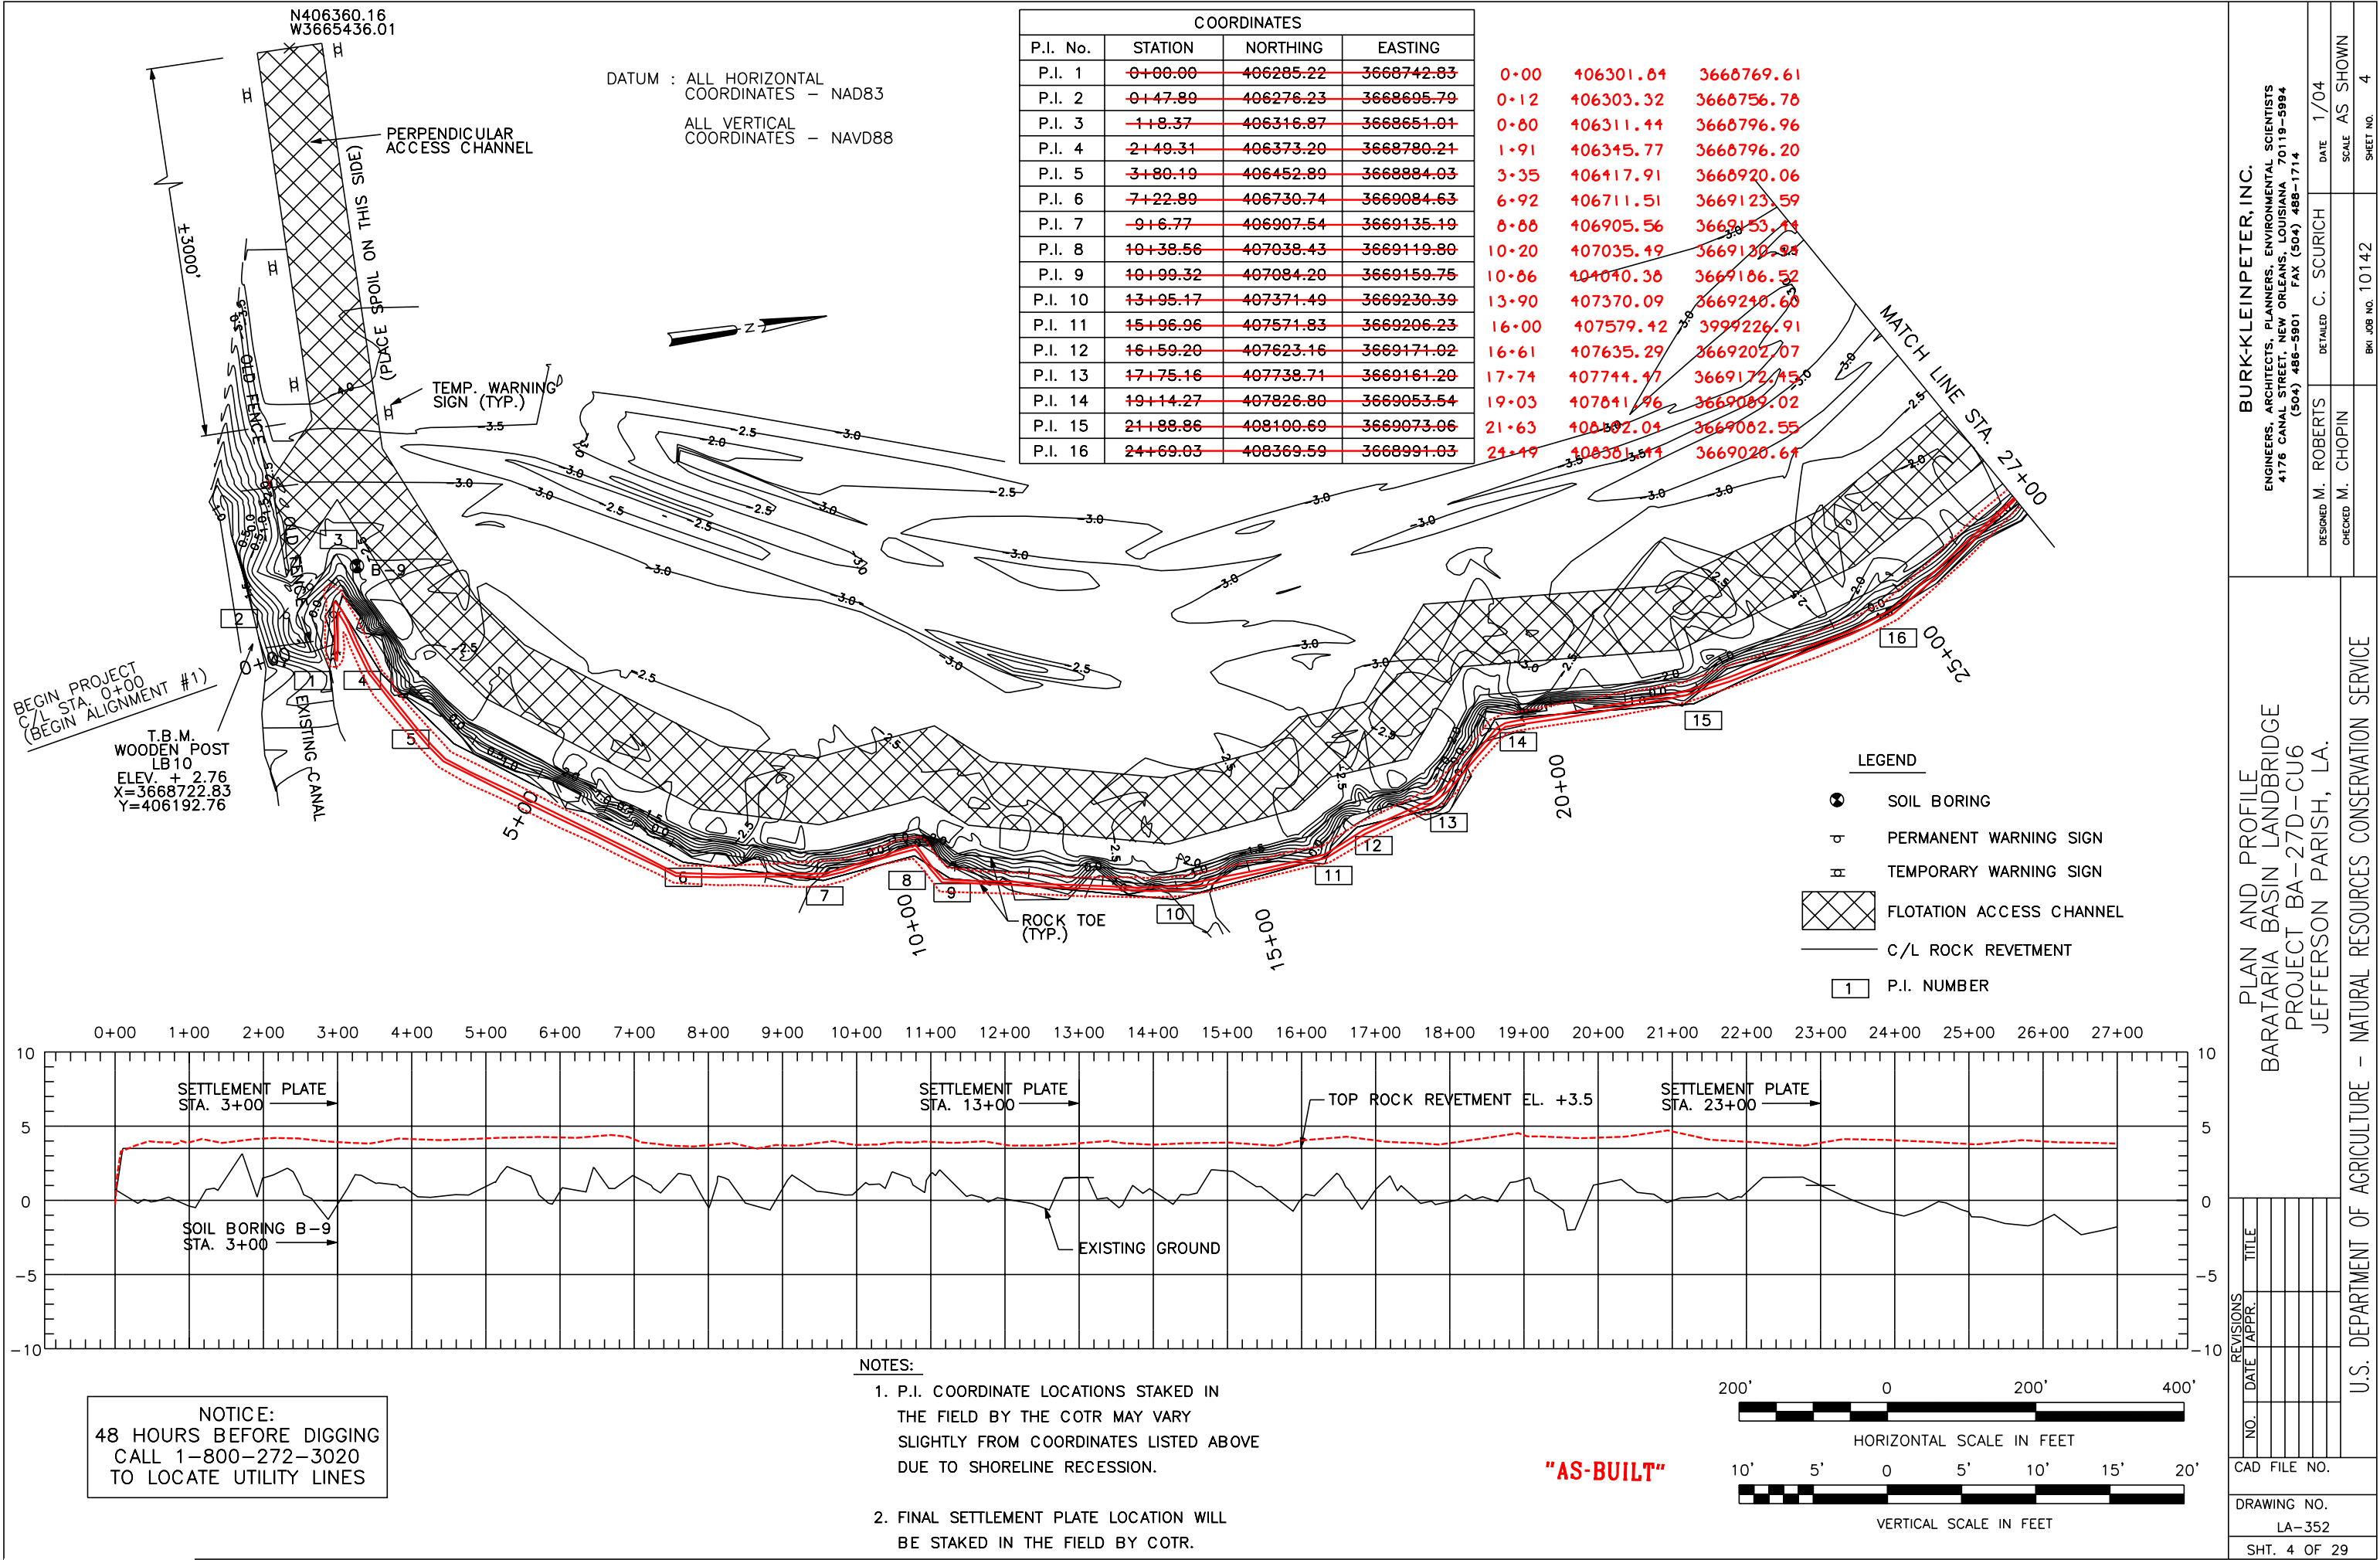

CURVE	PC STA.	PC		PT STA.	PT		L	T	△
		X	Y		X	Y			
1	43+42.24	3667811.40	409424.21	44+35.44	3667767.12	409503.78	93.20	48.89	42°43'13.7"
2	44+35.44	3667767.12	409503.78	44+98.60	3667813.18	409528.18	63.16	52.62	120°37'11.9"
3	44+98.60	3667813.18	409528.18	45+98.11	3667905.50	409541.10	99.51	57.35	71°16'1.8"


NOTE :
ALL RADII AND CURVE
DATA REFER TO
C/L ROCK REVETMENT

COORDINATES			
P.I. No.	STATION	NORTHING	EASTING
P.I. 17	29+20.27	406285.22	3668760.48
P.I. 18	36+11.39	409174.26	3668222.53
P.I. 19	38+12.41	409286.98	3668044.15
P.I. 20	43+42.24	409608.04	3667622.66
P.I. 21	44+35.44	409687.60	3667570.38
P.I. 22	44+98.60	409712.00	3667624.44
P.I. 23	45+98.11	409724.92	3667716.76
P.I. 24	47+19.35	409812.76	3667800.32
P.I. 25	48+43.09	409799.17	3667923.31

NOTE: SEE DWG. 26 OF 29
FOR FISH DIP DETAILS.



- LEGEND
- SOIL BORING
 - PERMANENT WARNING SIGN
 - TEMPORARY WARNING SIGN
 - FLOTATION ACCESS CHANNEL
 - C/L ROCK REVETMENT
 - P.I. NUMBER

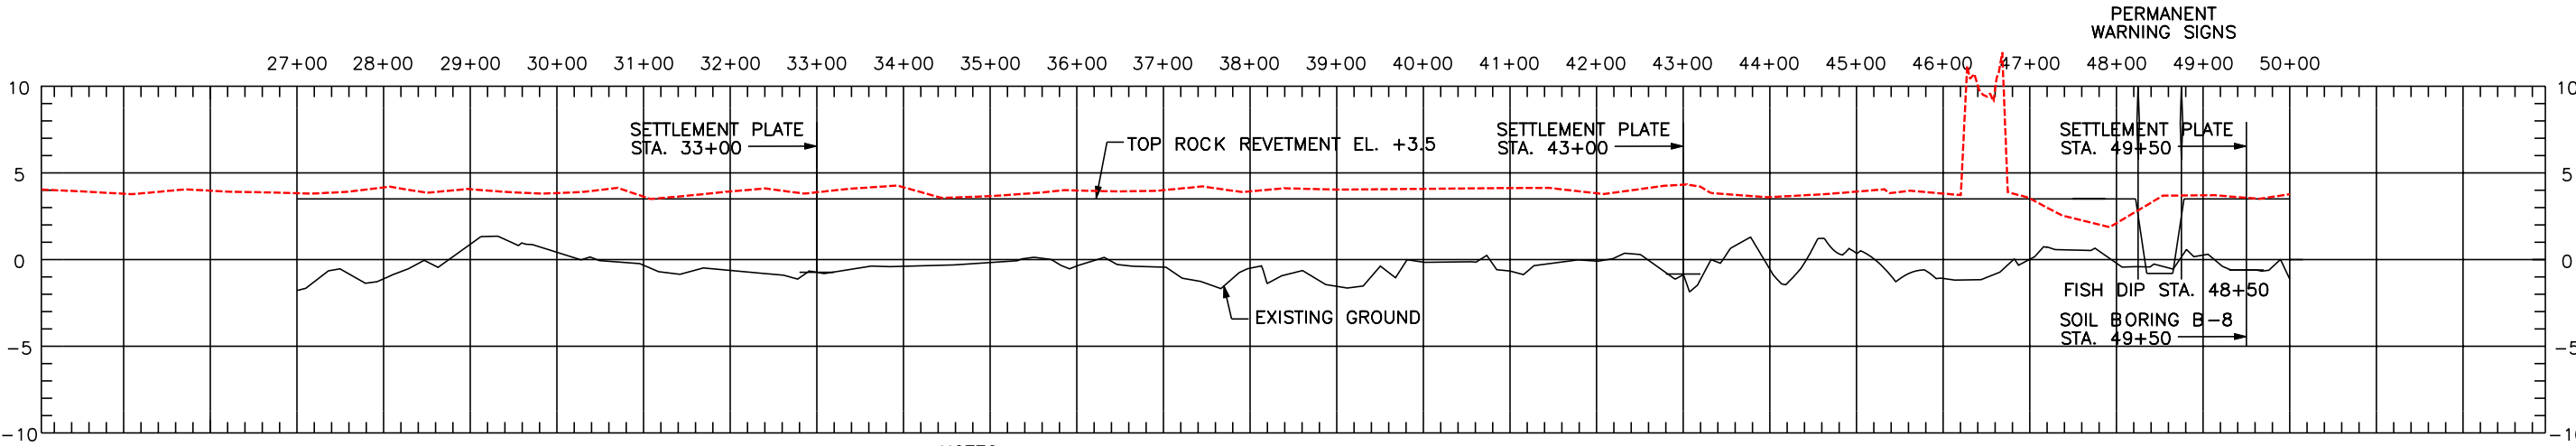


NOTES:

- P.I. COORDINATE LOCATIONS STAKED IN THE FIELD BY THE COTR MAY VARY SLIGHTLY FROM COORDINATES LISTED ABOVE DUE TO SHORELINE RECESSON.
- FINAL SETTLEMENT PLATE LOCATION WILL BE STAKED IN THE FIELD BY COTR.

NOTICE:
48 HOURS BEFORE DIGGING
CALL 1-800-272-3020
TO LOCATE UTILITY LINES

"AS-BUILT"

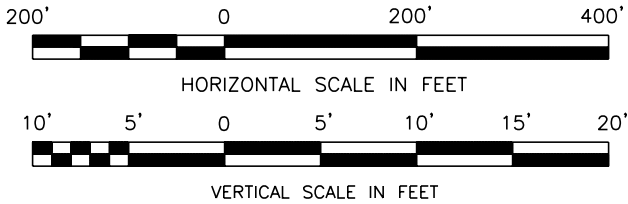

BURK-KLEINPETER, INC.
ENGINEERS, ARCHITECTS, PLANNERS, ENVIRONMENTAL SCIENTISTS
4176 CANAL STREET, NEW ORLEANS, LOUISIANA 70119-5994
(504) 486-5901 FAX (504) 486-1714

DESIGNED M. ROBERTS
CHECKED M. CHOPIN

DATE 1/04
SCALE AS SHOWN
SHEET NO. 5

PLAN AND PROFILE
BARATARIA BASIN LANDBRIDGE
PROJECT BA-27D-CU6
JEFFERSON PARISH, LA.

U.S. DEPARTMENT OF AGRICULTURE - NATURAL RESOURCES CONSERVATION SERVICE

REVISIONS
NO. DATE APPR. TITLE


CAD FILE NO.

DRAWING NO.
LA-352

SHT. 5 OF 29


COORDINATES			
P.I. No.	STATION	NORTHING	EASTING
P.I. 26	52+33.00	410039.77	3668230.14
P.I. 27	54+29.82	410197.15	3668348.33
P.I. 28	55+91.67	410352.81	3668392.68
P.I. 29	58+19.79	410579.97	3668413.60
P.I. 30	60+77.98	410801.34	3668546.47
P.I. 31	62+7.65	410929.75	3668564.53
P.I. 32	64+46.13	411147.61	3668661.55
P.I. 33	65+6.51	411204.04	3668640.09
P.I. 34	70.27.89	411650.51	3668909.36
P.I. 35	75+1.04	412073.47	3669121.42

50+50	410031.02	3668238.76
52+55	410183.75	3668374.94
54+32	410340.81	3668457.65
56+50	410556.74	3668483.81
59+23	410758.83	3668666.86
60+63	410880.38	3668737.59
63+28	411144.91	3668757.13
64+26	411200.78	3668677.49
69+32	411629.99	3668946.78
74+09	412042.83	3669185.47

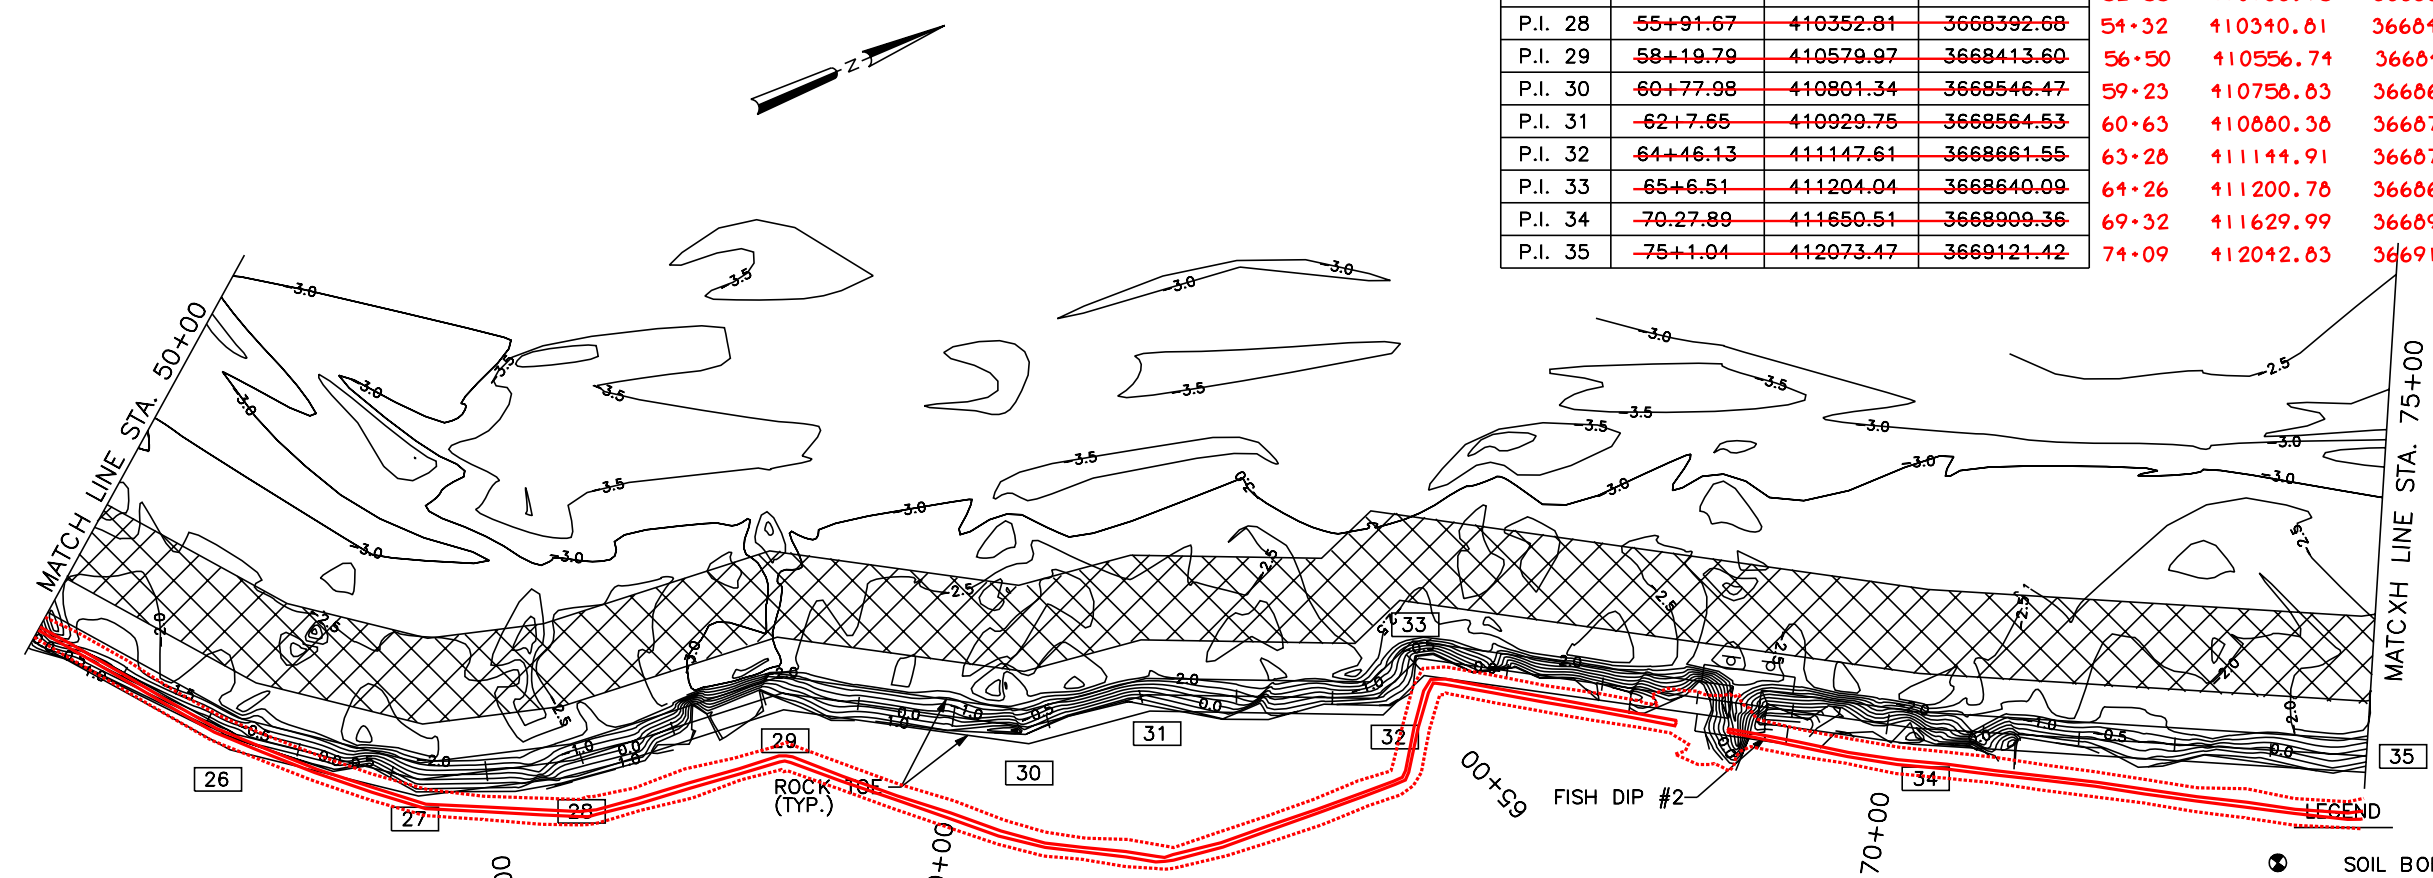

NOTE: SEE DWG. 26 OF 29
FOR FISH DIP DETAILS


- SOIL BORING
- PERMANENT WARNING SIGN
- TEMPORARY WARNING SIGN
- FLOTATION ACCESS CHANNEL
- C/L ROCK REVETMENT
- P.I. NUMBER

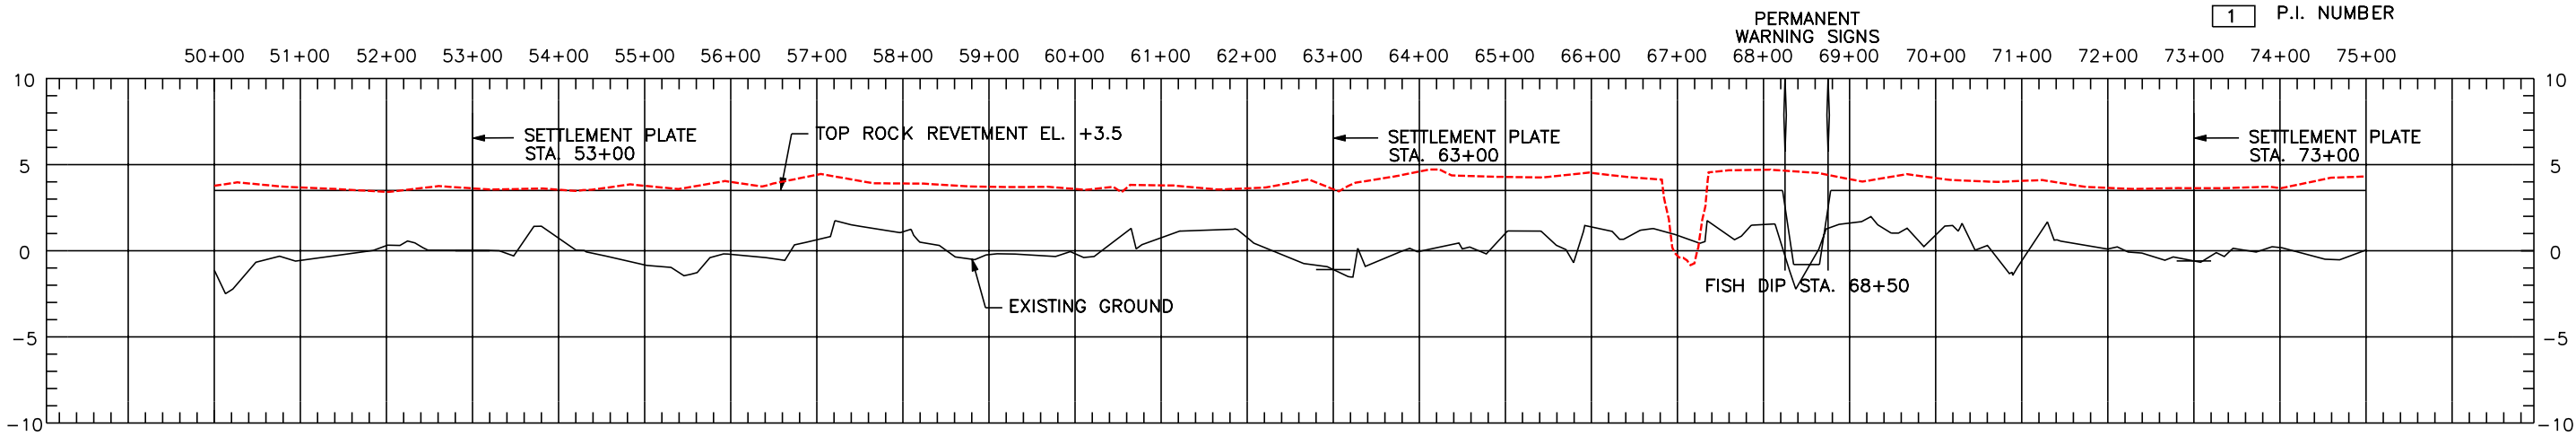

- NOTES:
- P.I. COORDINATE LOCATIONS STAKED IN THE FIELD BY THE COTR MAY VARY SLIGHTLY FROM COORDINATES LISTED ABOVE DUE TO SHORELINE RECESSION.
 - FINAL SETTLEMENT PLATE LOCATION WILL BE STAKED IN THE FIELD BY COTR.

NOTICE:
48 HOURS BEFORE DIGGING
CALL 1-800-272-3020
TO LOCATE UTILITY LINES



"AS-BUILT"

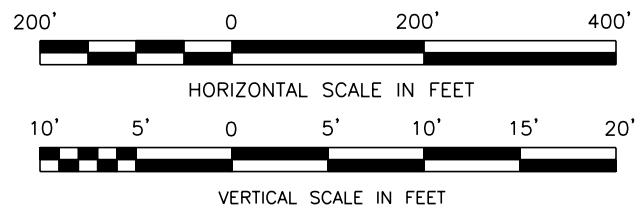

CURVE	PC STA.	PC		PT STA.	PT		L	T	△
		X	Y		X	Y			
4	85+16.32	3669062.26	413043.30	85+94.39	3669057.83	413113.54	78.07	49.54	89°28'0.4"

COORDINATES			
P.I. No.	STATION	NORTHING	EASTING
P.I. 36	78+7.53	412369.91	3669199.26
P.I. 37	80+94.58	412651.10	3669141.56
P.I. 38	84+29.11	412985.34	3669127.41
P.I. 39	85+16.32	413043.30	3669062.26
P.I. 40	85+94.39	413113.54	3669057.83
P.I. 41	86+47.21	413153.33	3669092.56
P.I. 42	88+36.44	413341.77	3669109.79
P.I. 43	89+67.56	413465.95	3669067.66
P.I. 44	93+17.69	413714.82	3668821.39
P.I. 45	93+96.08	413785.77	3668788.09
P.I. 46	94+92.92	413880.98	3668770.36
P.I. 47	95+87.91	413974.89	3668784.71
P.I. 48	96+99.29	414073.55	3668733.04
P.I. 49	97+95.73	414169.66	3668725.10


77+39	412368.86	3669234.96
80+31	412656.26	3669182.98
83+67	412989.24	3669135.62
84+80	413099.37	3669112.16
85+26	413144.98	3669112.40
87+22	413341.70	3669109.81
88+51	413453.67	3669047.67
91+94	413730.10	3668843.16
92+71	413786.82	3668791.28
93+66	413881.41	3668796.60
94+63	413977.92	3668803.39
95+81	414095.92	3668809.94
96+72	414186.50	3668800.05

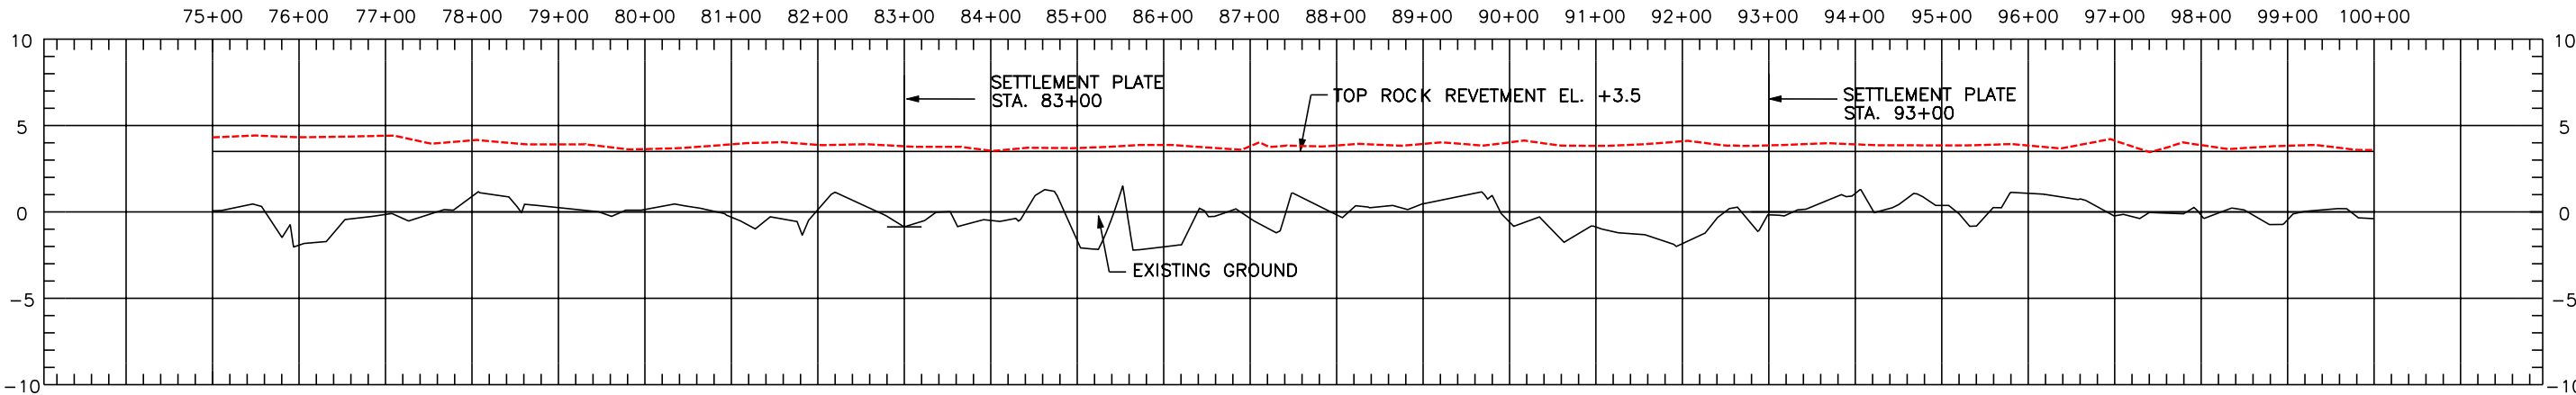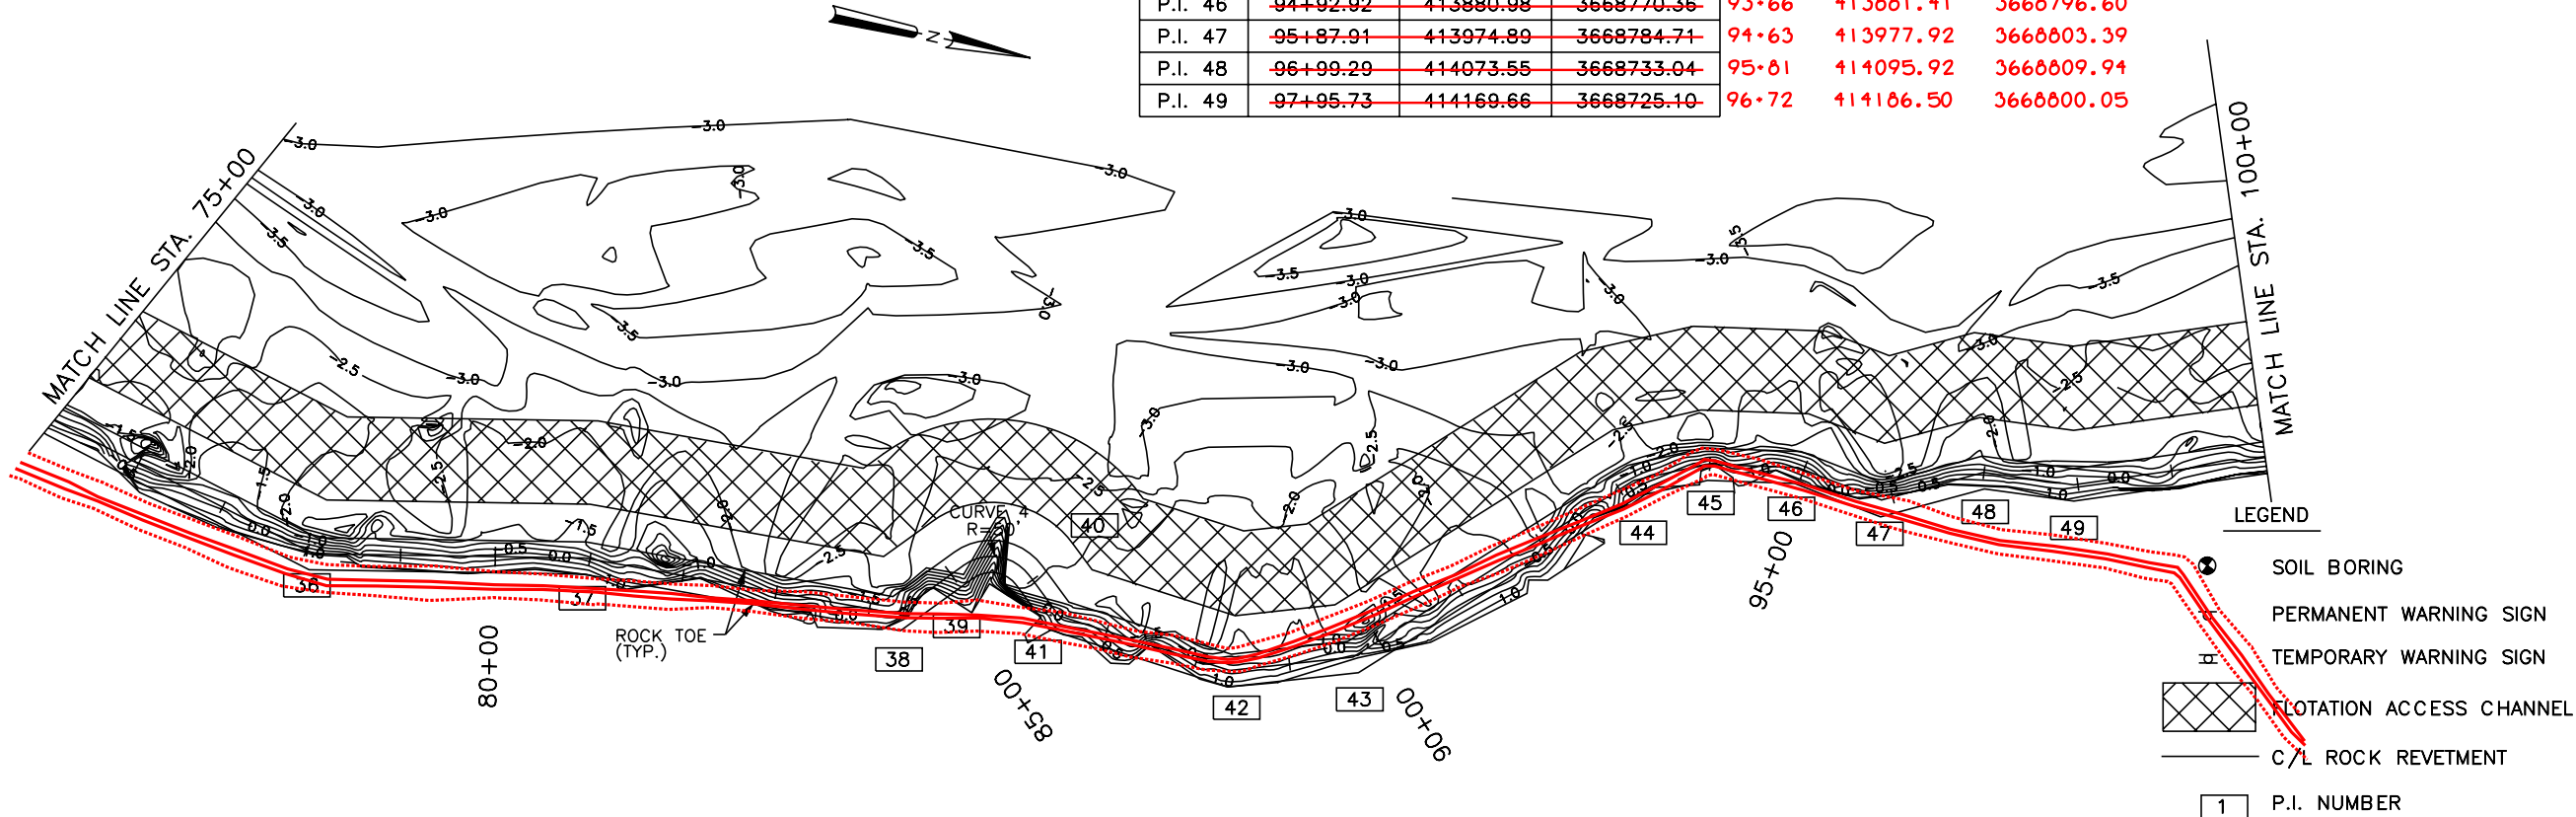

NOTES:

- P.I. COORDINATE LOCATIONS STAKED IN THE FIELD BY THE COTR MAY VARY SLIGHTLY FROM COORDINATES LISTED ABOVE DUE TO SHORELINE RECESSION.
- FINAL SETTLEMENT PLATE LOCATION WILL BE STAKED IN THE FIELD BY COTR.

"AS-BUILT"

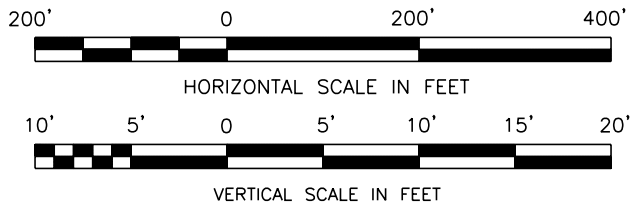

NOTICE:
48 HOURS BEFORE DIGGING
CALL 1-800-272-3020
TO LOCATE UTILITY LINES

BURK-KLEINPETER, INC.

ENGINEERS, ARCHITECTS, PLANNERS, ENVIRONMENTAL SCIENTISTS

4176 CANAL STREET, NEW ORLEANS, LOUISIANA 70119-5994

(504) 486-5901 FAX (504) 486-1714

DESIGNED M. ROBERTS

CHECKED M. CHOPIN

DATE 1/04

SCALE AS SHOWN

SHEET NO. 7

PLAN AND PROFILE

BARATARIA BASIN LANDBRIDGE

PROJECT BA-27D-CU6

JEFFERSON PARISH, LA.

REVISIONS

NO.	DATE	APPR.	TITLE


U.S. DEPARTMENT OF AGRICULTURE – NATURAL RESOURCES CONSERVATION SERVICE

CAD FILE NO.

DRAWING NO.
LA-352

SHT. 7 OF 29

07.plan4.dgn 10/4/2006 3:36:12 PM

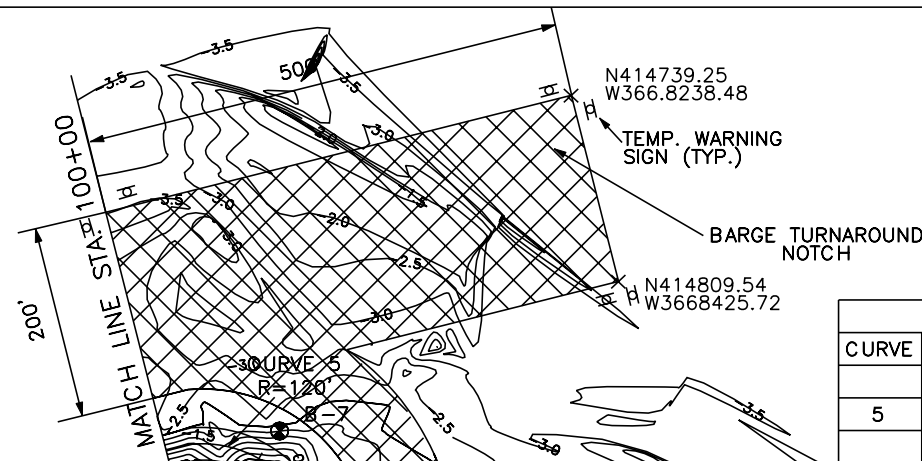

CURVE	PC STA.	PC		PT STA.	PT	
		X	Y		X	Y
5	100+28.30	3668643.14	414387.31	101+77.82	3668701.36	414514.67


97+80	414291.24	3668796.93
99+79	414443.60	3668929.05
100+70	414523.24	3668972.60
102+53	414704.42	3668997.57
104+29	414865.15	3669069.38
105+55	414966.07	3669095.58
109+36	415335.55	3669255.08
12+45	415625.74	3669373.38
14+79	415849.99	3669325.12
116+95	416062.85	3669363.22
117+83	416148.02	3669339.22
120+65	416411.94	3669241.74
121+88	416512.32	3669170.38

COORDINATES			
P.I. No.	STATION	NORTHING	EASTING
P.I. 50	100+28.30	414387.31	3668643.14
P.I. 51	101+77.82	414514.67	3668701.36
P.I. 52	102+90.90	414573.84	3668797.72
P.I. 53	103+64.33	414624.68	3668850.71
P.I. 54	104+92.39	414731.60	3668921.19
P.I. 55	106+52.18	414890.59	3668937.10
P.I. 56	107+96.24	415029.08	3668976.76
P.I. 57	112+4.35	415349.44	3669229.59
P.I. 58	114+99.55	415628.80	3669325.00
P.I. 59	117+22.95	415849.94	3669293.24
P.I. 60	119+37.01	416061.73	3669324.26
P.I. 61	120+16.43	416139.69	3669309.09
P.I. 62	122+91.83	416399.11	3669216.65
P.I. 63	124+8.17	416494.52	3669150.07

NOTE: SEE DWG. 26 OF 29
FISH DIP DETAILS

LEGEND

- SOIL BORING
- PERMANENT WARNING SIGN
- TEMPORARY WARNING SIGN
- FLOTATION ACCESS CHANNEL
- C/L ROCK REVETMENT
- P.I. NUMBER

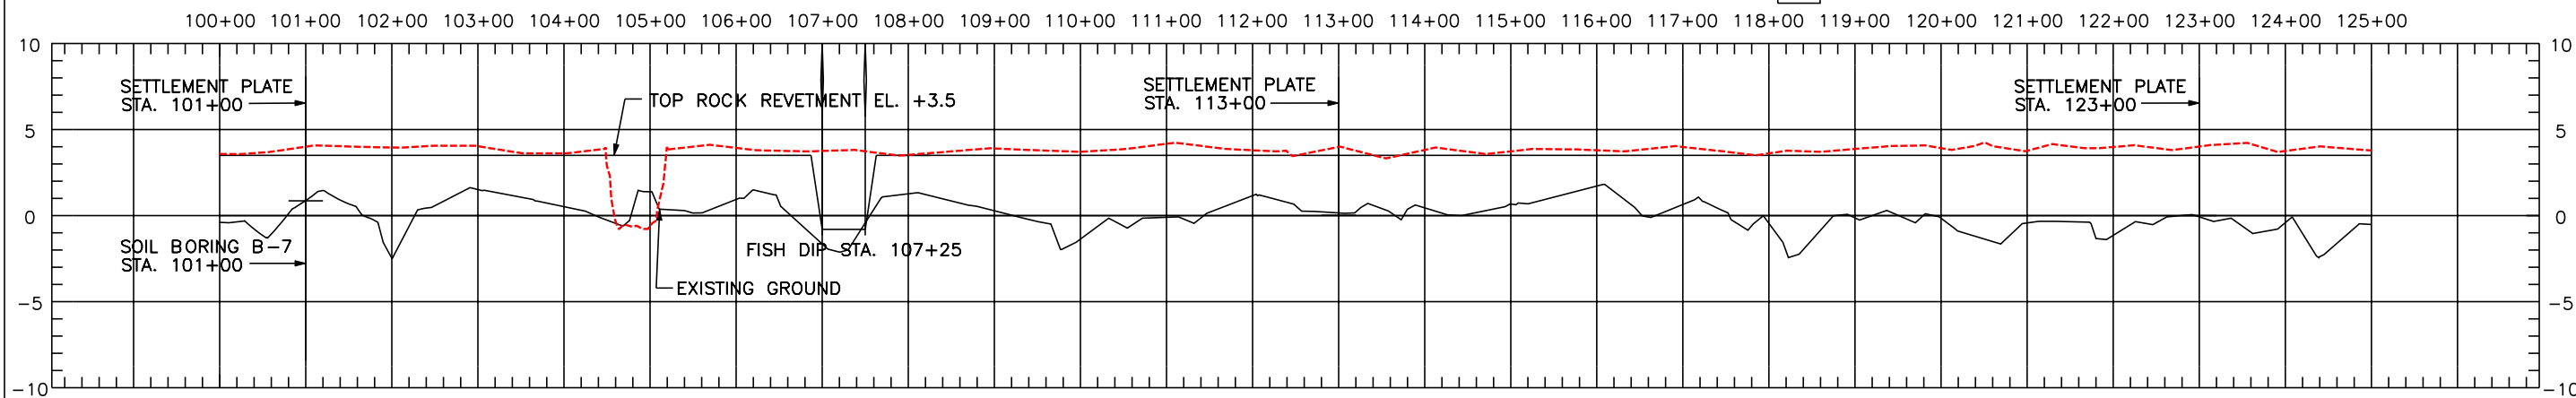


NOTES:

- P.I. COORDINATE LOCATIONS STAKED IN THE FIELD BY THE COTR MAY VARY SLIGHTLY FROM COORDINATES LISTED ABOVE DUE TO SHORELINE RECESSION.
- FINAL SETTLEMENT PLATE LOCATION WILL BE STAKED IN THE FIELD BY COTR.

NOTICE:
48 HOURS BEFORE DIGGING
CALL 1-800-272-3020
TO LOCATE UTILITY LINES

"AS-BUILT"

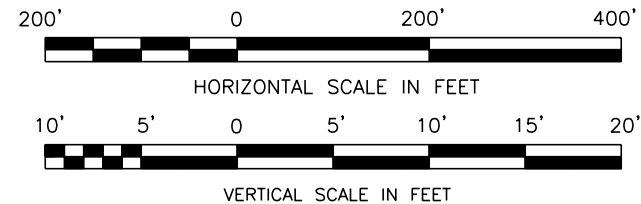

BURK-KLEINPETER, INC.
ENGINEERS, ARCHITECTS, PLANNERS, ENVIRONMENTAL SCIENTISTS
4176 CANAL STREET, NEW ORLEANS, LOUISIANA 70119-5994
(504) 488-5901 FAX (504) 488-1714

DESIGNED M. ROBERTS
CHECKED M. CHOPIN

DATE 1/04
SCALE AS SHOWN
SHEET NO. 8

PLAN AND PROFILE
BARATARIA BASIN LANDBRIDGE
PROJECT BA-27D-CU6
JEFFERSON PARISH, LA.



U.S. DEPARTMENT OF AGRICULTURE - NATURAL RESOURCES CONSERVATION SERVICE

NO.	DATE	APPR.	TITLE

CAD FILE NO.
DRAWING NO.
LA-352
SHT. 8 OF 29

COORDINATES			
P.I. No.	STATION	NORTHING	EASTING
P.I. 64	126+96.86	416609.65	3668937.32
P.I. 65	129+52.32	416831.84	3668725.09
P.I. 66	132+19.22	417057.70	3668582.87
P.I. 67	133+28.13	417161.55	3668615.69
P.I. 68	136+23.08	417382.52	3668811.05
P.I. 69	141+73.73	417864.41	3669077.49
P.I. 70	144+65.24	418148.52	3669012.19
P.I. 71	147+43.02	418426.22	3669018.93
P.I. 72	149+44.93	418624.08	3668978.67


124+80	416609.32	3668937.40
127+36	416832.26	3668724.89
130+14	417089.37	3668830.45
132+45	417294.36	3668835.67
136+41	417856.00	3669136.95
141+47	418154.46	3669070.99
144+22	418429.20	3669052.78
146+37	418639.29	3668987.67

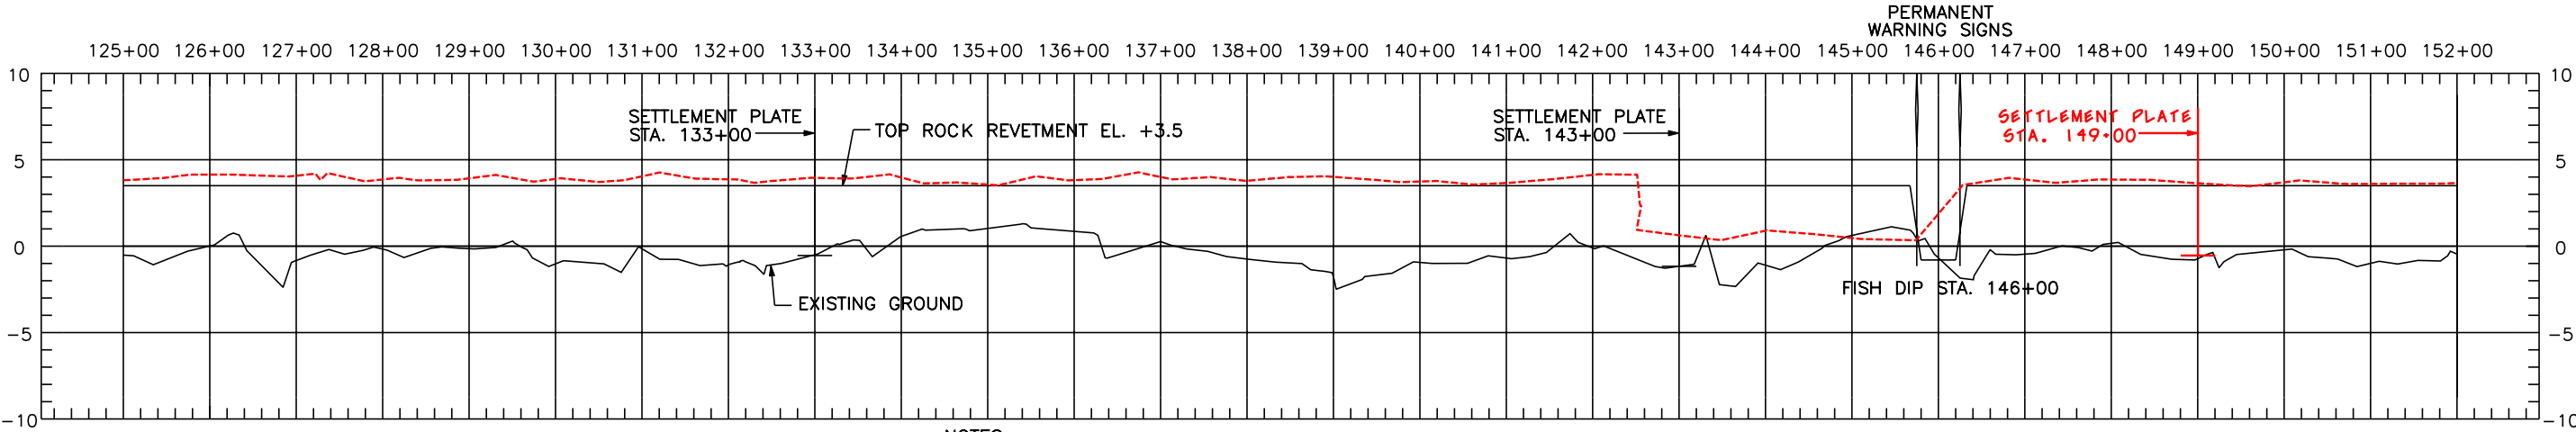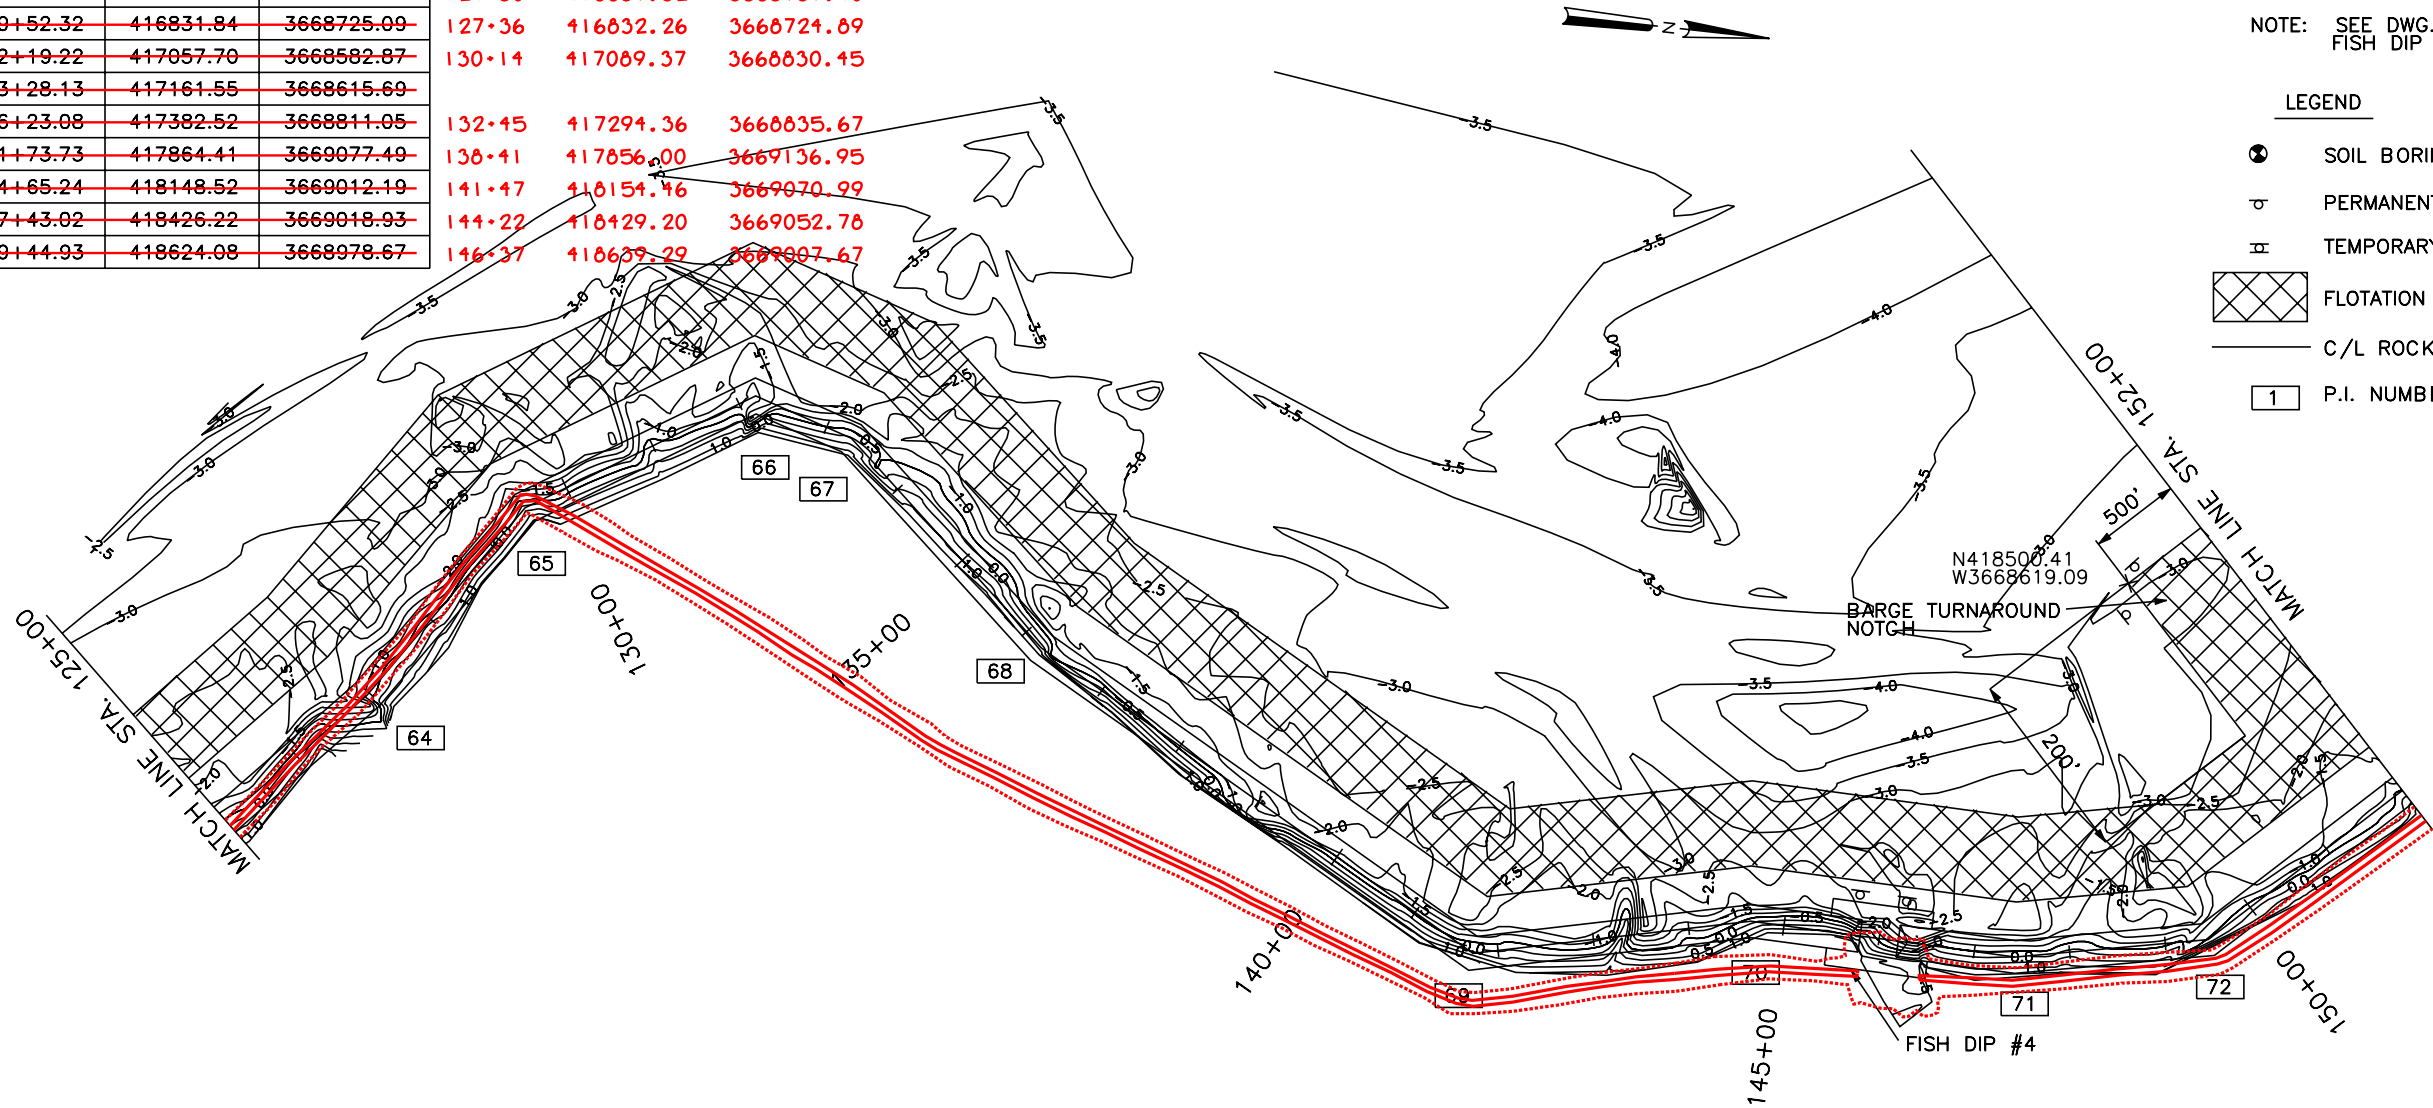

- NOTES:
- P.I. COORDINATE LOCATIONS STAKED IN THE FIELD BY THE COTR MAY VARY SLIGHTLY FROM COORDINATES LISTED ABOVE DUE TO SHORELINE RECESSION.
 - FINAL SETTLEMENT PLATE LOCATION WILL BE STAKED IN THE FIELD BY COTR.

NOTICE:
48 HOURS BEFORE DIGGING
CALL 1-800-272-3020
TO LOCATE UTILITY LINES

"AS-BUILT"

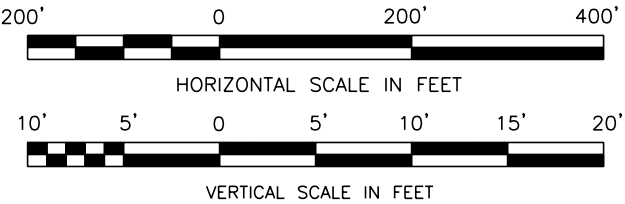

BURK-KLEINPETER, INC.
ENGINEERS, ARCHITECTS, PLANNERS, ENVIRONMENTAL SCIENTISTS
4176 CANAL STREET, NEW ORLEANS, LOUISIANA 70119-5994
(504) 486-5901 FAX (504) 486-1714

DESIGNED M. ROBERTS
CHECKED M. CHOPIN


DATE 1/04
SCALE AS SHOWN
SHEET NO. 9

PLAN AND PROFILE
BARATARIA BASIN LANDBRIDGE
PROJECT BA-27D-CU6
JEFFERSON PARISH, LA.

U.S. DEPARTMENT OF AGRICULTURE - NATURAL RESOURCES CONSERVATION SERVICE

REVISIONS	NO.	DATE	APPR.	TITLE


CAD FILE NO.
DRAWING NO.
LA-352
SHT. 9 OF 29

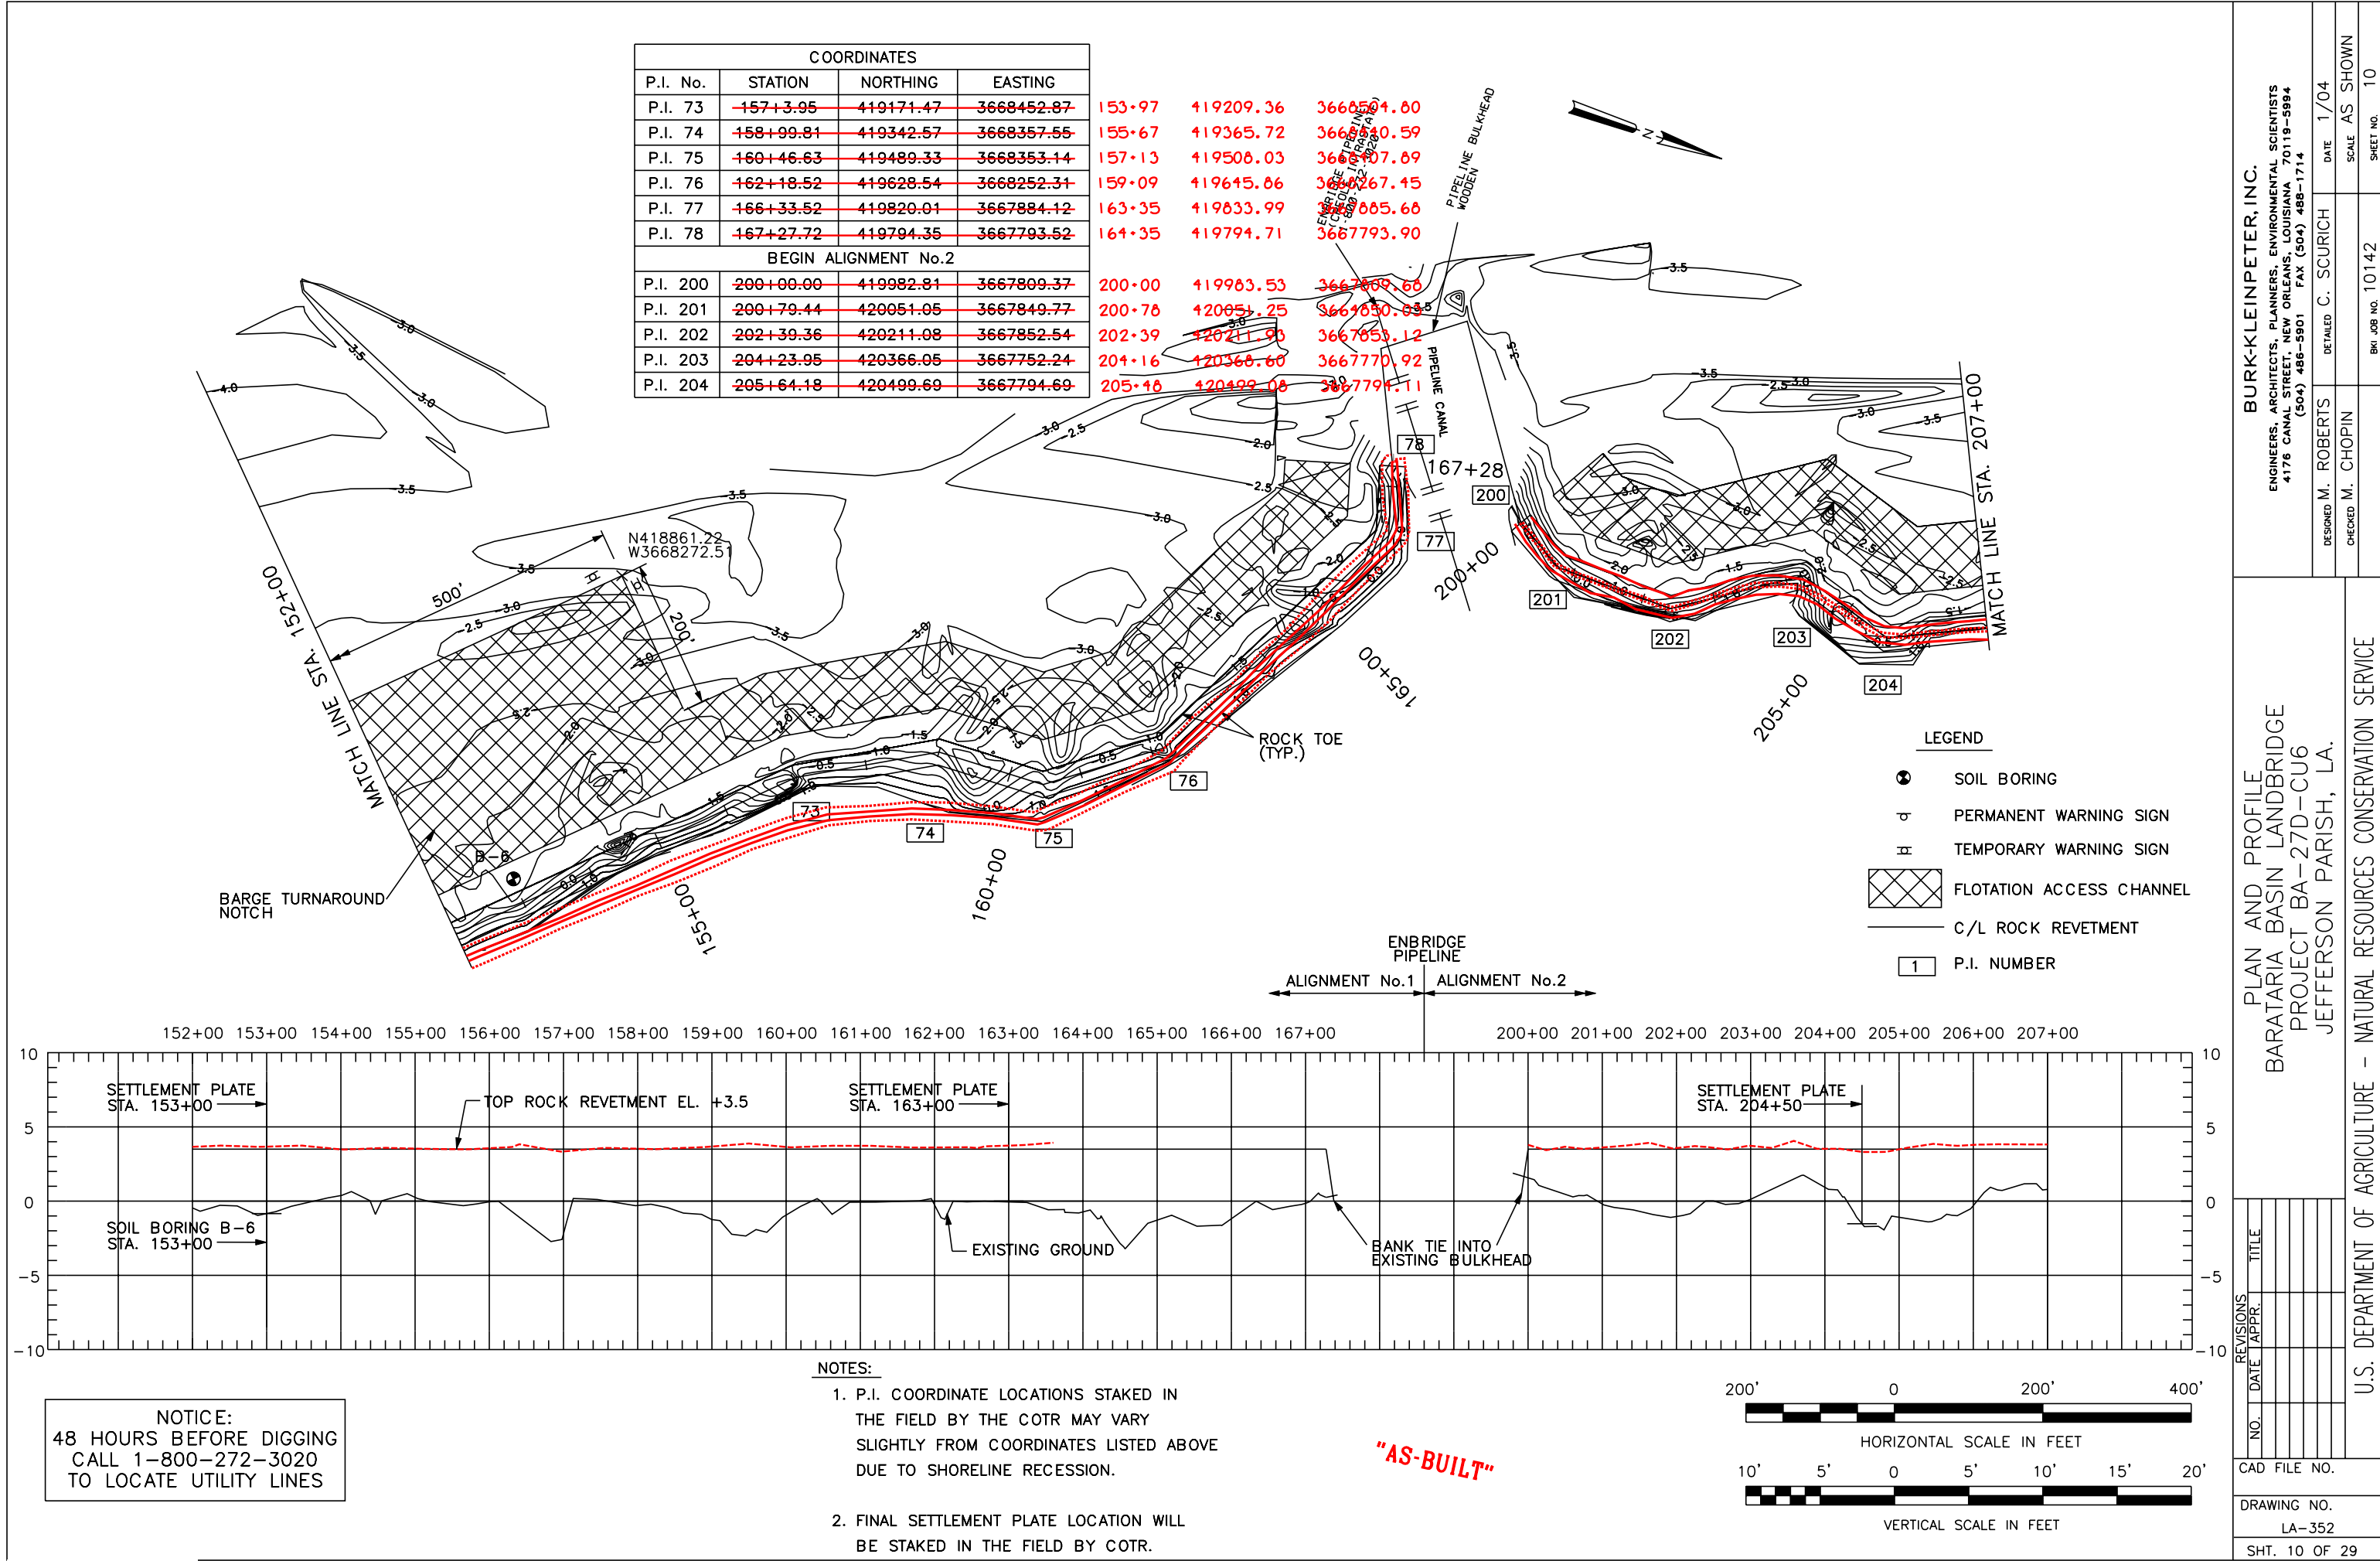

CURVE	PC STA.	PC		PT STA.	PT		L	T	△
		X	Y		X	Y			
6	219+49.40	3667118.52	421651.21	220+93.33	3667184.84	421759.92	143.93'	96.11'	97°01'16.5"
7	221+67.01	3667256.98	421774.88	222+44.49	3667291.92	421835.49	77.48'	48.95'	88°46'46.6"

LEGEND			
●	207+43	420675.79	3667713.05
⊙	206+95	420808.61	3667638.21
⊕	212+50	421159.05	3667347.17
⊖	214+36	421197.03	3667279.21
⊗	219+49	421651.21	3667118.52
⊘	220+93	421759.92	3667184.84
⊙	221+67	421774.88	3667256.98
⊖	222+44	421835.49	3667291.92
⊗	223+02	421948.29	3667279.67
⊘	223+86	422032.21	3667282.67
⊙	224+29	422070.30	3667303.99
⊖	226+58	422292.27	3667246.81
⊗	228+44	422470.42	3667300.37
⊘	229+82	422589.45	3667230.66

COORDINATES			
P.I. No.	STATION	NORTHING	EASTING
P.I. 205	207+58.05	420675.36	3667712.66
P.I. 206	209+10.65	420808.36	3667637.85
P.I. 207	212+94.87	421121.78	3667415.59
P.I. 208	213+83.67	421128.05	3667327.02
P.I. 209	214+68.22	421197.51	3667278.80
P.I. 210	219+49.40	421651.21	3667118.52
P.I. 211	220+93.33	421759.92	3667184.84
P.I. 212	221+67.01	421774.88	3667256.98
P.I. 213	222+44.49	421835.49	3667291.92
P.I. 214	223+62.60	421944.41	3667246.26
P.I. 215	224+63.94	422044.04	3667264.83
P.I. 216	225+11.83	422070.62	3667304.66
P.I. 217	227+40.26	422292.02	3667248.42
P.I. 218	229+15.50	422465.10	3667275.86
P.I. 219	230+47.18	422580.95	3667213.26

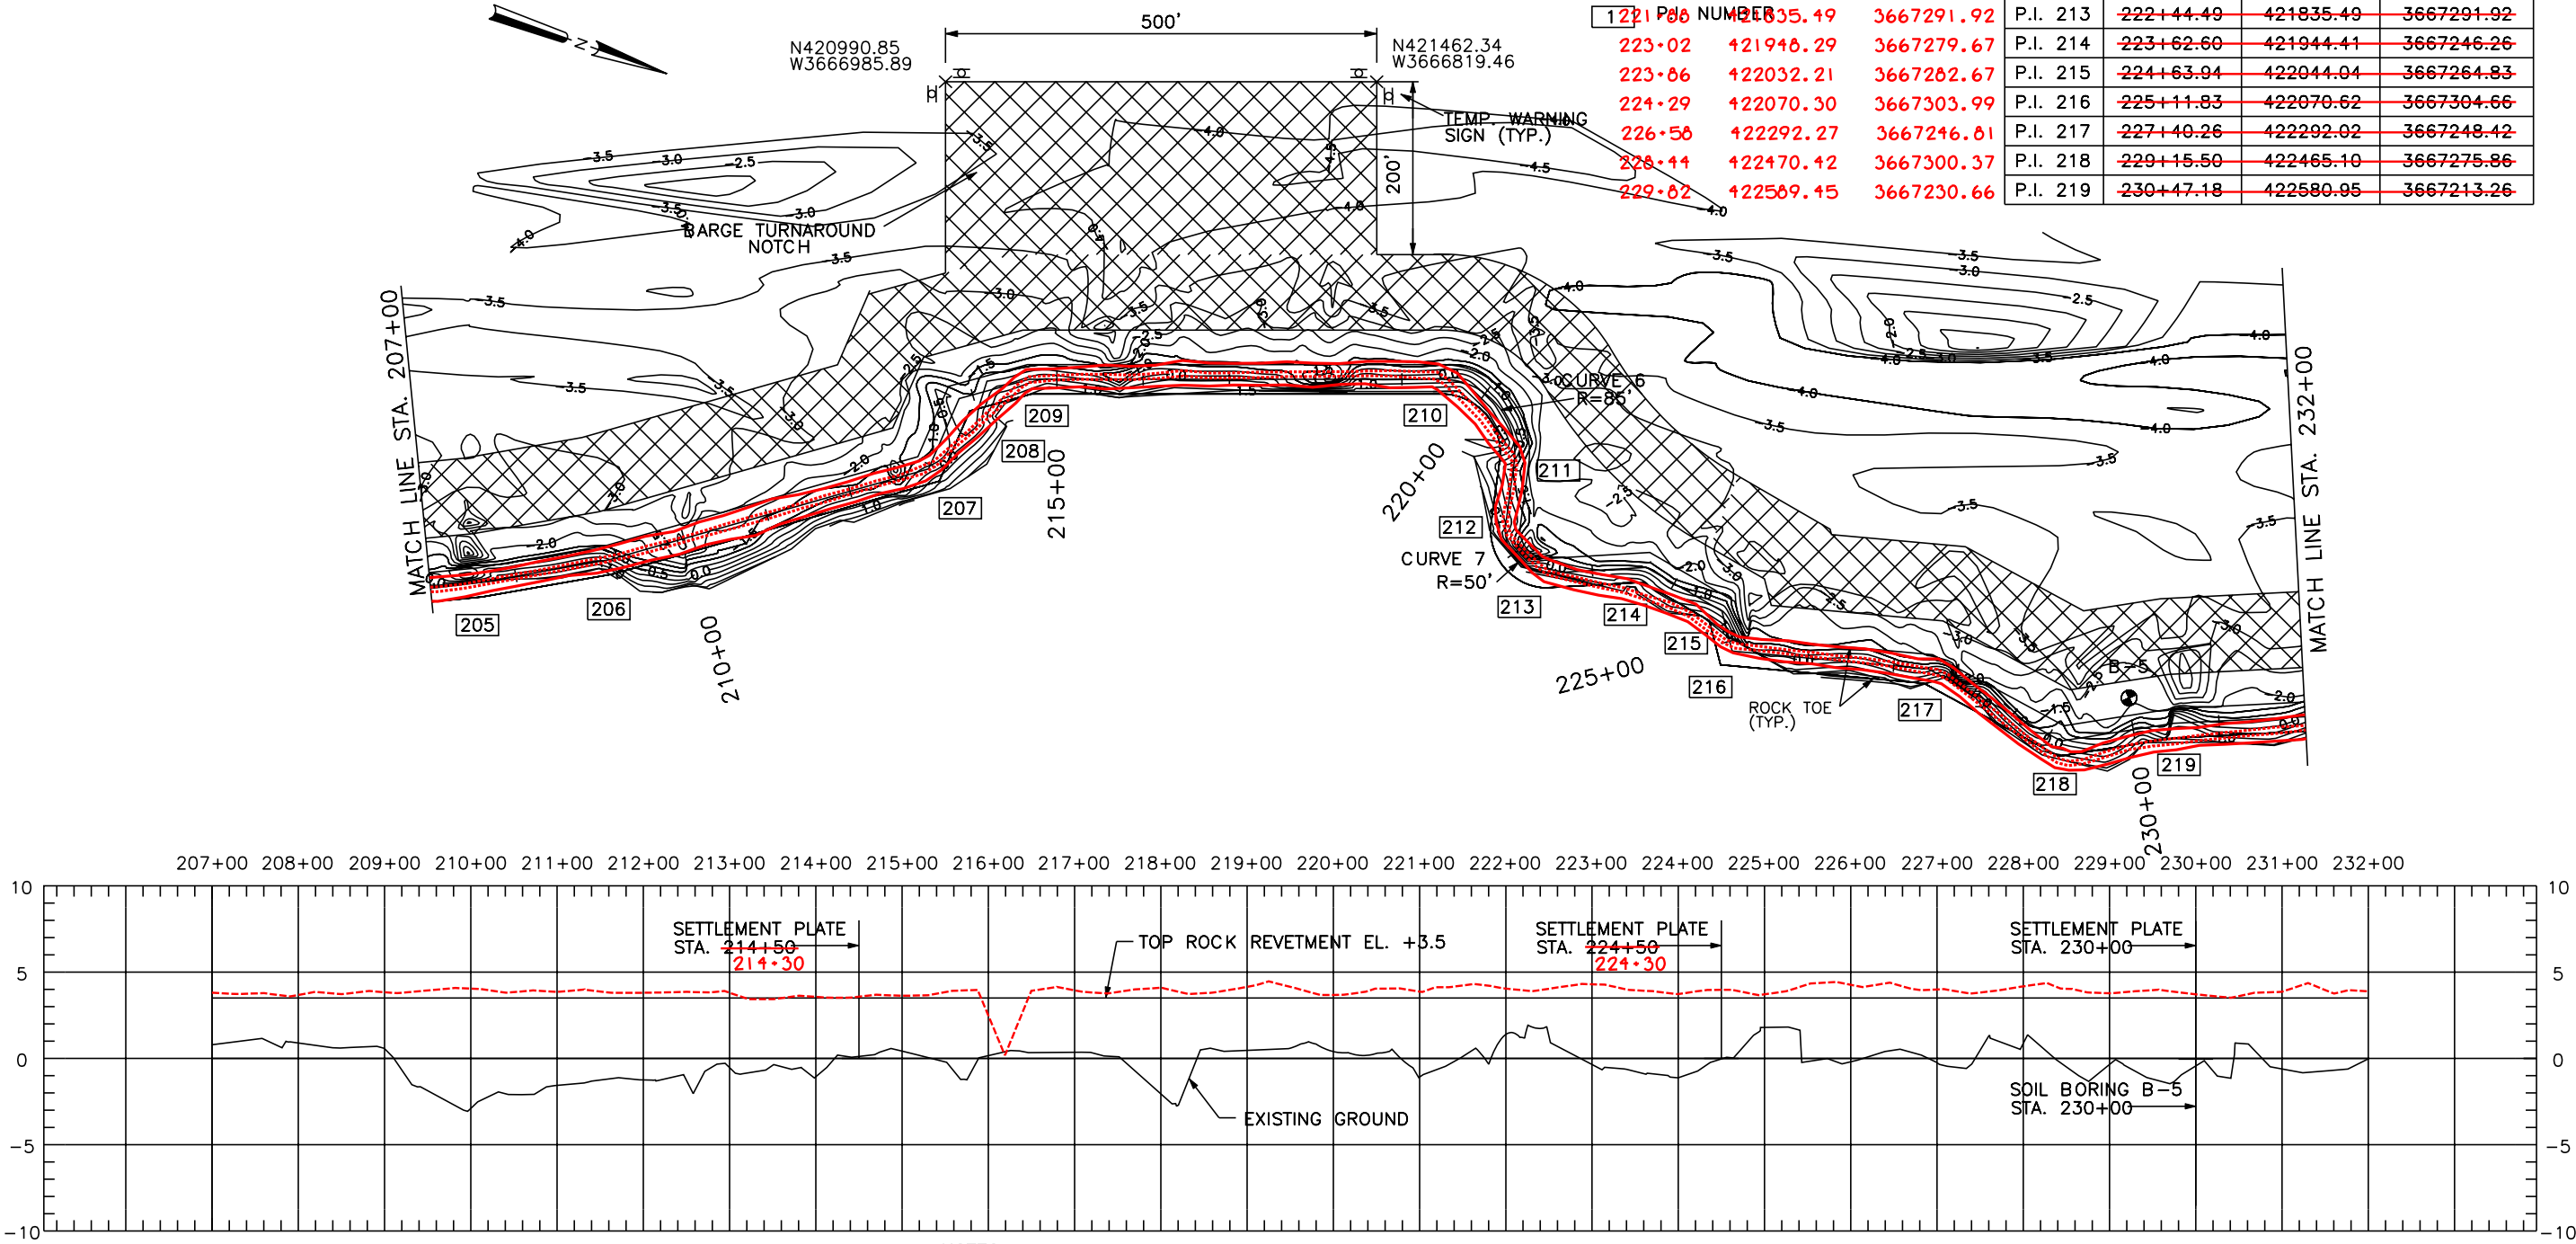


NOTES:

- P.I. COORDINATE LOCATIONS STAKED IN THE FIELD BY THE COTR MAY VARY SLIGHTLY FROM COORDINATES LISTED ABOVE DUE TO SHORELINE RECESSION.
- FINAL SETTLEMENT PLATE LOCATION WILL BE STAKED IN THE FIELD BY COTR.

NOTICE:
48 HOURS BEFORE DIGGING
CALL 1-800-272-3020
TO LOCATE UTILITY LINES

"AS-BUILT"

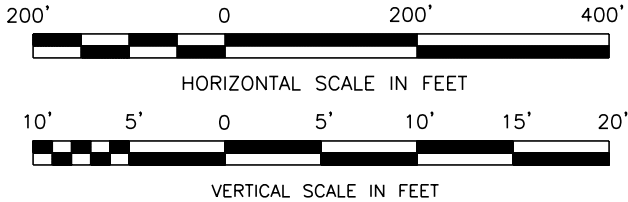

PLAN AND PROFILE
BARATARIA BASIN LANDBRIDGE
PROJECT BA-27D-CU6
JEFFERSON PARISH, LA.

BURK-KLEINPETER, INC.
ENGINEERS, ARCHITECTS, PLANNERS, ENVIRONMENTAL SCIENTISTS
4176 CANAL STREET, NEW ORLEANS, LOUISIANA 70119-5994
(504) 488-5901 FAX (504) 488-1714

DESIGNED M. ROBERTS

CHECKED M. CHOPIN

DATE 1/04

SCALE AS SHOWN

SHEET NO. 11


U.S. DEPARTMENT OF AGRICULTURE - NATURAL RESOURCES CONSERVATION SERVICE

NO.	DATE	TITLE

CAD FILE NO.

DRAWING NO.
LA-352

SHT. 11 OF 29

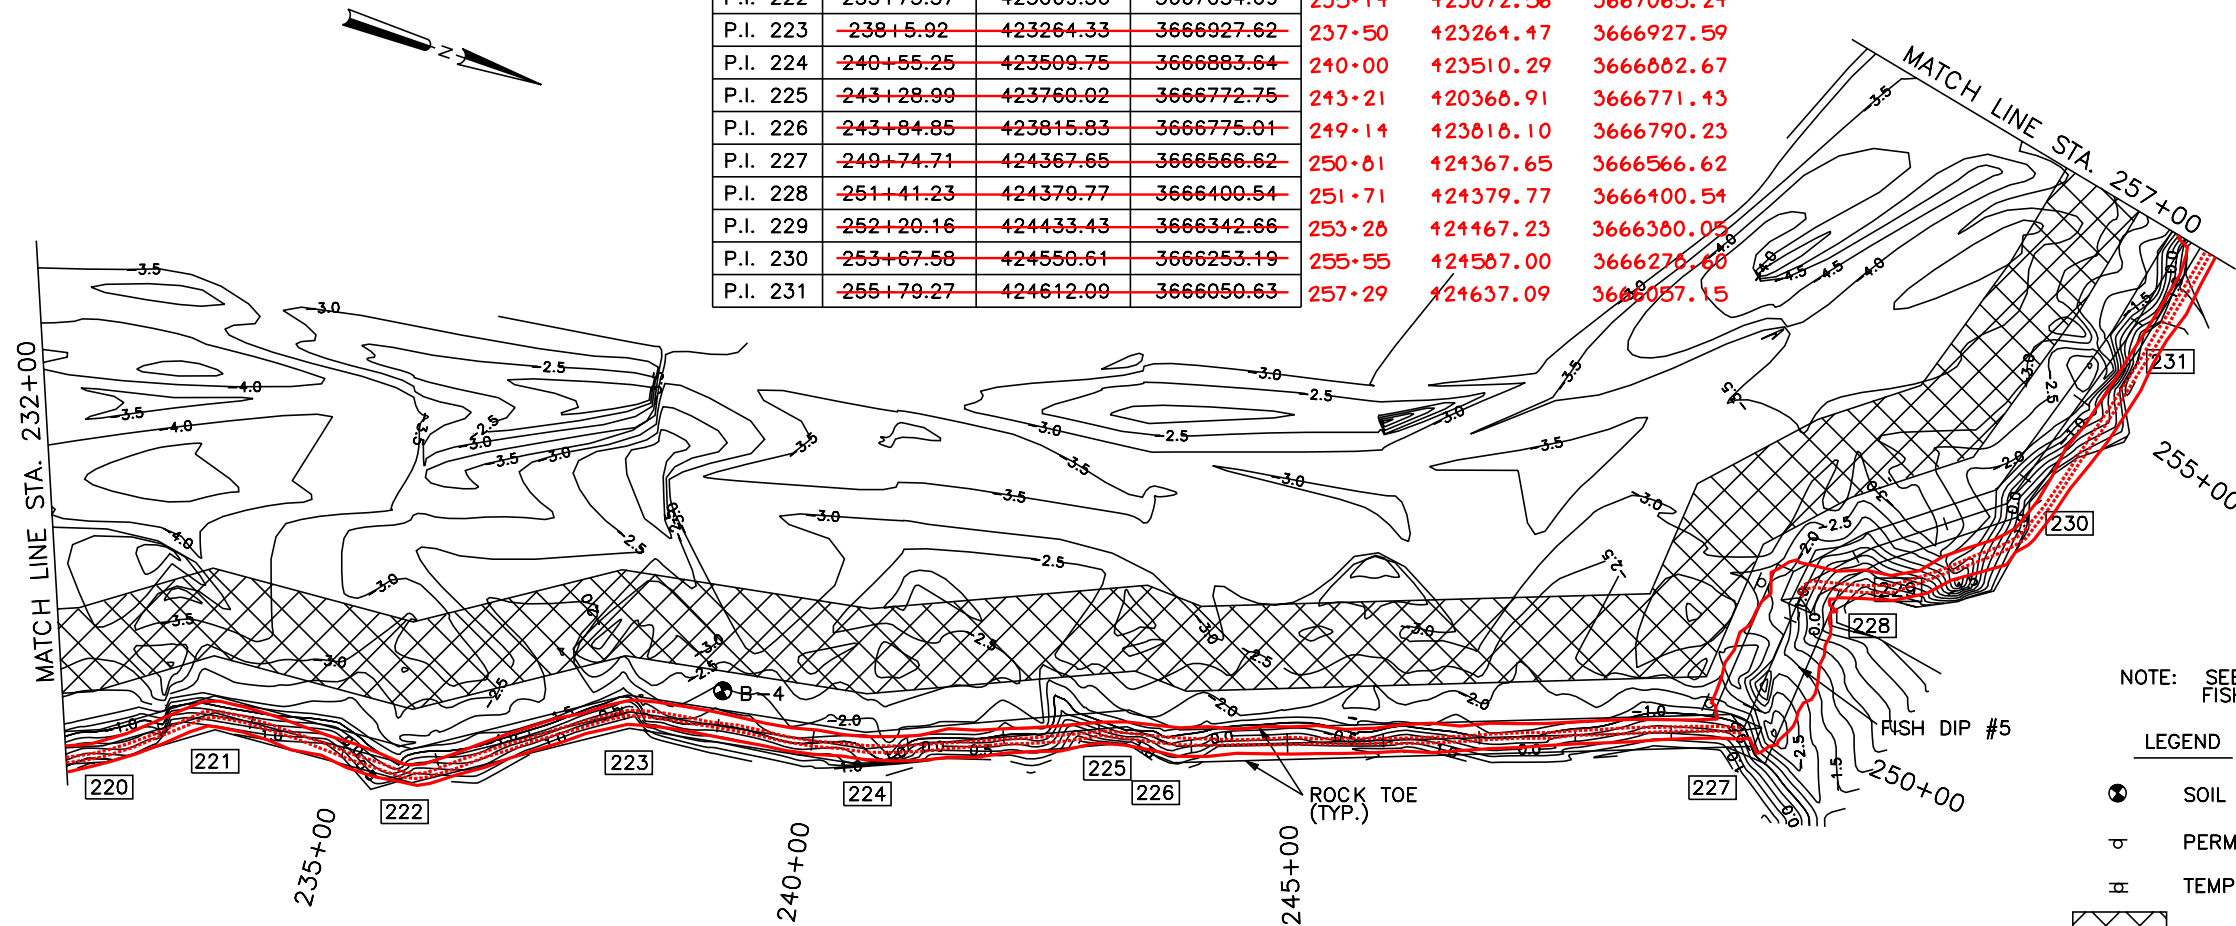


COORDINATES			
P.I. No.	STATION	NORTHING	EASTING
P.I. 220	232+39.17	422758.49	3667140.17
P.I. 221	233+60.68	422857.39	3667069.59
P.I. 222	235+73.37	423069.56	3667054.69
P.I. 223	238+5.92	423264.33	3666927.62
P.I. 224	240+55.25	423509.75	3666883.64
P.I. 225	243+28.99	423760.02	3666772.75
P.I. 226	243+84.85	423815.83	3666775.01
P.I. 227	249+74.71	424367.65	3666566.62
P.I. 228	251+41.23	424379.77	3666400.54
P.I. 229	252+20.16	424433.43	3666342.66
P.I. 230	253+67.58	424550.61	3666253.19
P.I. 231	255+79.27	424612.09	3666050.63

231+75	422764.61	3667149.87
232+99	422857.61	3667068.59
235+14	423072.56	3667065.24
237+50	423264.47	3666927.59
240+00	423510.29	3666882.67
243+21	420368.91	3666771.43
249+14	423818.10	3666790.23
250+81	424367.65	3666566.62
251+71	424379.77	3666400.54
253+28	424467.23	3666380.05
255+55	424587.00	3666276.68
257+29	424637.09	3666057.15

NOTE: SEE DWG. 26 OF 29
FISH DIP DETAILS

LEGEND

- SOIL BORING
- PERMANENT WARNING SIGN
- TEMPORARY WARNING SIGN
- FLOTATION ACCESS CHANNEL
- C/L ROCK REVETMENT
- P.I. NUMBER

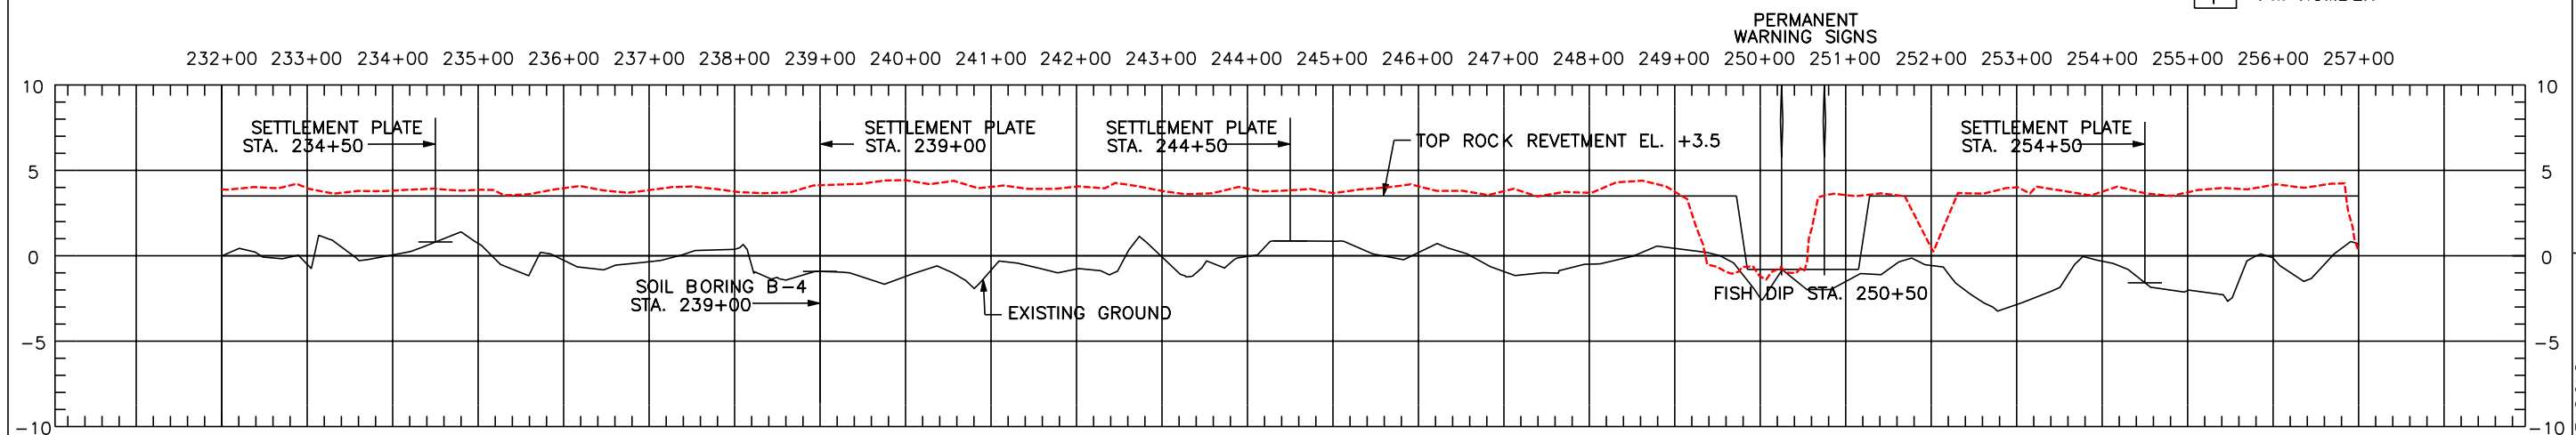


NOTES:

- P.I. COORDINATE LOCATIONS STAKED IN THE FIELD BY THE COTR MAY VARY SLIGHTLY FROM COORDINATES LISTED ABOVE DUE TO SHORELINE RECESSION.
- FINAL SETTLEMENT PLATE LOCATION WILL BE STAKED IN THE FIELD BY COTR.

NOTICE:
48 HOURS BEFORE DIGGING
CALL 1-800-272-3020
TO LOCATE UTILITY LINES

"AS-BUILT"

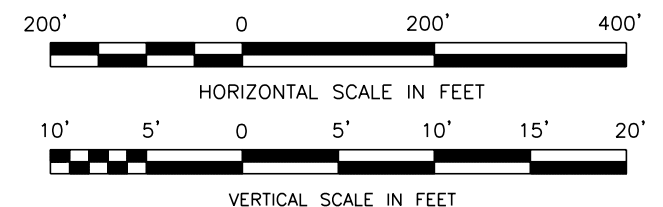


BURK-KLEINPETER, INC.
ENGINEERS, ARCHITECTS, PLANNERS, ENVIRONMENTAL SCIENTISTS
4176 CANAL STREET, NEW ORLEANS, LOUISIANA 70119-5994
(504) 486-5901 FAX (504) 486-1714

DESIGNED M. ROBERTS
CHECKED M. CHOPIN
DATE 1/04
SCALE AS SHOWN
SHEET NO. 12

PLAN AND PROFILE
BARATARIA BASIN LANDBRIDGE
PROJECT BA-27D-CU6
JEFFERSON PARISH, LA.


U.S. DEPARTMENT OF AGRICULTURE - NATURAL RESOURCES CONSERVATION SERVICE
REVISIONS
NO. DATE APPR. TITLE
CAD FILE NO.
DRAWING NO.
LA-352
SHT. 12 OF 29

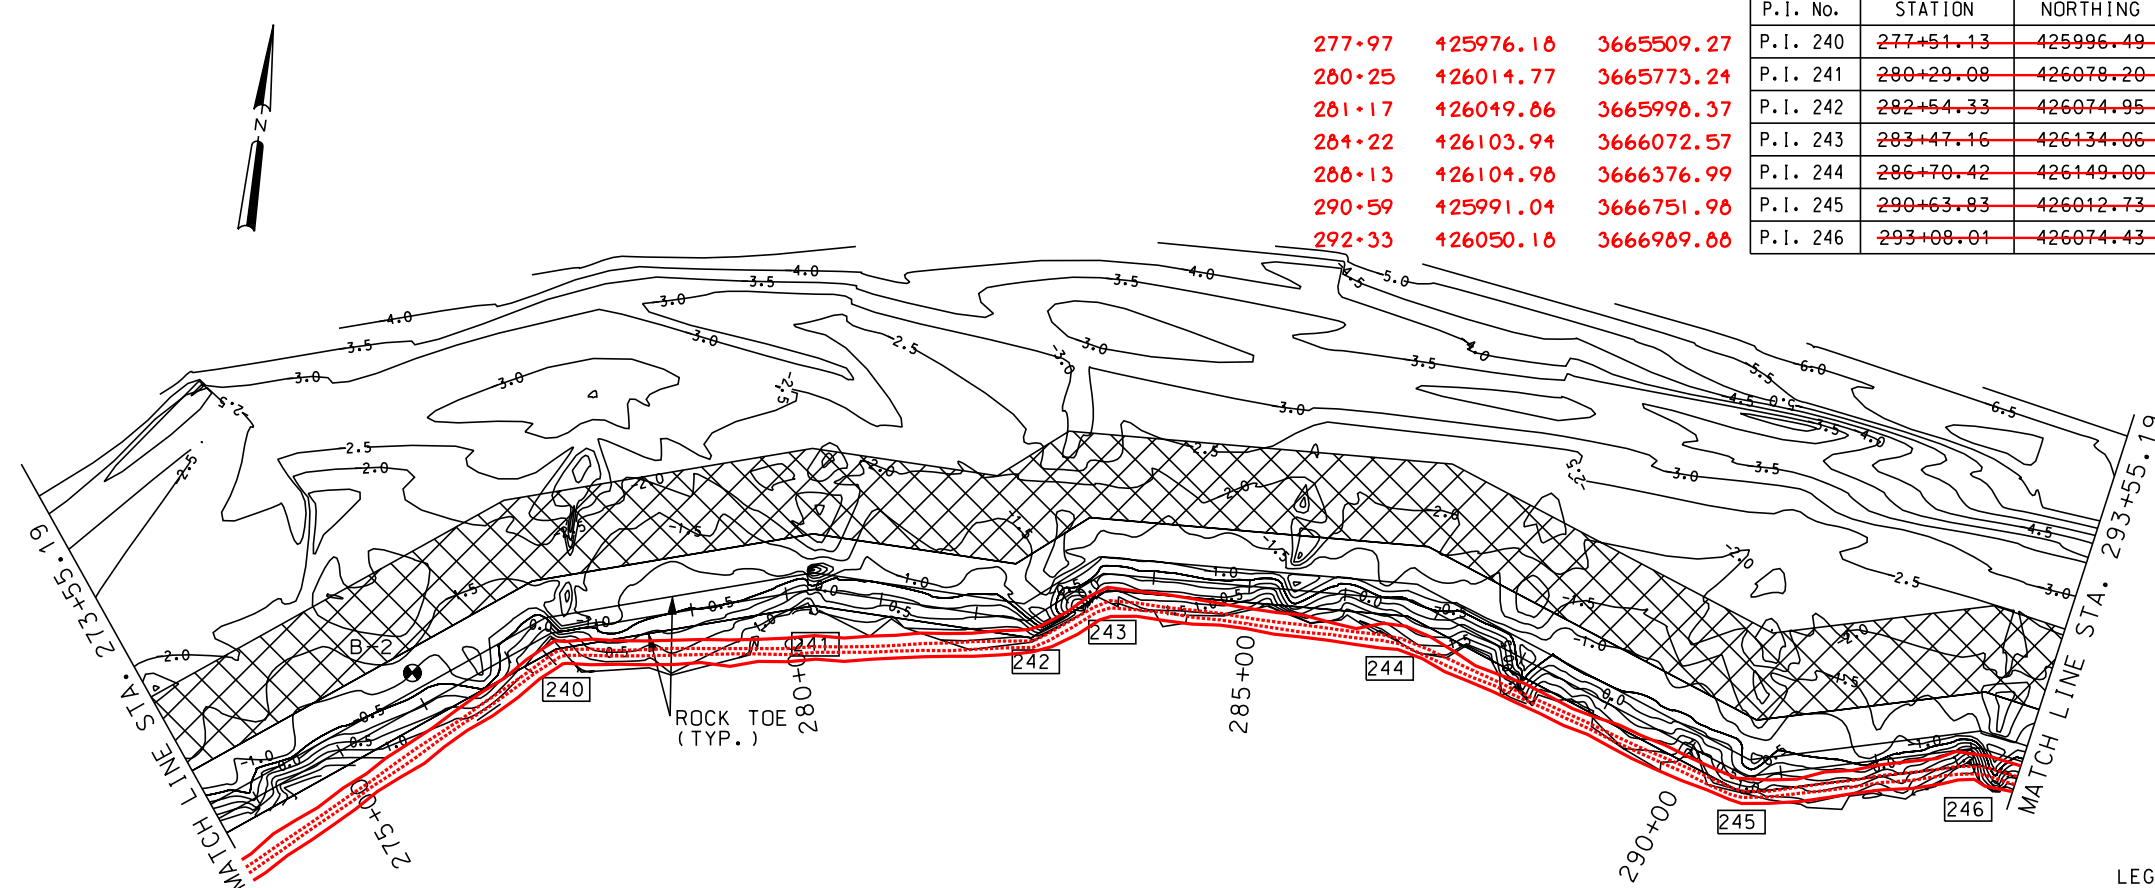

COORDINATES			
P.I. No.	STATION	NORTHING	EASTING
P.I. 240	277+51.13	425996.49	3665498.56
P.I. 241	280+29.08	426078.20	3665764.22
P.I. 242	282+54.33	426074.95	3665989.44
P.I. 243	283+47.16	426134.06	3666061.04
P.I. 244	286+70.42	426149.00	3666383.94
P.I. 245	290+63.83	426012.73	3666753.00
P.I. 246	293+08.01	426074.43	3666989.26

277+97	425976.18	3665509.27
280+25	426014.77	3665773.24
281+17	426049.86	3665998.37
284+22	426103.94	3666072.57
286+13	426104.98	3666376.99
290+59	425991.04	3666751.98
292+33	426050.18	3666989.88


- LEGEND
- SOIL BORING
 - PERMANENT WARNING SIGN
 - TEMPORARY WARNING SIGN
 - FLOTATION ACCESS CHANNEL
 - C/L ROCK REVETMENT
 - P.I. NUMBER

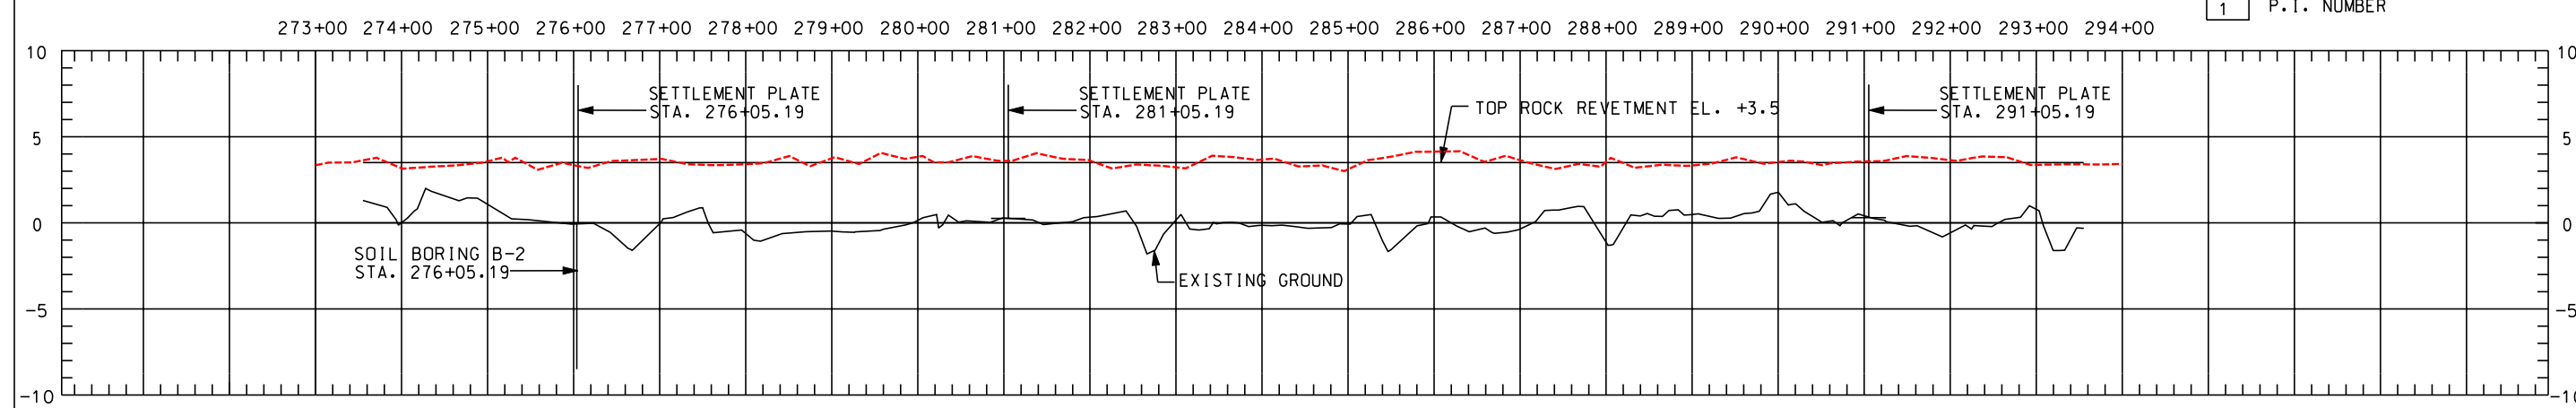

- NOTES:
- P.I. COORDINATE LOCATIONS STAKED IN THE FIELD BY THE COTR MAY VARY SLIGHTLY FROM COORDINATES LISTED ABOVE DUE TO SHORELINE RECESSON.
 - FINAL SETTLEMENT PLATE LOCATION WILL BE STAKED IN THE FIELD BY COTR.

NOTICE:
48 HOURS BEFORE DIGGING
CALL 1-800-272-3020
TO LOCATE UTILITY LINES

"AS-BUILT"

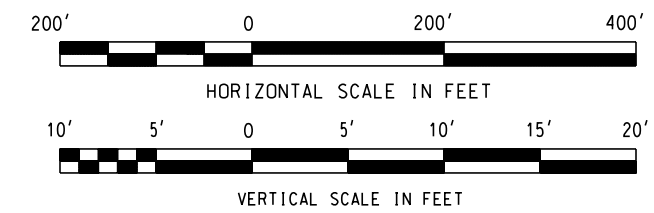

BURK KLEIN PETER, INC.
ENGINEERS, ARCHITECTS, PLANNERS, ENVIRONMENTAL SCIENTISTS
4176 CANAL STREET, NEW ORLEANS, LOUISIANA 70119-5994
(504) 486-5901 FAX (504) 486-1714

DESIGNED M. ROBERTS
CHECKED M. CHOPIN

DATE 1/04
SCALE AS SHOWN
SHEET NO. 14

PLAN AND PROFILE
BARATARIA BASIN LANDBRIDGE
PROJECT BA-27D-CU6
JEFFERSON PARISH, LA.


U.S. DEPARTMENT OF AGRICULTURE - NATURAL RESOURCES CONSERVATION SERVICE

REVISIONS
NO. DATE APPR. TITLE


CAD FILE NO.

DRAWING NO.
LA-352


SHT. 14 OF 29

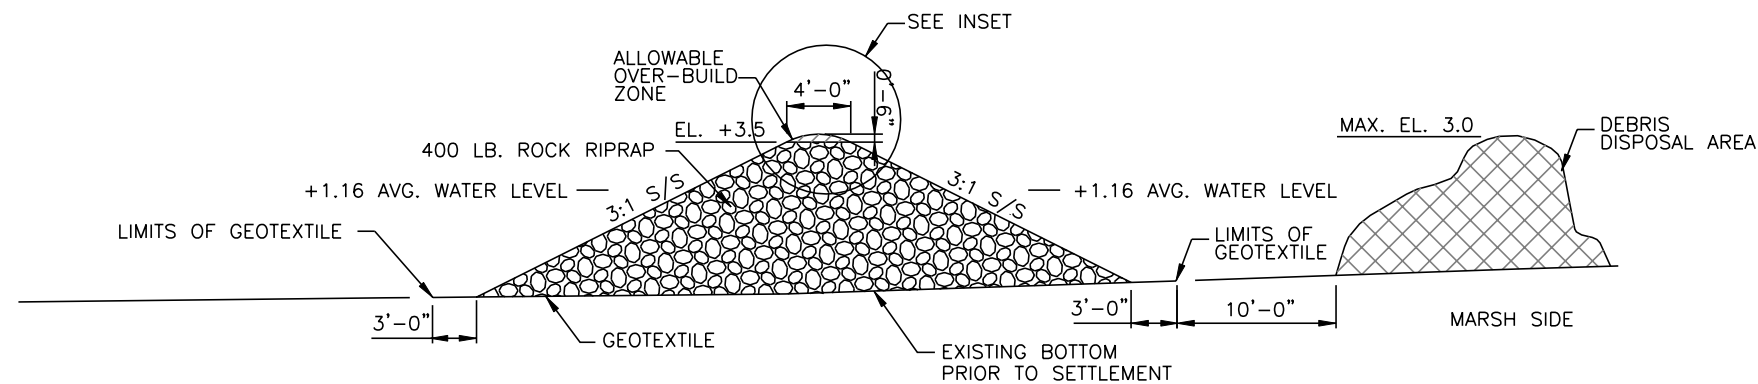


TYPICAL SECTION – ROCK DIKE
ELEVATION VIEW

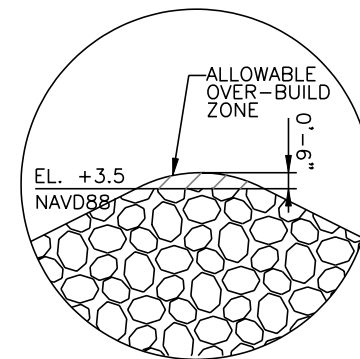

INSET – ROUNDED TOP SECTION OF ROCK

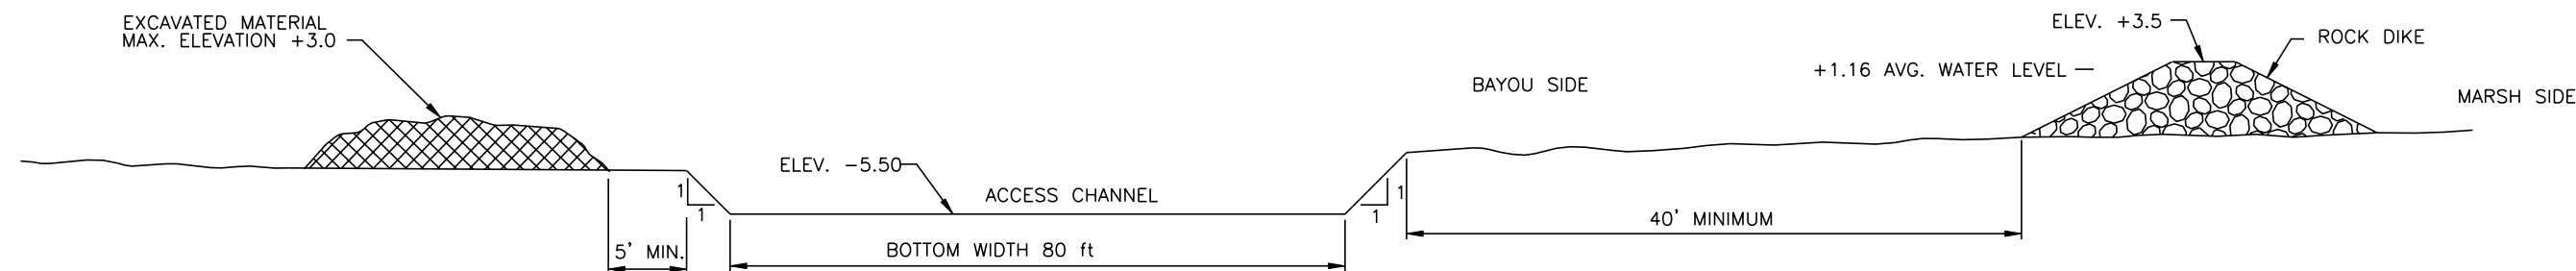

TYPICAL SECTION – PARALLEL ACCESS CHANNEL
(NOT TO SCALE)

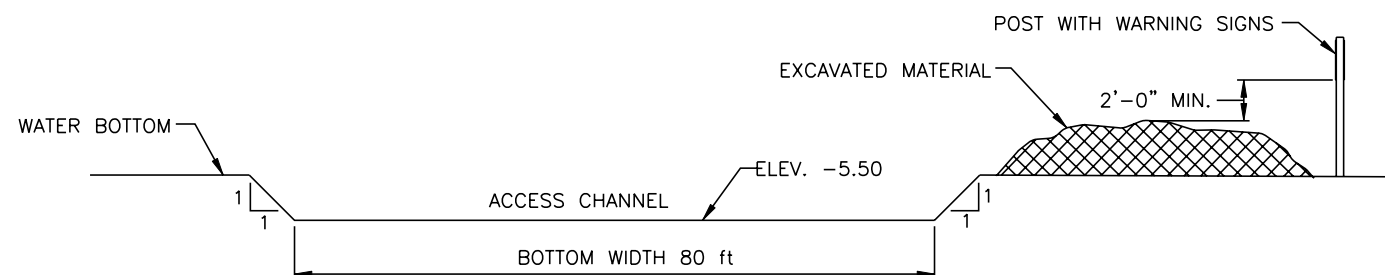

TYPICAL SECTION
PERPENDICULAR FLOTATION ACCESS CHANNEL
(NOT TO SCALE)

NOTES:

1. MATERIAL DREDGED FROM THE ACCESS CHANNEL SHALL BE PLACED ON THE BAYOU SIDE OF THE ACCESS CHANNEL CARE SHALL BE TAKEN NOT TO DISTURB THE EXISTING MARSH VEGETATION. CHANNEL SPOIL SHALL BE PULLED BACK INTO THE CHANNEL ONCE CONSTRUCTION HAS BEEN COMPLETED.
2. WHEN EXCAVATED MATERIAL IS PLACED ON THE WATER SIDE, TEMPORARY WARNING SIGNS SHALL BE PLACED & MAINTAINED UNTIL THE NAVIGATION HAZARD IS REMOVED. THE ACCESS CHANNEL SHALL BE BACK-FILLED WITH THE EXCAVATED MATERIAL.

"AS-BUILT"

BURK-KLEINPETER, INC.
ENGINEERS, ARCHITECTS, PLANNERS, ENVIRONMENTAL SCIENTISTS
4176 CANAL STREET, NEW ORLEANS, LOUISIANA 70119-5994
(504) 486-5901 FAX (504) 486-1714

DESIGNED	M. ROBERTS	DATE	1/04
CHECKED	M. CHOPIN	SCALE	AS SHOWN
BKI JOB NO. 10142		SHEET NO. 16	

TYPICAL SECTIONS
BARATARIA BASIN LANDBRIDGE
PROJECT BA-27D-CU 6
JEFFERSON PARISH, LA.


NO.	DATE	REVISIONS	TITLE

CAD FILE NO.


DRAWING NO.
LA-352

SHEET NO 16 OF 29

U.S. DEPARTMENT OF AGRICULTURE – NATURAL RESOURCES CONSERVATION SERVICE

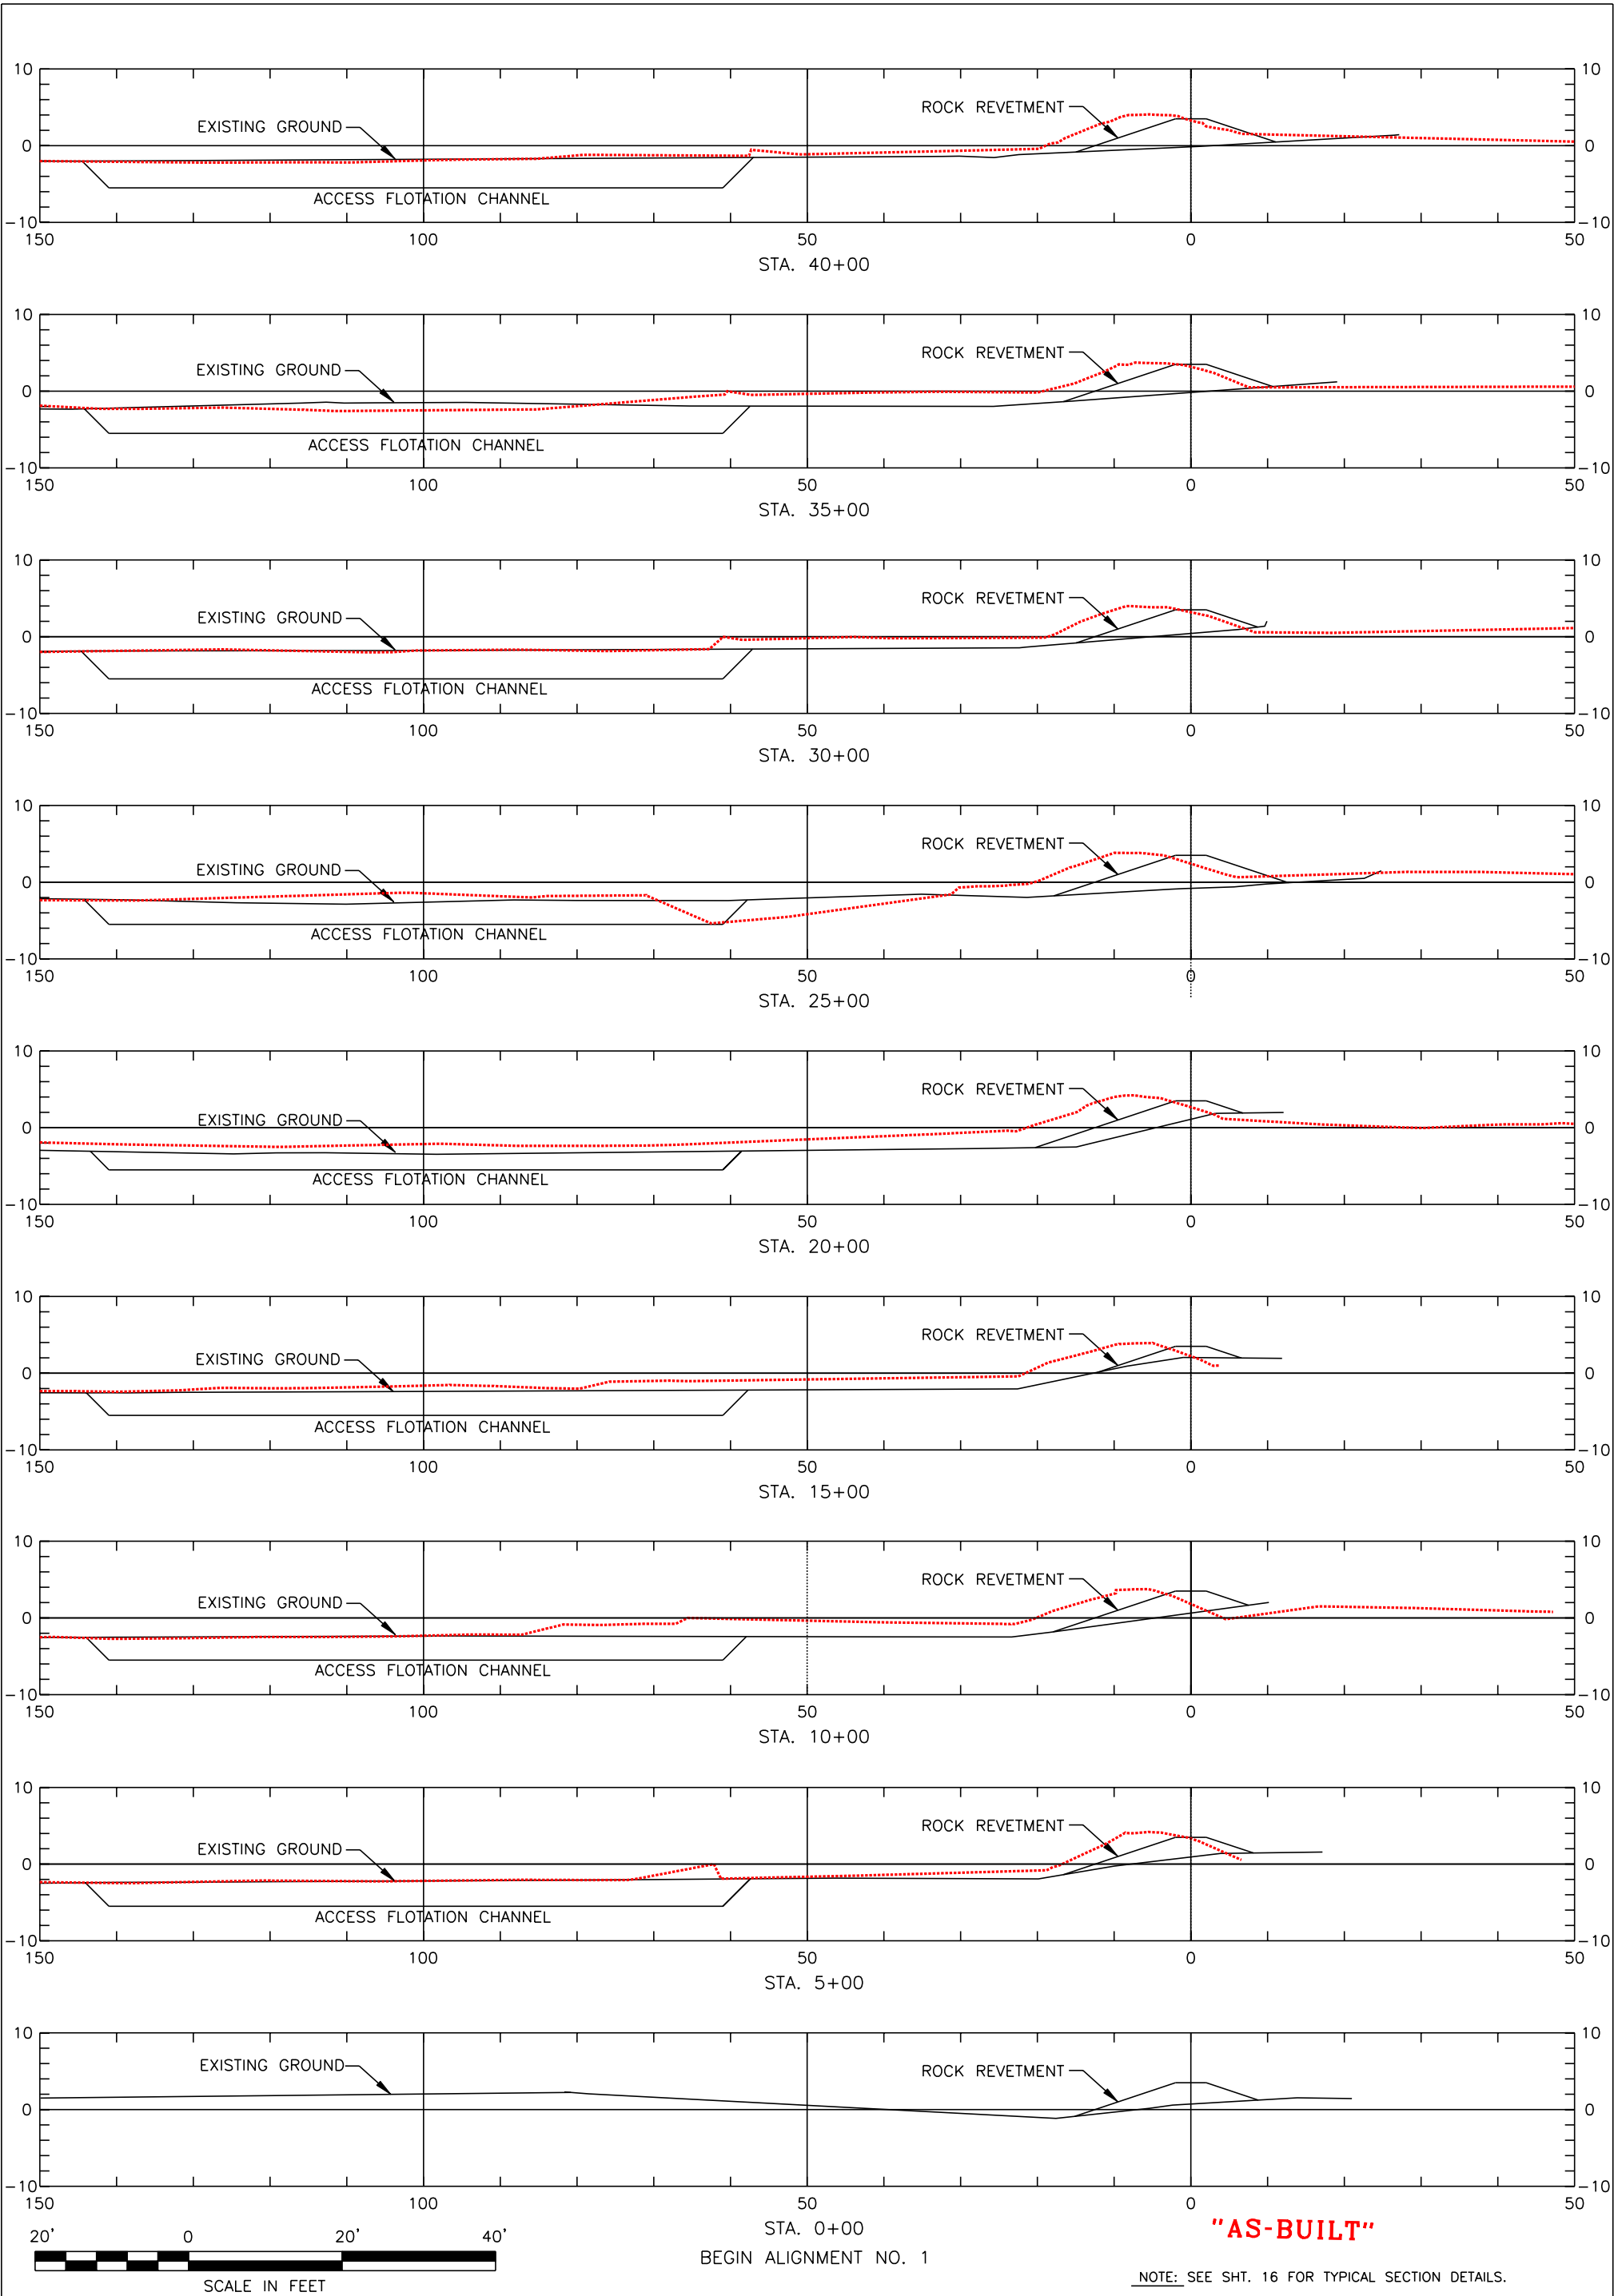


Sht. 17 of 29	DRAWING NO. LA-352	CAD FILE NO.	REVISIONS				CROSS SECTIONS BARATARIA BASIN LANDBRIDGE PROJECT BA-27D-CU6 JEFFERSON PARISH, LA.				BURK-KLEINPETER, INC. ENGINEERS, ARCHITECTS, PLANNERS, ENVIRONMENTAL SCIENTISTS 4176 CANAL STREET, NEW ORLEANS, LOUISIANA 70119-5994 (504) 486-5901 FAX (504) 488-1714										
			NO.	DATE	APPR.	TITLE															
			U.S. DEPARTMENT OF AGRICULTURE - NATURAL RESOURCES CONSERVATION SERVICE							DESIGNED		M. ROBERTS	DETAILED		C. SCURICH	DATE		1/04			
										CHECKED		M. CHOPIN					SCALE		AS SHOWN		
														BKI JOB NO.		10142		SHEET NO.		17	

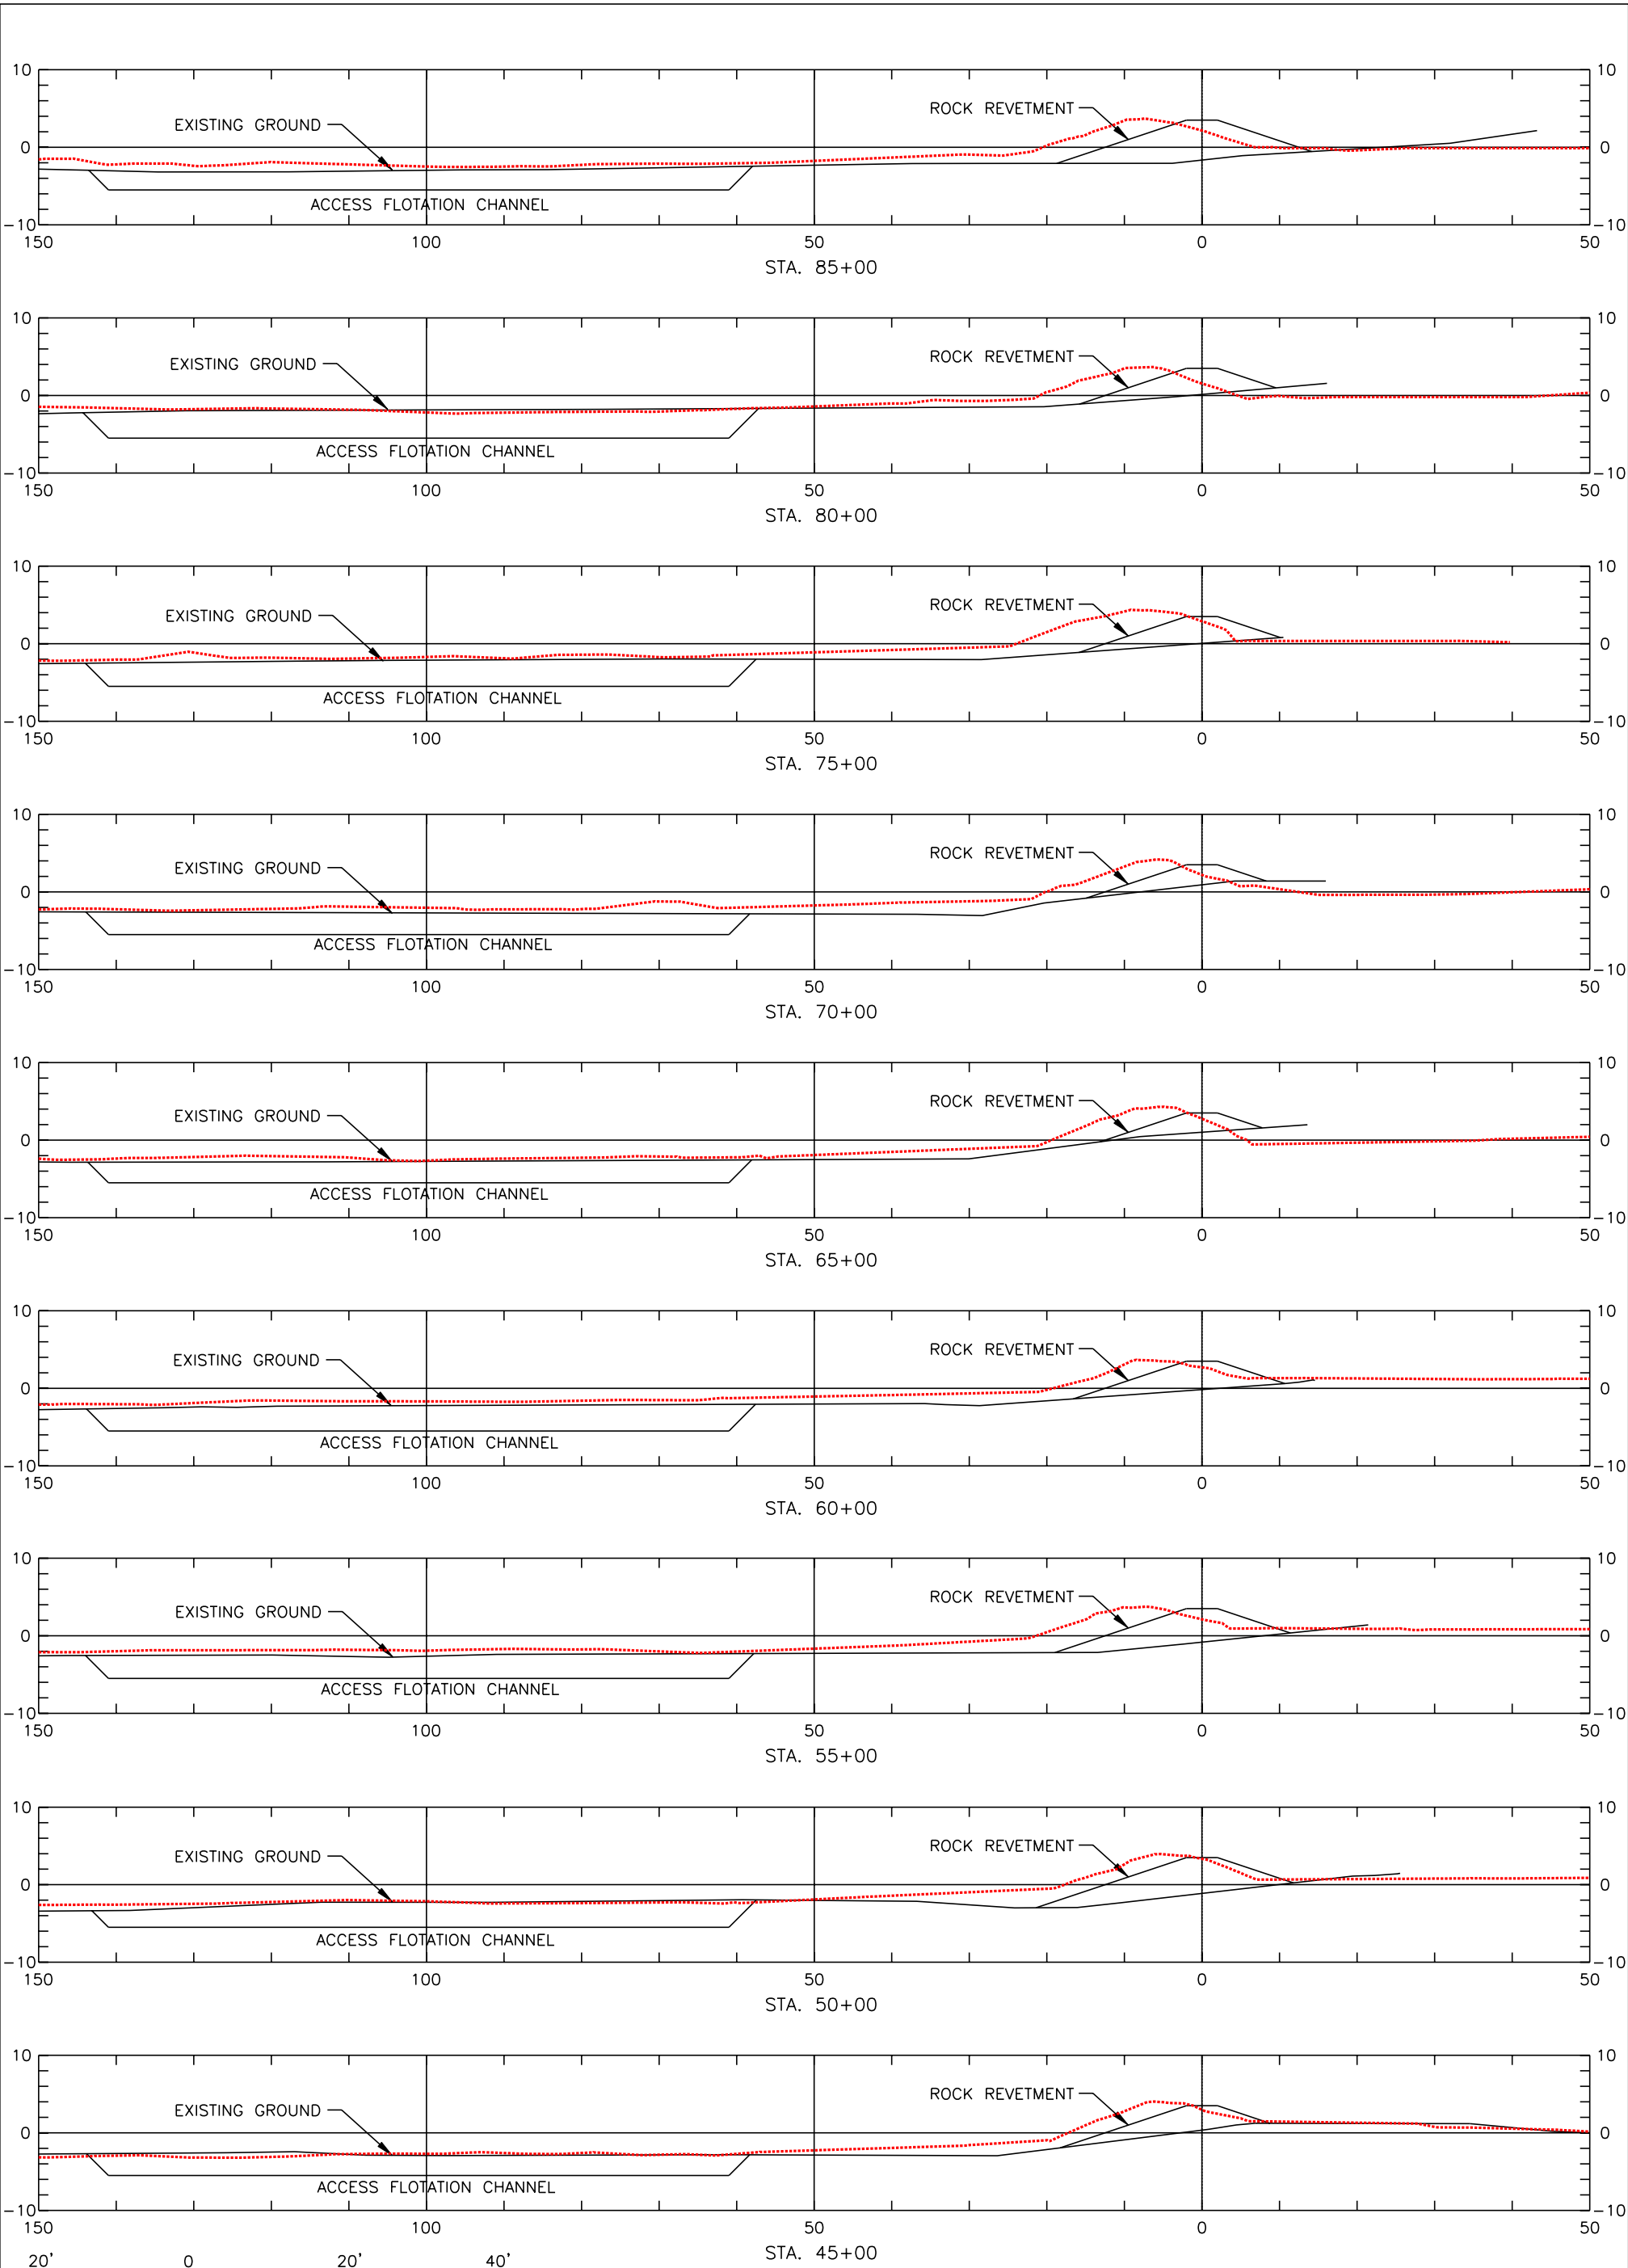

"AS-BUILT"

NOTE: SEE SHT. 16 FOR TYPICAL SECTION DETAILS.


Sht. 18 of 29	DRAWING NO. LA-352	CAD FILE NO.	REVISIONS				CROSS SECTIONS BARATARIA BASIN LANDBRIDGE PROJECT BA-27D-CU6 JEFFERSON PARISH, LA. U.S. DEPARTMENT OF AGRICULTURE - NATURAL RESOURCES CONSERVATION SERVICE	BURK-KLEINPETER, INC. ENGINEERS, ARCHITECTS, PLANNERS, ENVIRONMENTAL SCIENTISTS 4176 CANAL STREET, NEW ORLEANS, LOUISIANA 70119-5994 (504) 486-5901 FAX (504) 488-1714					
			NO.	DATE	APPR.	TITLE		DESIGNED	M. ROBERTS	DETAILED	C. SCURICH	DATE	1/04
								CHECKED	M. CHOPIN			SCALE	AS SHOWN
										BKI JOB NO.	10142	SHEET NO.	18

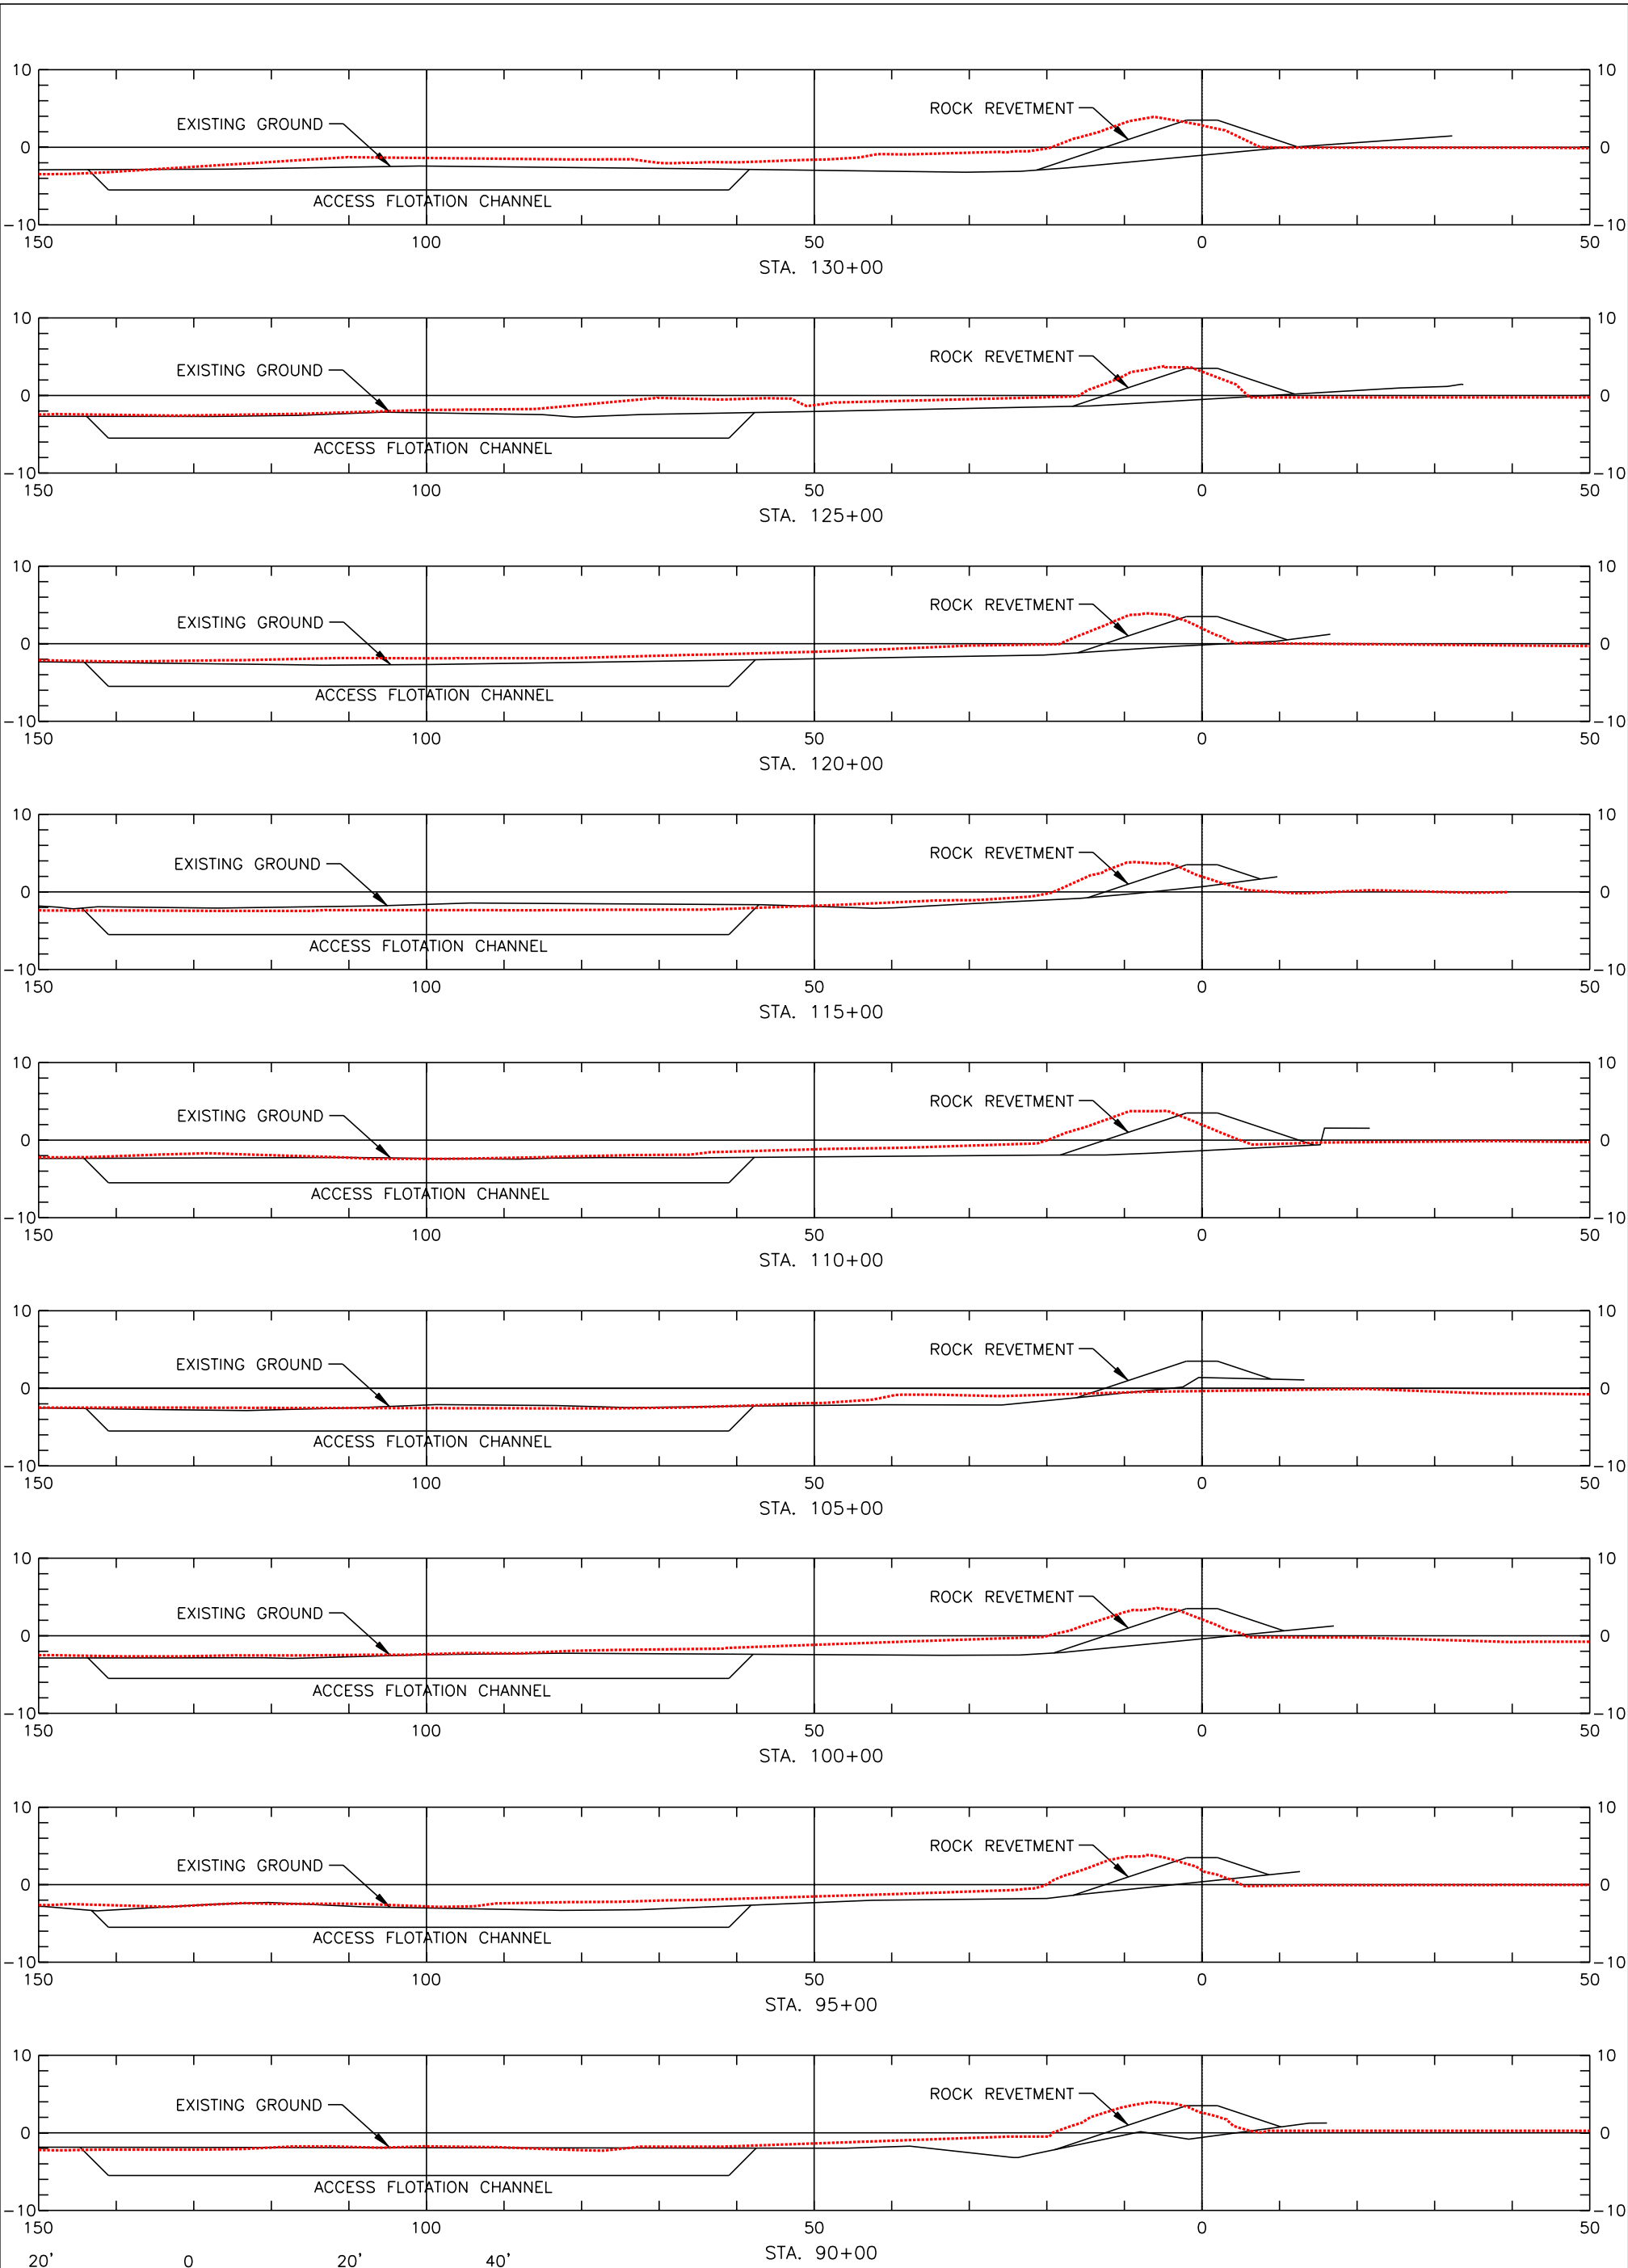


"AS-BUILT"

NOTE: SEE SHT. 16 FOR TYPICAL SECTION DETAILS.


Sht. 19 of 29	DRAWING NO. LA-352	CAD FILE NO.	REVISIONS				CROSS SECTIONS BARATARIA BASIN LANDBRIDGE PROJECT BA-27D-CU6 JEFFERSON PARISH, LA.	BURK-KLEINPETER, INC. ENGINEERS, ARCHITECTS, PLANNERS, ENVIRONMENTAL SCIENTISTS 4176 CANAL STREET, NEW ORLEANS, LOUISIANA 70119-5994 (504) 486-5901 FAX (504) 488-1714					
			NO.	DATE	APPR.	TITLE		DESIGNED	M. ROBERTS	DETAILED	C. SCURICH	DATE	1/04
								CHECKED	M. CHOPIN			SCALE	AS SHOWN
										BKI JOB NO.	10142	SHEET NO.	19
								U.S. DEPARTMENT OF AGRICULTURE - NATURAL RESOURCES CONSERVATION SERVICE					

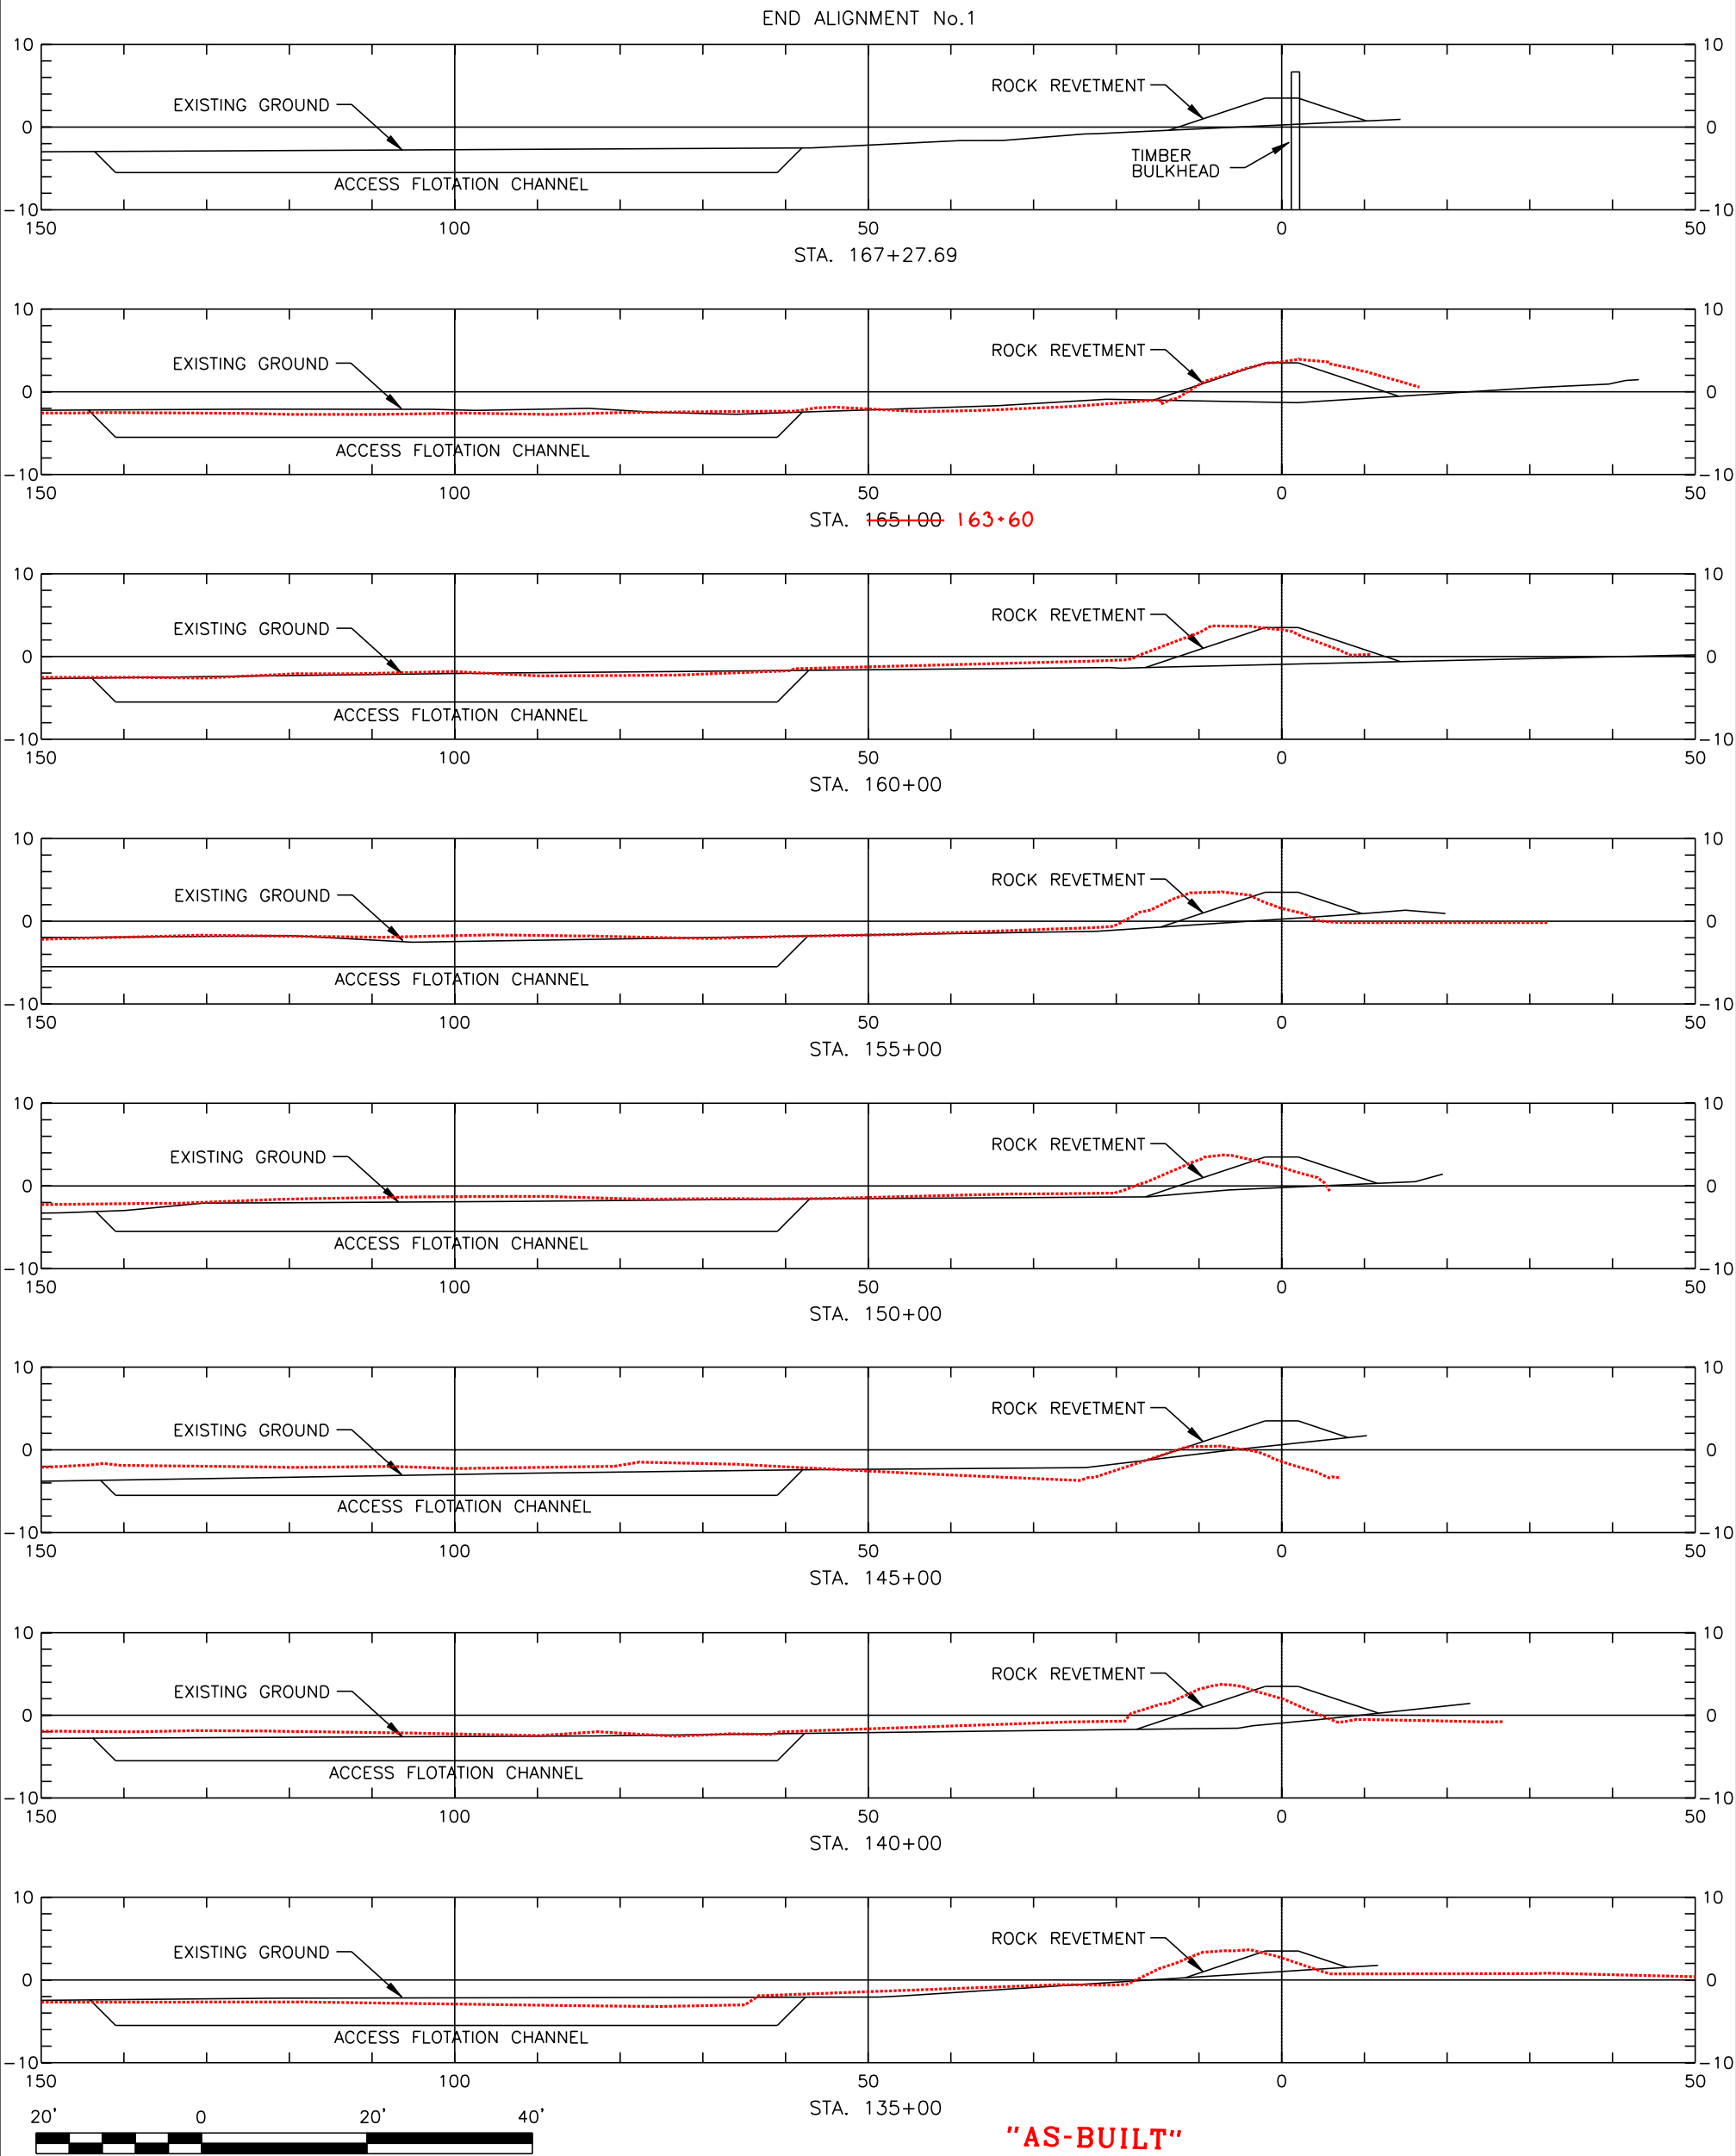

Sht. 20 of 29	DRAWING NO. LA-352	CAD FILE NO.	REVISIONS				CROSS SECTIONS BARATARIA BASIN LANDBRIDGE PROJECT BA-27D-CU6 JEFFERSON PARISH, LA.				BURK-KLEINPETER, INC. ENGINEERS, ARCHITECTS, PLANNERS, ENVIRONMENTAL SCIENTISTS 4176 CANAL STREET, NEW ORLEANS, LOUISIANA 70119-5994 (504) 486-5901 FAX (504) 488-1714					
			NO.	DATE	APPR.	TITLE					DESIGNED	M. ROBERTS	DETAILED	C. SCURICH	DATE	1/04
											CHECKED	M. CHOPIN			SCALE	AS SHOWN
													BKI JOB NO.	10142	SHEET NO.	20
			U.S. DEPARTMENT OF AGRICULTURE - NATURAL RESOURCES CONSERVATION SERVICE													

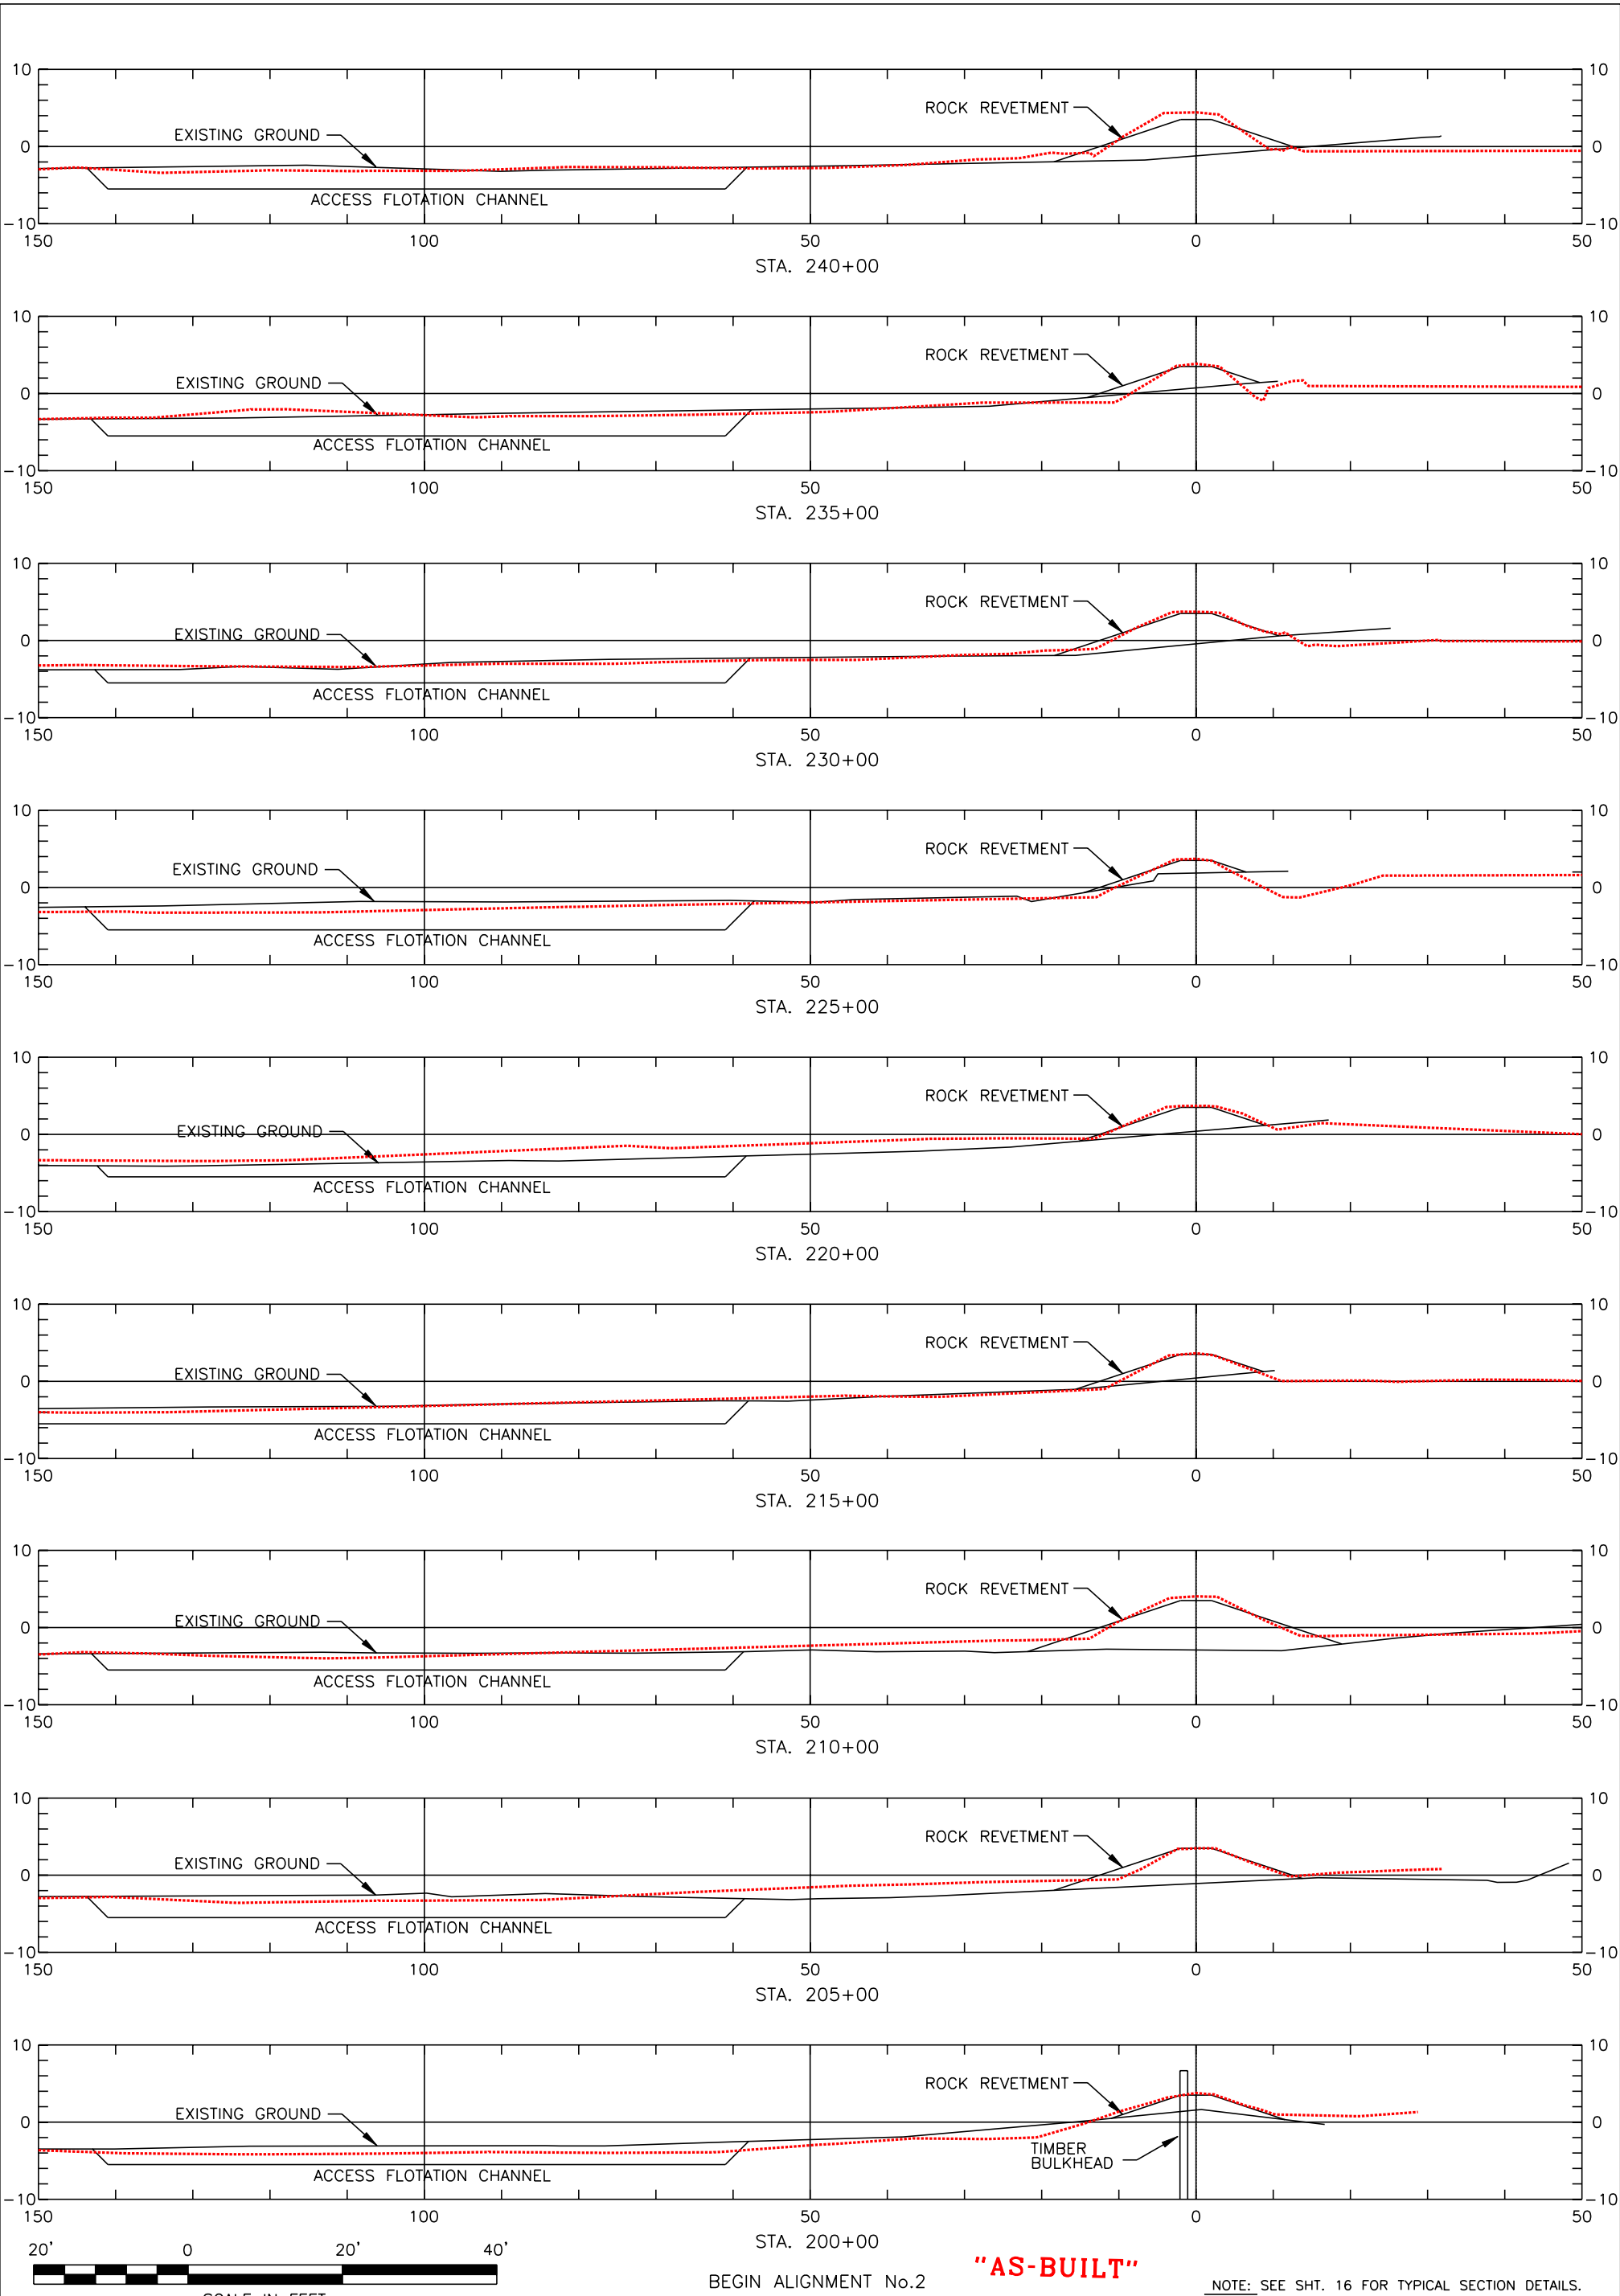


Sht. 21 of 29	DRAWING NO. LA-352	CAD FILE NO.	REVISIONS				CROSS SECTIONS BARATARIA BASIN LANDBRIDGE PROJECT BA-27D-CU6 JEFFERSON PARISH, LA.				BURK-KLEINPETER, INC. ENGINEERS, ARCHITECTS, PLANNERS, ENVIRONMENTAL SCIENTISTS 4176 CANAL STREET, NEW ORLEANS, LOUISIANA 70119-5994 (504) 486-5901 FAX (504) 488-1714											
			NO.	DATE	APPR.	TITLE																
			U.S. DEPARTMENT OF AGRICULTURE - NATURAL RESOURCES CONSERVATION SERVICE								DESIGNED		M. ROBERTS		DETAILED		C. SCURICH		DATE		1/04	
											CHECKED		M. CHOPIN						SCALE		AS SHOWN	
															BKI JOB NO.		10142		SHEET NO.		21	



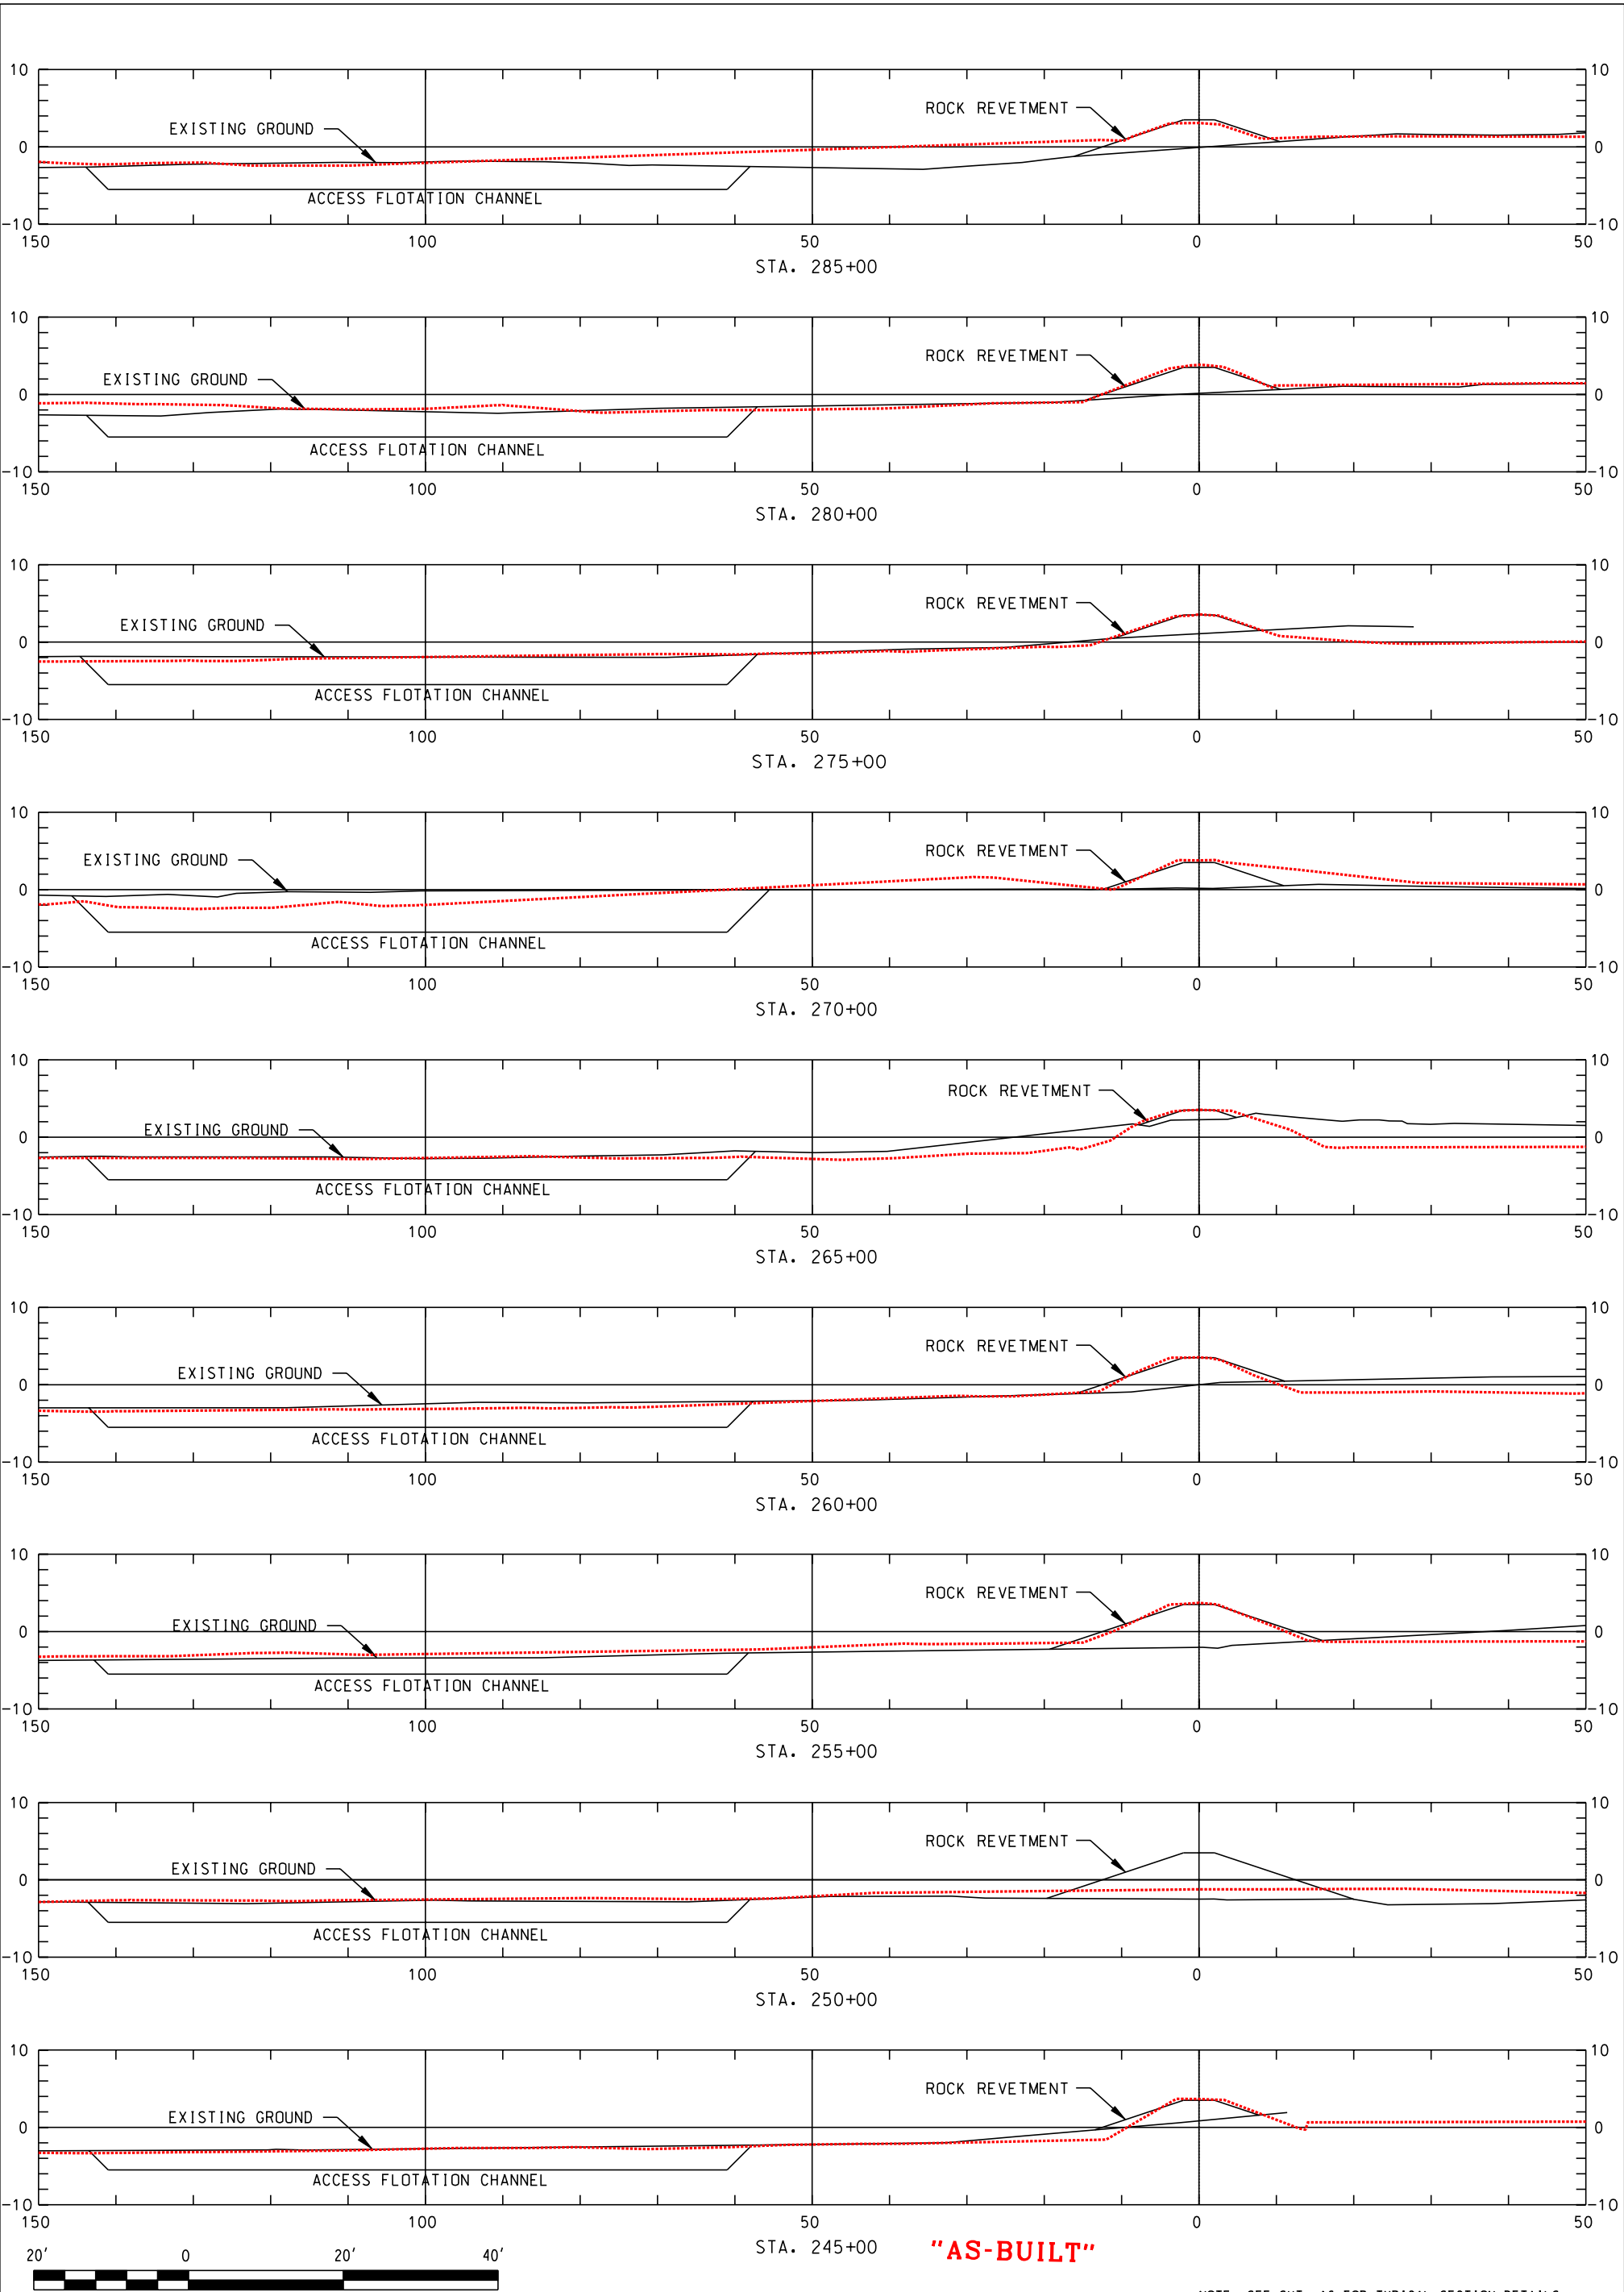


"AS-BUILT"

NOTE: SEE SHT. 16 FOR TYPICAL SECTION DETAILS.

Sht. 22 of 29	DRAWING NO. LA-352	CAD FILE NO.	REVISIONS				CROSS SECTIONS BARATARIA BASIN LANDBRIDGE PROJECT BA-27D-CU6 JEFFERSON PARISH, LA.				BURK-KLEINPETER, INC. ENGINEERS, ARCHITECTS, PLANNERS, ENVIRONMENTAL SCIENTISTS 4176 CANAL STREET, NEW ORLEANS, LOUISIANA 70119-5994 (504) 486-5901 FAX (504) 488-1714			
			NO.	DATE	APPR.	TITLE								
			U.S. DEPARTMENT OF AGRICULTURE - NATURAL RESOURCES CONSERVATION SERVICE				DESIGNED	M. ROBERTS	DETAILED	C. SCURICH	DATE	1/04		
							CHECKED	M. CHOPIN			SCALE	AS SHOWN		
									BK1 JOB NO.	10142	SHEET NO.	22		

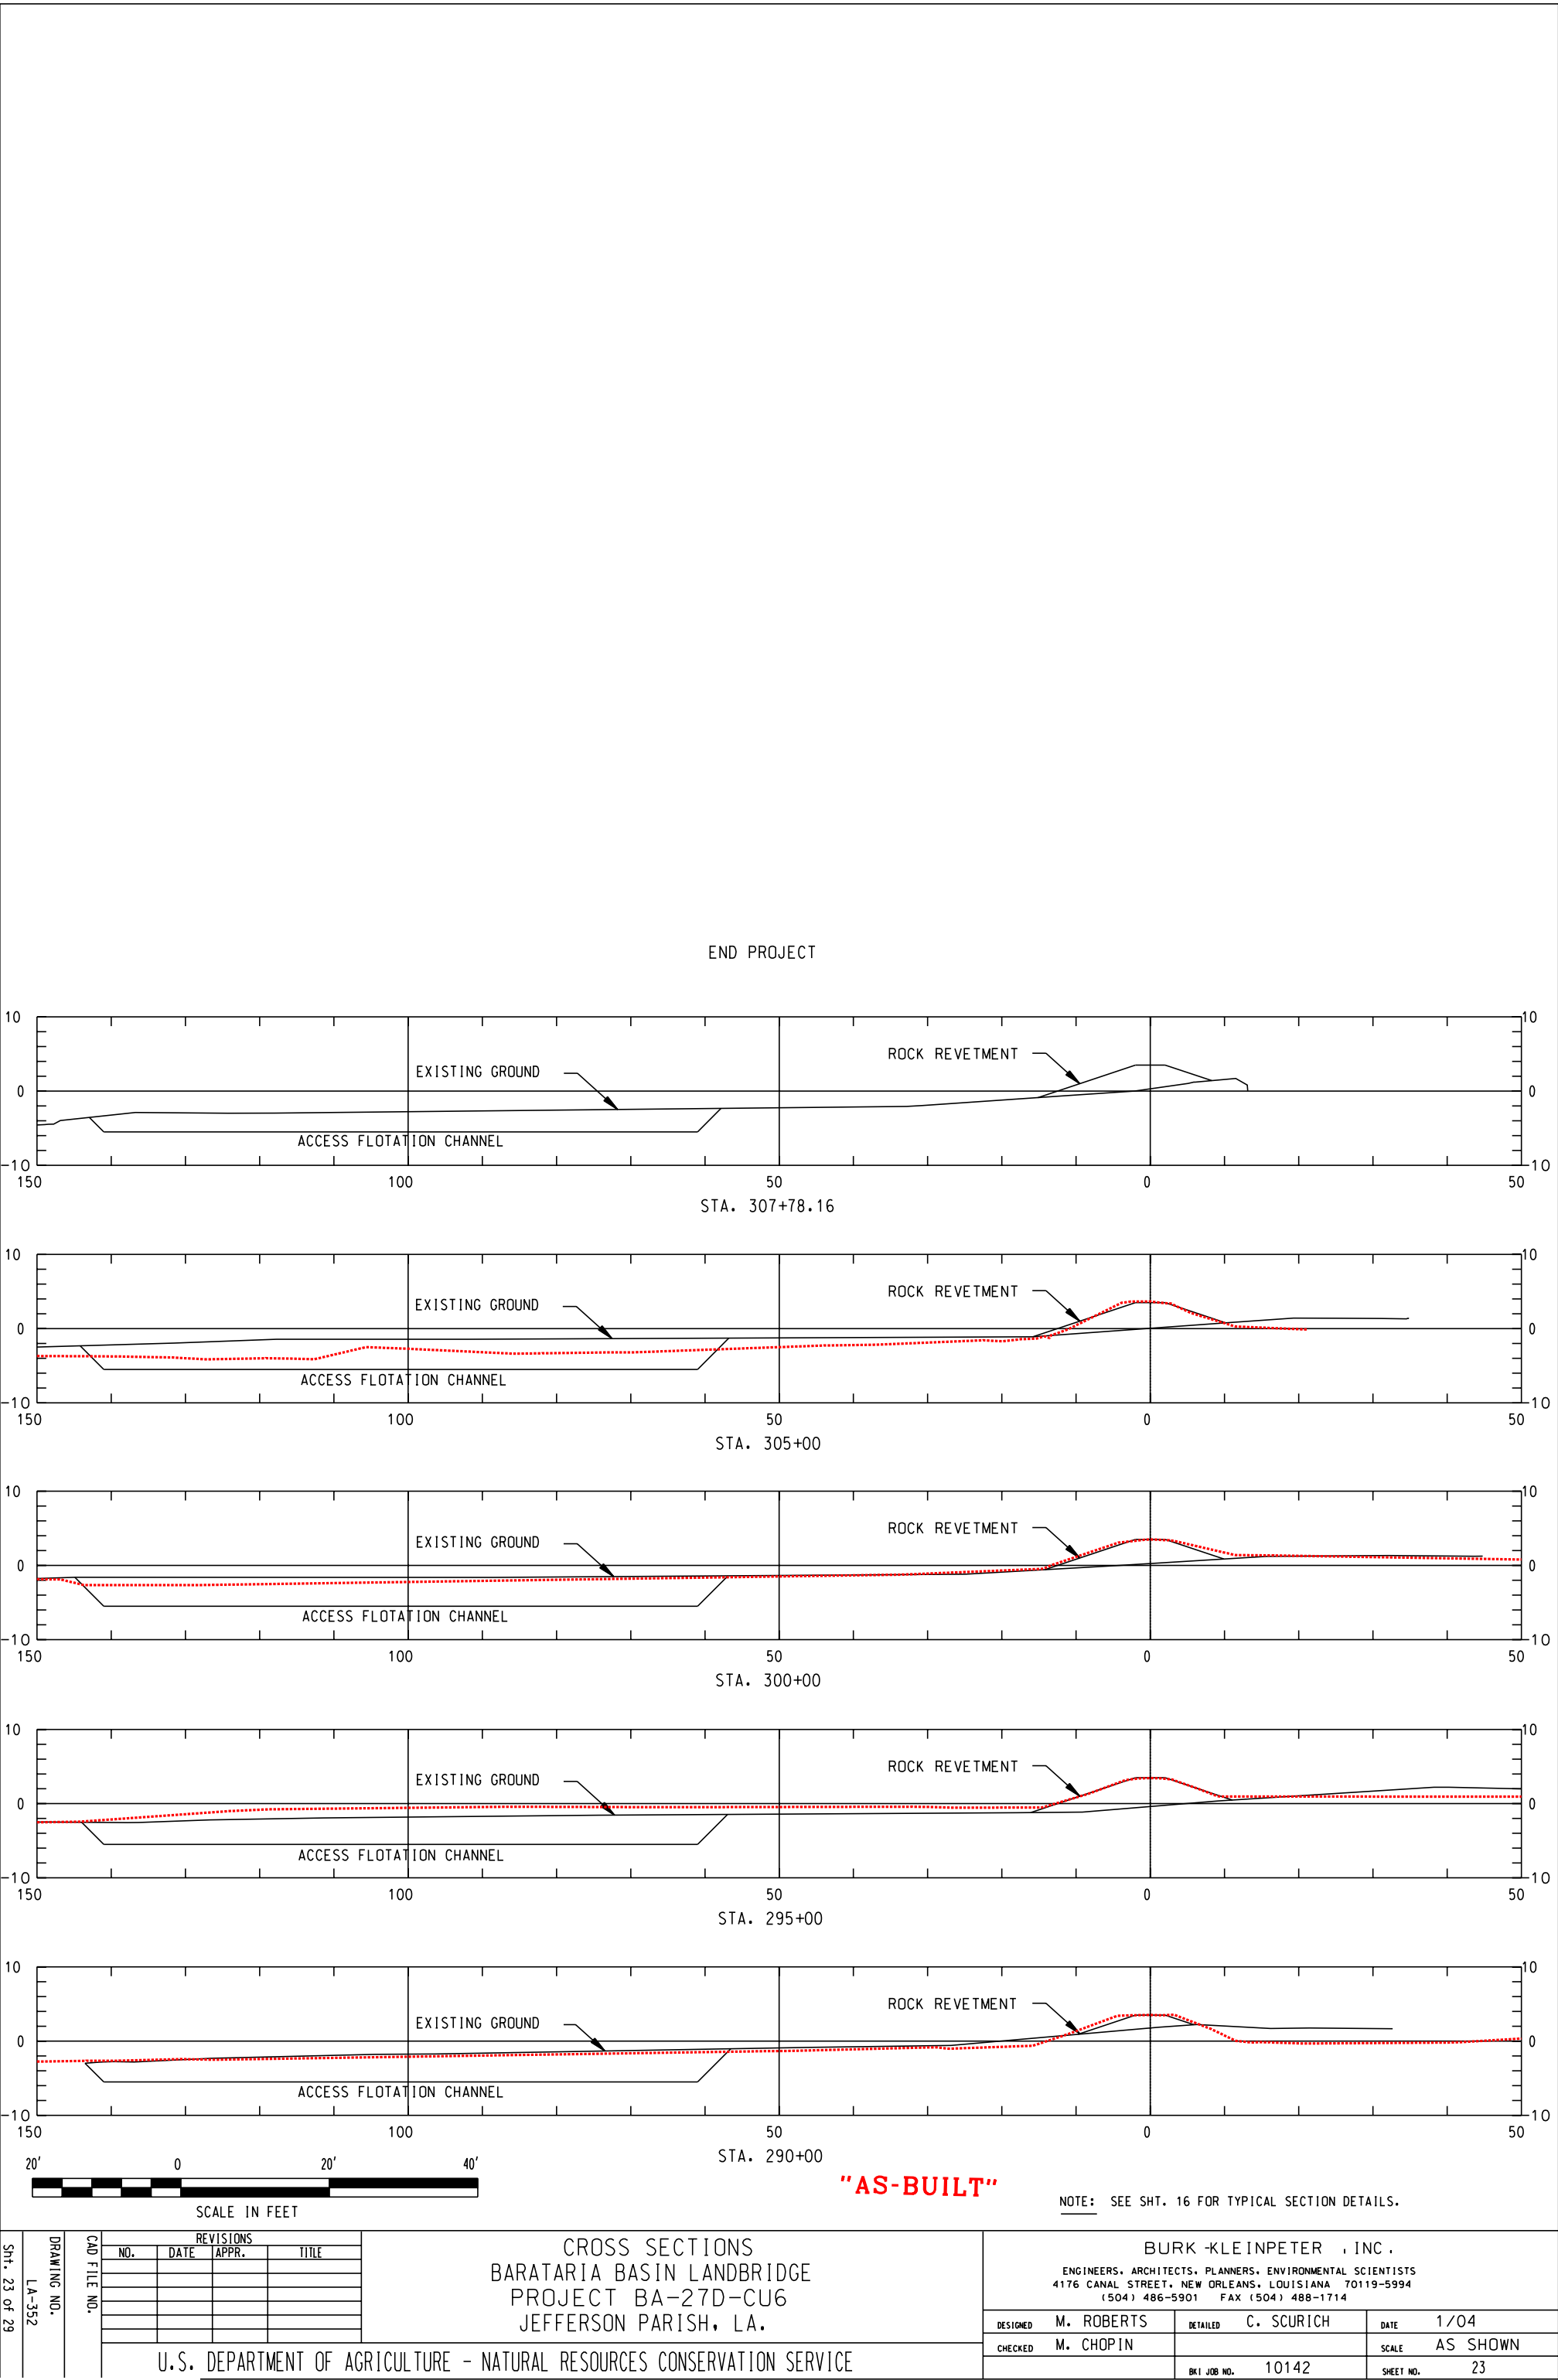

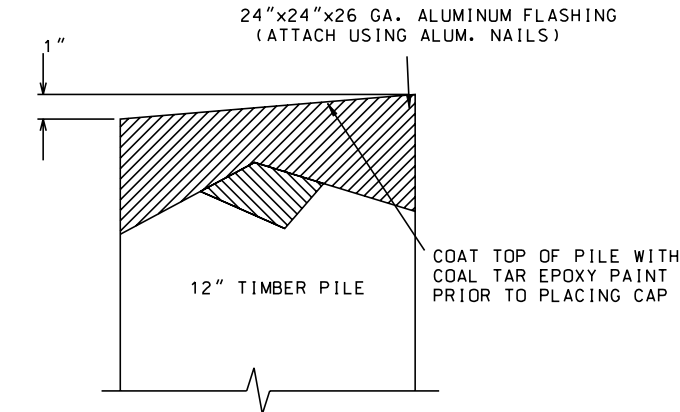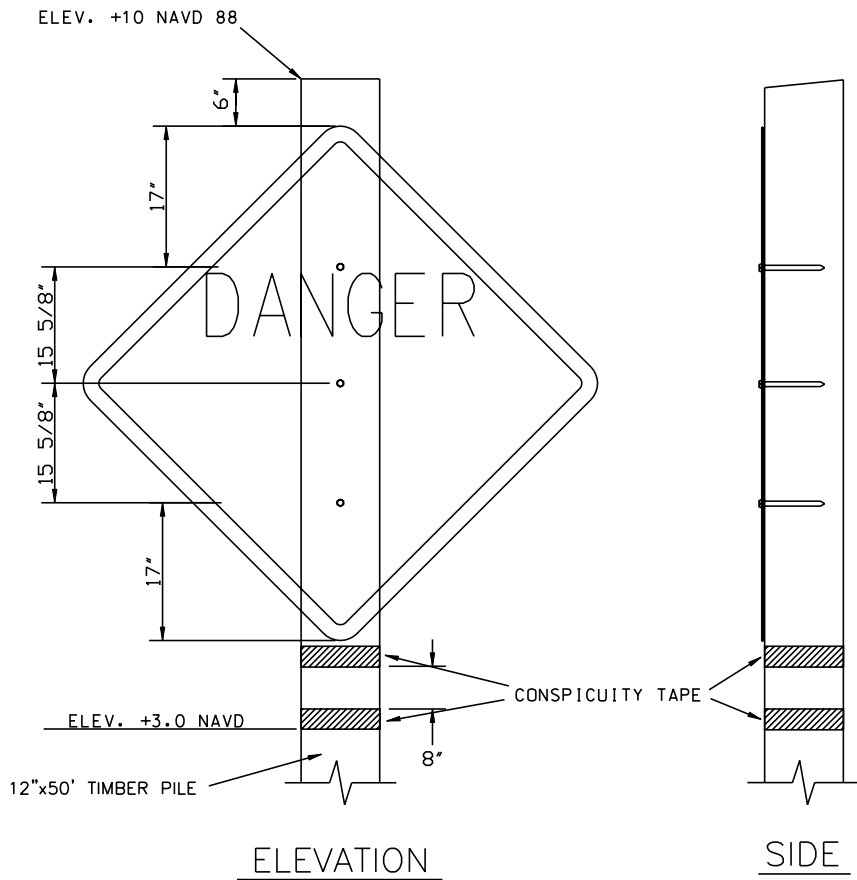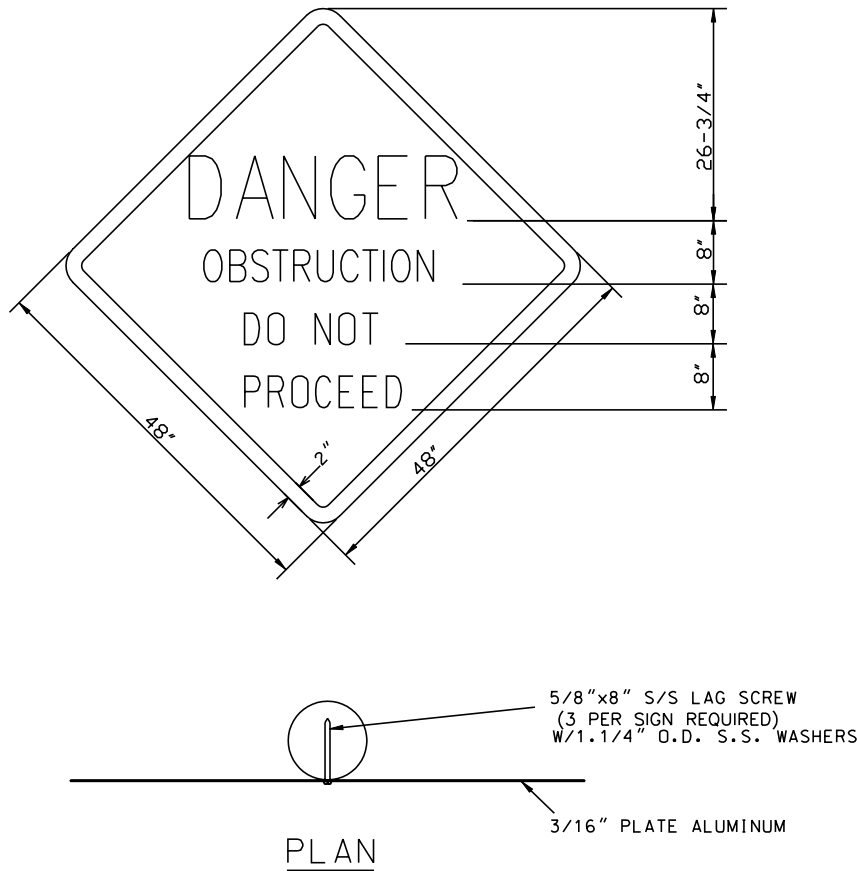


TYPICAL TIMBER PILE CAP
(NOT TO SCALE)

TEMPORARY SIGN NOTES:

1. TWO (2) TEMPORARY SIGNS PER POST SHALL BE INSTALLED ALONG THE FLOTATION ACCESS CHANNELS THAT ARE PERPENDICULAR TO THE ROCK DIKE ALIGNMENT.
2. ONE (1) TEMPORARY SIGN PER POST SHALL BE INSTALLED ALONG THE FLOTATION ACCESS CHANNEL THAT IS PARALLEL TO THE ROCK DIKE ALIGNMENT.
3. TEMPORARY WARNING SIGNS ON THE PERPENDICULAR FLOTATION ACCESS CHANNELS SHALL BE SPACED AT INTERVALS NOT TO EXCEED 250'.
4. TEMPORARY WARNING SIGNS ON THE PARALLEL FLOTATION ACCESS CHANNELS SHALL BE PLACED A MAXIMUM OF 200 FEET FROM POINTS OF TIE-IN AND AT INTERVALS NOT TO EXCEED 500 FEET.
5. TEMPORARY SIGNS SHALL BE CUT FROM 1/2 INCH MARINE, B/C GRADE VENEER PLYWOOD TO THE SAME DIMENSIONS AS THE PERMANENT SIGNS.
6. TEMPORARY SIGNS SHALL BE FIRST PRIMED ON THE B SIDE OF THE PLYWOOD WITH TWO (2) COATS OF A LIGHT PIGMENT, PERMANENT OIL-BASED PRIMER. THE TOP COAT SHALL BE AN OIL-BASED BRILLIANT WHITE. THE LETTERING ON THESE SIGNS SHALL ALSO BE BLACK. THE LETTERING FOR THE WARNING SIGN WILL BE BLACK.
7. STEEL PIPE SIGN POSTS SHALL BE A MINIMUM SCHEDULE 40 AND 4 INCHES IN DIAMETER. ROUND TIMBER PILE SIGN POSTS SHALL BE A MINIMUM OF 8 INCHES IN DIAMETER. ALL SIGN POSTS SHALL BE LONG ENOUGH TO MAINTAIN THE SIGNS AT THE SPECIFIED ELEVATIONS DURING WEATHER PATTERNS AND MARINE TRAFFIC CONSIDERED TYPICAL FOR THE PROJECT AREA.

MARSH SIDE

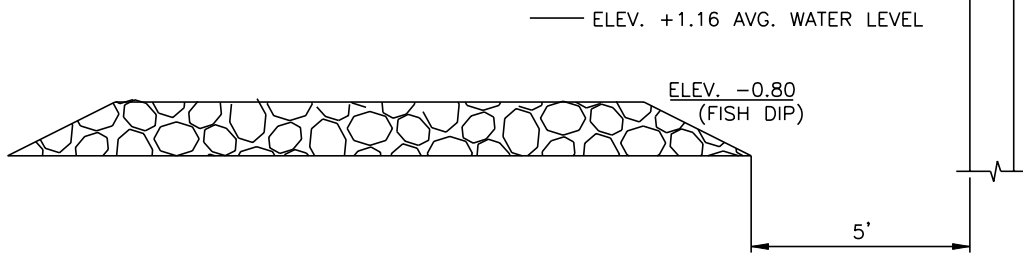

SIDE VIEW
(SIGN TYPE A : SUPPORT TYPE 1)
(NOT TO SCALE)

BAYOU SIDE

"AS-BUILT"

PERMANENT SIGN NOTES:

1. THE 2" BORDER ON THE TYPE "A" WARNING SIGN SHALL BE A REFLECTIVE MATERIAL OF ORANGE COLOR. THE LETTERING FIELD SHALL BE A RETRO-REFLECTIVE MATERIAL OF WHITE COLOR. THE LETTERING FOR THE WARNING SIGNS SHALL BE BLACK. WARNING SIGNS SHALL BE PLACED ON THE SIDE FACING THE BAYOU.

ALG.	SIGN TYPE	SUPPORT TYPE	DESCRIPTION	NO. OF SIGNS
1	A	1	DO NOT PROCEED	8
2	A	1	DO NOT PROCEED	4

2. SEE SHEET PLAN/PROFILES FOR PERMANENT SIGN LOCATIONS.
3. ONE (1) PERMANENT SIGN PER POST SHALL BE INSTALLED.

BURK-KLEINPETER, INC.

ENGINEERS, ARCHITECTS, PLANNERS, ENVIRONMENTAL SCIENTISTS
4176 CANAL STREET, NEW ORLEANS, LOUISIANA 70119-5994
(504) 486-5901 FAX (504) 486-1714

DESIGNED M. ROBERTS

CHECKED M. CHOPIN

DATE 1/04

SCALE AS SHOWN

SHEET NO. 24

WARNING SIGN DETAILS
BARATARIA BASIN LANDBRIDGE
PROJECT BA-27D- CU 6
JEFFERSON PARISH, LA.

U.S. DEPARTMENT OF AGRICULTURE - NATURAL RESOURCES CONSERVATION SERVICE

NO.	DATE	APPR.	TITLE

CAD FILE NO.

DRAWING NO.
LA-352

SHEET NO 24 OF 29

LANDBRIDGE CU • 6 BA-27D SETTLEMENT PLATE DATA ALIGNMENT • 1 LOCATIONINITIAL SET1ST CHECK2ND CHECK3RD CHECK4TH CHECK5TH CHECK6TH CHECKBENCH MARKSETTLEMENT •FT. • CUMULATIVE SETTLEMENT •FEET•										
STA.3+00 N 406372.1 E 3668841.	ELEVATION DATE SURVEYED E 3668841.	6.29 7/19/2005 0.00	5.04 8/15/2005 1.25	4.83 11/7/2005 0.21	4.83 2/13/2006 0.00	8.84*** 2/14/2006 0.00	0.00 0.00 0.00	0.00 0.00 0.00	L8-10 L8-10 L8-10	1.46 1.34 1.15
STA.13+00 N 407197.1 E 3669210	ELEVATION DATE SURVEYED INCREMENTAL SET.	7.03 7/28/2005 0.00	6.99 7/31/2005 0.04	5.91 8/15/2005 1.08	5.71 11/7/2005 0.20	5.69 12/7/2005 0.02	5.68 2/13/2006 0.00	7.9* 2/14/2006 0.00	L8-10 L8-10 L8-10	1.34 1.15 1.15
STA.23+00 N 408130.7 E 3669076	ELEVATION DATE SURVEYED INCREMENTAL SET.	6.95 8/9/2005 0.00	6.26 8/15/2005 0.69	5.81 11/7/2005 0.45	5.8 12/8/2005 0.01	5.8 2/13/2006 0.00	7.96* 2/14/2006 0.00	0.00 0.00 0.00	L8-18 L8-17 L8-17	1.15 2.50 1.51
STA.33+00 N 408903.7 E 3668570	ELEVATION DATE SURVEYED INCREMENTAL SET.	8.37 8/12/2005 0.00	6.31 8/15/2005 2.06	5.96 11/7/2005 0.35	5.94 12/8/2005 0.02	5.87 2/13/2006 0.07	7.92* 2/14/2006 0.00	0.00 0.00 0.00	L8-17 L8-17 L8-17	2.50 1.51 0.99
STA.43+00 N 409500.9 E 3667803	ELEVATION DATE SURVEYED INCREMENTAL SET.	7.87 8/16/2005 0.00	6.60 8/24/2005 1.27	6.47 11/7/2005 0.13	6.42 12/12/2005 0.05	6.36 2/13/2006 0.06	8.37* 2/14/2006 0.00	0 0.00 0.00	L8-17 L8-17 L8-17	1.51 0.99 1.31
STA.49+11 N 409856.8 E 3668001	ELEVATION DATE SURVEYED INCREMENTAL SET.	7.42 8/18/2005 0.00	6.66 8/24/2005 0.76	6.59 11/7/2005 0.07	6.56 12/15/2005 0.03	6.43 2/13/2006 0.13	8.48* 2/14/2006 0.00	0.00 0.00 0.00	L8-17 L8-17 L8-17	0.99 1.31 1.18
STA.53+00 N 410081.0 E 3668283	ELEVATION DATE SURVEYED INCREMENTAL SET.	7.66 8/1/1905 0.00	6.70 8/24/2005 0.96	6.55 11/7/2005 0.15	6.55 12/15/2005 0.00	6.35 2/13/2006 0.20	8.57* 2/14/2006 0.00	0.00 0.00 0.00	L8-17 L8-16 L8-16	1.31 1.18 1.07
STA.63+00 N 410912.2 E 3668743	ELEVATION DATE SURVEYED INCREMENTAL SET.	8.26 8/23/2005 0.00	7.21 11/7/2005 1.05	7.11 12/15/2005 0.10	7.08 2/13/2006 0.03	0.00 0.00 0.00	0.00 0.00 0.00	0.00 0.00 0.00	L8-16 L8-16 L8-16	1.18 1.07 1.32
STA.73+00 N 411718.0 E 3668996	ELEVATION DATE SURVEYED INCREMENTAL SET.	7.36 8/25/2005 0.00	6.39 11/7/2005 0.97	6.33 1/11/2006 0.06	6.29 2/13/2006 0.04	8.19* 2/14/2006 0.00	0.00 0.00 0.00	0.00 0.00 0.00	L8-16 L8-16 L8-16	1.07 1.32 1.55
STA.83+00 N 412634.8 E 3669185	ELEVATION DATE SURVEYED INCREMENTAL SET.	6.61 9/19/2005 0.00	5.98 11/7/2005 0.63	5.91 1/3/2006 0.07	5.29 2/13/2006 0.62	8.02* 2/14/2006 0.00	0.00 0.00 0.00	0.00 0.00 0.00	L8-16 L8-16 L8-16	1.32 1.55 1.60
STA.93+00 N 413562.5 E 3668963	ELEVATION DATE SURVEYED INCREMENTAL SET.	6.96 9/22/2005 0.00	5.47 11/8/2005 1.49	5.41 1/12/2006 0.06	5.41 2/13/2006 0.00	7.59* 2/14/2006 0.00	0.00 0.00 0.00	0.00 0.00 0.00	L8-16 L8-15 L8-15	1.55 1.60 1.06
STA.101+00 N 414352.4 E 3668848	ELEVATION DATE SURVEYED INCREMENTAL SET.	6.92 10/12/2005 0.00	5.65 11/8/2005 1.27	5.32 1/18/2006 0.33	5.32 2/13/2006 0.00	8.96** 2/14/2006 0.00	0.00 0.00 0.00	0.00 0.00 0.00	L8-15 L8-15 L8-15	1.60 1.06 1.57
STA.113+50 N 415471.8 E 3669310	ELEVATION DATE SURVEYED INCREMENTAL SET.	6.68 10/21/2005 0.00	5.84 11/8/2005 0.84	5.63 1/18/2006 0.21	5.62 2/13/2006 0.01	8.76** 2/14/2006 0.00	0.00 0.00 0.00	0.00 0.00 0.00	L8-15 L8-15 L8-15	1.06 1.57 1.59
STA.123+00 N 415364.2 E 3669259	ELEVATION DATE SURVEYED INCREMENTAL SET.	7.22 10/25/2005 0.00	5.82 11/8/2005 1.40	5.65 1/19/2006 0.17	5.65 2/13/2006 0.00	8.60** 2/14/2006 0.00	0.00 0.00 0.00	0.00 0.00 0.00	L8-15 L8-14 L8-14	1.57 1.59 6.41
STA.133+00 N 417067.7 E 3668822	ELEVATION DATE SURVEYED INCREMENTAL SET.	7.49 10/31/2005 0.00	6.09 1/19/2006 1.40	5.90 2/13/2006 0.19	8.03* 2/14/2006 0.00	0.00 0.00 0.00	0.00 0.00 0.00	0.00 0.00 0.00	L8-14 L8-14 L8-14	1.59 6.41 1.05
STA.143+00 N 417994.5 E 3669104	ELEVATION DATE SURVEYED INCREMENTAL SET.	6.41 11/3/2005 0.00	5.48 1/30/2006 0.93	5.37 2/13/2006 0.11	0.00 2/14/2006 5.37	0.00 0.00 0.00	0.00 0.00 0.00	0.00 0.00 0.00	L8-14 L8-14 L8-14	6.41 1.05 1.99
STA.149+00 N 418569.2 E 3669023	ELEVATION DATE SURVEYED INCREMENTAL SET.	6.98 11/7/2005 0.00	5.96 1/30/2006 1.02	5.93 2/13/2006 0.03	7.87** 2/14/2006 0.00	0.00 0.00 0.00	0.00 0.00 0.00	0.00 0.00 0.00	L8-14 L8-14 L8-14	1.05 1.99 5.23
STA.153+00 N 418882.2 E 3668793	ELEVATION DATE SURVEYED INCREMENTAL SET.	7.54 11/8/2005 0.00	5.56 1/30/2006 1.98	5.55 2/13/2006 0.01	8.58** 2/14/2006 0.00	0.00 0.00 0.00	0.00 0.00 0.00	0.00 0.00 0.00	L8-14 BA-27 6M03 BA-27 6M03	1.99 5.23 5.23
STA.163+00 N 419660.4 E 3668238	ELEVATION DATE SURVEYED INCREMENTAL SET.	7.48 11/15/2005 0.00	2.51 12/19/2005 4.97	6.62*** 12/19/2005 0.00	6.36 1/30/2006 0.26	6.36 2/13/2006 0.00	9.74* 2/14/2006 0.00	0.00 0.00 0.00	BA-27 6M03 BA-27 6M03 BA-27 6M03	5.23 5.23 5.23
*** -- 4.0' SECTION OF PIPE ADDED ** -- 3.0' SECTION OF PIPE ADDED * -- 2.0' SECTION OF PIPE ADDED										
"AS-BUILT"										
BURK-KLEINPETER, INC. ENGINEERS, ARCHITECTS, PLANNERS, ENVIRONMENTAL SCIENTISTS 4176 CANAL STREET, NEW ORLEANS, LOUISIANA 70119-5994 (504) 486-5901 FAX (504) 486-1714										
DESIGNED M. ROBERTS CHECKED M. CHOPIN										
DATE 1/04 SCALE AS SHOWN SHEET NO. 25										
SETTLEMENT PLATE SURVEYS BARATARIA BASIN LANDBRIDGE PROJECT BA-27D- CU 6 JEFFERSON PARISH, LA.										
U.S. DEPARTMENT OF AGRICULTURE - NATURAL RESOURCES CONSERVATION SERVICE										
CAD FILE NO.										
DRAWING NO. LA-352										
SHEET NO25 OF 29										


LANDBRIDGE CU * 6 BA-27D SETTLEMENT PLATE DATA ALIGNMENT * 2										BURK-KLEINPETER, INC. ENGINEERS, ARCHITECTS, PLANNERS, ENVIRONMENTAL SCIENTISTS 4176 CANAL STREET, NEW ORLEANS, LOUISIANA 70119-5994 (504) 486-5901 FAX (504) 488-1714										DATE 1/04		SCALE AS SHOWN	
LOCATION INITIAL SET 1ST CHECK 2ND CHECK 3RD CHECK 4TH CHECK 5TH CHECK BENCH MARK SETTLEMENT *FT.*																				DESIGNED M. ROBERTS CHECKED M. CHOPIN	C. SCURICH	BKI JOB NO. 10142	SHEET NO. 25
CUMULATIVE SETTLEMENT *FEET*																							
STA.300+96	ELEVATION	9.42	7.62	7.48	7.40	0.00	0.00	LAFITTE 2	2.02														
N 425818.23	DATE SURVEYED	5/10/2005	5/30/2005	6/28/2005	11/9/2005																		
E 3667727.03		0.00	1.80	0.14	0.08	0.00	0.00																
STA.291+05	ELEVATION	7.30	5.87	5.59	5.62	9.73**	9.61	L0 11	1.80														
N 426000.64	DATE SURVEYED	5/12/2005	5/30/2005	6/28/2005	7/29/2005	7/29/2005	11/9/2005																
E 3666789.01	INCREMENTAL SET.	0.00	1.43	0.28	-0.03	0.00	0.12																
STA.281+05	ELEVATION	9.14	7.05	6.46	6.24	0.00	0	L0 11	2.90														
N 426027.81	DATE SURVEYED	5/16/2005	5/30/2005	6/28/2005	11/8/2005																		
E 3665852.18	INCREMENTAL SET.	0.00	2.09	0.59	0.22	0.00	0.00																
STA.276+05	ELEVATION	8.00	6.07	5.53	5.37	9.48**	9.33	L0 11	12.11														
N 425889.96	DATE SURVEYED	5/18/2005	5/30/2005	7/6/2005	7/29/2005	7/29/2005	11/8/2005																
E 3665414.95	INCREMENTAL SET.	0.00	1.93	0.54	0.16	0.00	0.15																
STA.269+00	ELEVATION	7.25	5.95	5.36	5.29	9.41**	9.15	L0 11	2.22														
N 425391.36	DATE SURVEYED	5/20/2005	5/30/2005	7/6/2005	7/29/2005	7/29/2005	11/8/2005																
E 366203.81	INCREMENTAL SET.	0.00	1.30	0.59	0.07	0.00	0.26																
STA.264+50	ELEVATION	6.64	5.45	4.91	4.84	8.94**	8.72	L0 11	2.02														
N 425086.17	DATE SURVEYED	5/25/2005	6/14/2005	7/6/2005	7/29/2005	7/29/2005	11/8/2005																
E 3665479.57	INCREMENTAL SET.	0.00	1.19	0.54	0.07	0.00	0.22																
STA.254+50	ELEVATION	6.61	5.15	4.75	4.41	8.58**	8.23	L0 12	2.55														
N 424607.74	DATE SURVEYED	5/30/2005	6/14/2005	7/6/2005	7/29/2005	7/29/2005	11/8/2005																
E 3666182.31	INCREMENTAL SET.	0.00	1.46	0.40	0.34	0.00	0.35																
STA.244+50	ELEVATION	6.83	4.96	4.65	4.48	8.58**	8.47	L0 13	2.46														
N 423882.51	DATE SURVEYED	6/2/2005	6/14/2005	7/6/2005	7/26/2005	7/26/2005	11/8/2005																
E 3666745.97	INCREMENTAL SET.	0.00	1.87	0.31	0.17	0.00	0.11																
STA.239+00	ELEVATION	6.48	6.05	5.25	4.67	8.77**	8.46	L0 12	2.12														
N 423358.24	DATE SURVEYED	6/7/2005	6/14/2005	7/6/2005	7/26/2005	7/26/2005	11/8/2005																
E 3666908.98	INCREMENTAL SET.	0.00	0.43	0.80	0.58	0.00	0.31																
STA.234+50	ELEVATION	6.48	5.56	5.34	4.90	9.01**	8.85	L012	1.74														
N 422950.26	DATE SURVEYED	6/8/2005	6/14/2005	7/6/2005	7/26/2005	7/26/2005	11/8/2005																
E 3667064.30	INCREMENTAL SET.	0.00	0.92	0.22	0.44	0.00	0.16																
STA.230+00	ELEVATION	8.14	6.53	6.25	5.62	9.74**	9.51	L0 13	2.75														
N 422550.98	DATE SURVEYED	6/10/2005	6/14/2005	7/6/2005	7/26/2005	7/26/2005	11/8/2005																
E 3667250.81	INCREMENTAL SET.	0.00	1.61	0.28	0.63	0.00	0.23																
STA.224+30	ELEVATION	6.91	6.22	5.56	9.66**	9.53	0.00	L0 13	1.35														
N 421996.64	DATE SURVEYED	6/15/2005	7/6/2005	7/26/2005	7/26/2005	11/8/2005																	
E 3667280.24	INCREMENTAL SET.	0.00	0.69	0.66	0.00	0.00	0.00																
STA.214+30	ELEVATION	8.15	7.04	6.04	0.00	0.00	0.00	L0 13	2.11														
N 421190.06	DATE SURVEYED	6/28/2005	7/6/2005	11/8/2005		0.00	0.00																
E 3667291.38	INCREMENTAL SET.	0.00	1.11	1.00	0.00	0.00	0.00																
STA.204+50	ELEVATION	6.57	3.26	3.01	7.10**	6.54	0.00	BA-27 6M03	3.56														
N 420396.29	DATE SURVEYED	7/11/2005	7/22/2005	7/26/2005	7/26/2005	11/8/2005																	
E 3667772.08	INCREMENTAL SET.	0.00	3.31	0.25	0.00	0.00	0.00																
** -- 4.0' SECTION OF PIPE ADDED										"AS-BUILT"													

FISH DIP NO.	TW	BW
1	55.8'	30'
2	55.8'	30'
3	75.8'	50'
4	65.8'	40'
5	155.8'	130'
6	75.8'	50'


NOTE: 1. THE CREST ELEVATION OF FISH DIP #5 IS NOT REQUIRED TO BE -0.8'. 30" OF ROCK SHALL BE PLACED IN THE OPENING.

2. FOR FISH DIP #5, PLACE SIGNS AT 1/3 INTERVALS OF BOTTOM WIDTH.


BAYOU SIDE

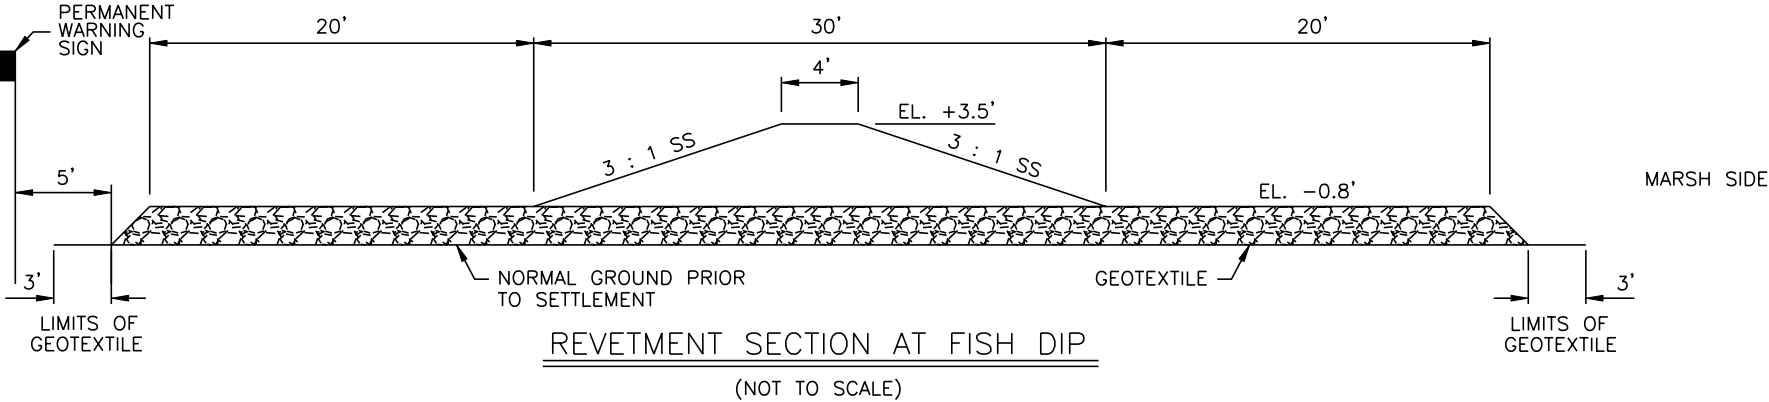


REVETMENT SECTION AT FISH DIP
(NOT TO SCALE)

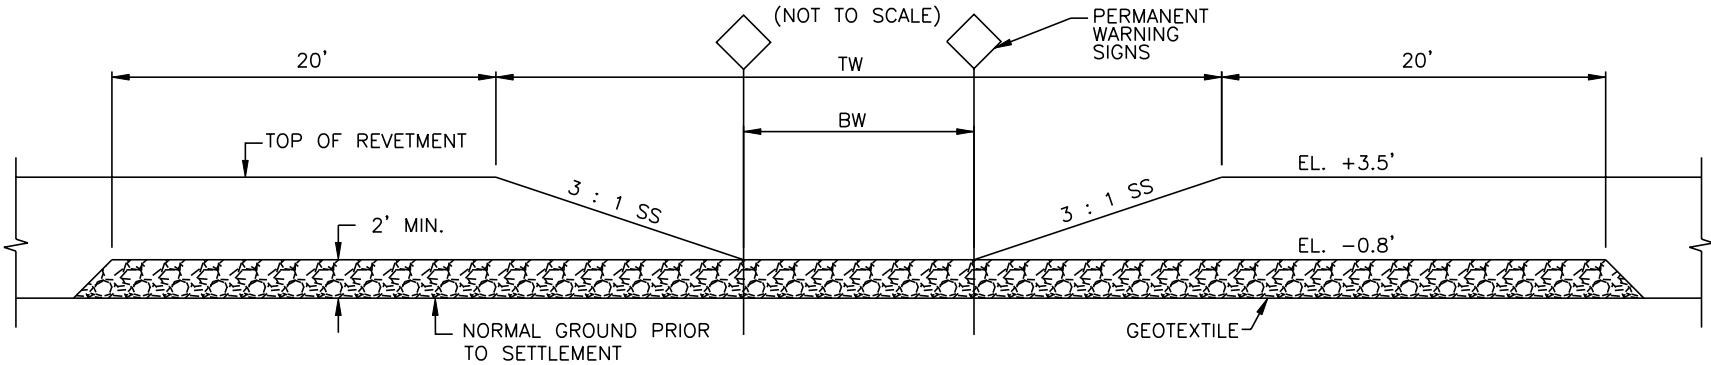

REVETMENT PROFILE AT FISH DIP
(NOT TO SCALE)

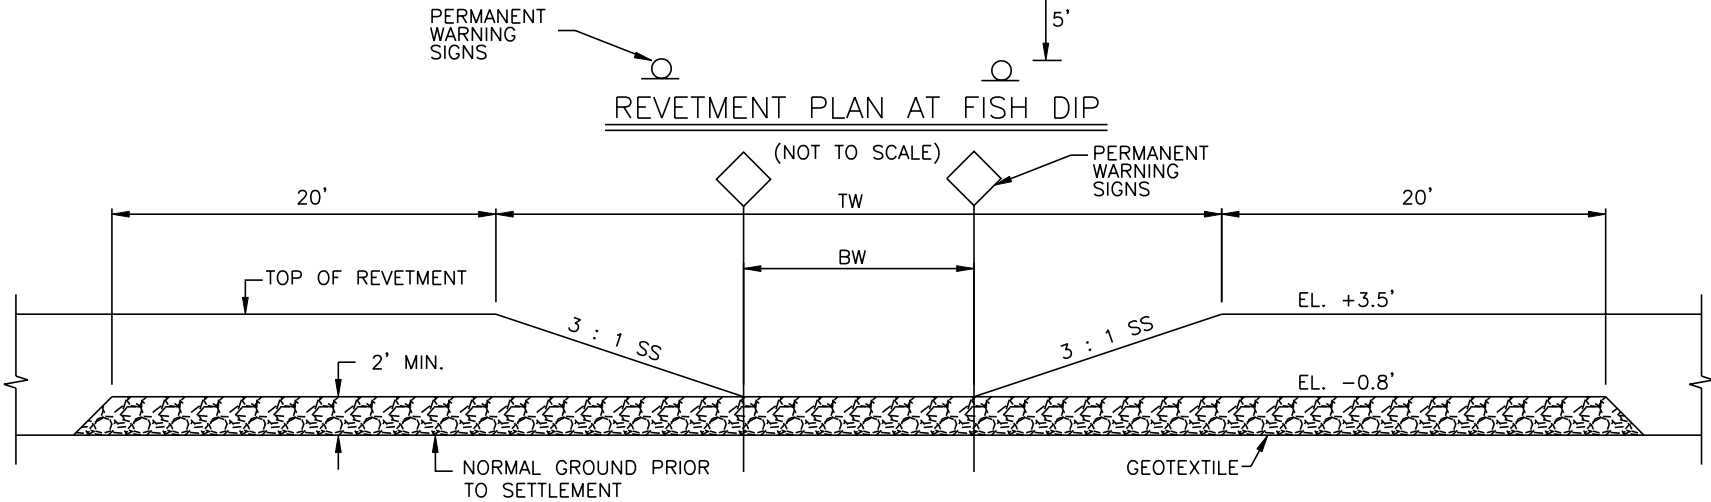

REVETMENT PLAN AT FISH DIP

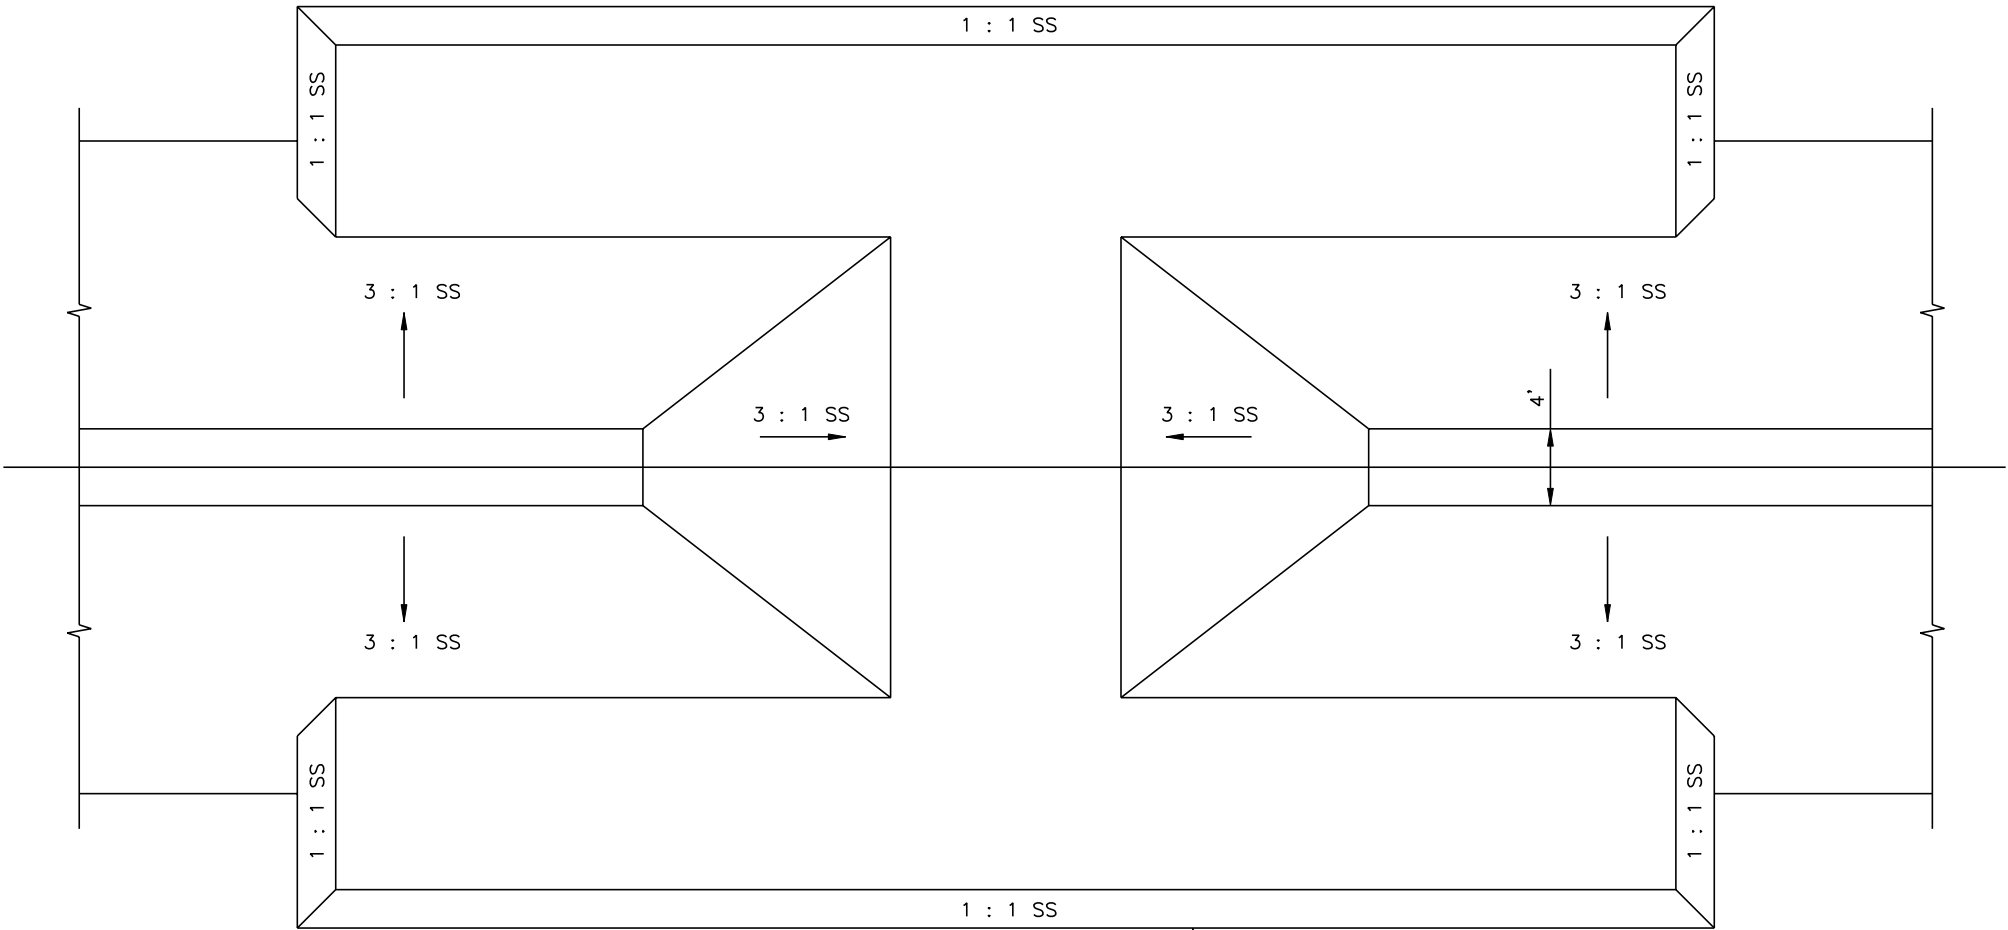

NOTE :
GEOTEXTILE TO CONFORM TO
EXISTING CHANNEL BOTTOM

"AS-BUILT"

DETAILS – FISH DIPS
BARATARIA BASIN LANDBRIDGE
PROJECT BA-27D– CU 6
JEFFERSON PARISH, LA.

BURK-KLEINPETER, INC.
ENGINEERS, ARCHITECTS, PLANNERS, ENVIRONMENTAL SCIENTISTS
4176 CANAL STREET, NEW ORLEANS, LOUISIANA 70119-5994
(504) 486-5901 FAX (504) 486-1714

DESIGNED M. ROBERTS
CHECKED M. CHOPIN

DATE 1/04
SCALE AS SHOWN


U.S. DEPARTMENT OF AGRICULTURE – NATURAL RESOURCES CONSERVATION SERVICE

NO.	DATE	APPR.	TITLE

CAD FILE NO.


DRAWING NO.
LA-352

SHEET NO 26 OF 29


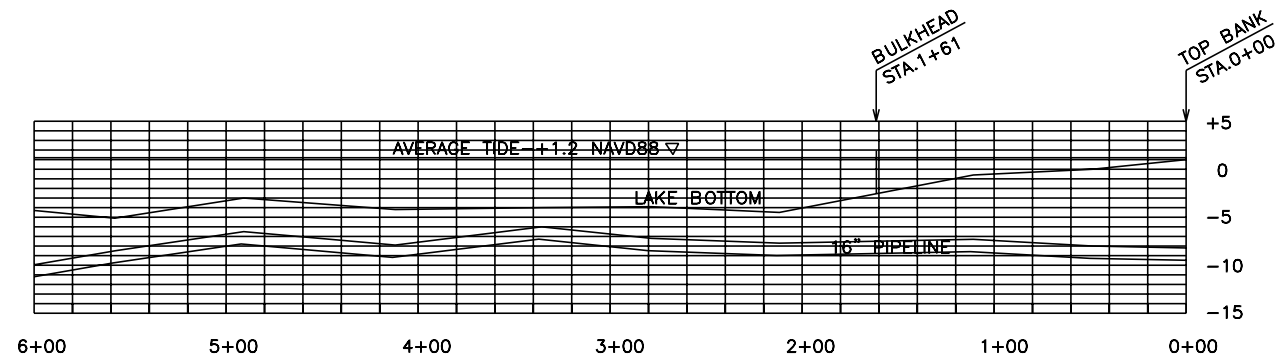


"AS-BUILT"


SHT. 27 OF 29				DRAWING NO. LA-352				CAD FILE NO.				<table><tr><th colspan="4">REVISIONS</th></tr><tr><th>NO.</th><th>DATE</th><th>APPR.</th><th>TITLE</th></tr><tr><td> </td><td> </td><td> </td><td> </td></tr><tr><td> </td><td> </td><td> </td><td> </td></tr><tr><td> </td><td> </td><td> </td><td> </td></tr><tr><td> </td><td> </td><td> </td><td> </td></tr><tr><td> </td><td> </td><td> </td><td> </td></tr><tr><td> </td><td> </td><td> </td><td> </td></tr><tr><td> </td><td> </td><td> </td><td> </td></tr></table>				REVISIONS				NO.	DATE	APPR.	TITLE																												
REVISIONS																																																			
NO.	DATE	APPR.	TITLE																																																
U.S. DEPARTMENT OF AGRICULTURE - NATURAL RESOURCES CONSERVATION SERVICE												DETAILS - ENBRIDGE PIPELINE BARATARIA BASIN LANDBRIDGE PROJECT BA-27D-CU6 JEFFERSON PARISH, LA.																																							
BURK-KLEINPETER, INC. ENGINEERS, ARCHITECTS, PLANNERS, ENVIRONMENTAL SCIENTISTS 4176 CANAL STREET, NEW ORLEANS, LOUISIANA 70119-5994 (504) 486-5901 FAX (504) 486-1714																																																			
DESIGNED												DETAILED D.J. WILMORE												DATE 1/04																											
CHECKED																								SCALE AS SHOWN																											
																								BKI_JOB NO. 10142										SHEET NO. 27																	

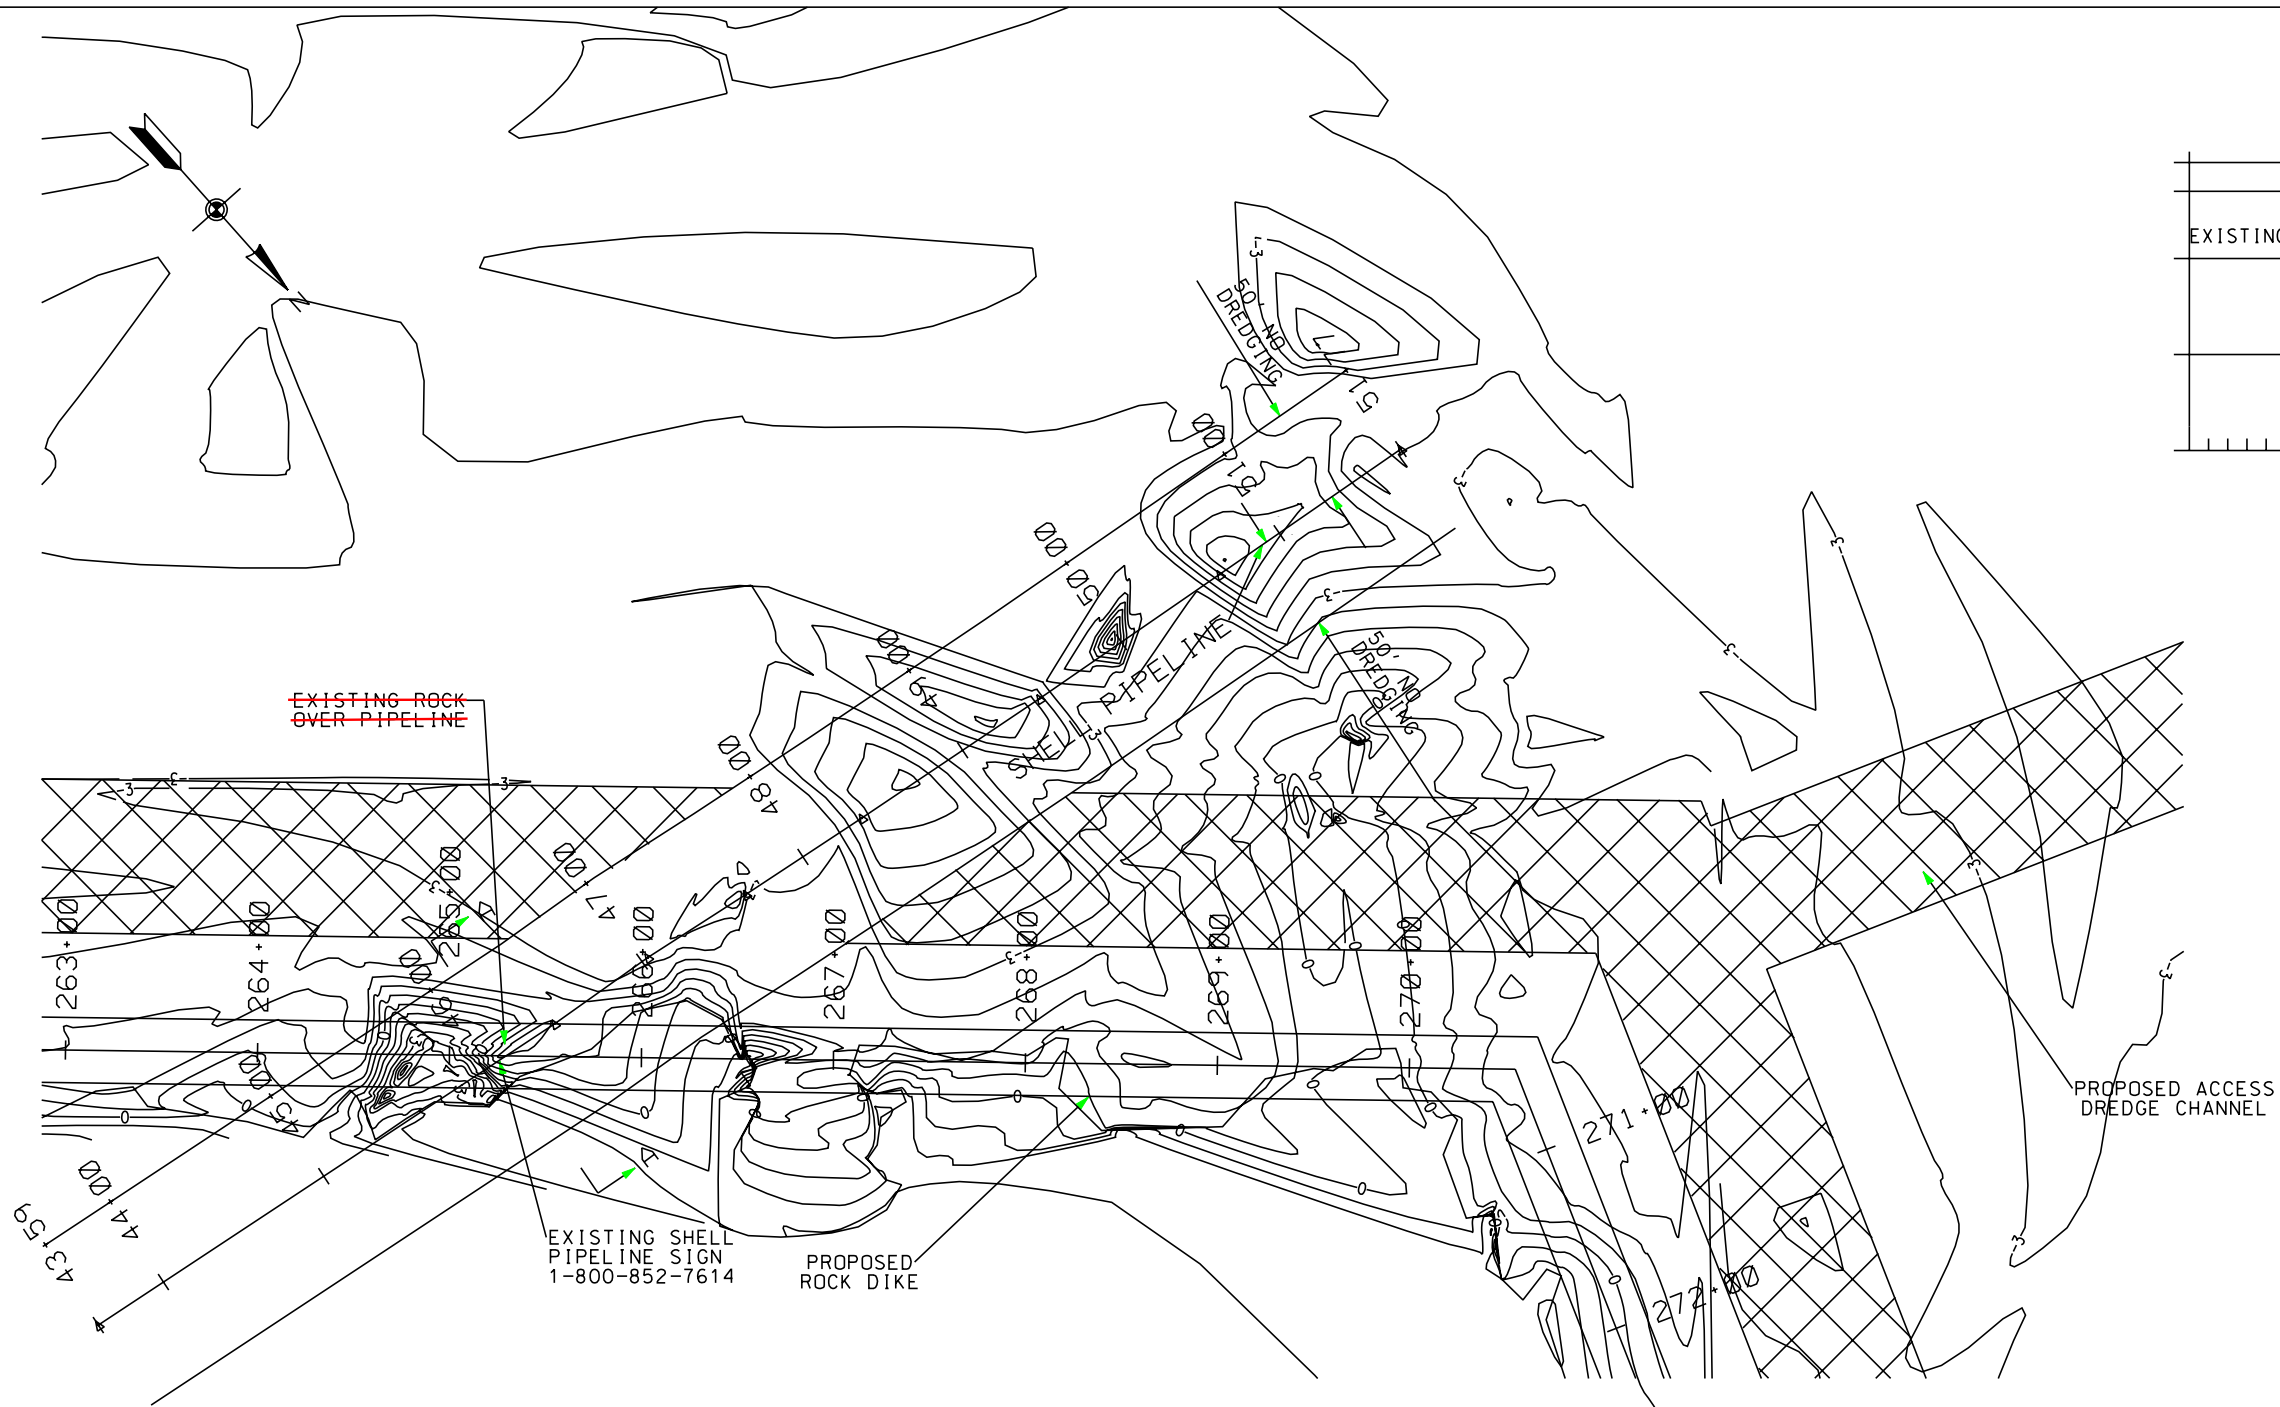

SHELL PIPELINE CROSSING
PLAN VIEW

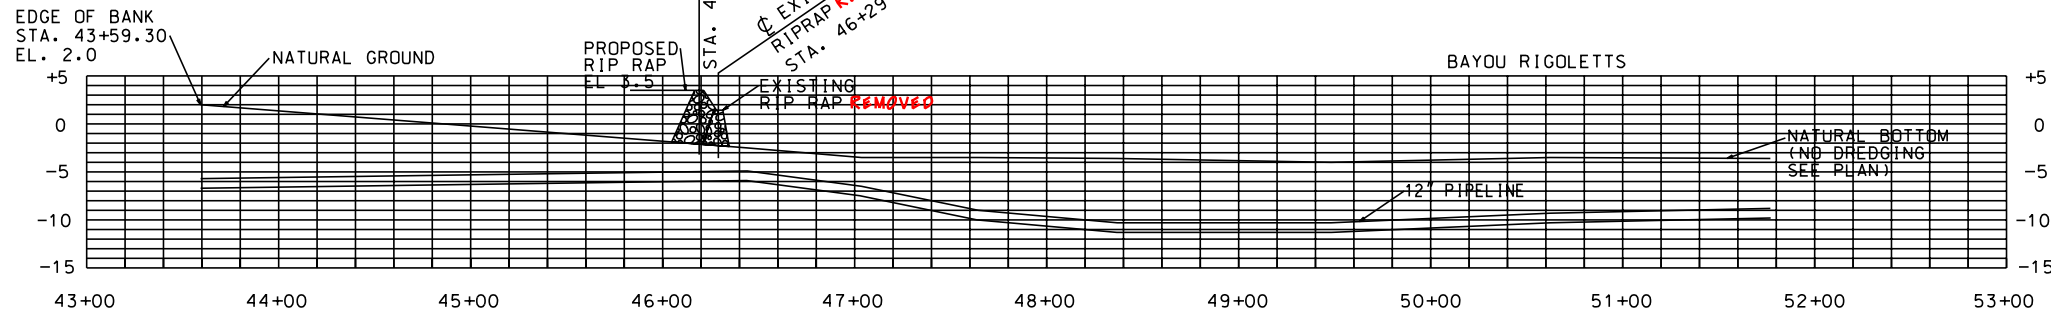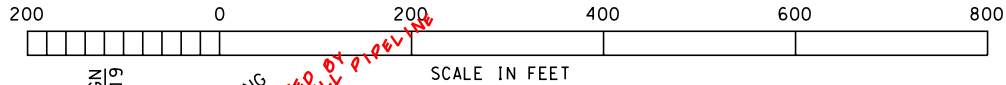

SHELL PIPELINE CROSSING
PROFILE VIEW
(LOOKING SOUTH)

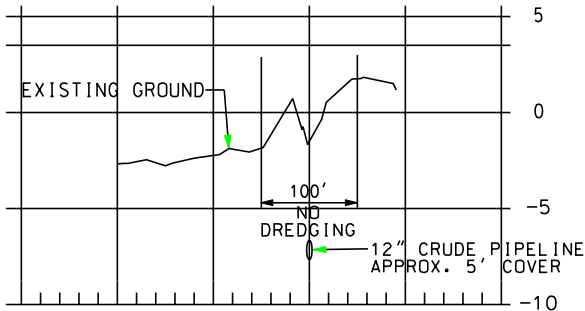







SECTION A-A

"AS-BUILT"

NOTE: STATIONING CORRESPONDS TO
SHELL PIPELINE AS-BUILTS.

DETAILS - SHELL PIPELINE BARATARIA BASIN LANDBRIDGE PROJECT BA-27D-CU6 JEFFERSON PARISH, LA.		BURK-KLEIN PETER, INC. ENGINEERS, ARCHITECTS, PLANNERS, ENVIRONMENTAL SCIENTISTS 4176 CANAL STREET, NEW ORLEANS, LOUISIANA 70119-5994 (504) 486-5901 FAX (504) 488-1714	
U.S. DEPARTMENT OF AGRICULTURE - NATURAL RESOURCES CONSERVATION SERVICE		DESIGNED M. ROBERTS	DATE 1/04
		CHECKED M. CHOPIN	SCALE AS SHOWN
			BKL JOB NO. 10142
			SHEET NO. 28

CAD FILE NO.		REVISIONS	
		NO.	DATE
			DATE
			DATE
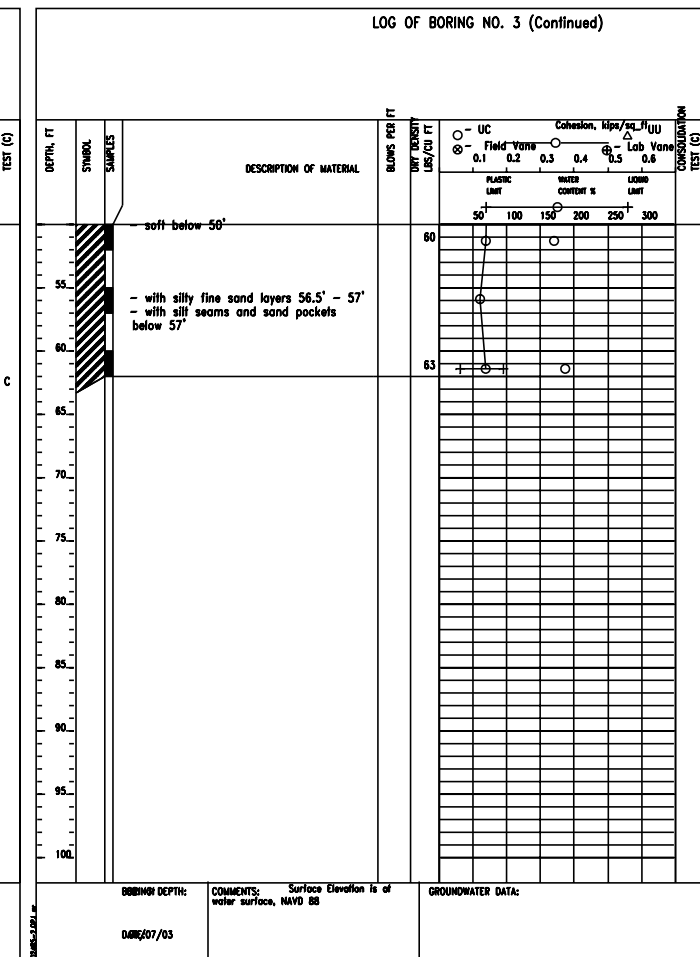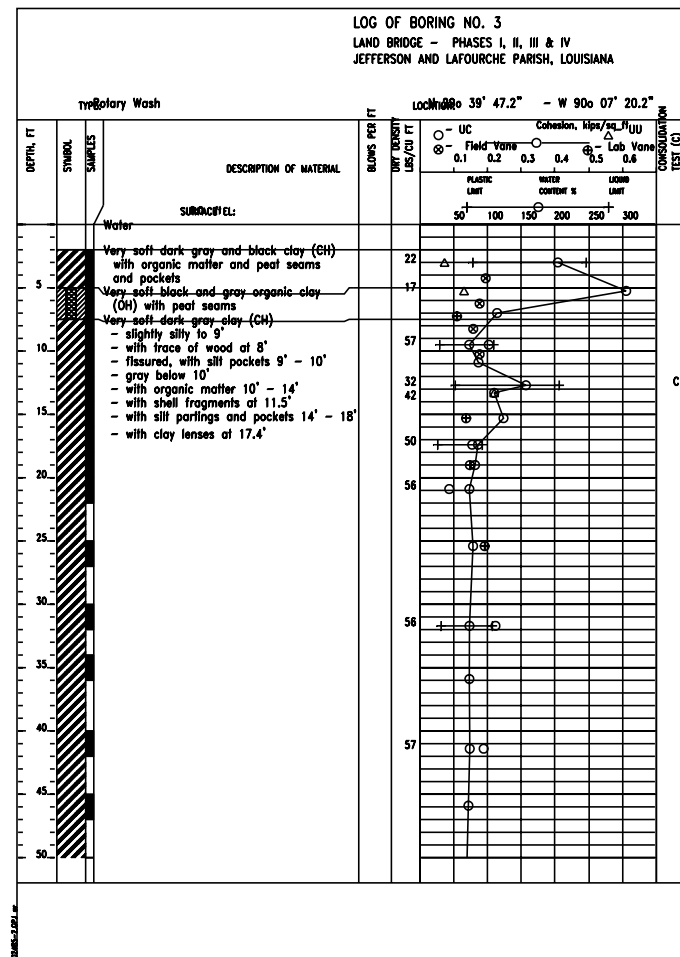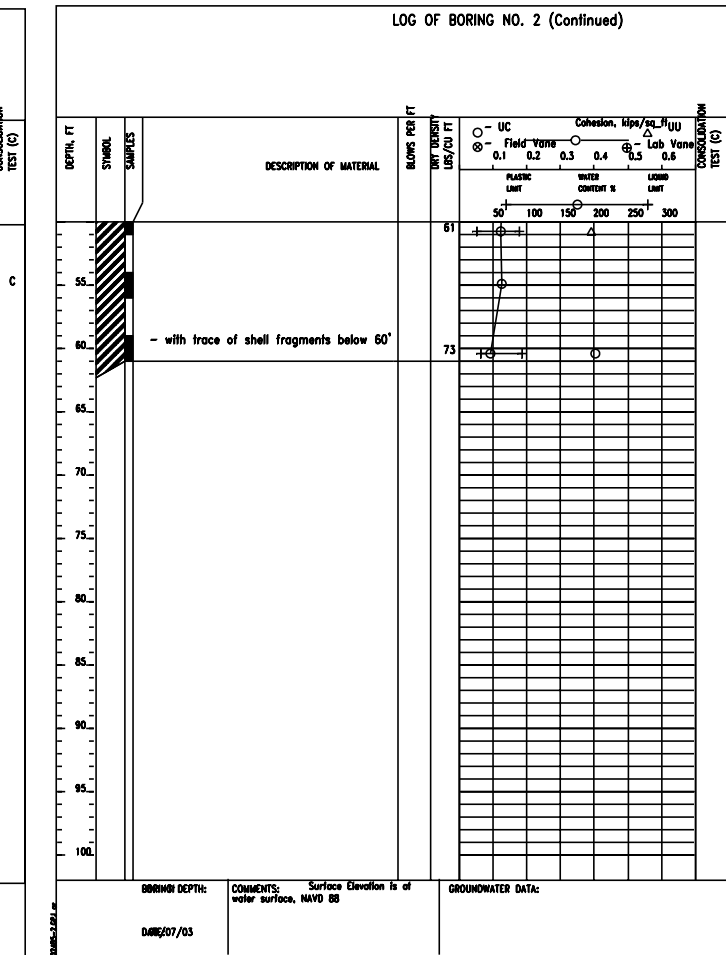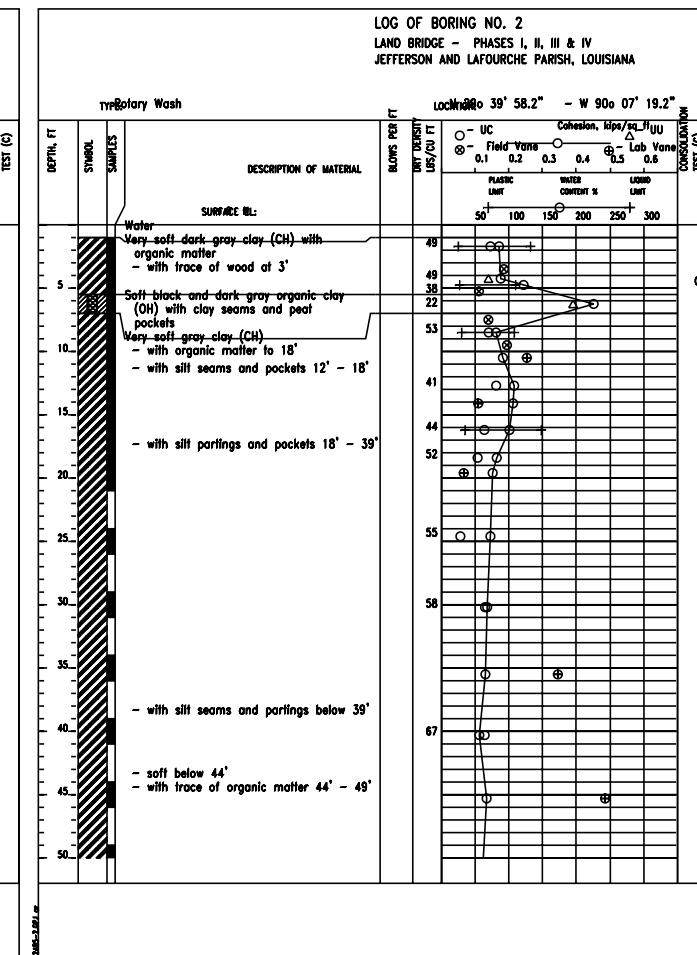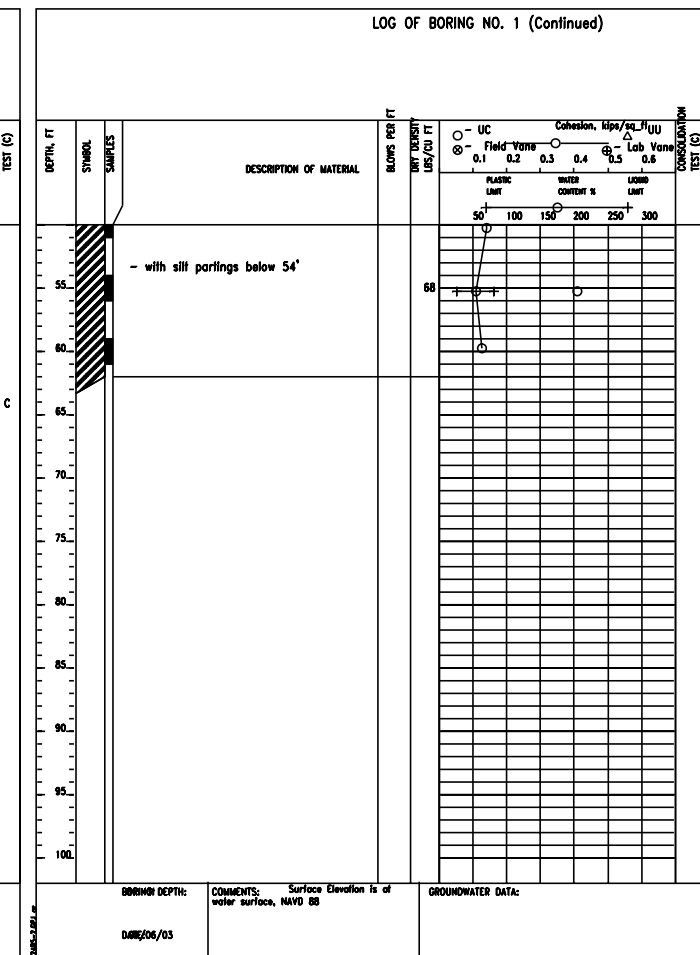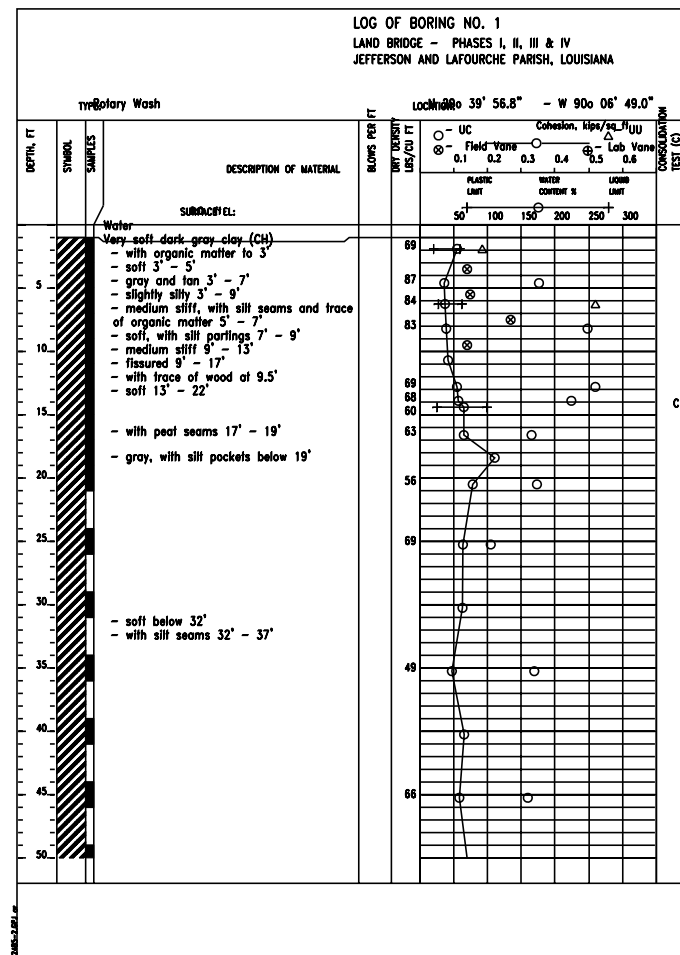

	ML SILT WITH LITTLE OR NO PLASTICITY
	CL SILTY CLAY, LOW TO MEDIUM PLASTICITY
	CH CLAY, HIGH PLASTICITY
	OH ORGANIC CLAY OF MEDIUM TO HIGH PLASTICITY
	FV FIELD VANE (KSF)
	LV LAB VANE (KSF)

BORING No.	LATITUDE	LONGITUDE
B-1	29°39'56.8"	90°06'49.0"
B-2	29°39'58.2"	90°07'19.2"
B-3	29°39'47.2"	90°07'20.2"
B-4	29°39'25.8"	90°07'03.3"
B-5	29°39'14.4"	90°07'02.3"
B-6	29°38'46.0"	90°06'45.5"
B-7	29°38'02.2"	90°06'46.8"
B-8	29°37'23.4"	90°06'53.1"
B-9	29°36'42.4"	90°06'46.5"

"AS-BUILT"

SOIL BORINGS
BARATARIA BASIN LANDBRIDGE
PROJECT BA-27D-CU 6
JEFFERSON PARISH, LA.

BURK-KLEINPETER, INC.
ENGINEERS, ARCHITECTS, PLANNERS, ENVIRONMENTAL
4176 CANAL STREET, NEW ORLEANS, LOUISIANA 70115
(504) 486-5901 FAX (504) 488-1714









DESIGNED M. ROBERTS

DATE 1/04

U.S. DEPARTMENT OF AGRICULTURE - NATURAL RESOURCES CONSERVATION SERVICE

10142

29

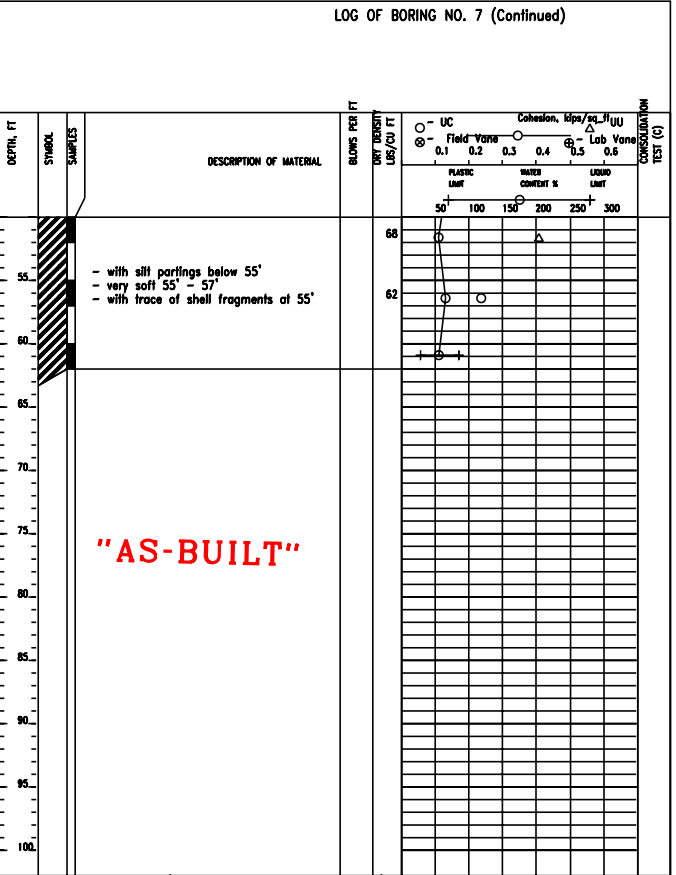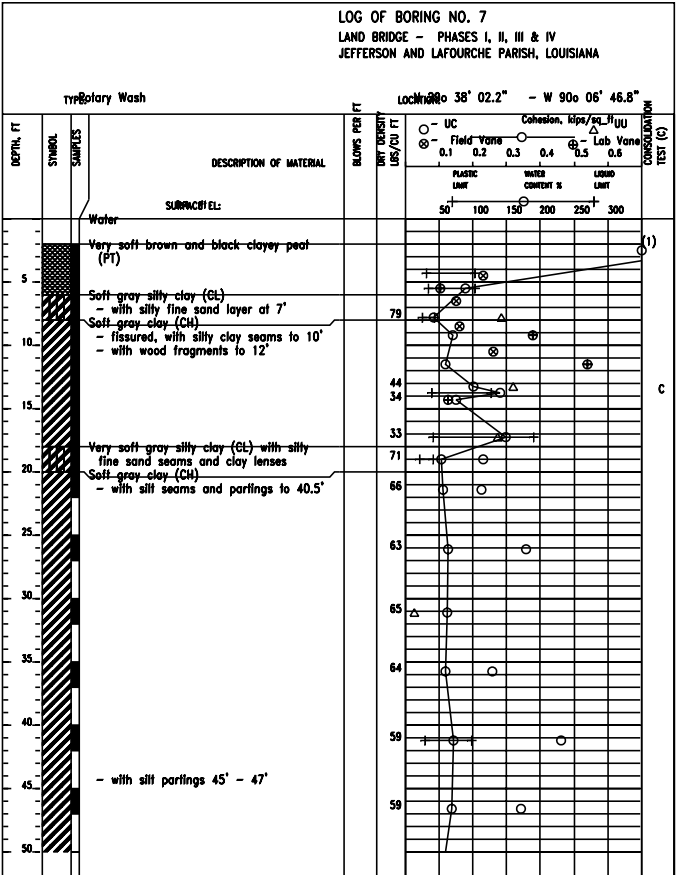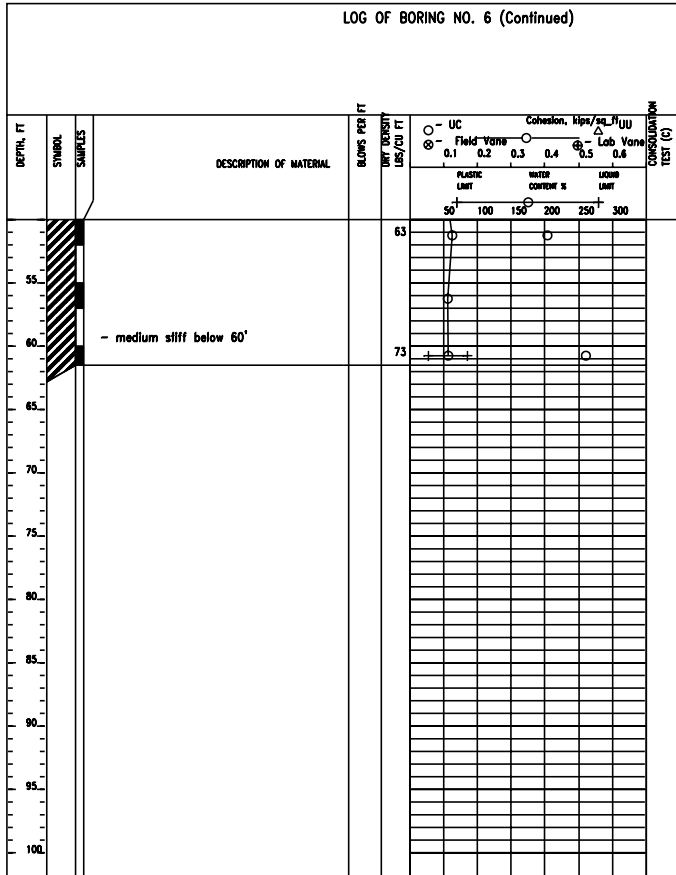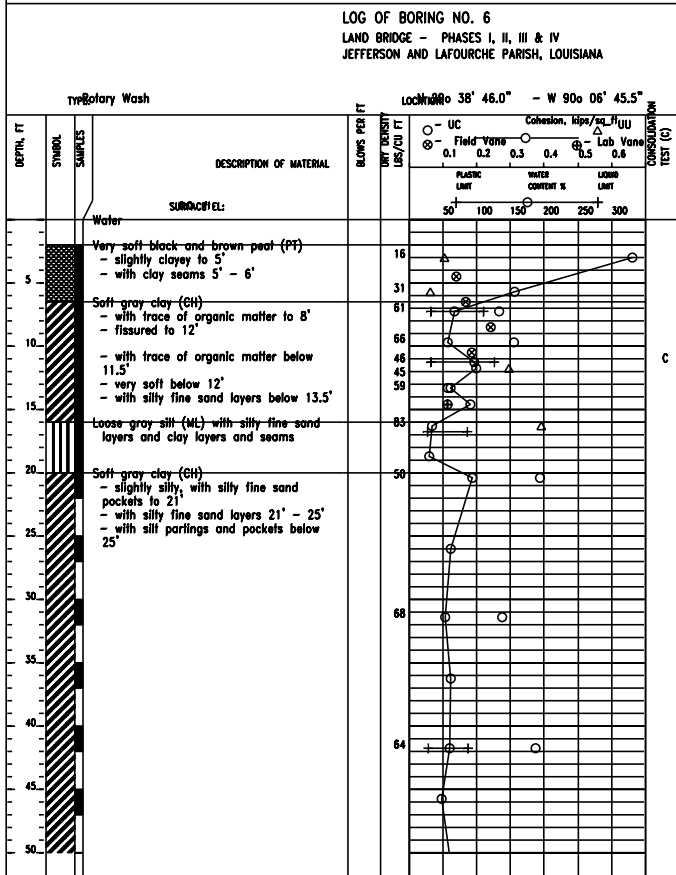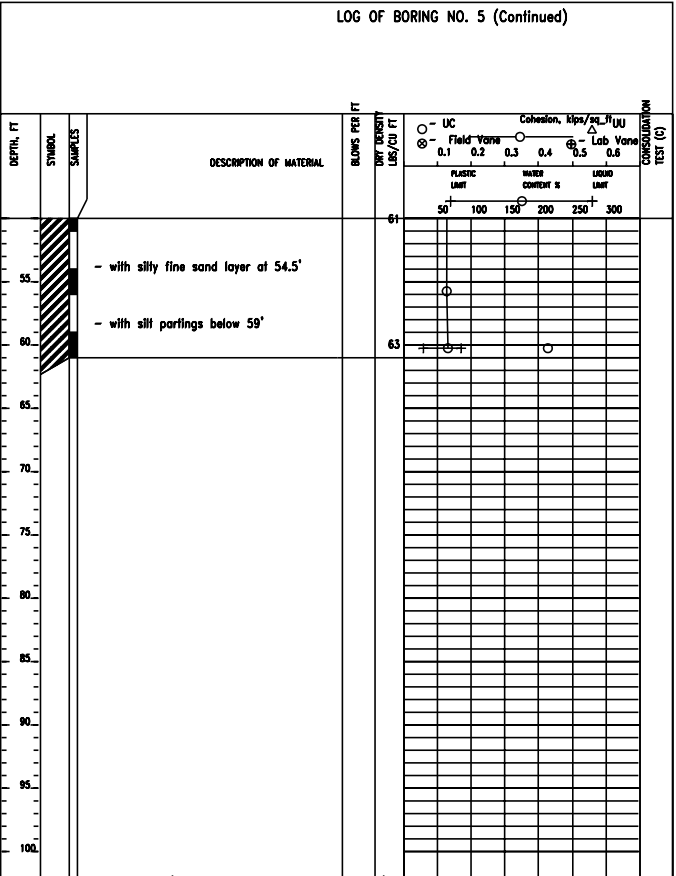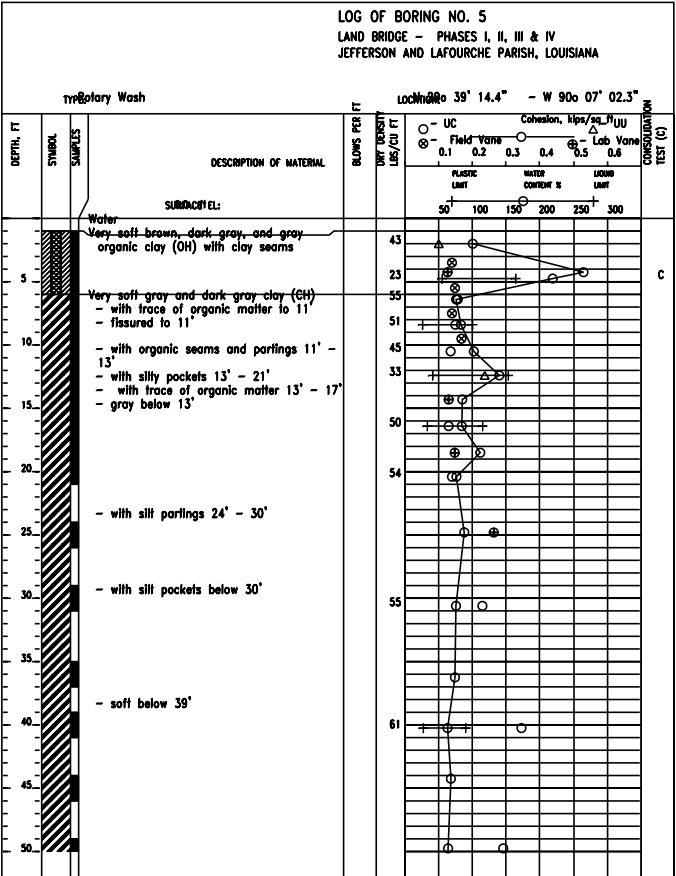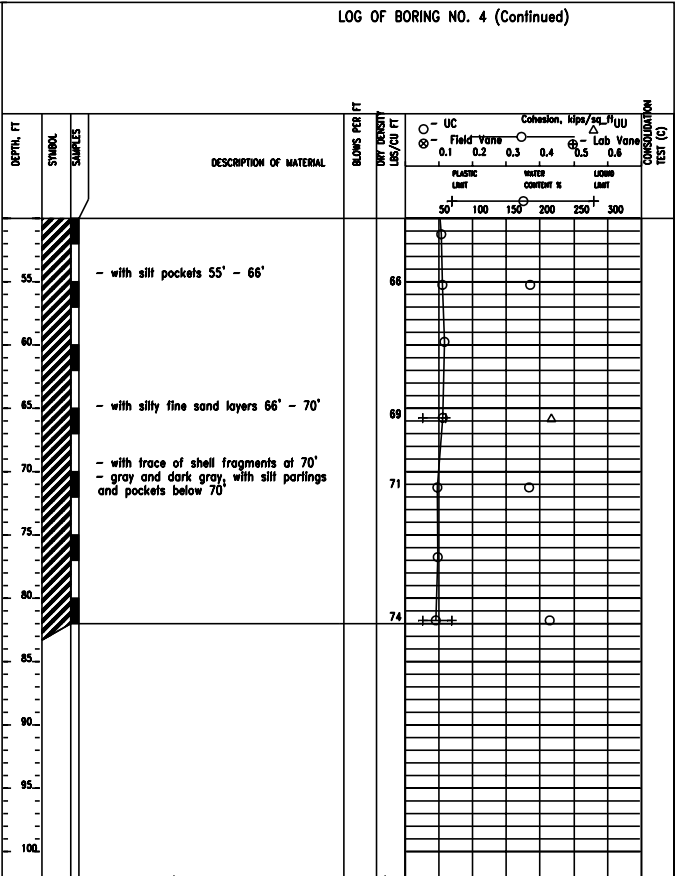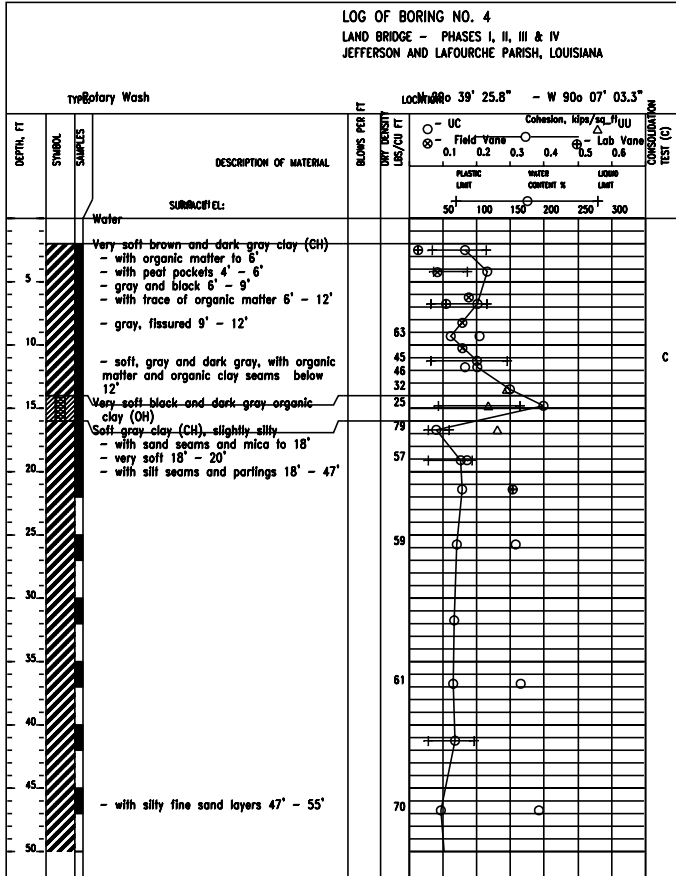

BURK-KLEINPETER, INC.
ENGINEERS, ARCHITECTS, PLANNERS, ENVIRONMENTAL SCIENTISTS
4176 CANAL STREET, NEW ORLEANS, LOUISIANA 70119-5994
(504) 486-5901 FAX (504) 486-1714





SOIL BORINGS
BARATARIA BASIN LANDBRIDGE
PROJECT BA-27D-CU 6
JEFFERSON PARISH, LA.

NO.	DATE	APPR.	TITLE

CAD FILE NO.
DRAWING NO.
LA-352
SHEET NO 29 of 29

DESIGNED M. ROBERTS
CHECKED M. CHOPIN
DATE 1/04
SCALE AS SHOWN
SHEET NO. 29g

DETAILED C. SCURICH
U.S. DEPARTMENT OF AGRICULTURE - NATURAL RESOURCES CONSERVATION SERVICE

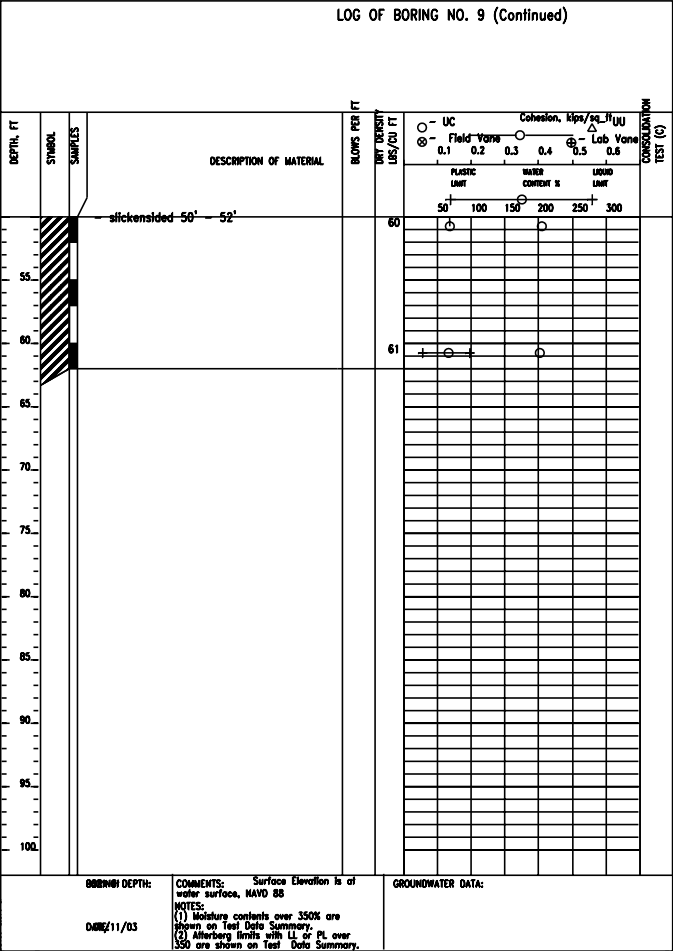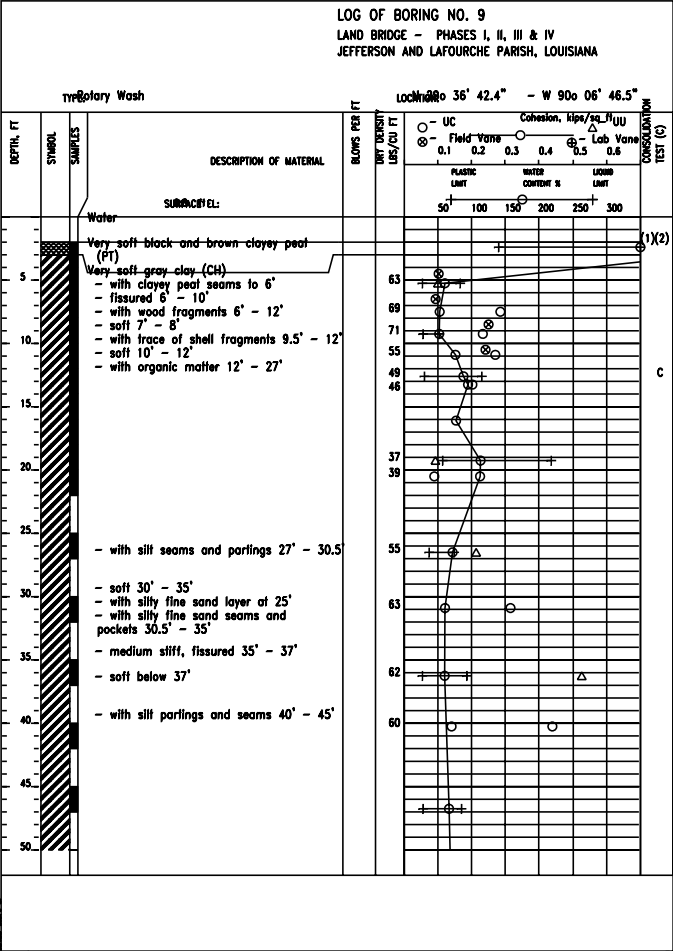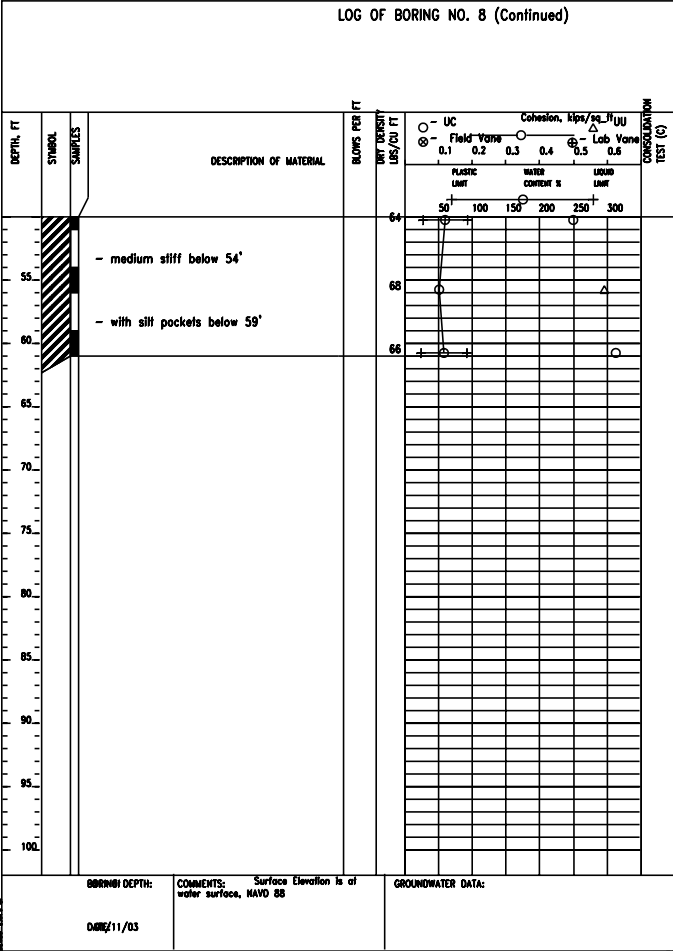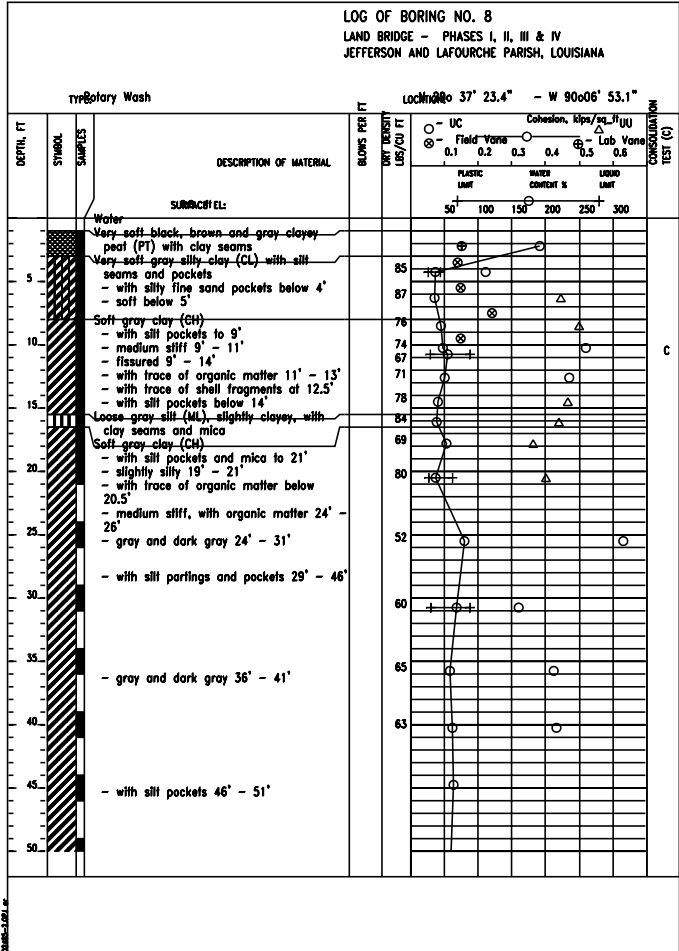

"AS-BUILT"

SOIL BORINGS
BARATARIA BASIN LANDBRIDGE
PROJECT BA-27D-CU 6
JEFFERSON PARISH, LA.

BURK-KLEINPETER, INC.
ENGINEERS, ARCHITECTS, PLANNERS, ENVIRONMENTAL SCIENTISTS
4176 CANAL STREET, NEW ORLEANS, LOUISIANA 70119-5994
(504) 486-5901 FAX (504) 486-1714

DESIGNED M. ROBERTS
CHECKED M. CHOPIN

DATE 1/04

SCALE AS SHOWN

SHEET NO. 29b

U.S. DEPARTMENT OF AGRICULTURE - NATURAL RESOURCES CONSERVATION SERVICE

NO.	DATE	REVISIONS	TITLE

CAD FILE NO.

DRAWING NO.
LA-352

SHEET NO 29b OF 29