




| | | | |
|------------|------------|---------------|-----------|
| PROJECT | DATE | SCALE | SHEET NO. |
| 10-41 7190 | 4-10-13-02 | 5/1 20th TIME | 1/30 |

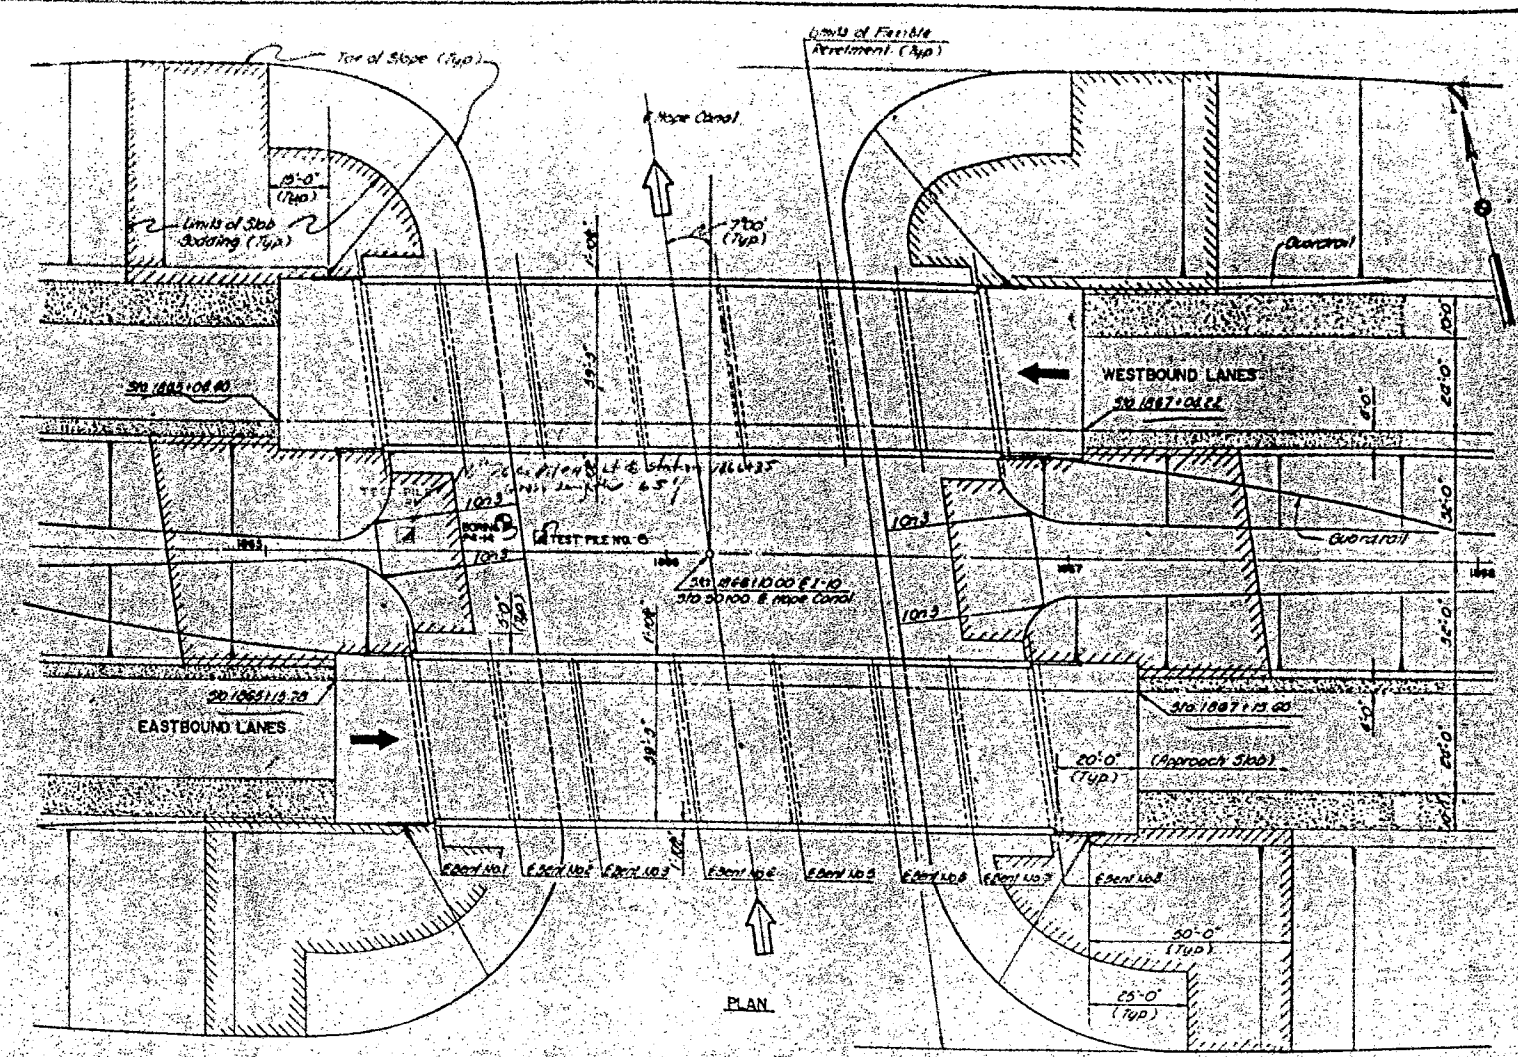

42'-0" to E-I-10
Symmetrical about E-I-10

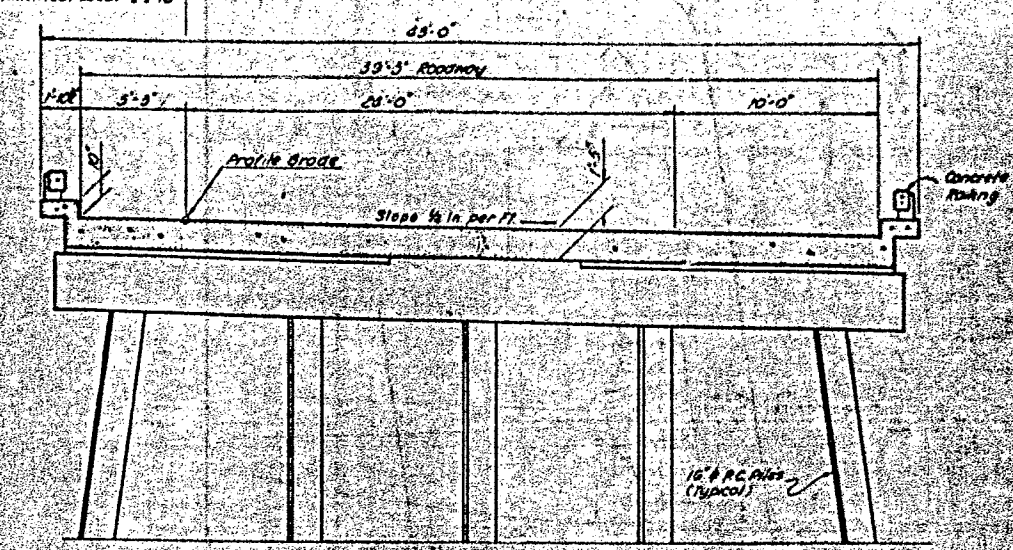


TYPICAL SECTION

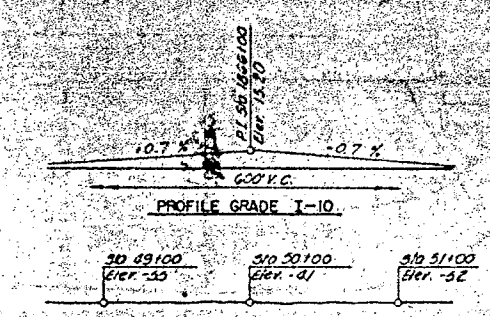

PROFILE HOPE CANAL

I-10 Main Lane
Design Speed = 60 mph
1988 A-27 Traffic = 11,700

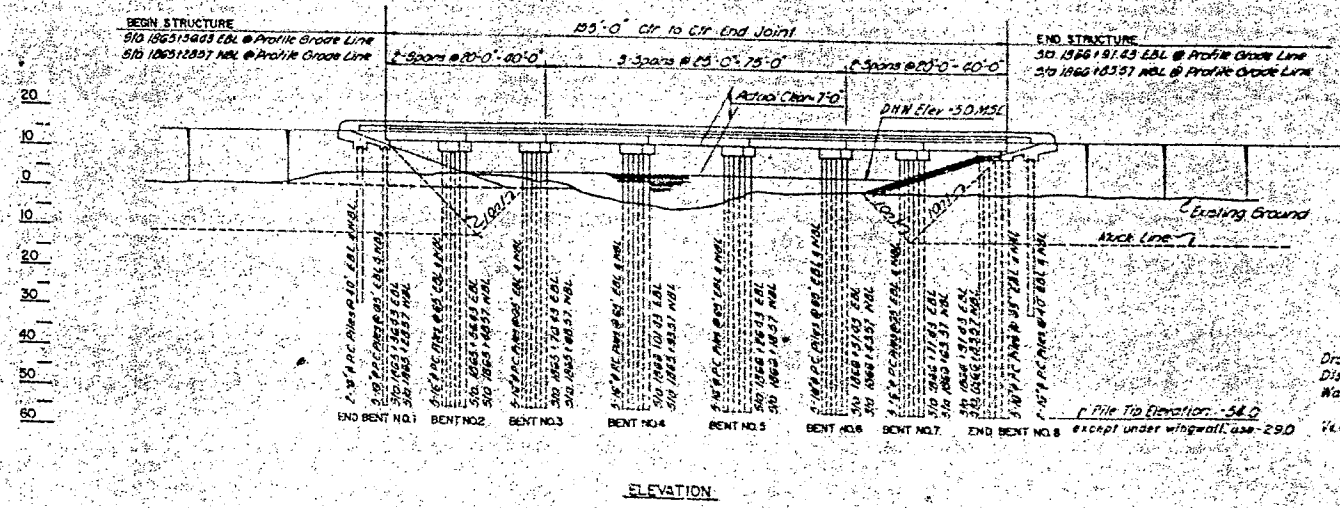

ELEVATION

HYDRAULIC DATA

Drainage Area: 1875 Sq. Mi.
Discharge (50 year Flood): 1750 cfs
Waterway Area below Elev. 50: 577 Sq. Ft. (Suggested)
Velocity, Average: 5.0 fps (Suggested), 3.0 fps (Actual)

CROSS SECTION

Notes for Net Lengths of Piling in Place
See Final Book 108-292
pp. 5-116

Notes:
For General Notes see Sheet No. 101.
Live Load: HS 20-44 (Modified).
The location of borings is shown in plan by \odot .
For Boring Logs see Sheets No. 144 & 147.
For drain locations see Sheets No. 134 & 135.
The location of test pile is shown in plan by \square .
Test piles are not permanent. They shall be cut off at an elevation of 2 ft. below existing ground and covered with soil or they must be pulled.

| | |
|--|-------------------------|
| STATE OF LOUISIANA DEPARTMENT OF HIGHWAYS | |
| INTERSTATE I-10 OVER HOPE CANAL STA. 1866+10.00 | |
| BARNARD & BLUES HOWARD NEEDLER TAMMEN & BERGENCOFF CONSULTING ENGINEERS - BAYOU ROUGE, LOUISIANA | |
| DATE: 8/10/07 | SCALE: N.P.S. |
| DESIGNED BY: [Signature] | CHECKED BY: [Signature] |

AS BUILT