


TBM 1

100
1.49
TE-48-SM-01 (CON)
Lat. 29°03'14.79115"
Lon. 90°55'59.37394"

CAILLOU BAY


RACCOON ISLAND

GULF OF MEXICO

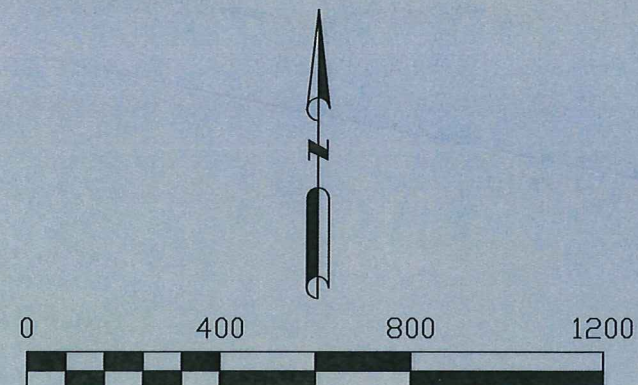

GRAPHIC SCALE IN FEET

NOTE: IMAGERY TAKEN FROM USING
GOOGLE EARTH PRO, DATED
1/24/2015.

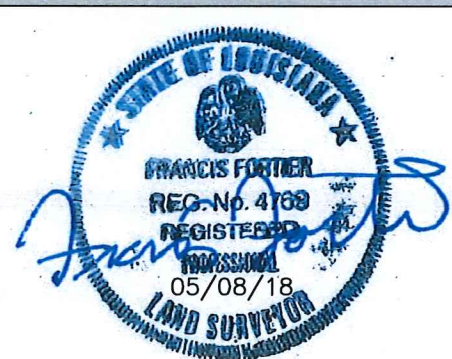

SURVEYED BY:
FRANCIS FORTIER, P.L.S. 4769
3091 HIGHWAY 104
OPELOUSAS, LOUISIANA 70570
PHONE: (337) 278-7204

**RACCOON ISLAND
BREAKWATER REHABILITATION PROJECT
TERREBONNE PARISH, LOUISIANA
COVER SHEET
SCALE: 1"=400'**

SURVEY NOTES:

PRE-CONSTRUCTION SURVEYS DONE ON:

01-15-2018
01-20-2018
02-17-2018

POST-CONSTRUCTION SURVEYS DONE ON:

04-10-2018
04-16-2018
04-21-2018

VERTICAL DATUM:

1988 (NAVD '88) USING GEOID 2012A





HORIZONTAL DATUM:

NORTH AMERICAN DATUM OF 1983 (NAD '83,
LOUISIANA STATE PLANE SOUTH ZONE) U.S.
SURVEY FEET (FEET).

SHEET 1 OF 11

5	CORRECTIONS MADE AS PER COMMENTS, MODIFIED POST-CONSTRUCTION SURVEY PROFILES ON SHT 10 & ADDED LEGEND SHTS 2 THRU 11	GPS	FAF	05/08/18
4	CORRECTIONS MADE AS PER COMMENTS	GPS	FAF	05/07/18
3	ADDED SHTS 2 THRU 11	GPS	FAF	04/30/18
2	ADDED AS BUILT BREAKWATER POINTS	GPS	FAF	02/19/18
1	ADDED STONE GROIN POINTS	GPS	FAF	01/25/18
0	FINAL	GPS	FAF	01/17/18
REV	ISSUE	DWN	APP	DATE


LEGEND:	
	DENOTES POST-CONSTRUCTION SURVEY
	DENOTES PRE-CONSTRUCTION SURVEY

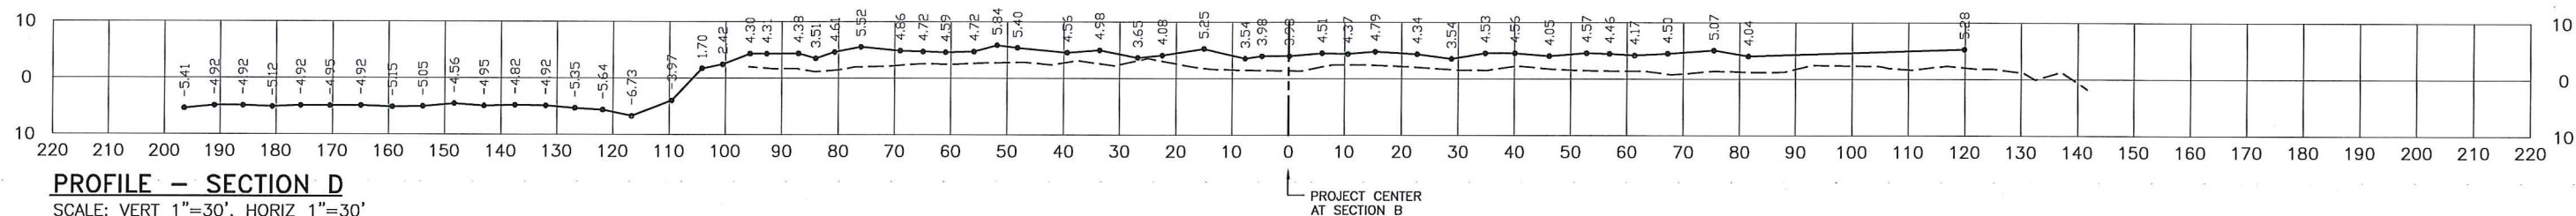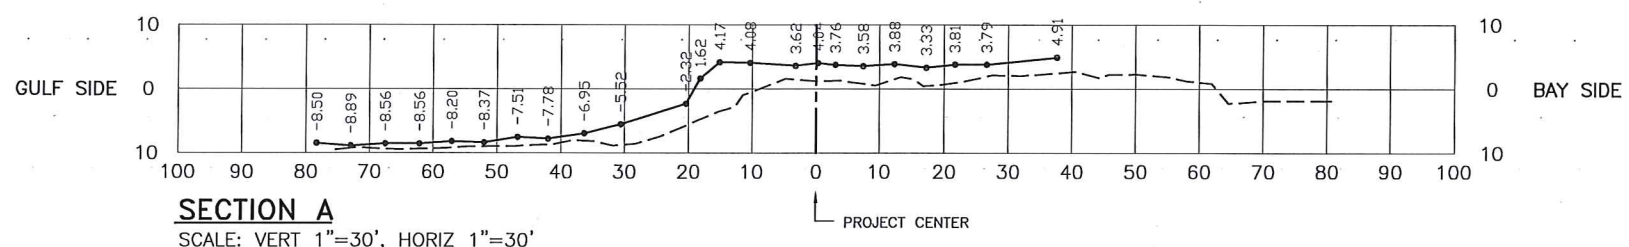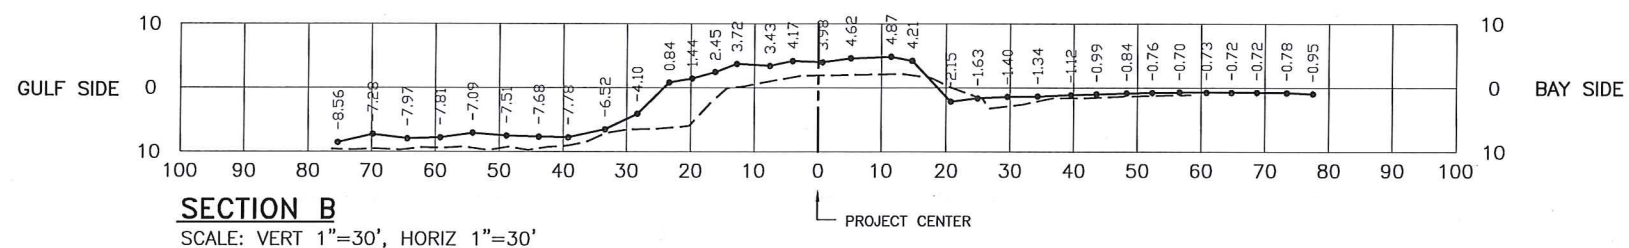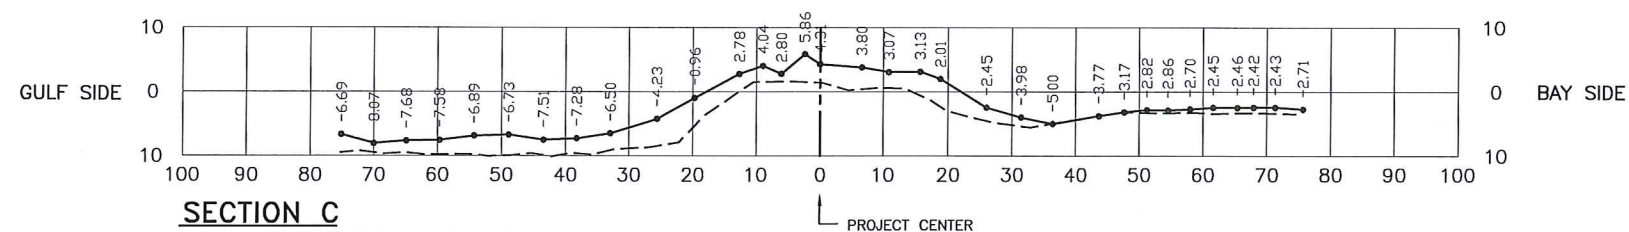






SURVEYED BY:
FRANCIS FORTIER, P.L.S. 4769
3091 HIGHWAY 104
OPELOUSAS, LOUISIANA 70570
PHONE: (337) 278-7204

**RACCOON ISLAND
BREAKWATER REHABILITATION PROJECT
TERREBONNE PARISH, LOUISIANA**

BREAKWATER 0
PLAN AND SECTIONS

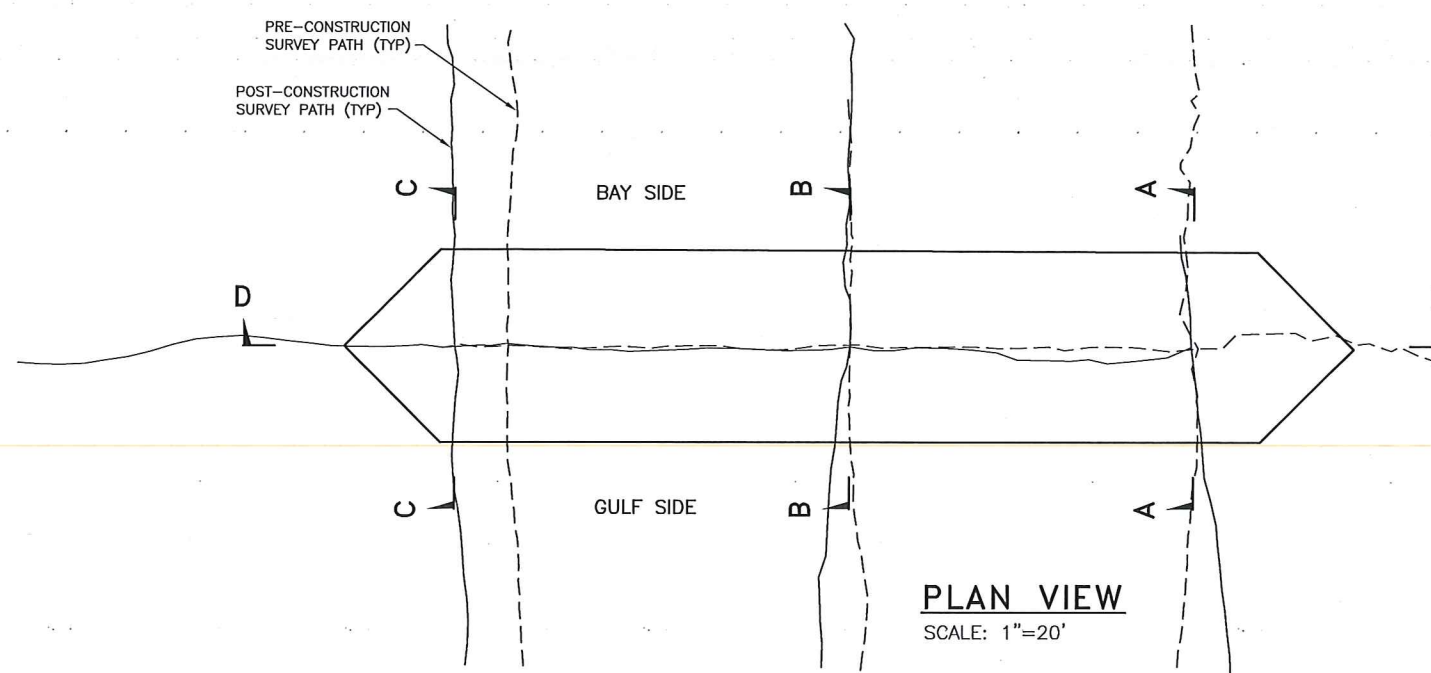


LEGEND:	
	DENOTES POST-CONSTRUCTION SURVEY
	DENOTES PRE-CONSTRUCTION SURVEY

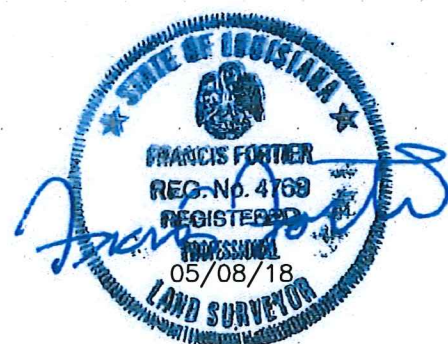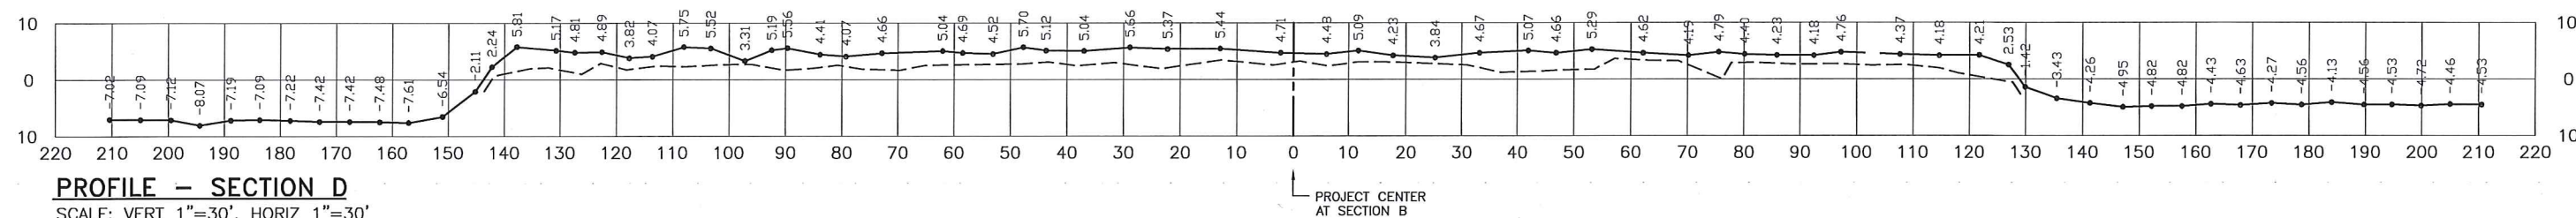
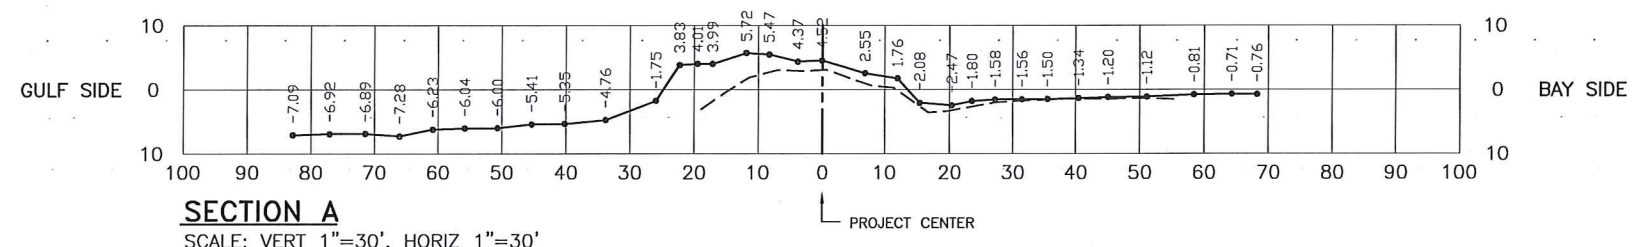
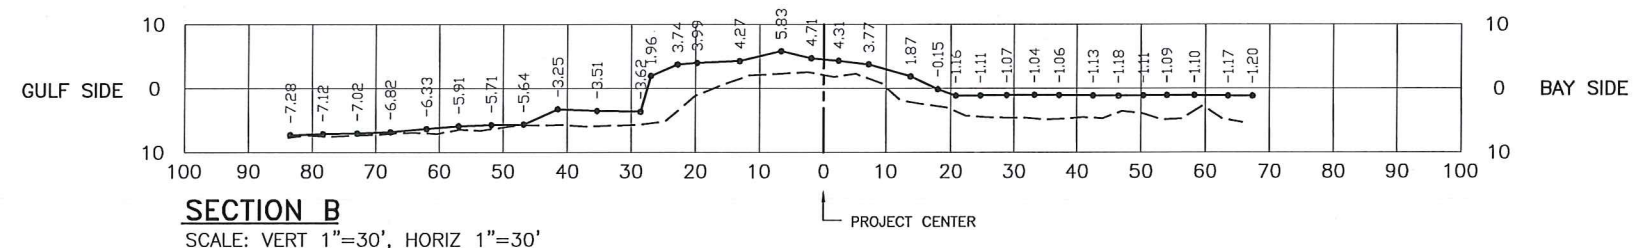
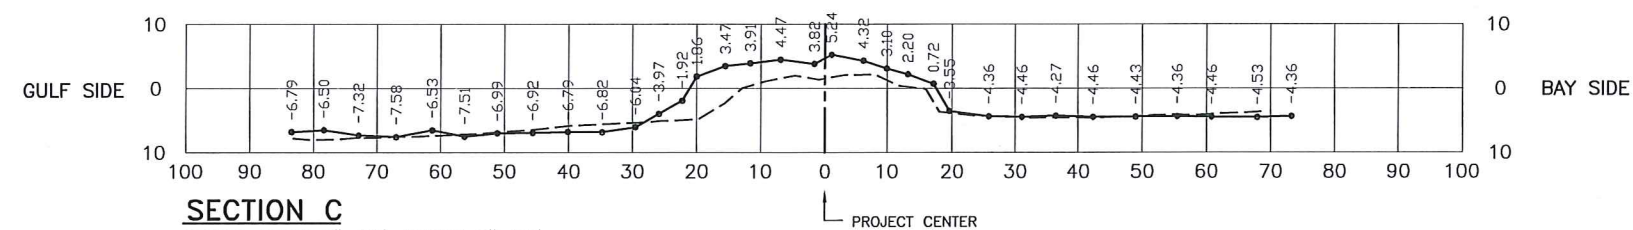


SURVEYED BY:
FRANCIS FORTIER, P.L.S. 4769
3091 HIGHWAY 104
OPELOUSAS, LOUISIANA 70570
PHONE: (337) 278-7204


**RACCOON ISLAND
BREAKWATER REHABILITATION PROJECT
TERREBONNE PARISH, LOUISIANA**
BREAKWATER 1
PLAN AND SECTIONS

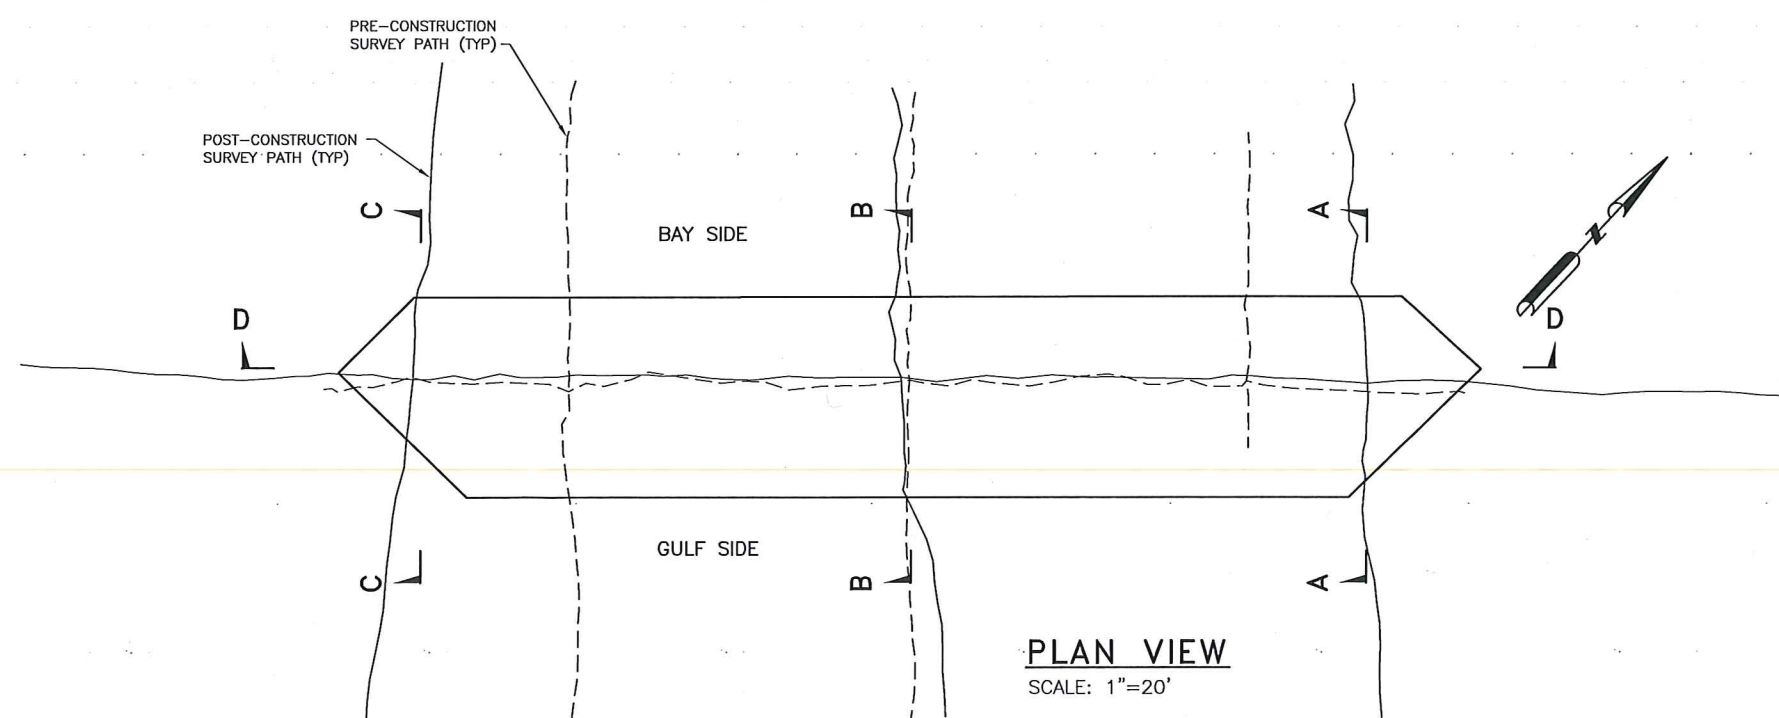

LEGEND:	
	DENOTES POST-CONSTRUCTION SURVEY
	DENOTES PRE-CONSTRUCTION SURVEY

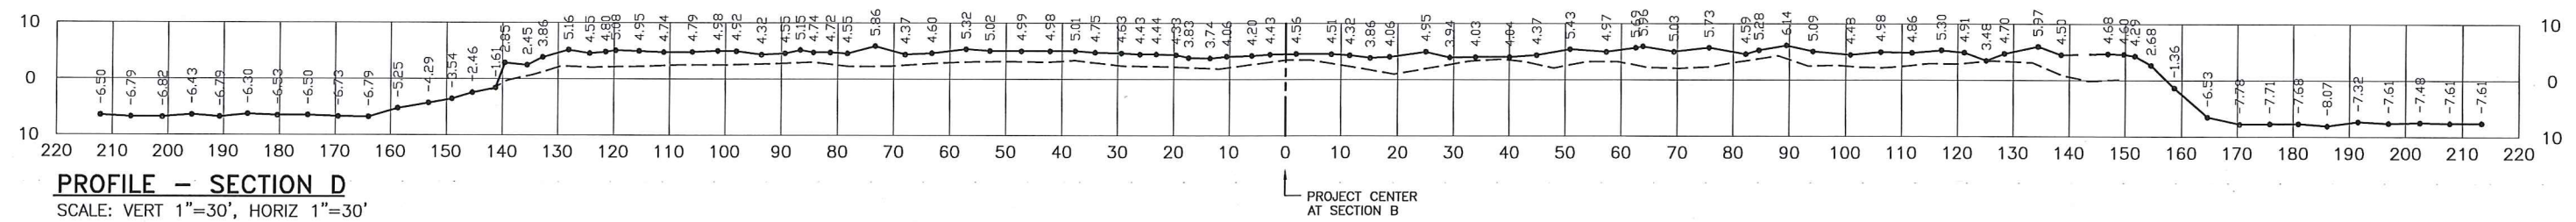
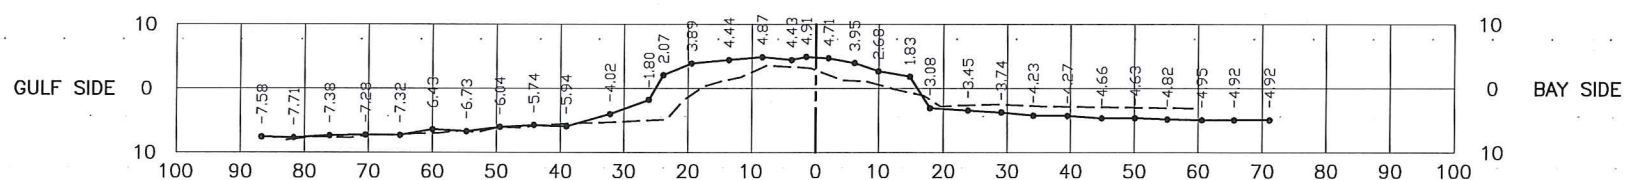
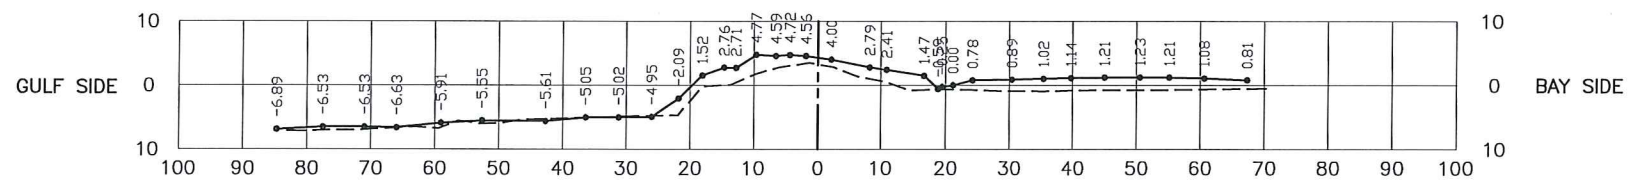
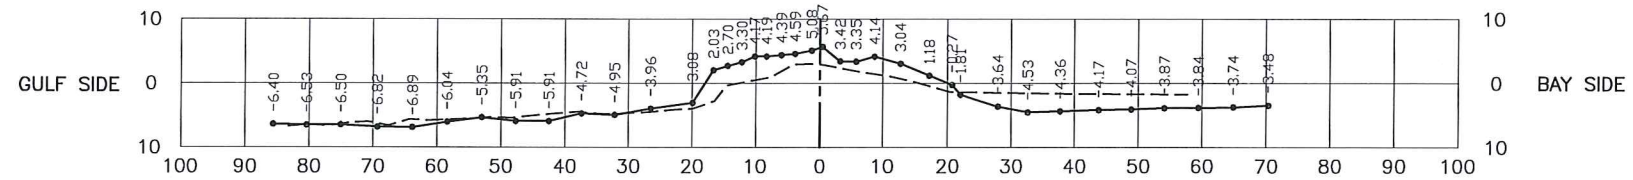


SURVEYED BY:
FRANCIS FORTIER, P.L.S. 4769
3091 HIGHWAY 104
OPELOUSAS, LOUISIANA 70570
PHONE: (337) 278-7204

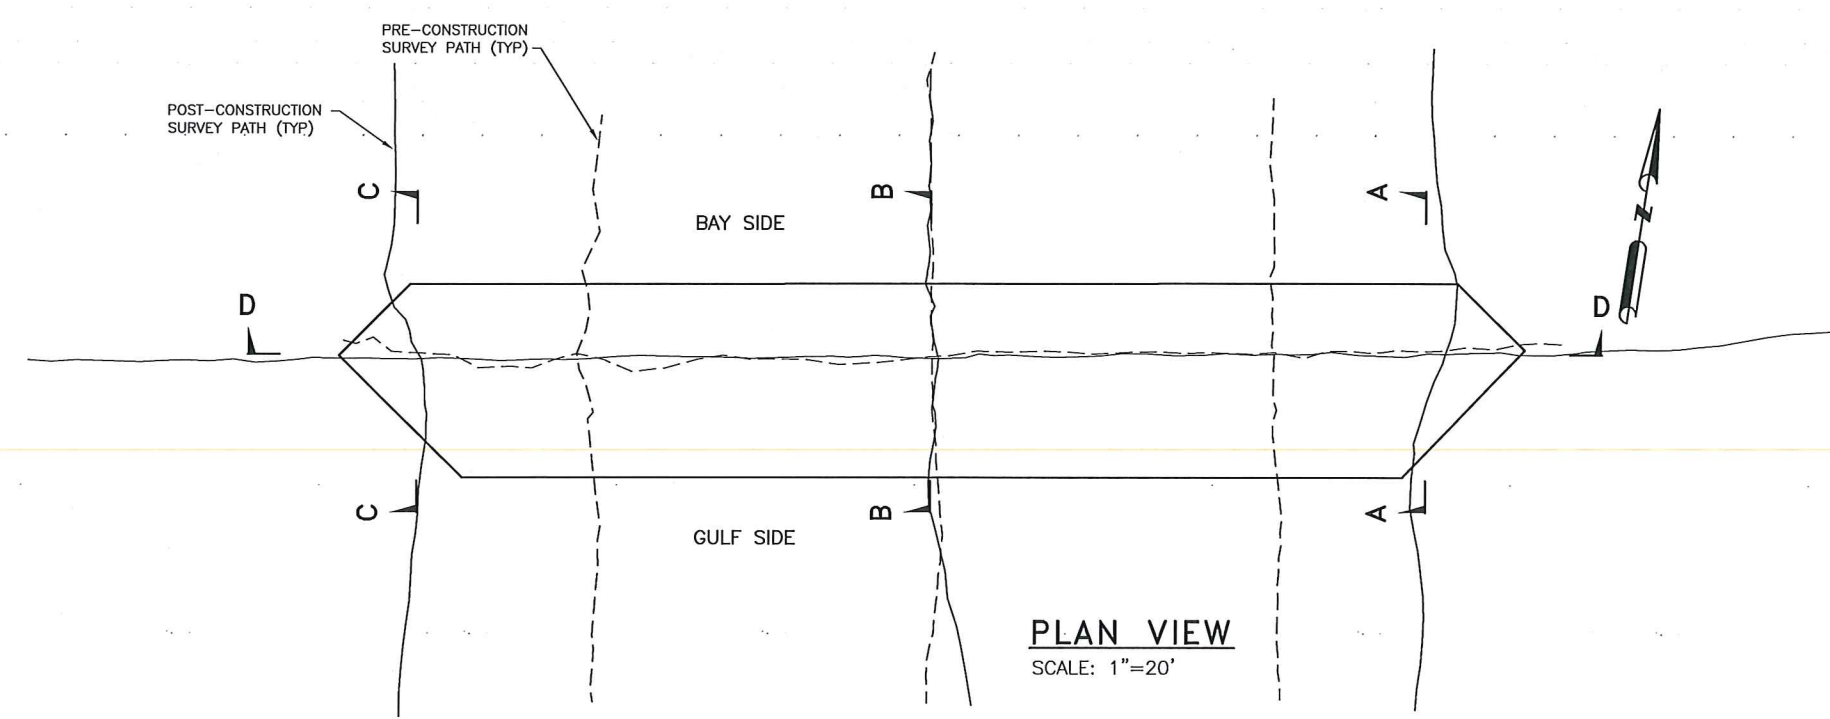

**RACCOON ISLAND
BREAKWATER REHABILITATION PROJECT
TERREBONNE PARISH, LOUISIANA**
BREAKWATER 2
PLAN AND SECTIONS


LEGEND:	
	DENOTES POST-CONSTRUCTION SURVEY
	DENOTES PRE-CONSTRUCTION SURVEY

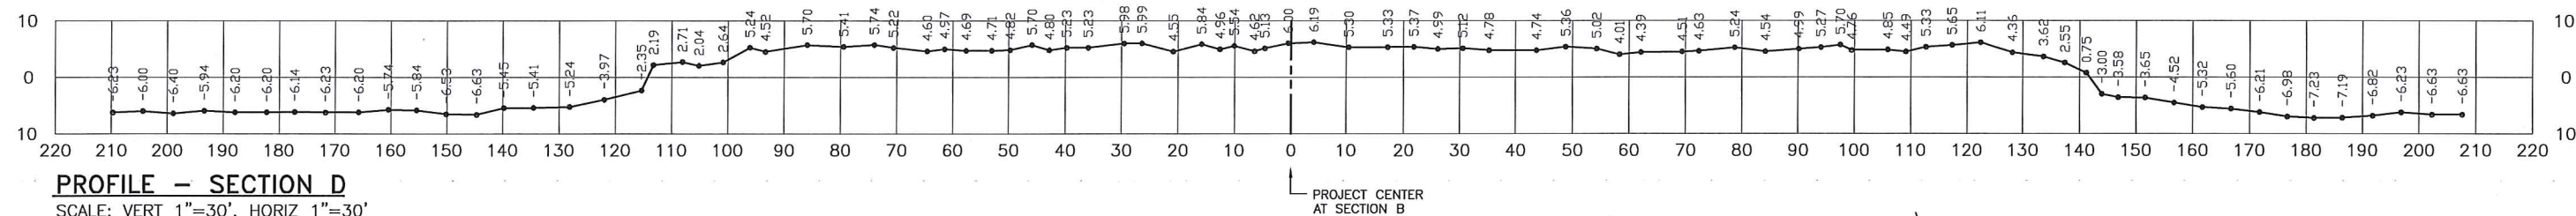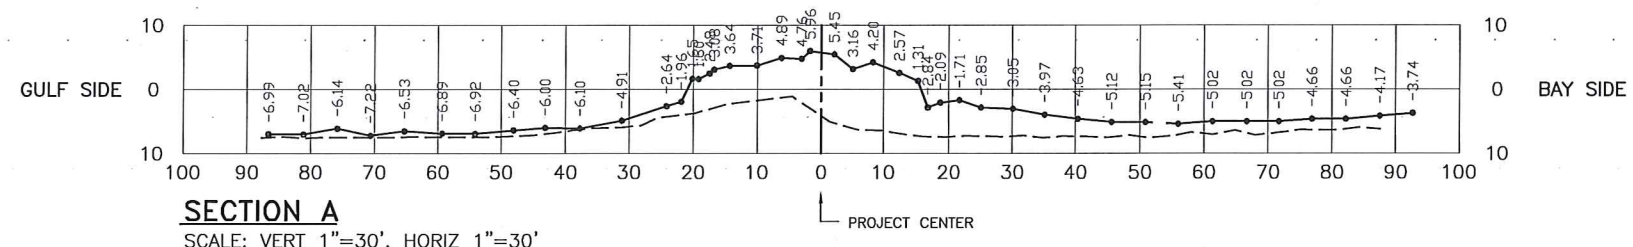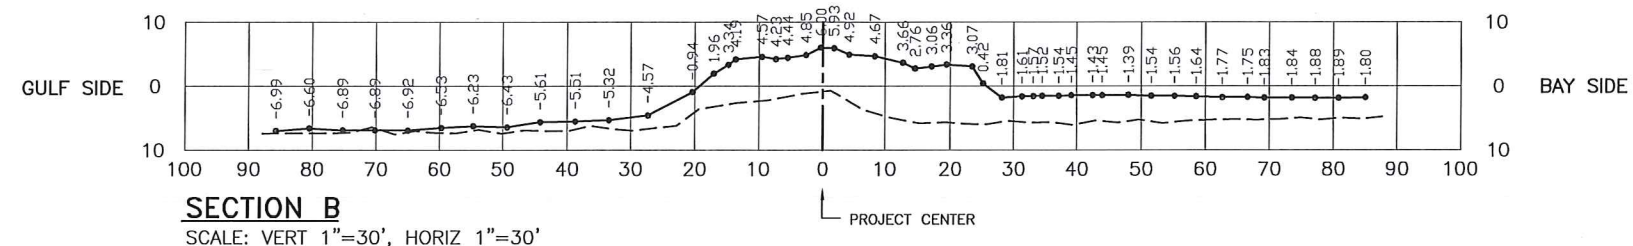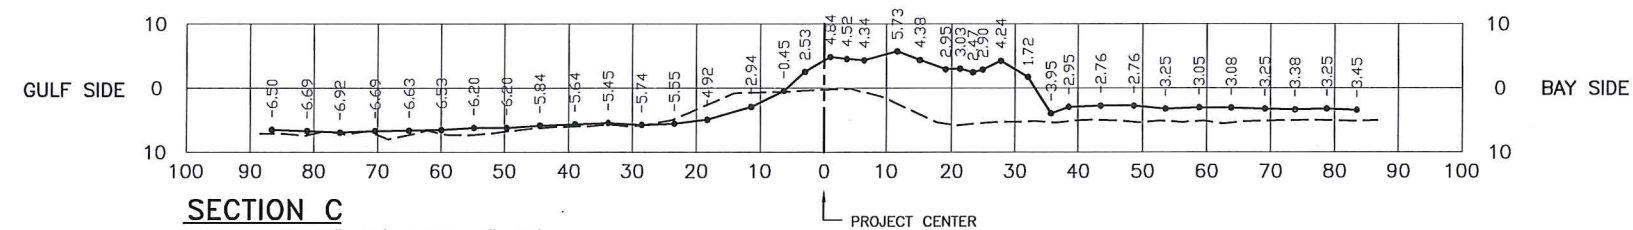





SURVEYED BY:
FRANCIS FORTIER, P.L.S. 4769
3091 HIGHWAY 104
OPELOUSAS, LOUISIANA 70570
PHONE: (337) 278-7204

**RACCOON ISLAND
BREAKWATER REHABILITATION PROJECT
TERREBONNE PARISH, LOUISIANA**


BREAKWATER 3
PLAN AND SECTIONS

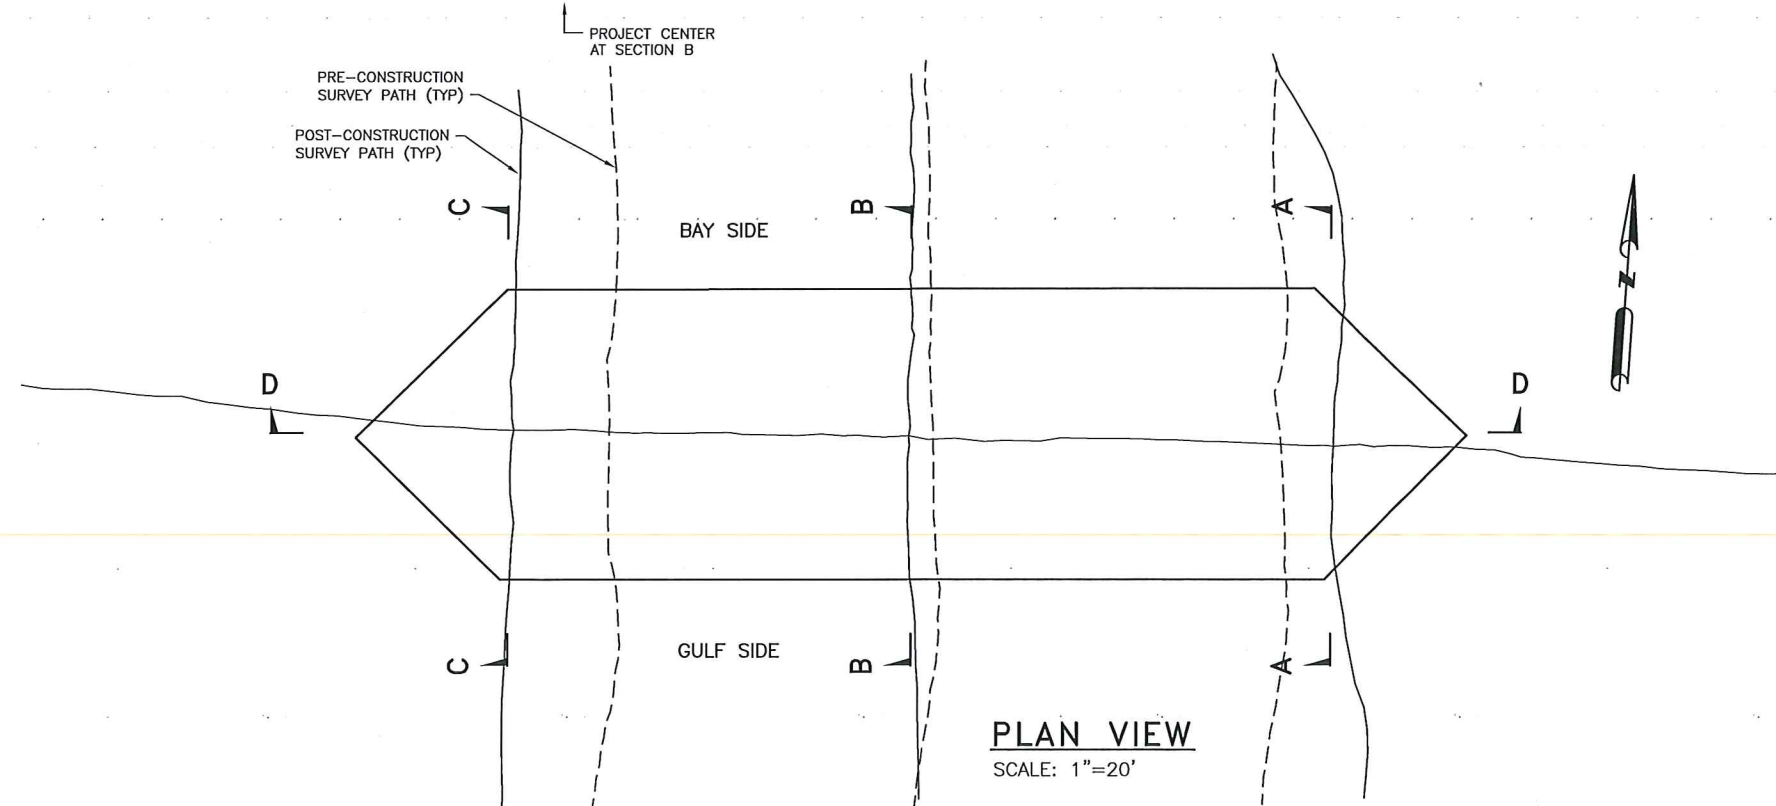

LEGEND:	
	DENOTES POST-CONSTRUCTION SURVEY
	DENOTES PRE-CONSTRUCTION SURVEY



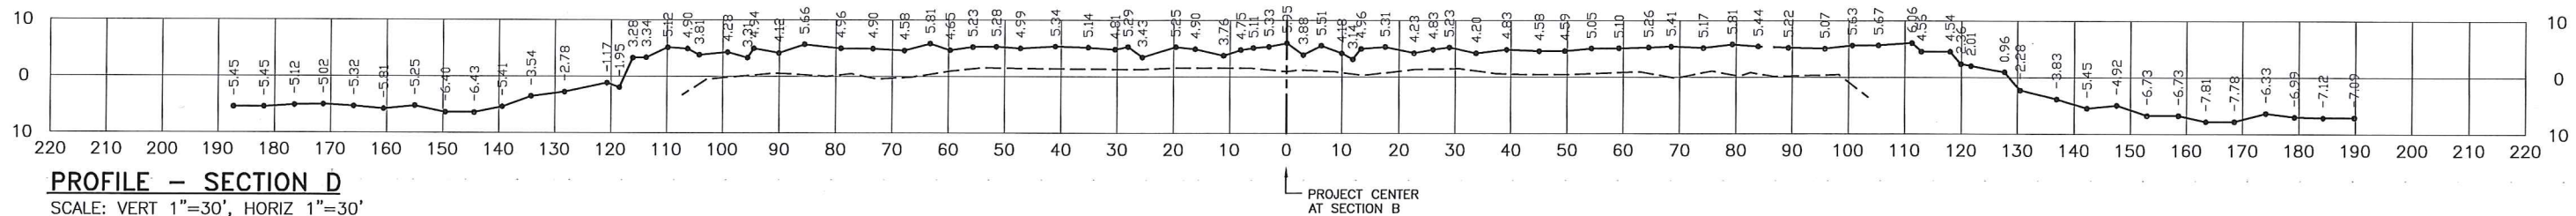
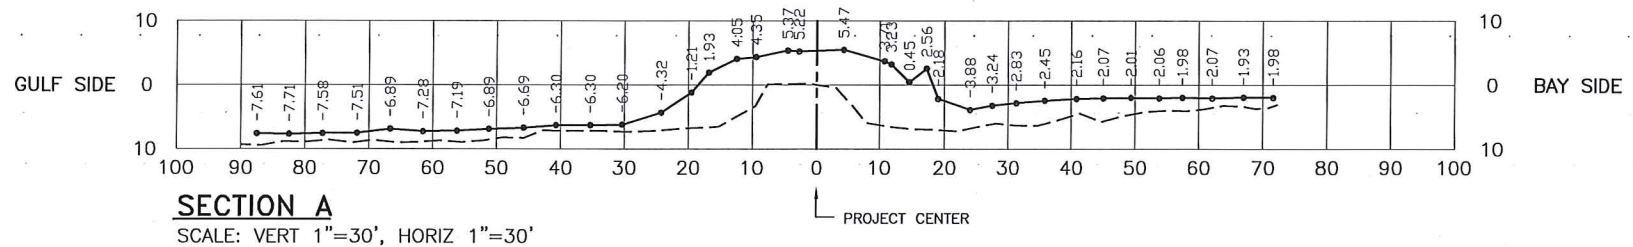
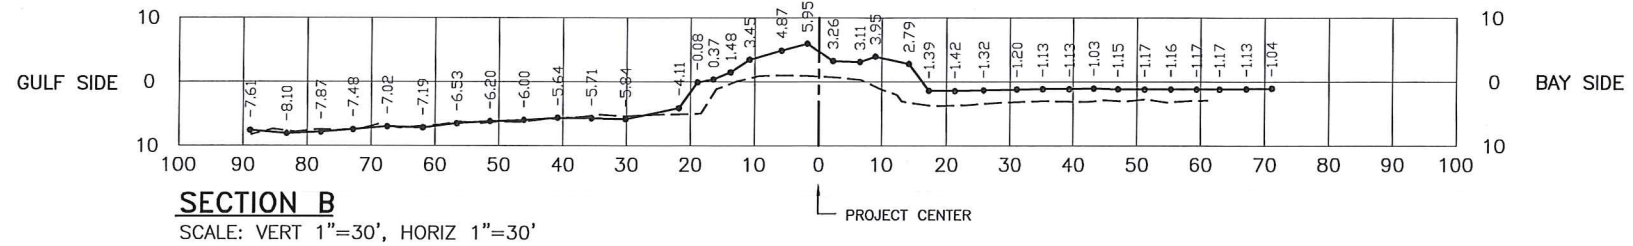
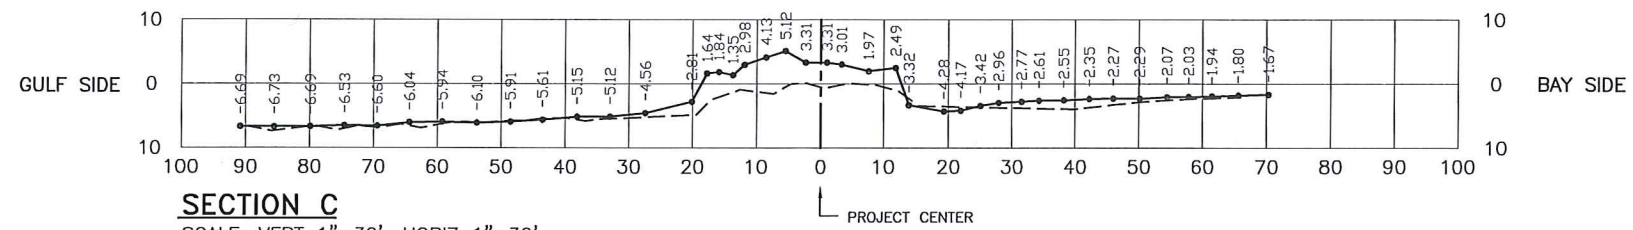


SURVEYED BY:
FRANCIS FORTIER, P.L.S. 4769
3091 HIGHWAY 104
OPELOUSAS, LOUISIANA 70570
PHONE: (337) 278-7204

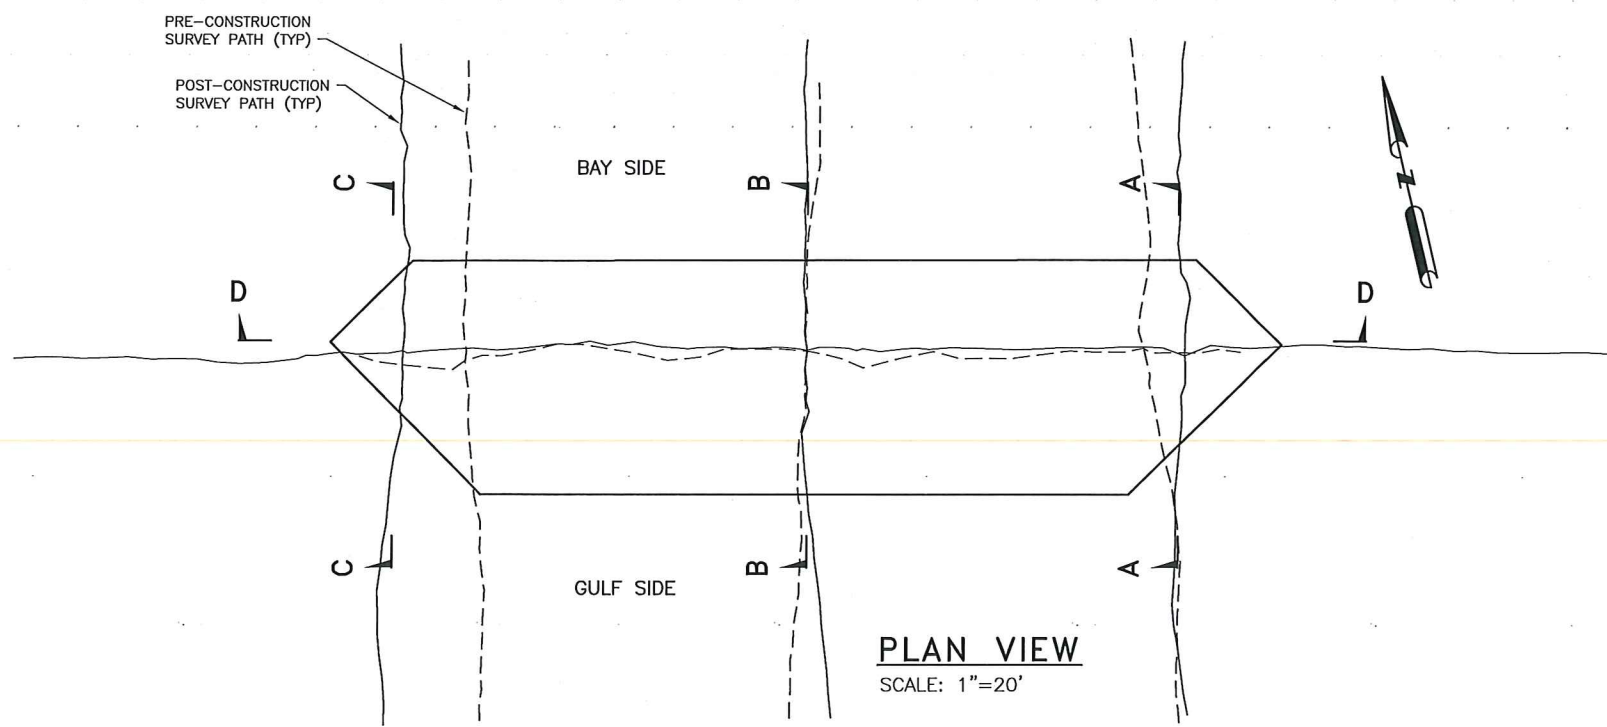

**RACCOON ISLAND
BREAKWATER REHABILITATION PROJECT
TERREBONNE PARISH, LOUISIANA
BREAKWATER 4
PLAN AND SECTIONS**






LEGEND:	
	DENOTES POST-CONSTRUCTION SURVEY
	DENOTES PRE-CONSTRUCTION SURVEY

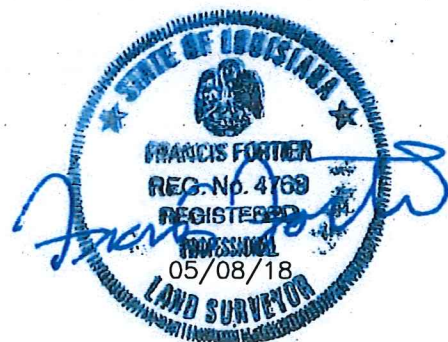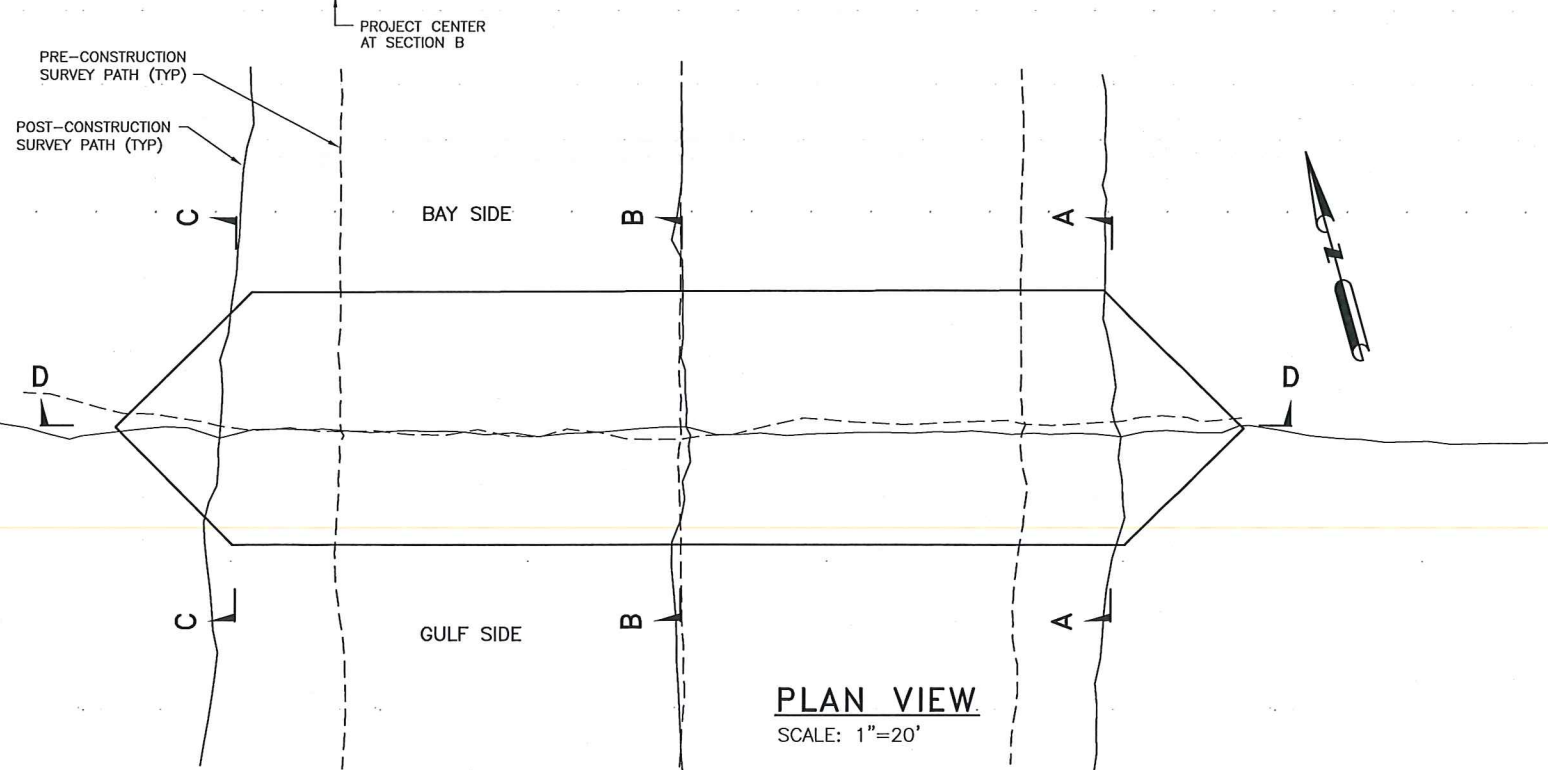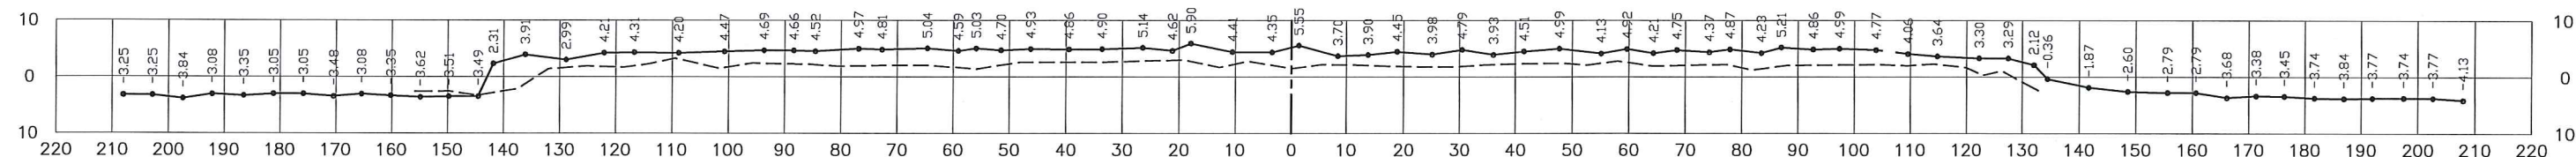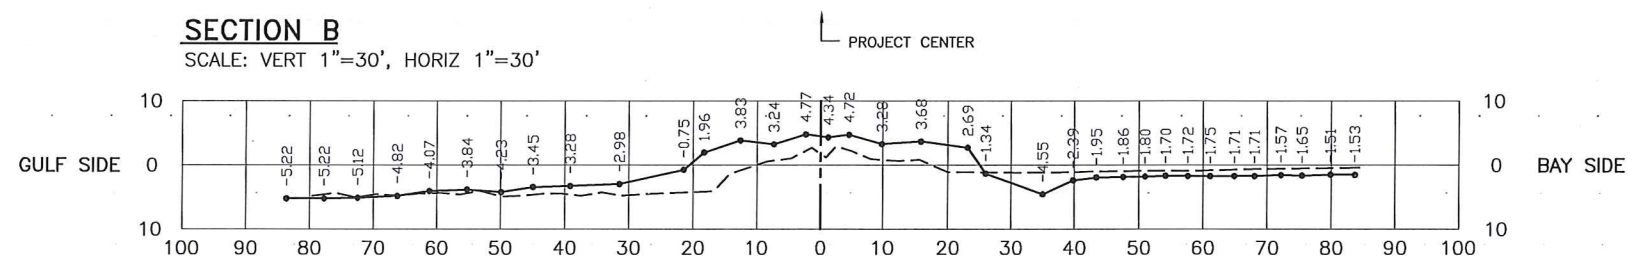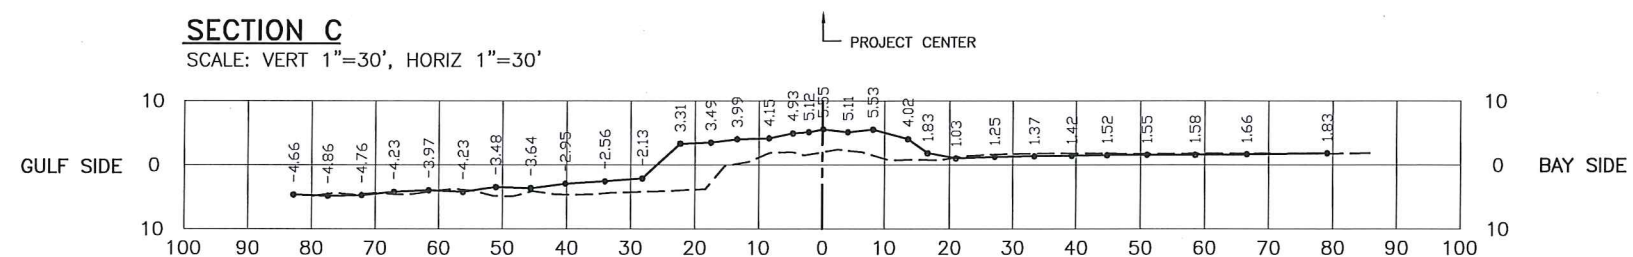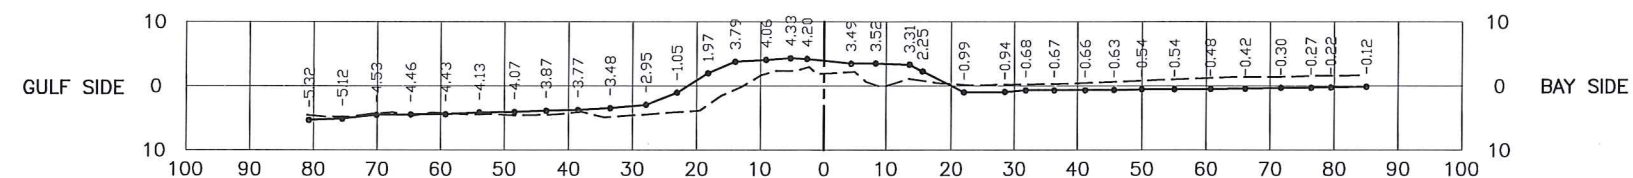


SURVEYED BY:
FRANCIS FORTIER, P.L.S. 4769
3091 HIGHWAY 104
OPELOUSAS, LOUISIANA 70570
PHONE: (337) 278-7204

**RACCOON ISLAND
BREAKWATER REHABILITATION PROJECT
TERREBONNE PARISH, LOUISIANA
BREAKWATER 5
PLAN AND SECTIONS**

LEGEND:	
	DENOTES POST-CONSTRUCTION SURVEY
	DENOTES PRE-CONSTRUCTION SURVEY

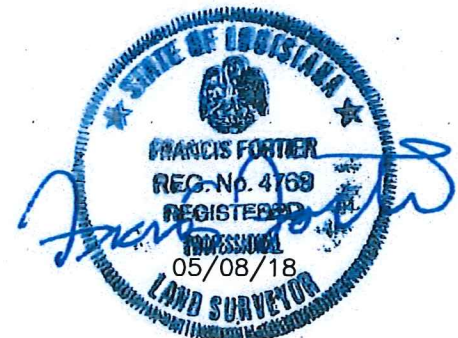
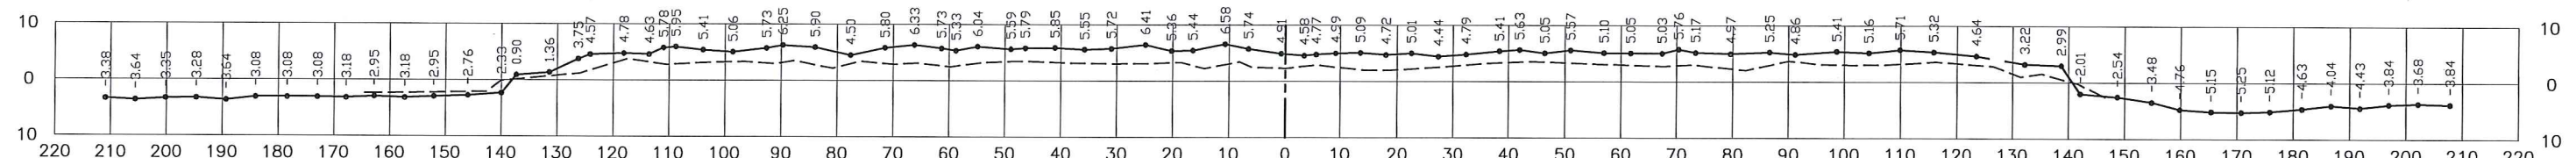
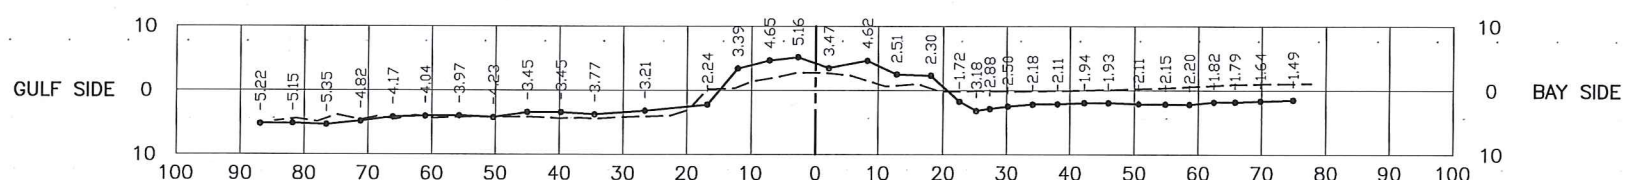
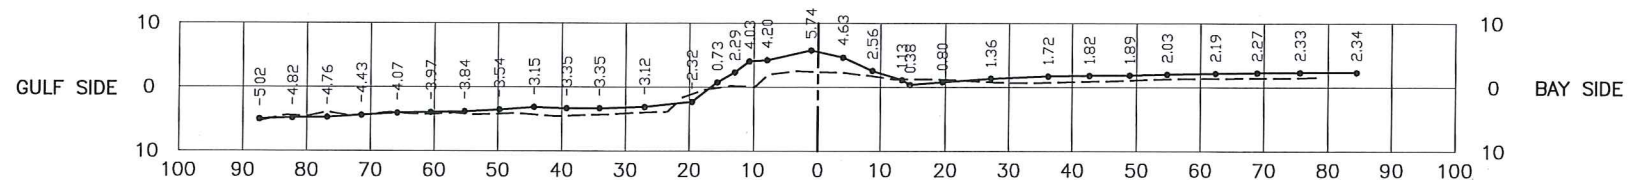
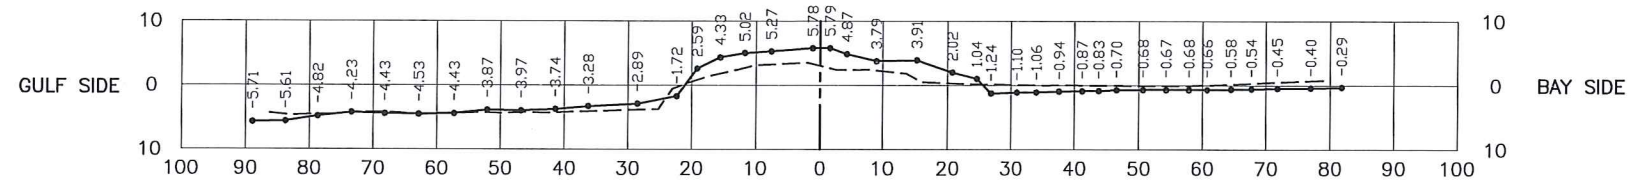


SURVEYED BY:
FRANCIS FORTIER, P.L.S. 4769
3091 HIGHWAY 104
OPELOUSAS, LOUISIANA 70570
PHONE: (337) 278-7204

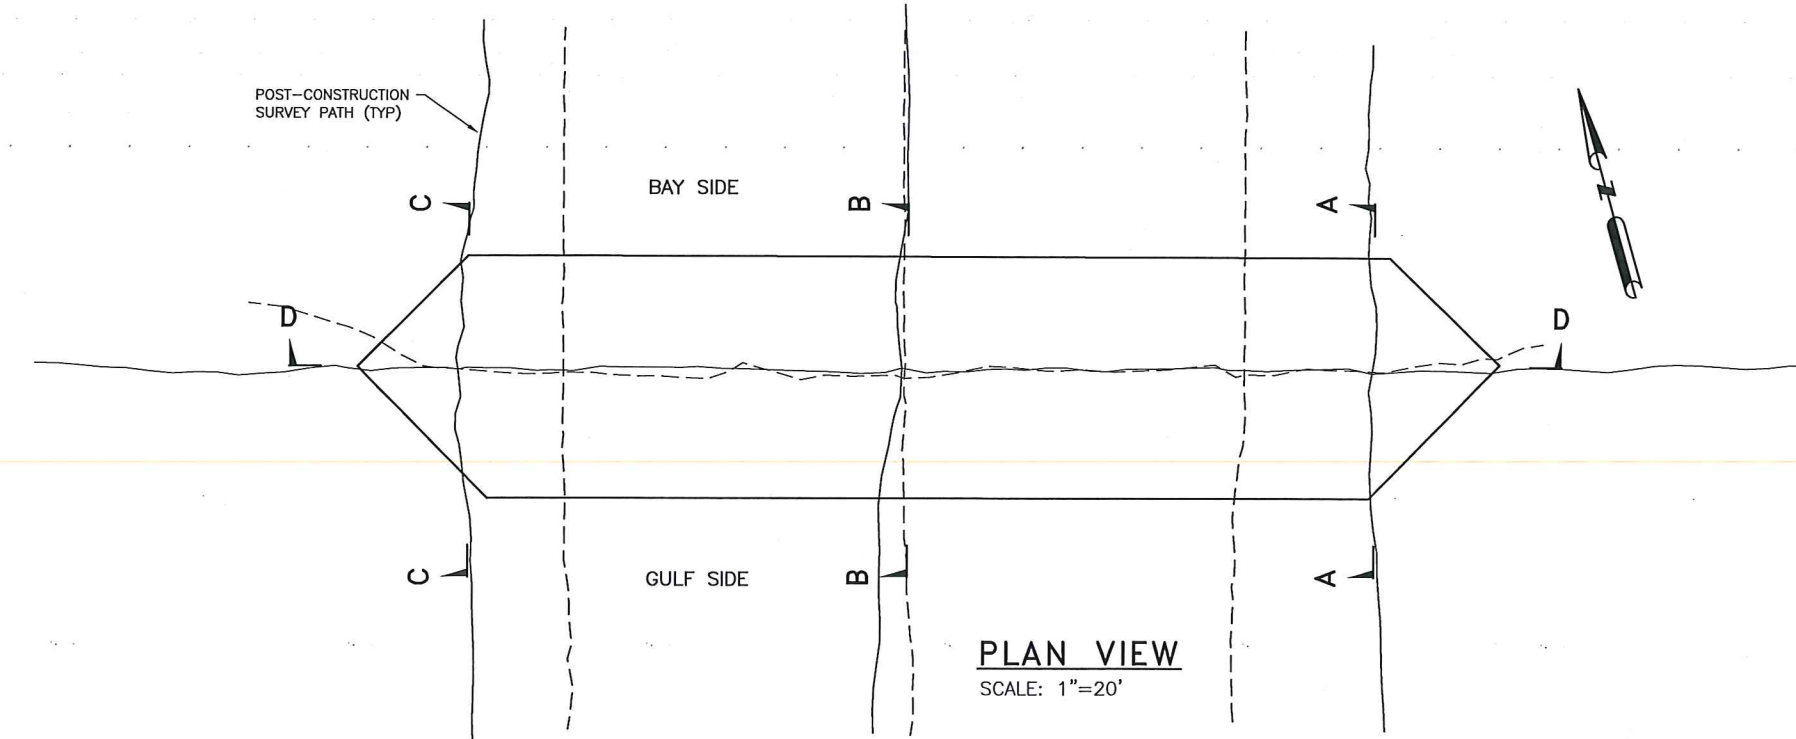


**RACCOON ISLAND
BREAKWATER REHABILITATION PROJECT
TERREBONNE PARISH, LOUISIANA**
BREAKWATER 6
PLAN AND SECTIONS

LEGEND:	
	DENOTES POST-CONSTRUCTION SURVEY
	DENOTES PRE-CONSTRUCTION SURVEY

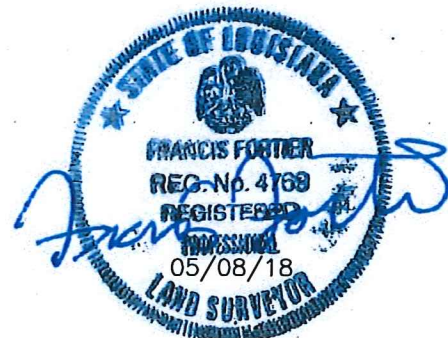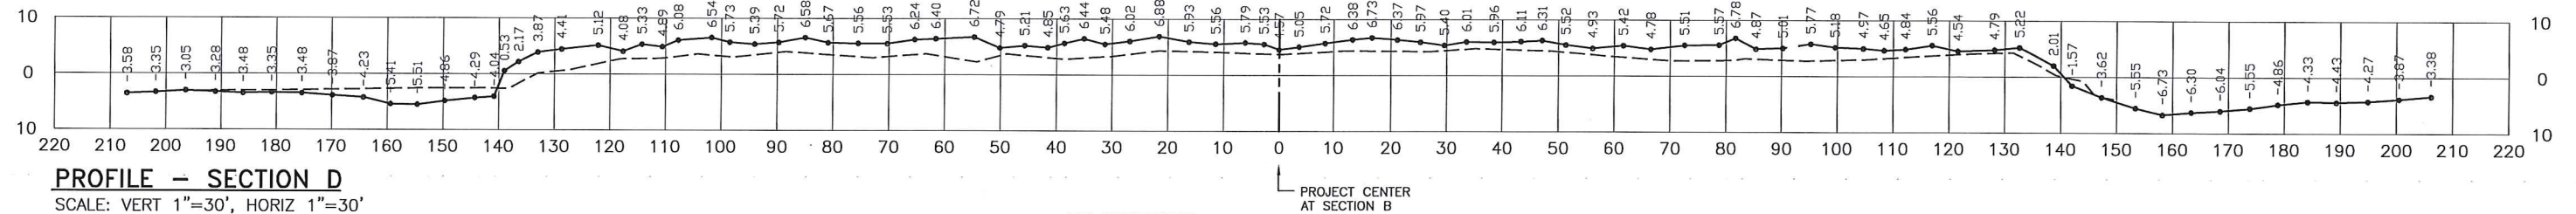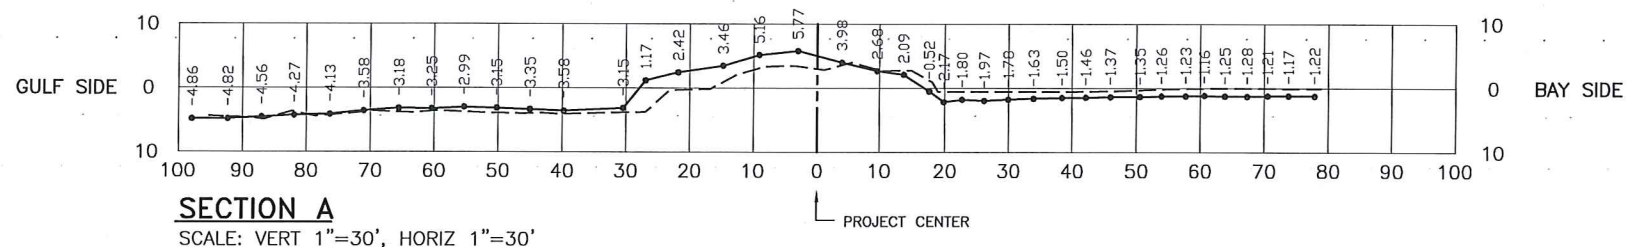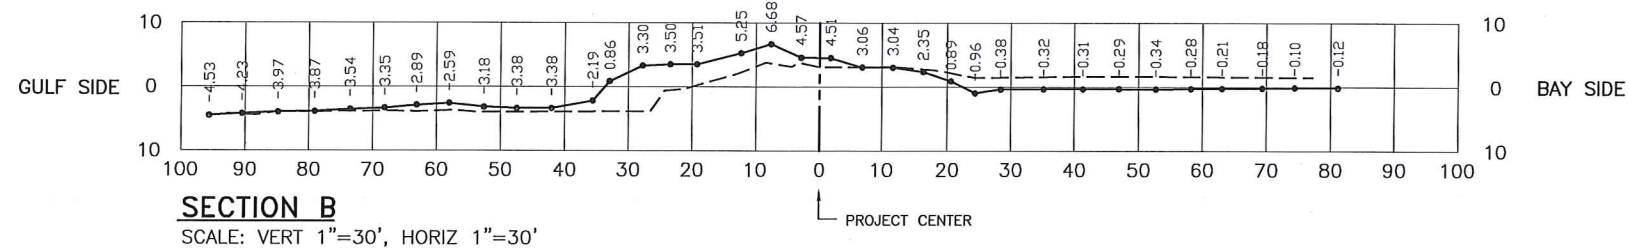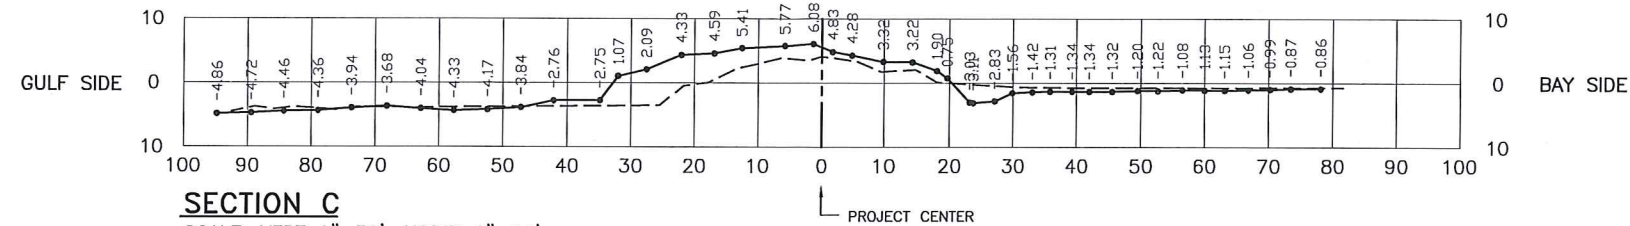


SURVEYED BY:
FRANCIS FORTIER, P.L.S. 4769
3091 HIGHWAY 104
OPELOUSAS, LOUISIANA 70570
PHONE: (337) 278-7204


**RACCOON ISLAND
BREAKWATER REHABILITATION PROJECT
TERREBONNE PARISH, LOUISIANA**
BREAKWATER 7
PLAN AND SECTIONS

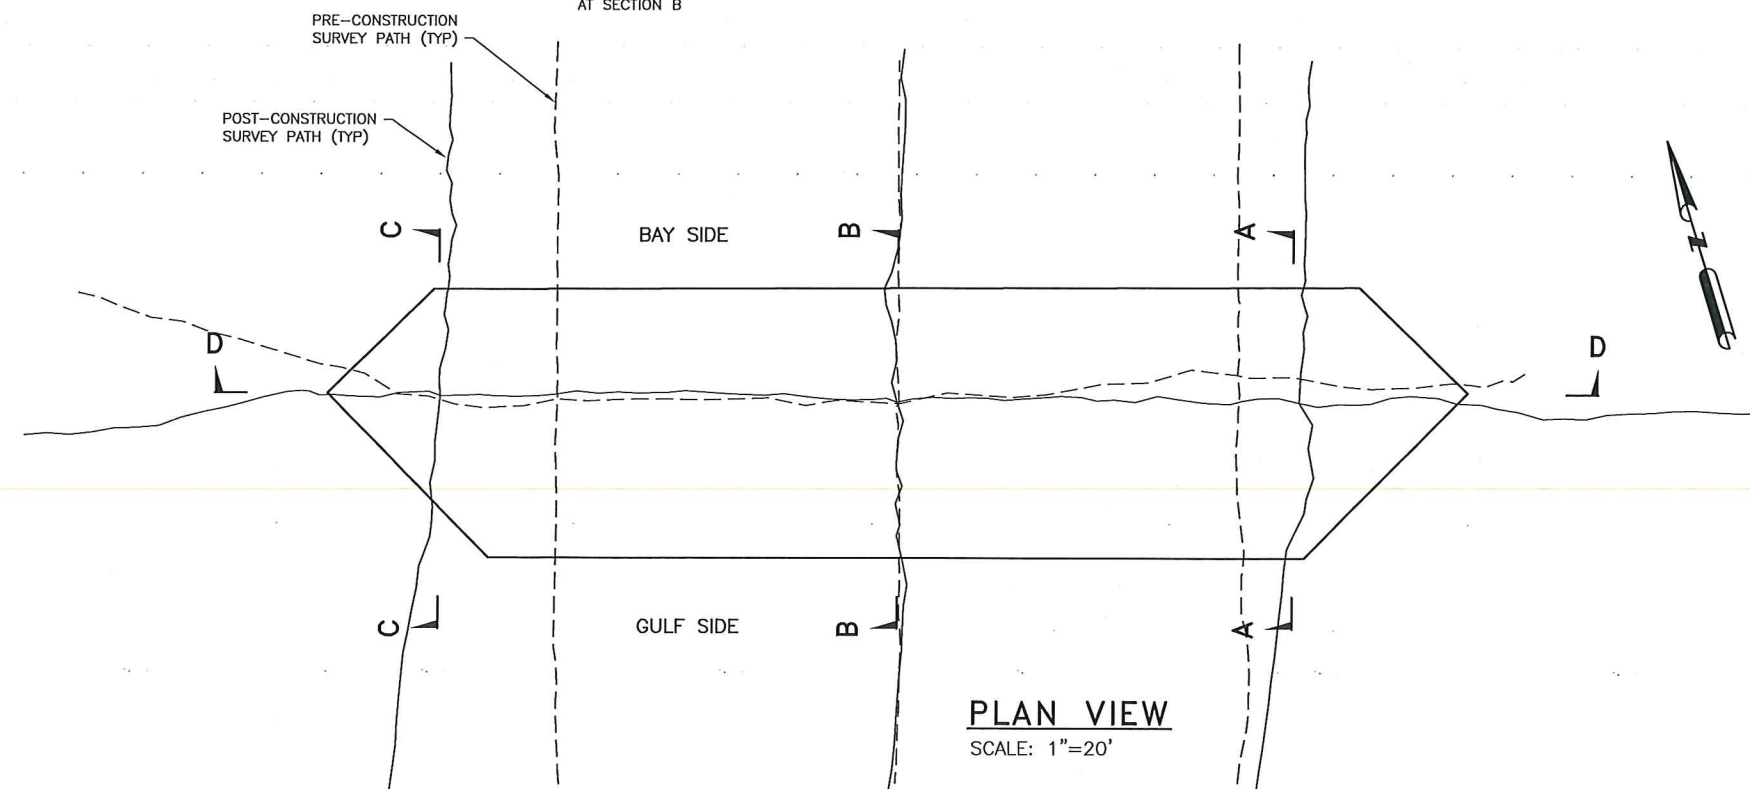

LEGEND:	
	DENOTES POST-CONSTRUCTION SURVEY
	DENOTES PRE-CONSTRUCTION SURVEY

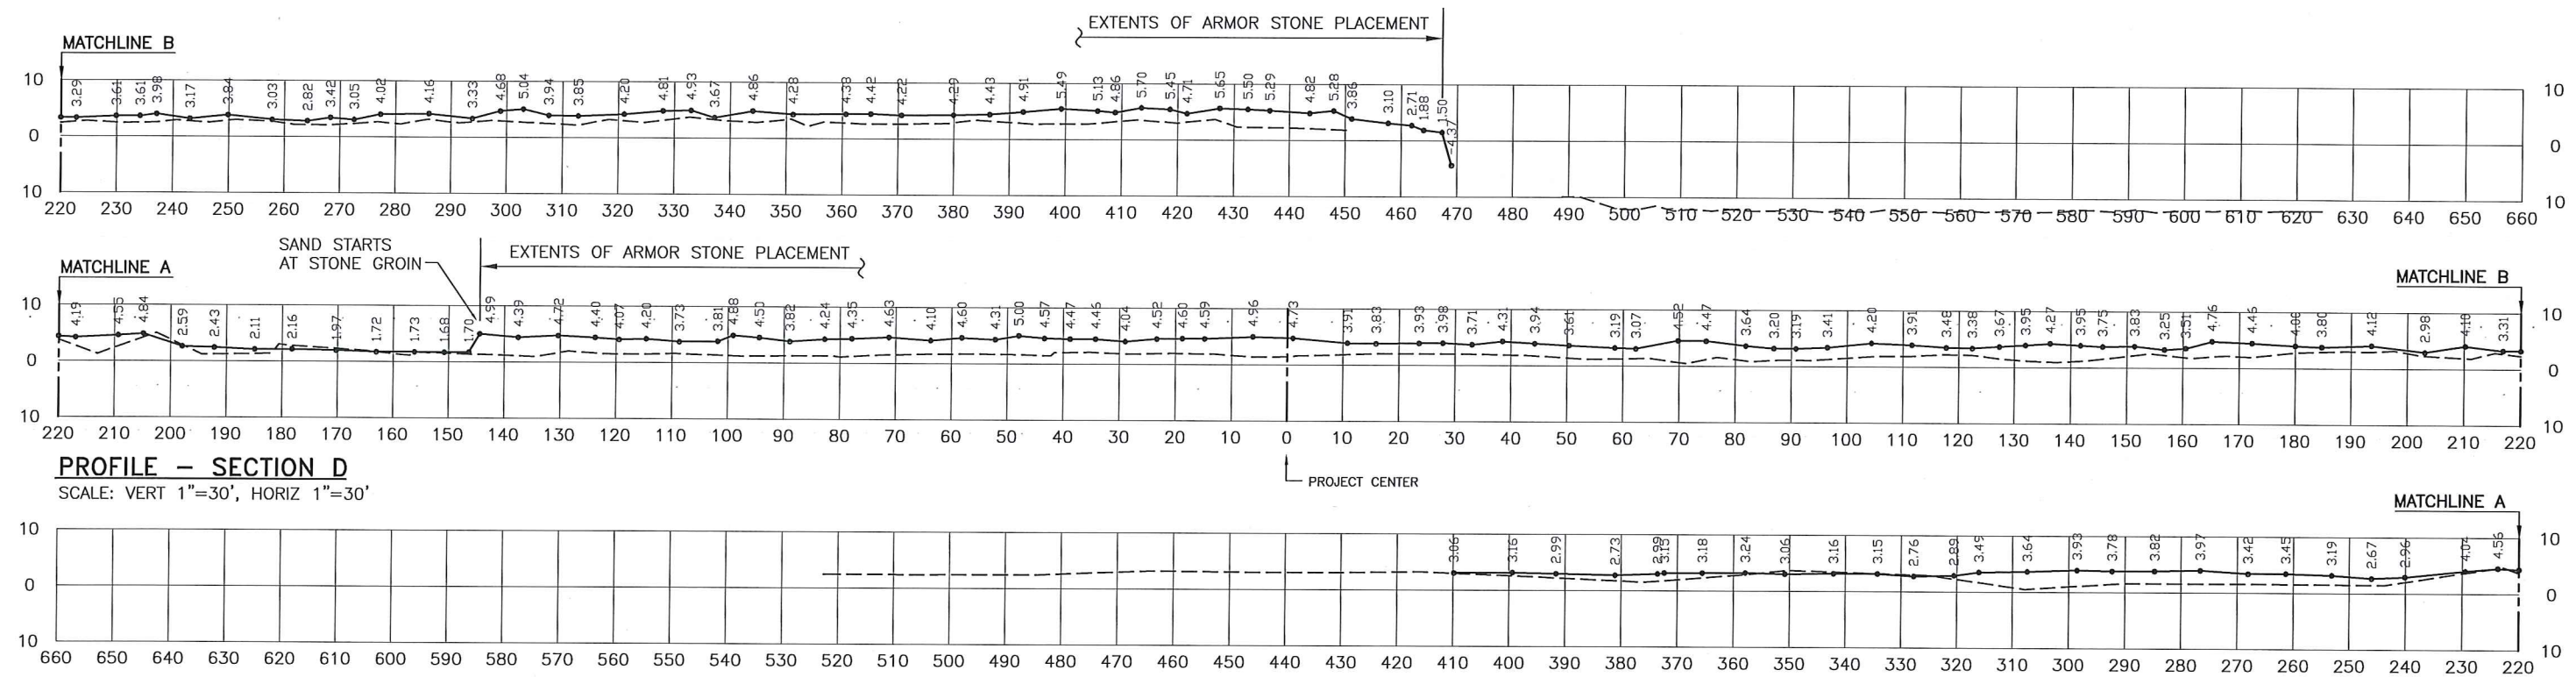

SURVEYED BY:
FRANCIS FORTIER, P.L.S. 4769
3091 HIGHWAY 104
OPELOUSAS, LOUISIANA 70570
PHONE: (337) 278-7204

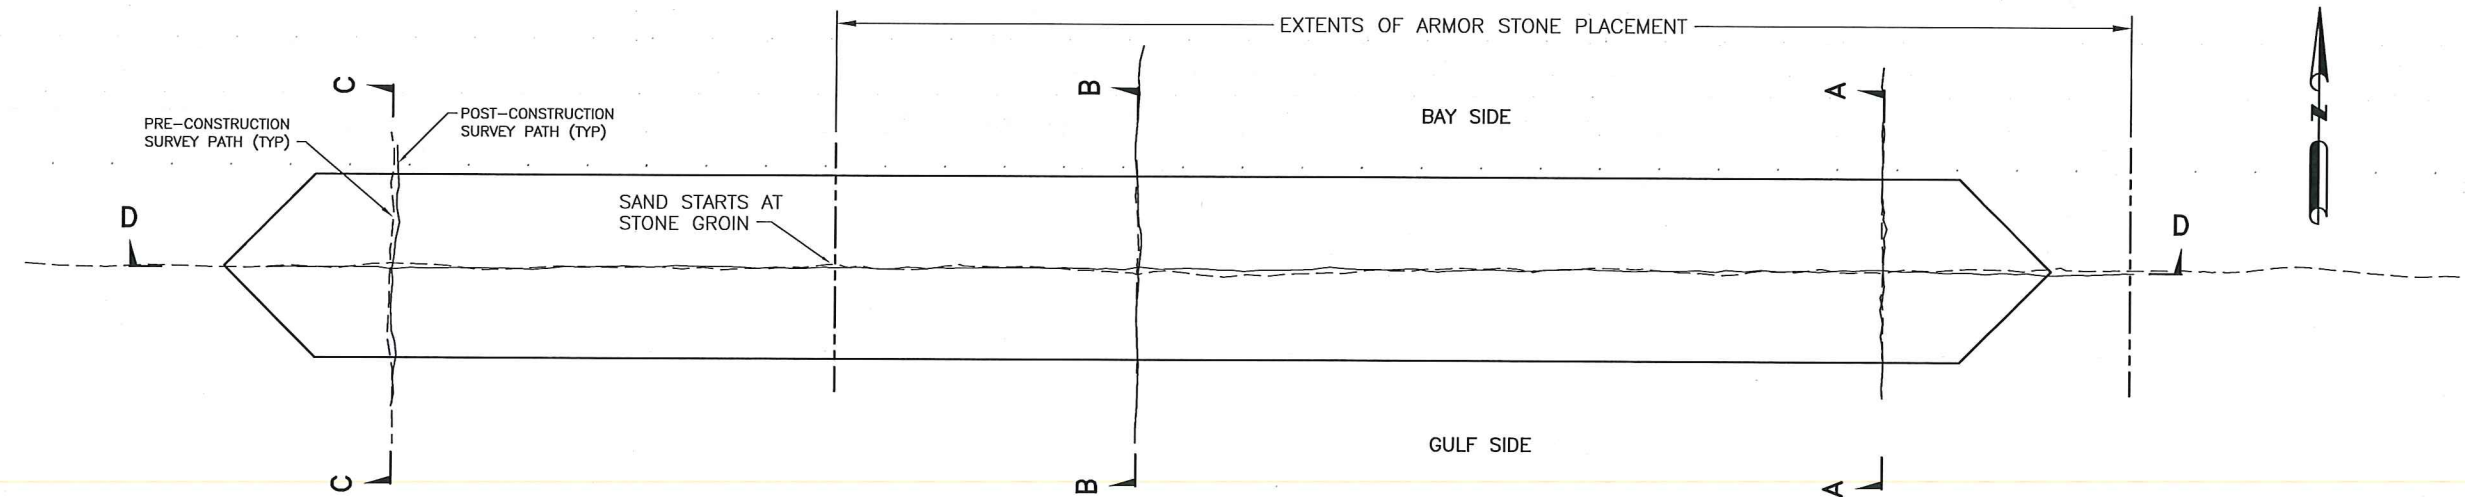

PLAN VIEW
SCALE: 1"=10'

**RACCOON ISLAND
BREAKWATER REHABILITATION PROJECT
TERREBONNE PARISH, LOUISIANA**


EAST GROIN
PLAN AND SECTIONS
SHT 1 OF 2



SURVEYED BY:
FRANCIS FORTIER, P.L.S. 4769
3091 HIGHWAY 104
OPELOUSAS, LOUISIANA 70570
PHONE: (337) 278-7204

**RACCOON ISLAND
BREAKWATER REHABILITATION PROJECT
TERREBONNE PARISH, LOUISIANA**

EAST GROIN
PLAN AND SECTIONS
SHT 2 OF 2

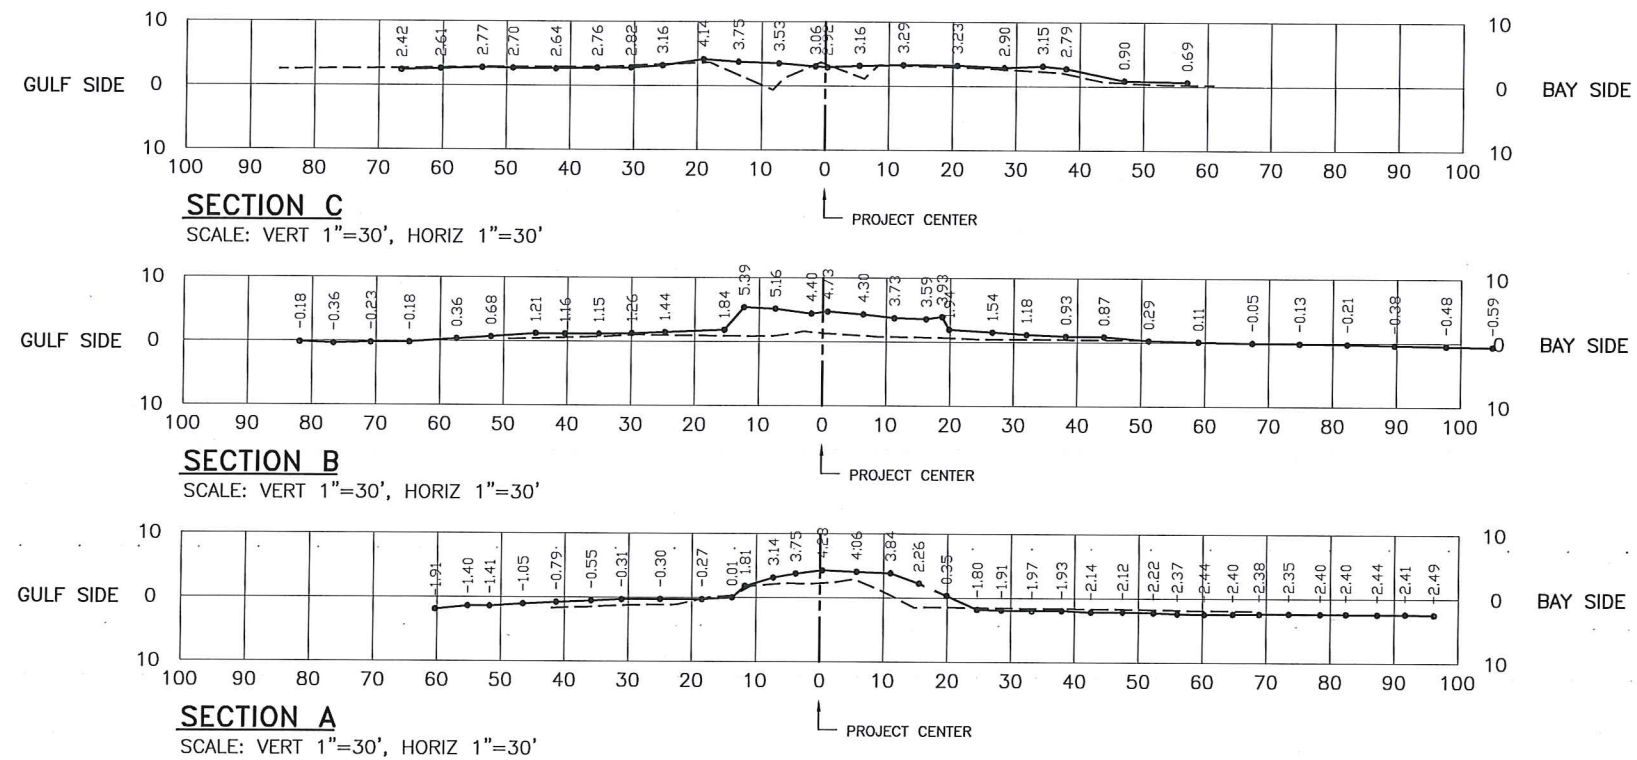

LEGEND:	
	DENOTES POST-CONSTRUCTION SURVEY
	DENOTES PRE-CONSTRUCTION SURVEY

