

Survey Report

Grande Cheniere Marsh & Ridge Restoration
Project BA-173
Plaquemines Parish, LA

For:



State of Louisiana
Coastal Protection and Restoration Authority
450 Laurel Street
Baton Rouge, Louisiana 70801

By:



2472 Sunset Dr. / Grenada, MS 38901
662.226.5166

July 9, 2015

Table of Contents

Section 1: General Project Description	Page 3
Section 2: Vicinity Map	Page 4
Section 3: Control Establishment	Page 5
Sub-Section A: Staff Gages	Page 5
Sub-Section B: Benchmark Forms	Page 7
Section 4: Data Collection	Page 13
Sub-Section A: Average Marsh Elevation Sites	Page 13
Sub-Section B: Magnetometer Anomaly Data	Page 14
Section 5: Data Processing	Page 15
Section 6: Survey Drawings	Page 16
Section 7: Field Notes	Page 30

Section 1: General Project Description

Client: LA Coastal Protection and Restoration Authority

Project: Bayou Grande Cheniere Marsh and Ridge Restoration (BA-173)

Location: Bayou Grande Cheniere, West Pointe a La Hache, Louisiana


Before going to the field, a general survey plan was adopted in the office based upon the Scope of Work and prior planning during project negotiations. After establishing the most effective and efficient schedule of operations, field crews were given their assignments. All provided data, was given to the field supervisor and field crews.

EMC, Inc. (EMC) conducted a hydrographic, magnetometer and topographic survey during April through June 2015 to collect existing marsh elevations, bottom elevations for open water areas and attempt to locate any existing pipelines and/or obstructions in the area. An average marsh elevation survey was also performed at five (5) marsh elevation sites as determined by CPRA.

All datasets were collected, processed and submitted in NAD83 State Plane Louisiana South zone (1702) using U.S. Survey feet. Vertical data is referenced to NAVD88 utilizing Geoid 2012A holding control values based on the 2006.81 epoch as specified in the Scope of Work.

Control coordinates were provided to survey crews. Field crews were assigned specific tasks to avoid omissions and errors.

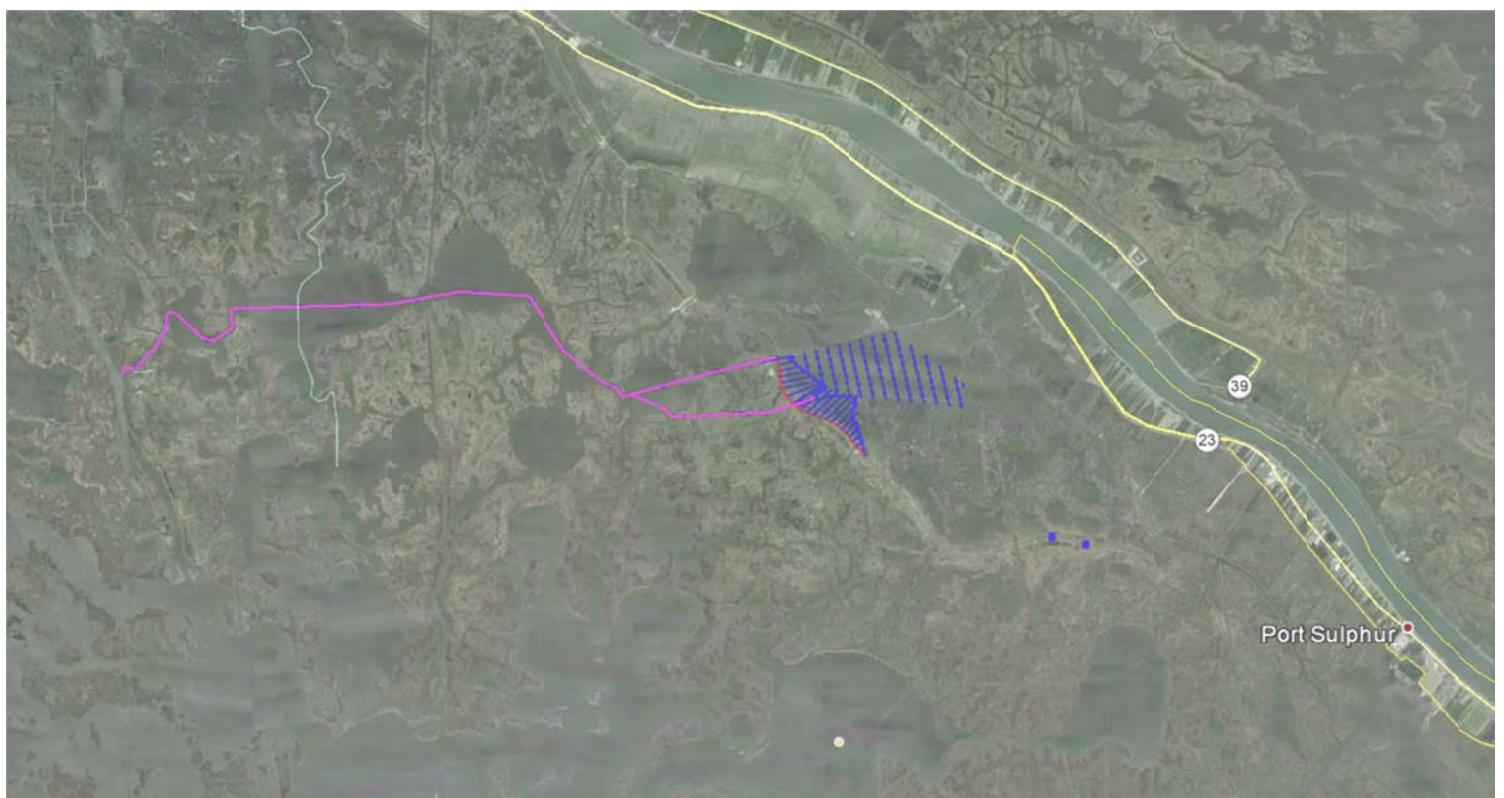Section 2: Vicinity Map



Section 3: Control Establishment

Positions for the survey control are from published existing control marks which were provided by CPRA and are listed below. A Static GPS network was created from the existing control and included one other existing control point along with two (2) new iron rods set for this survey. All were used to establish control positions for the project.

RTK GPS was used to verify gage elevations used to determine the water surface correction to be applied to the hydrographic data.

Once the control data was in the office the data was converted from raw GPS format to Rinex file format using the Trimble Business Center utility Convert to Rinex. This Rinex file was then processed by NGS and their OPUS solution was as a check against the processed network solutions.

Horizontal coordinates are referenced to NAD83 State Plane Louisiana South (1702) Zone in U.S. Survey Feet and the elevations are referenced to the North American Vertical Datum of 1988 (NAVD88) using Geoid 2012A holding control values based on the 2006.81 epoch as specified in the Scope of Work. The control marks are listed below:

Provided Control:

876 1602 C TIDAL 1985	(survey disk) X= 3741375.10	Y= 388177.25	Elev. = 0.51
C 195 1964	(survey disk) X= 3780155.39	Y= 380462.01	Elev. = 1.09

Additional Control:

MVN-68 2014	(flange encased steel rod)
IR GBC-1	(3/4" x 12' rebar projecting 0.2' above ground)
IR GBC-2	(3/4" x 12' rebar projecting 0.3' above ground)

The GPS Network Reports are presented in "Section 5: Data Processing" of this document along with the Monument Data Sheets which will provide more detail for the control points used.

Sub-Section A: Staff Gages

The Staff Gage of the CRMS0260-H01 CRMS station and a newly set staff gage were used to obtain the water surface elevation each day. The gage was read each day before surveying began and then again after surveying ended for the day. This gage data was used for the tide correction for the hydrographic data collected in the Marsh Creation Areas.

At the CRMS0260-H01 CRMS station, the survey crew collected the location of the post that the staff gage was affixed to: X= 3751126.34 Y= 379176.45. Three elevations were collected at the gage: top of the post (6.44), TBM Nail in the post



(3.38) and the 3.00 mark on the gage (2.04). Daily gage readings were corrected by -0.96 before the tide corrections were applied. The survey crew could not locate a "Reset Rod" at the location shown in the scope of work. The existing gage was approximately six feet from the provided position and the entire area surrounding the gage was inundated with water.

Upon receipt of a requested location, a new temporary staff gage was set near the North end of line T6. The gage is a 4" x 4" post set at the West end of a point of marsh grass on the South side of a canal. The gage is approximately 338 feet West of the control point IR GBC-1. Gage coordinate location is: X= 3759002.17 Y= 385233.35, with the top of the post elevation being 6.10'. A 16 penny nail was driven into the post at the 4 foot mark. The zero of the gage is 0.02'. The gage was set on May 11, 2015 and the reading at 3:30pm was 0.9. This gage was utilized along with the existing staff gage for the remainder of the hydrographic soundings on the project. See below for staff gage readings for all hydrographic data collection.



CRMS0260-H01 CRMS Station Tide Gage

	Reading	Adjust	Actual	Time
4/8/2015	1.18	-0.96	0.22	9:36
	1.3	-0.96	0.34	12:05
	1.45	-0.96	0.49	14:23
4/9/2015	Reading	Adjust	Actual	Time
	1.56	-0.96	0.6	12:49
4/10/2015	1.66	-0.96	0.7	15:00
	Reading	Adjust	Actual	Time
	1	-0.96	0.04	8:30
4/11/2015	1.4	-0.96	0.44	14:00
	Reading	Adjust	Actual	Time
	0.6	-0.96	-0.36	8:00
5/26/2015	0.75	-0.96	-0.21	11:10
	1	-0.96	0.04	14:35
	Reading	Adjust	Actual	Time
5/27/2015	1.57	-0.96	0.61	12:48
	1.5	-0.96	0.54	15:13
5/28/2015	Reading	Adjust	Actual	Time
	1.55	-0.96	0.59	8:00
	1.78	-0.96	0.82	11:56
Reading	Adjust	Actual	Time	
1.7	-0.96	0.74	8:13	
1.8	-0.96	0.84	11:55	
1.78	-0.96	0.82	13:10	

New Temporary Staff Gage

Reading	Adjust	Actual	Time
0.48	0.02	0.5	11:45
0.5	0.02	0.52	15:10
Reading	Adjust	Actual	Time
0.62	0.02	0.64	7:47
0.8	0.02	0.82	11:56
Reading	Adjust	Actual	Time
0.7	0.02	0.72	7:40
0.8	0.02	0.82	13:45

Sub-Section B: Benchmark Forms



VICINITY MAP

Scale: NTS

Reproduced from Google Earth

Station Name: 876 1602C TIDAL

Monument Location: TO REACH THE STATION FROM MYRTLE GROVE GO SOUTHEAST ON STATE HIGHWAY 23 TO MILE MARKER 45.7. TURN RIGHT AND GO EAST FOR 8 KM (4.95 MI) ON LAKE JUDGE PEREZ ROAD TO A FIRE STATION ON THE RIGHT AND THE BENCH MARK ON THE LEFT. MARK IS A STANDARD NOS DISK CRIMPED TO A STEEL ROD DRIVEN 22 METERS (72 FT) INTO THE GROUND AND ENCASED IN A 5-INCH PVC PIPE SURROUNDED BY CONCRETE. 29 METERS (95.2 FT) NORTH FROM THE NORTH CORNER OF THE FIRE STATION, 21.8 METERS (71.4 FT) EAST FROM A POWER POLE AND 0.5 METERS (1.8 FT) SOUTHWEST FROM A WITNESS POST.

Monument Description:

NGS TIDAL STATION

Stamping: 1602C 1985

Survey Date: April 9, 2015

Monument Established By:

NOS

NAD 83 (2011) Epoch 2010.00 Geodetic Position

Lat. 29°33'33.83236"N

Long. 89°53'05.03561"W

NAD 83 (2011) Epoch 2010.00 Datum LSZ (1702) U.S. Feet

N= 388177.250

E= 3741375.100

NAVD88 (2011) Epoch 2006.81 VTDP Geoid 12A Elev.

Elevation = 0.51 usft (0.155 mtrs.)

Ellipsoid Height = -80.562 usft (24.555 mtrs.)

Geoid Height = 0.00 usft (0.000 mtrs.)



Adjusted Position Established by EMC, Inc. for the Coastal Protection and Restoration Authority of Louisiana



VICINITY MAP Scale: NTS

Reproduced from Google Earth

Station Name: C 195

Monument Location: THE STATION IS ON THE PROTECTED SIDE OF THE MISSISSIPPI RIVER LEVEE. FROM THE INTERSECTION OF HWY 23 AND POINTE LA HACHE FERRY RD GO APPROXIMATELY 0.9 MILES SOUTH EAST TO THE INTERSECTION OF HWY 23 AND DIAMOND RD ON THE LEFT, TURN ONTO DIAMOND RD AND PROCEED APPROXIMATELY 2.2 MILES TO THE MARK ON THE RIGHT.

MARK IS 26 FEET SOUTHWEST OF THE CENTER LINE OF DIAMOND RD, 27 FEET NORTH OF A POWER POLE AND 93 FEET NORTHWEST OF THE CENTER LINE OF NORRIS LN. MARK IS A BRONZE DISK SET IN THE TOP OF A CONCRETE POST WHICH PROJECTS 2 INCHES.

Monument Description:

NGS Monument



Stamping: C 195 1964

Survey Date: April 9, 2015

Monument Established By:

USCGS

NAD 83 (2011) Epoch 2010.00 Geodetic Position

Lat. 29°32'12.40356"N

Long. 89°45'47.15528"W

NAD 83 (2011) Epoch 2010.00 Datum LSZ (1702) U.S. Feet

N= 380462.010

E= 3780155.390

NAVD88 (2011) Epoch 2006.81 VTDP Geoid 12A Elev.

Elevation = 1.09 usft (0.332 mtrs.)

Ellipsoid Height = -79.404 usft (24.202 mtrs.)

Geoid Height = 0.00 usft (0.000 mtrs.)



Adjusted Position Established by EMC, Inc. for the Coastal Protection and Restoration Authority of Louisiana



VICINITY MAP Scale: NTS

Reproduced from Google Earth

Station Name: MVN-68

Monument Location: TO REACH THE MARK FROM THE INTERSECTION OF THE SOUTHWEST EDGE OF THE SOUTH BOUND LANE OF HWY 23 AND THE ACCESS ROAD FOR POINTE a La HACHE FERRY, PROCEED NORTHWEST ALONG EDGE OF SAID ROAD FOR 1450 FT TO MARK ON THE LEFT. MARK IS 24 FT SOUTHWEST OF THE SOUTHWEST EDGE OF HWY 23, 59.8 FT EAST OF A POWER POLE, 68 FT NORTHEAST OF A LARGE ALUMINUM POWER POLE.

Monument Description:

Stainless steel rod in sleeve (10FT+ or 3.048M+)



Stamping: MVN-68 2014

Survey Date: April 9, 2015

Monument Established By:

EMC, Inc. for USCOE



NAD 83 (2011) Epoch 2010.00 Geodetic Position

Lat. 29°34'09.92604"N

Long. 89°48'07.96110"W

NAD 83 (2011) Epoch 2010.00 Datum LSZ (1702) U.S. Feet

N= 392163.970

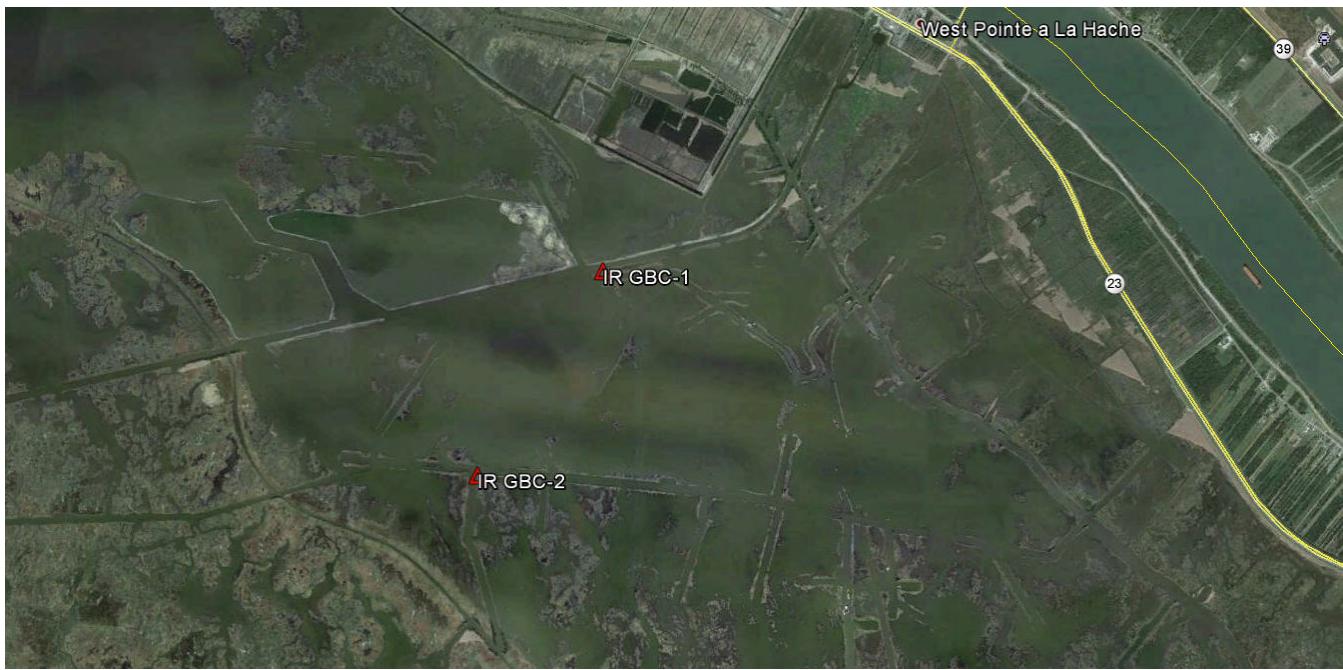
E= 3767559.987

NAVD88 (2011) Epoch 2006.81 VTDP Geoid 12A Elev.

Elevation = 1.26 usft (0.383 mtrs.)

Ellipsoid Height = -79.723 usft (24.230 mtrs.)

Adjusted Position Established by EMC, Inc. for the Coastal Protection and Restoration Authority of Louisiana



VICINITY MAP Scale: NTS

Reproduced from Google Earth

Station Name: IR GBC-1

Monument Location: MARK IS IN THE MARSH WEST OF POINTE A LA HACHE, LOUISIANA. MARK IS APPROXIMATELY 10,000 FEET WESTERLY OF BOAT RAMP, 312 FEET EAST OF POINT OF MARSH GRASS AND 35 FEET BACK OF SOUTH TOP BANK OF CANAL.

Monument Description:

Rebar 3/4" x 12' projecting 0.2'

Stamping: NONE

Survey Date: April 9, 2015

Monument Established By:

EMC, Inc. for USCOE



NAD 83 (2011) Epoch 2010.00 Geodetic Position

Lat. 29°33'02.96405"N

Long. 89°49'42.10696"W



NAD 83 (2011) Epoch 2010.00 Datum LSZ (1702) U.S. Feet

N= 385290.369

E= 3759335.991

NAVD88 (2011) Epoch 2006.81 VTDP Geoid 12A Elev.

Elevation = 0.96 usft (0.292 mtrs.)

Ellipsoid Height = -79.870 usft (24.344 mtrs.)

Adjusted Position Established by EMC, Inc. for the Coastal Protection and Restoration Authority of Louisiana



VICINITY MAP

Scale: NTS

Reproduced from Google Earth

Station Name: IR GBC-2

Monument Location: MARK IS IN THE MARSH WEST OF POINTE A LA HACHE, LOUISIANA. MARK IS APPROXIMATELY 17,000 FEET WESTERLY OF BOAT RAMP, 37 FEET BACK OF SOUTH TOP BANK OF CANAL AND 34 FEET EAST OF TOP BANK OF CANAL.

Monument Description:

Rebar 3/4" x 12' projecting 0.3'



Stamping: NONE

Survey Date: April 9, 2015

Monument Established By:

EMC, Inc. for USCOE



NAD 83 (2011) Epoch 2010.00 Geodetic Position

Lat. 29°32'07.10973"N
Long. 89°50'21.53921"W

NAD 83 (2011) Epoch 2010.00 Datum LSZ (1702) U.S. Feet

N= 379603.248
E= 3755927.133

NAVD88 (2011) Epoch 2006.81 VTDP Geoid 12A Elev.

Elevation = 1.32 usft (0.402 mtrs.)
Ellipsoid Height = -79.355 usft (24.187 mtrs.)

Adjusted Position Established by EMC, Inc. for the Coastal Protection and Restoration Authority of Louisiana

Section 4: Data Collection

The surveys were conducted with an array of electronic surveying equipment. First our crew set and recovered control points then ran GPS sessions on the control points within the planned network using Trimble R8 GNSS model 3 GPS systems on fixed two meter tripods.

The crews then utilized an Odom Echotrac single beam hydrographic system using DGPS positioning to gather the bottom elevation data in the open water areas. Tide corrections were collected via readings from existing and set staff gages. All open water areas were collected prior to filling in transect data with conventional survey methods.

RTK/GPS data collection was performed with Trimble R8 base stations and R6 rovers. The RTK survey was based upon control values provided by the GPS control network. Field data came into the office in raw GPS (.dat) files, data collector file format (.dc & .job), field books and GPS Log Sheets that verified the control used. RTK was used to obtain elevation data on all portions of transects that were too shallow for soundings or exposed ground areas.

Magnetometer data was collected using a Geometric 883 within the requested limits in an attempt to horizontally locate pipelines or obstructions within the survey limits. Bar checks and layback lines were taken to calibrate hydrographic equipment. See below for control points used on the project.

Point Name	Northing	Easting	Elevation
8761602C TIDAL	388177.25	3741375.10	0.51
C 195	380462.01	3780155.39	1.09
IR GBC-1	385290.37	3759335.99	0.96
IR GBC-2	379603.25	3755927.13	1.32
MVN-68	392163.97	3767559.99	1.26

Sub-Section A: Average Marsh Elevation Sites

Five (5) marsh elevation sites were selected on-site by CPRA personnel to be used to obtain an "Average Marsh Elevation". The survey crew collected a minimum of twenty elevations at each of the areas specified by the on-site field inspector. The horizontal location of each of the elevations was collected in the manner prescribed by the on-site inspector. Upon the completion of the data processing, the coordinates were averaged for each site and the results are shown below:

Average Marsh Elevation Information

Site #1 Y= 381933.45 X= 3749329.75	Average Elev.= 0.65
Site #2 Y= 379550.42 X= 3750781.81	Average Elev.= 0.54
Site #3 Y= 376941.98 X= 3752647.75	Average Elev.= 0.82
Site #4 Y= 374914.99 X= 3746846.35	Average Elev.= 0.46
Site #5 Y= 380020.02 X= 3747887.20	Average Elev.= 0.49

Sub-Section B: Magnetometer Anomaly Data

The initial magnetometer transect data was post-processed in the office. Targets were reviewed along with conventional data which showed signage and all significant magnetic anomalies were targeted for further investigation. Field crews were tasked with collecting further investigation lines around significant anomalies, noting any features encountered and probing to attempt to locate and identify features if possible. All field information was compiled into the table as shown. The amplitudes shown reflect the peak to peak gamma change at the location of the anomaly. The duration shown reflects the distance along the trackline that the magnetic anomaly exists.

Section 5: Data Processing

The field data was processed utilizing an array of computer programs. The GPS session files were taken into Trimble Business Center version 3.50 software, where the GPS data was processed. Rod heights, point codes and controlling base station coordinates were verified. Upon completion of all checks, the network baselines were processed and a network adjustment was done and corrected coordinates were output in a comma separated file (.csv) along with the network adjustment reports (.pdf). These coordinates were the control values for the job.

Trimble Business Center version 3.50 software was also used to process the topographic RTK/GPS data. Rod heights, point codes and controlling base station coordinates were verified. Upon completion of all checks, a comma separated file (.csv) was exported.

HyPack 2014 hydrographic software was used to process the hydrographic and magnetometer data. The HyPack software is where the hydrographic data was edited for spikes and erroneous soundings. This is also when the tide correction is applied. Edited HyPack files were saved containing the xyz edited data. This data was combined with the topographic RTK data in AutoCAD to produce profiles of each individual topographic transect.

The edited magnetometer data was saved to a northing, easting gamma format comma separated file (.csv). Magnetometer data was reviewed for significant magnetic anomalies. When anomalies were found during processing, subsequent investigation lines were taken in the field and processed to verify that an anomaly was present and an attempt to locate the source of the anomaly was made. In some cases, anomalies were found to be small pieces of metal or wire and were discarded from the investigation list. All significant anomalies are shown on the survey plats, whether or not the source was identifiable.

All exported ACSII data files were combined in AutoCAD Civil 3D 2015 where the plan view map, profiles, and appropriate tabled information were created.

Section 6: Survey Drawings

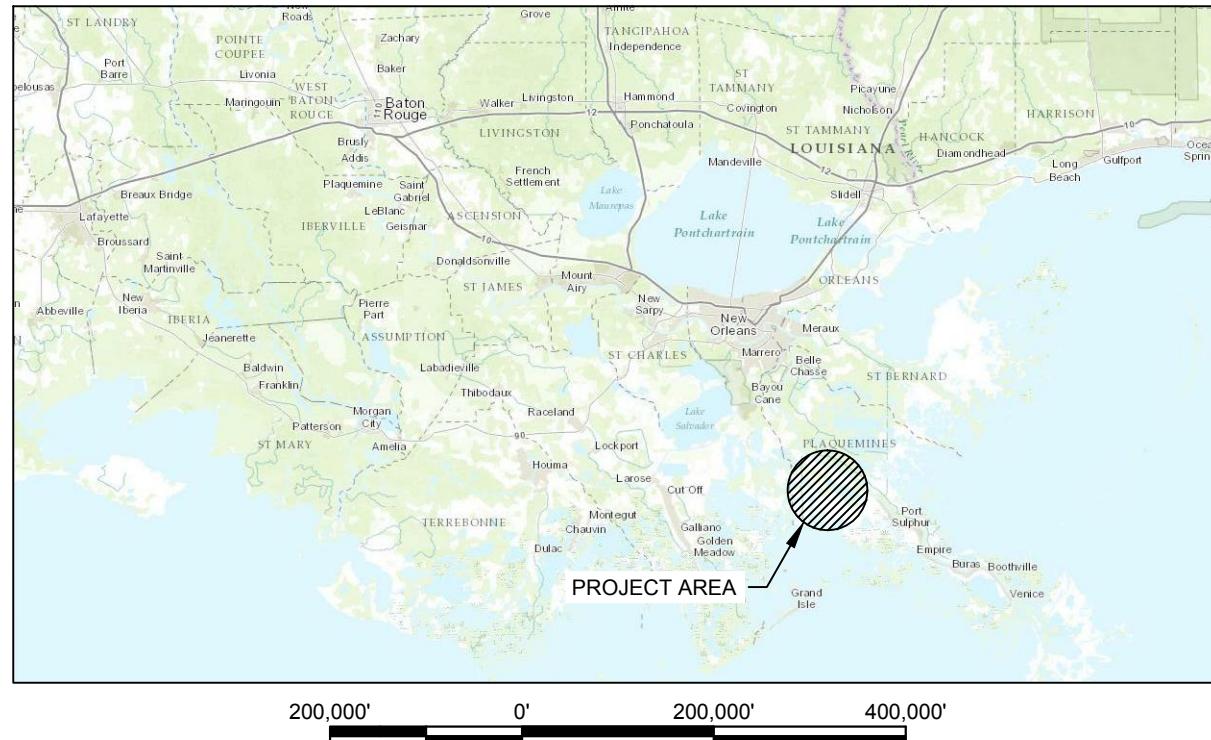
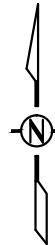
STATE OF LOUISIANA
COASTAL PROTECTION AND RESTORATION AUTHORITY

INDEX TO SHEETS

SHEET NO. DESCRIPTION

- 1 TITLE SHEET
- 2 CONTROL LAYOUT
- 3 MAGNETOMETER SURVEY LAYOUT
- 4 MAGNETOMETER ACCESS LAYOUT
- 5 PIPELINE SURVEY LAYOUT
- 6 PIPELINE PROFILE SHEET
- 7 SURVEY LAYOUT
- 8 ACCESS LAYOUT
- 9 PROFILE SHEET
- 10 PROFILE SHEET
- 11 PROFILE SHEET
- 12 PROFILE SHEET
- 13 PROFILE SHEET

BAYOU GRANDE CHENIER
MARSH AND RIDGE RESTORATION
TOPOGRAPHIC, BATHYMETRIC, AND MAGNETOMETER SURVEY LAYOUT
BA-173
PLAQUEMINES PARISH



REV.	DATE	DESCRIPTION	BY

EMC, Inc.
SPECIALISTS IN SURVEYING & MAPPING
Web Address: <http://www.emcsurvey.com>
2472 SUNSET DR. • GRENADE, MS 38901 • Ph. (662) 226-5166 • Fax (662) 226-5170
CENTER POINT, LA • PUNTA GORDA, FL • HOUSTON, TX

COASTAL PROTECTION AND
RESTORATION AUTHORITY
450 LAUREL STREET
BATON ROUGE, LOUISIANA 70801

DRAWN BY: JP

DESIGNED BY:

BAYOU GRANDE CHENIER
MARSH AND RIDGE RESTORATION

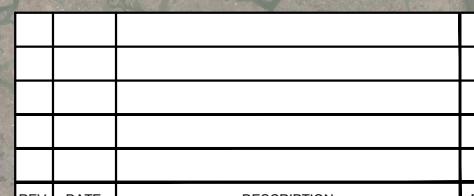
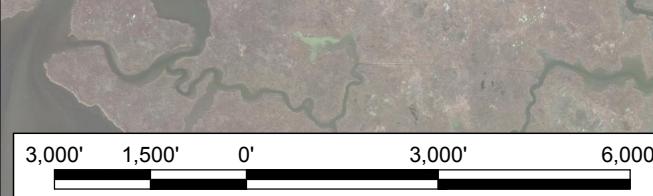
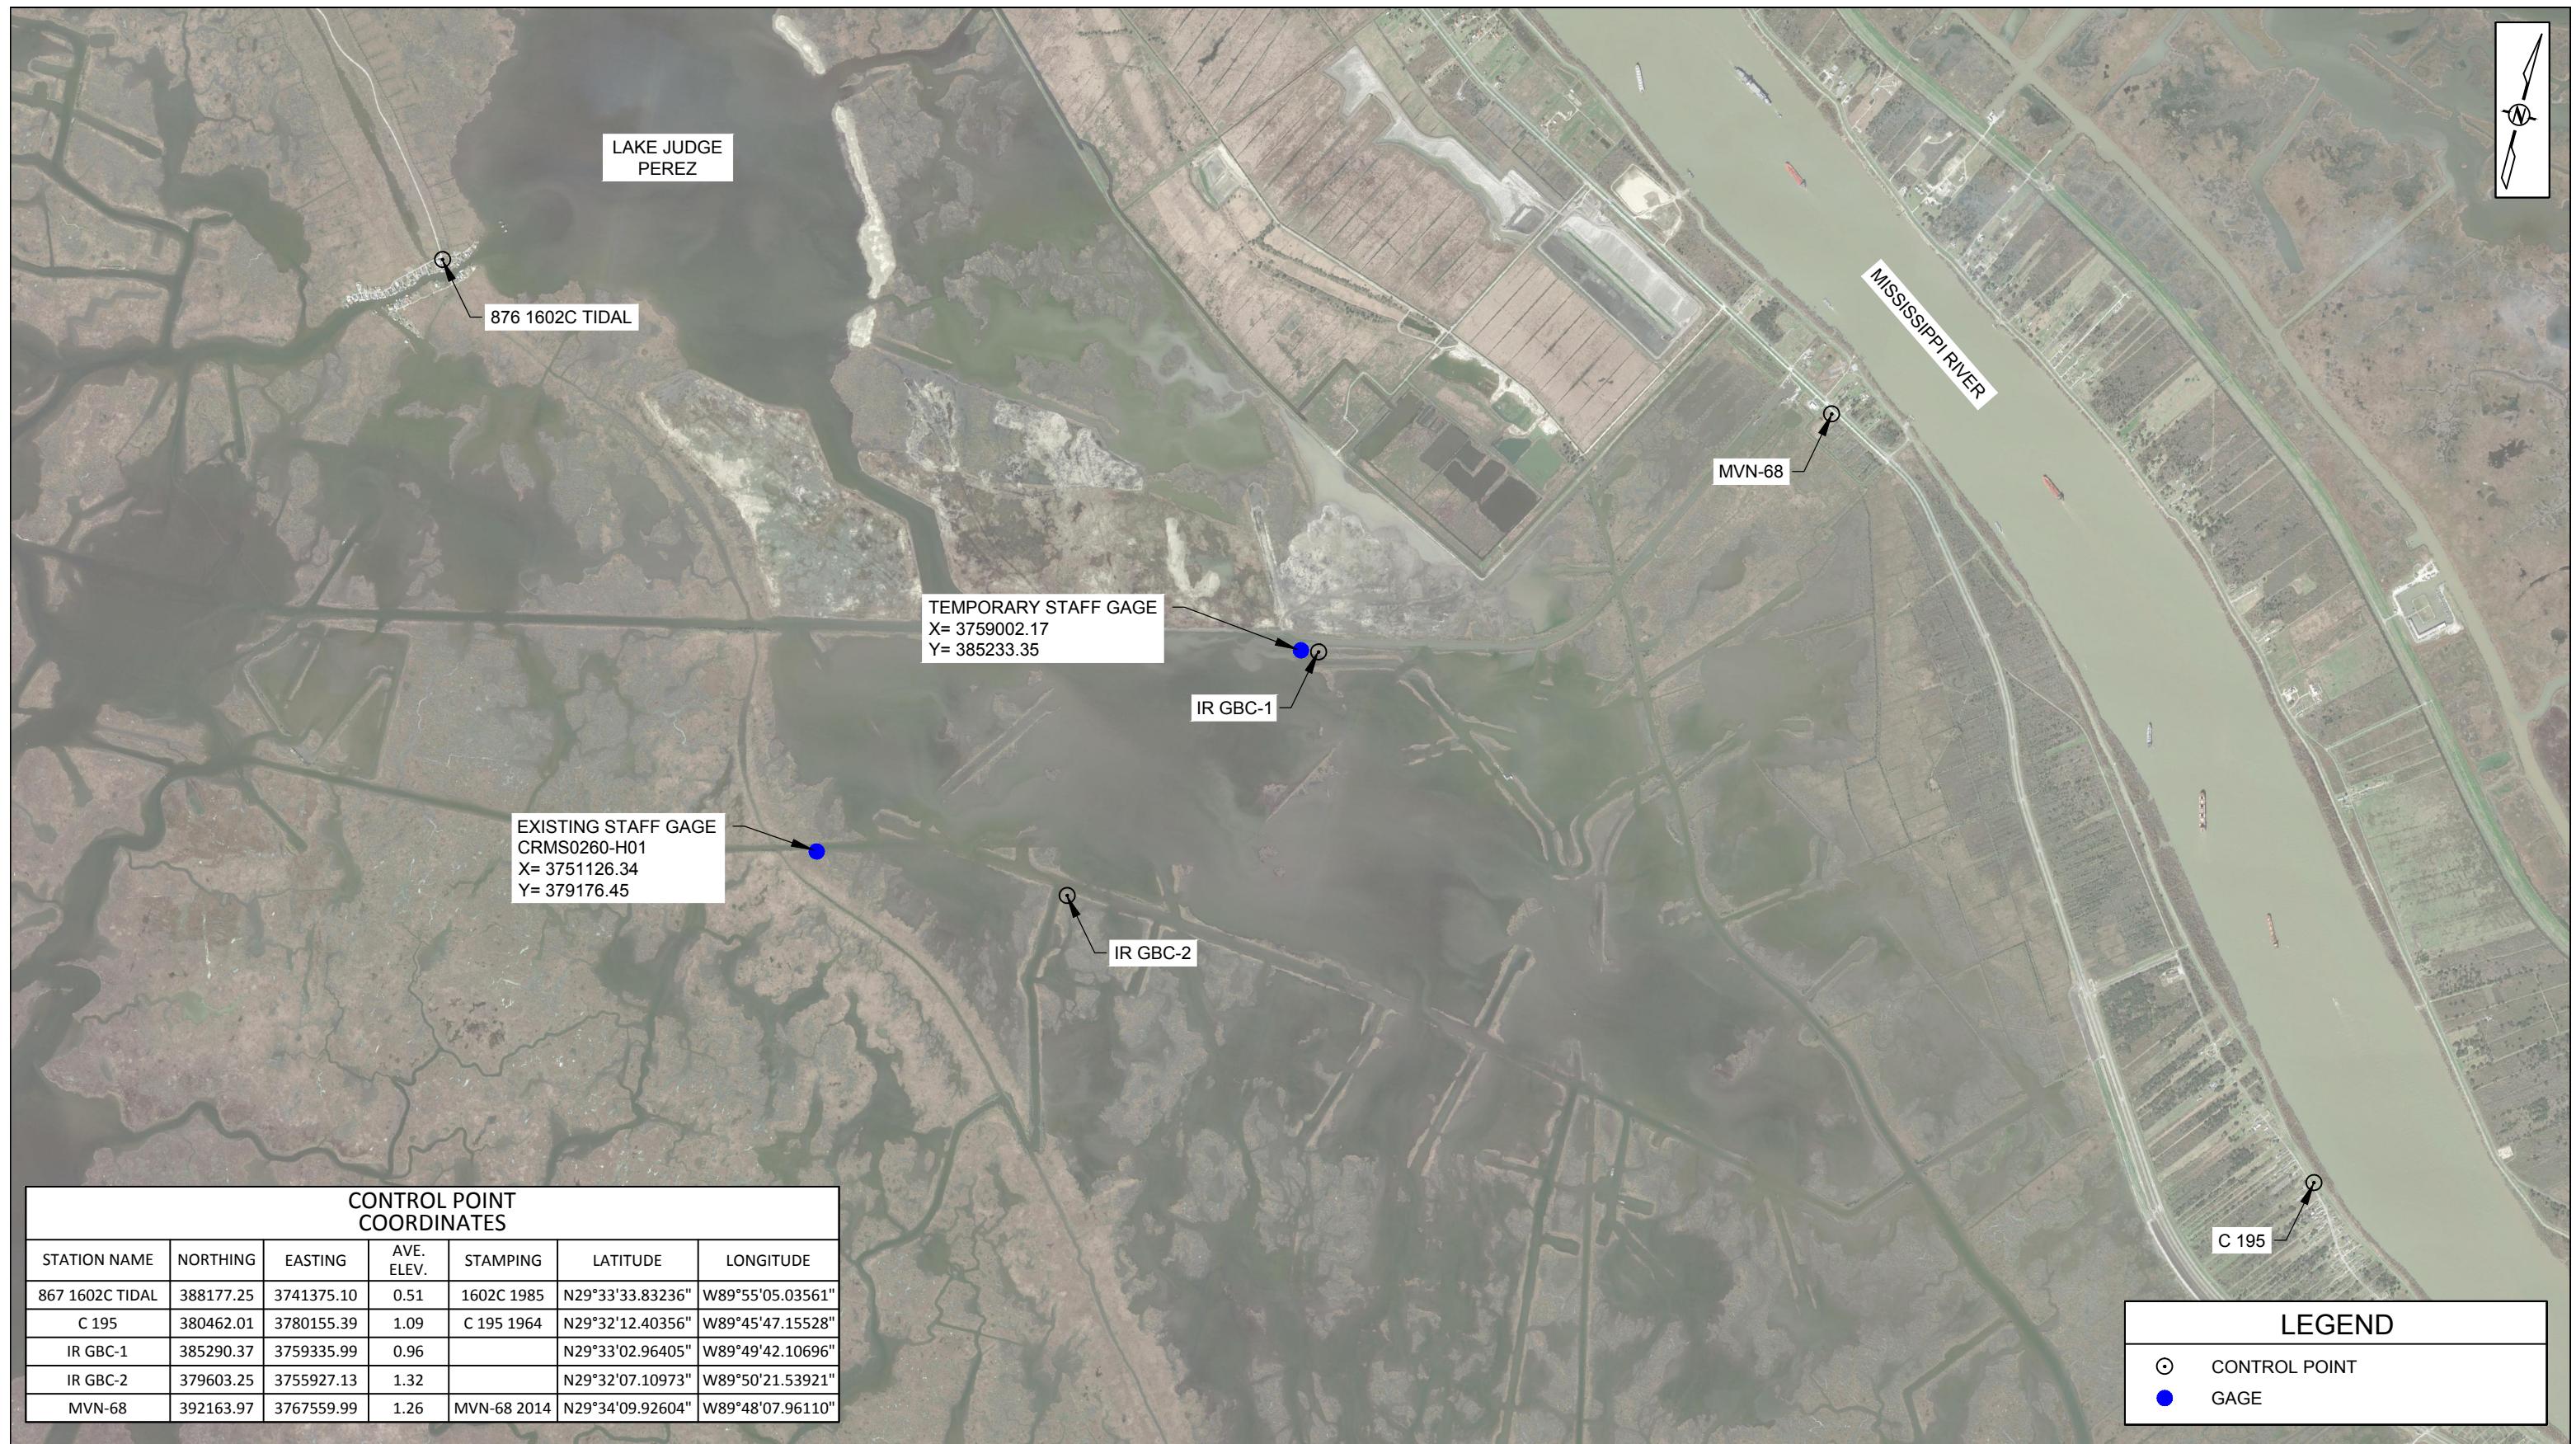
STATE PROJECT NUMBER: BA-173

FEDERAL PROJECT NUMBER: BA-173

TITLE SHEET

DATE: JULY 2015

SHEET 1 OF 13



Web Address: <http://www.emcsurvey.com>
2472 SUNSET DR. • GRENADE, MS 38901 • Ph. (662) 226-5166 • Fax (662) 226-5170
CENTER POINT, LA • PUNTA GORDA, FL • HOUSTON, TX

COASTAL PROTECTION AND RESTORATION AUTHORITY
450 LAUREL STREET
BATON ROUGE, LOUISIANA 70801

BAYOU GRANDE CHENIER
MARSH AND RIDGE RESTORATION
STATE PROJECT NUMBER: BA-173
FEDERAL PROJECT NUMBER: BA-173

CONTROL LAYOUT
DATE: JULY 2015

DRAWN BY: JP

DESIGNED BY:


APPROVED BY:


SHEET 2 OF 13




LAKE JUDGE
PEREZ



Magnetic Anomaly Investigation Table					
Investigation No.	Northing (ft.)	Easting (ft.)	Description	Peak to Peak Amplitude	Duration (ft.)
I2	379199.90	3761397.50	Piece of Wire / Cable	196.60	49.6
I9	379753.70	3758183.00	Unable to locate Source	156.40	64.8
I10	379551.50	3757233.10	Scrap Iron from old boat	1110.70	153.1
I11	380184.40	3757076.40	Crab Pot	290.40	51.5
I13	384448.50	3755041.60	Old Wire	405.00	146.5
I15	380328.10	3754979.50	Crab Trap near Pipeline	279.50	122.6
I16	380051.60	3754012.40	Small Piece of Metal near Pipeline	1502.10	102.1
I17	379715.60	3754087.70	Crab Trap	536.60	82.4
I18	383749.90	3752108.60	Scrap Iron from Boat	925.50	117.8
I19	383534.80	3751137.00	Crab Trap	215.50	110.8
I20	379786.40	3753049.00	Crab Trap near Pipeline	922.90	156.6
I21	381473.40	3751638.70	Unable to locate Source	1736.20	262.8
I22	379506.10	3752074.00	Crab Trap near Pipeline	1116.30	110.2
I23	379112.50	3752158.10	Piece of Cable	1020.70	124.1
I25	383209.40	3754934.20	Unable to locate Source	342.90	113.4
I27	381473.00	3751659.40	Crab Pot	1863.80	250.6
I30	381085.70	3754362.00	Crab Pot / Scrap Iron	200.10	137.5
I35	380645.40	3761263.20	Scrap Metal	122.50	88.7
I36	379000.80	3763020.40	Steel Plate	134.50	155.4
I37	378684.40	3750819.20	Scrap Iron from Boat	2653.00	103.5
I40	378960.80	3755675.70	Scrap Iron from Boat	754.70	74.4
I43	378818.10	3751200.20	Unable to locate Source	926.10	130.2
I100	382176.40	3756592.80	Crab Trap	38.80	94.2
I101	382241.50	3758517.60	Unable to locate Source / minimal return on investigation lines	45.80	175.3
I102	379271.30	3762412.00	Scrap Iron	86.80	31.2
I103	380151.40	3755013.60	Piece of Cable / Concrete Rebar Form	117.40	166.5
I104	378029.90	3755512.20	Wire / Cable	106.90	146.2
I105	375037.10	3756248.60	Crab Trap	86.90	22.5
I106	377998.30	3755479.30	Wire / Cable	86.60	147.6
I107	379438.80	3753124.30	Piece of Chain	61.80	49
I108	381347.70	3750628.00	Crab Trap	97.30	60.3
I109	374750.00	3756567.20	Crab Trap	203.40	222.9
I110	379589.50	3761160.50	Cable	182.80	581.5
I111	379200.00	3763840.00	Scrap Iron	28.10	79.8
I112	380224.70	3752151.70	Scrap Iron	21.40	50
I115	382960.50	3749005.00	Barge	4084.50	120.4
I116	383006.30	3749206.70	Barge	4201.80	119.2
I221	382854.20	3748945.40	Crab Trap	330.20	24.8
I222	382205.10	3749130.50	Crab Trap	234.00	69
I223	381034.80	3749218.60	Wire Basket / Cable	238.10	46.2
I224	375495.70	3755880.80	Crab Trap	213.90	95.1
I225	374966.90	3756377.30	Crab Traps	192.80	103.6
I44	385026.50	3759005.30	Shell Pipeline	250.70	140.1
I26	384416.40	3759824.50	Shell Pipeline	373.10	131.9
I3	384092.20	3760255.40	Shell Pipeline	1038.50	145.1
I4	383959.20	3760286.00	Shell Pipeline	219.30	87.1
I28	383645.90	3760873.30	Shell Pipeline	426.60	151.1
I5	383296.80	3761342.90	Shell Pipeline	901.50	78.7
I29	382828.60	3761984.20	Shell Pipeline	458.00	159.3
I6	382278.00	3762737.30	Shell Pipeline	340.80	184.7
I33	382076.00	3762989.90	Shell Pipeline	556.10	149.9
I7	381373.10	3763950.40	Shell Pipeline	780.60	256.1
I34	381296.70	3764057.40	Shell Pipeline	370.90	301.2
I226	383596.40	3760094.00	Gulf South Pipeline	324.20	158.4
I1	382639.00	3759569.40	Gulf South Pipeline	688.60	110.8
I31	382267.30	3759380.80	Gulf South Pipeline	117.60	234
I8	381447.60	3758809.50	Gulf South Pipeline	1304.30	128.1
I227	381172.40	3757857.50	Gulf South Pipeline	815.70	95.8
I12	380881.70	3756909.90	Gulf South Pipeline	1222.90	114.9
I14	380618.00	3755936.20	Gulf South Pipeline	772.50	151.9
I15	380328.10	3754979.50	Gulf South Pipeline	279.50	122.6
I16	380051.60	3754012.40	Gulf South Pipeline	1502.10	102.1
I20	379786.40	3753049.00	Gulf South Pipeline	922.90	156.6
I22	379506.10	3752074.00	Gulf South Pipeline	1116.30	110.2
I24	379244.50	3751132.00	Gulf South Pipeline	212.20	105.9

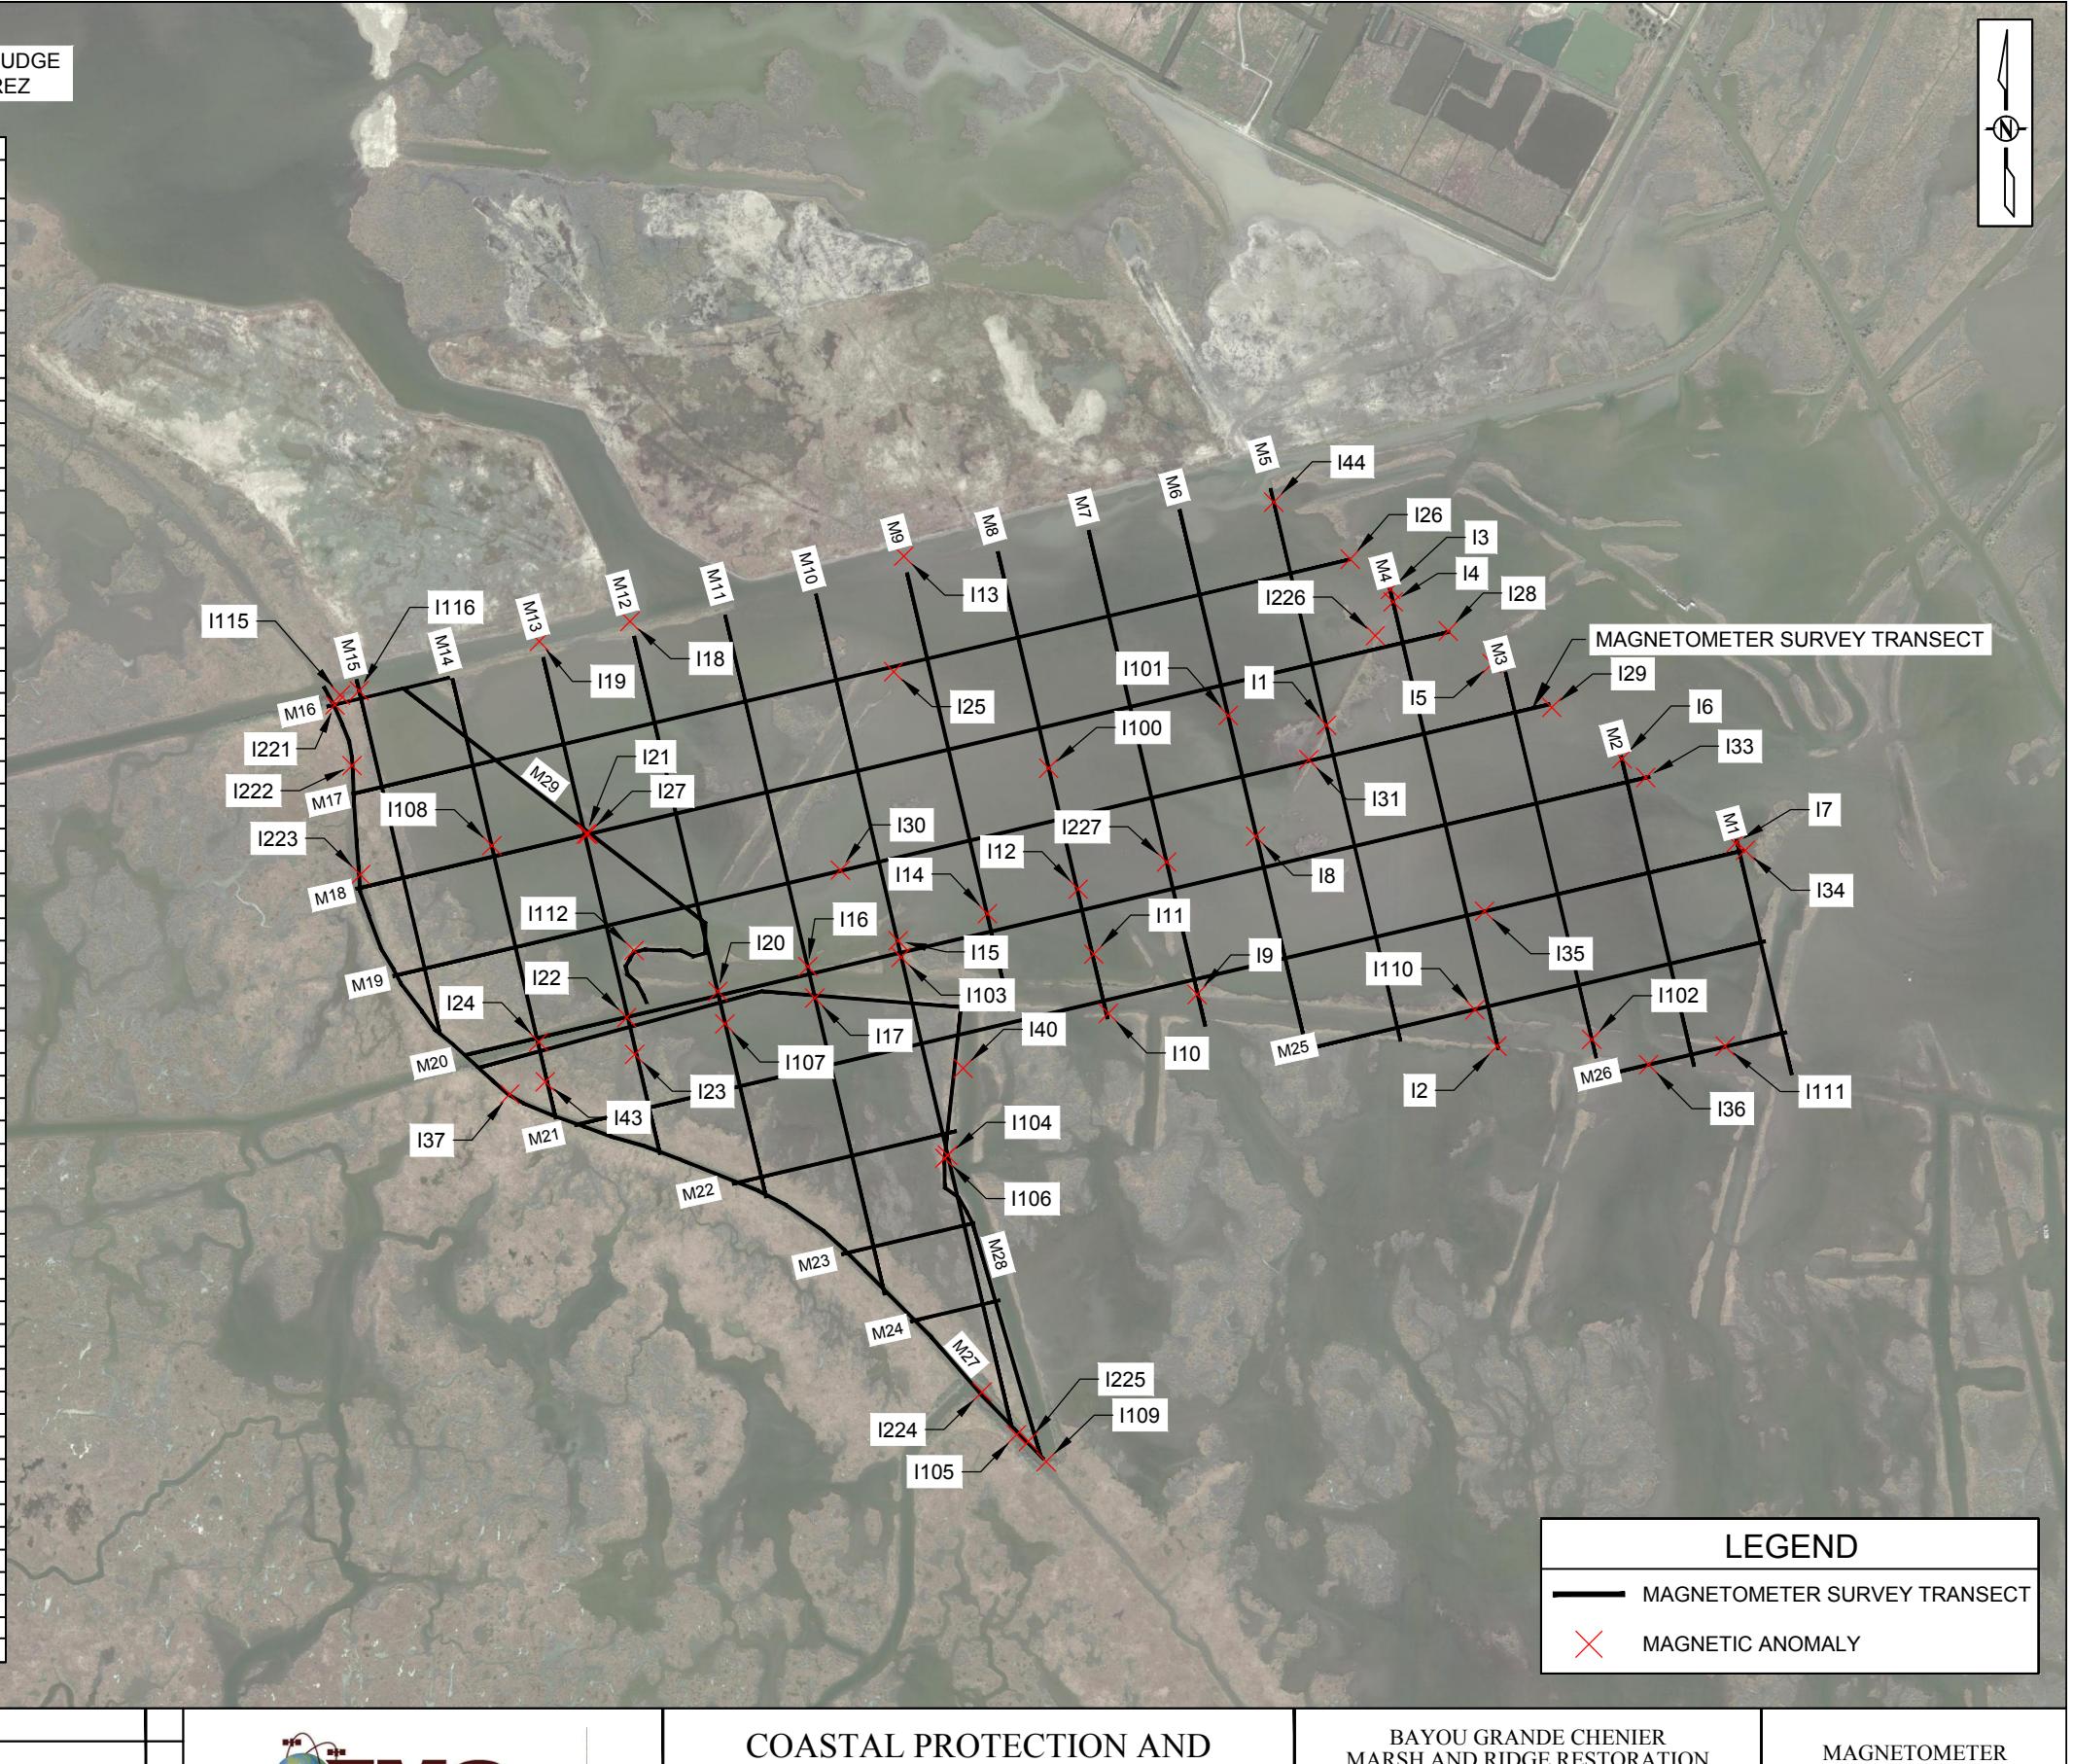


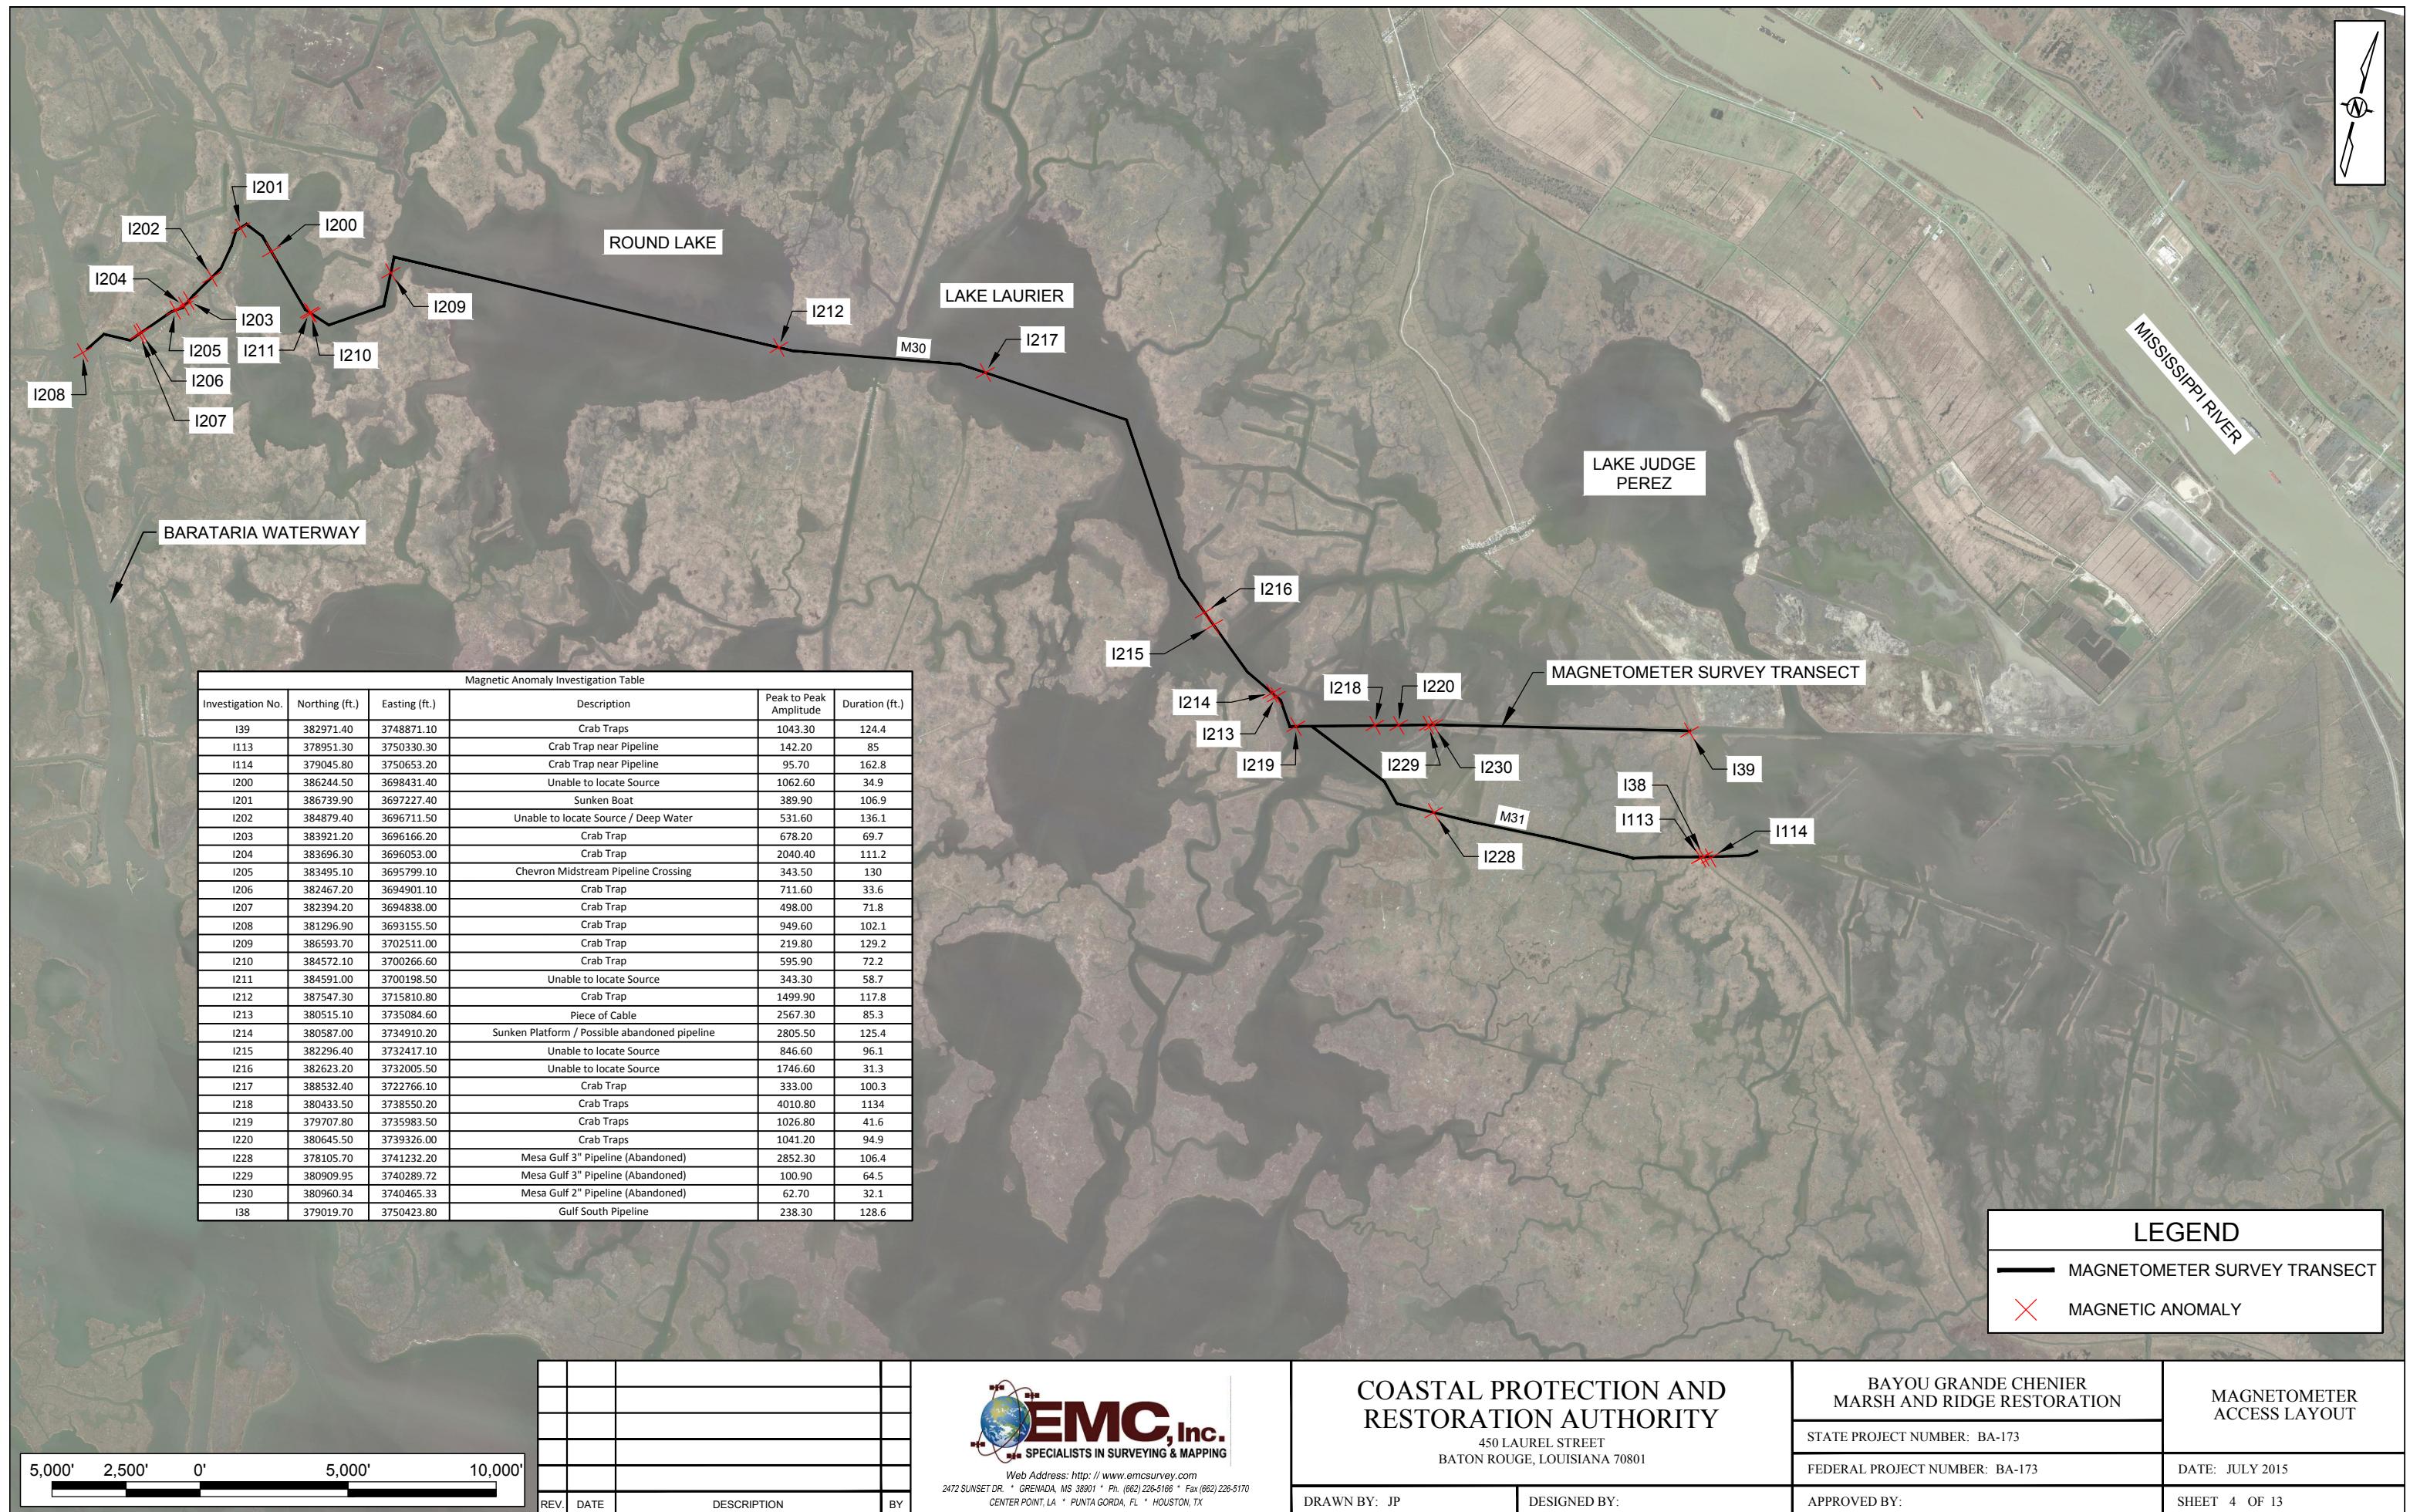


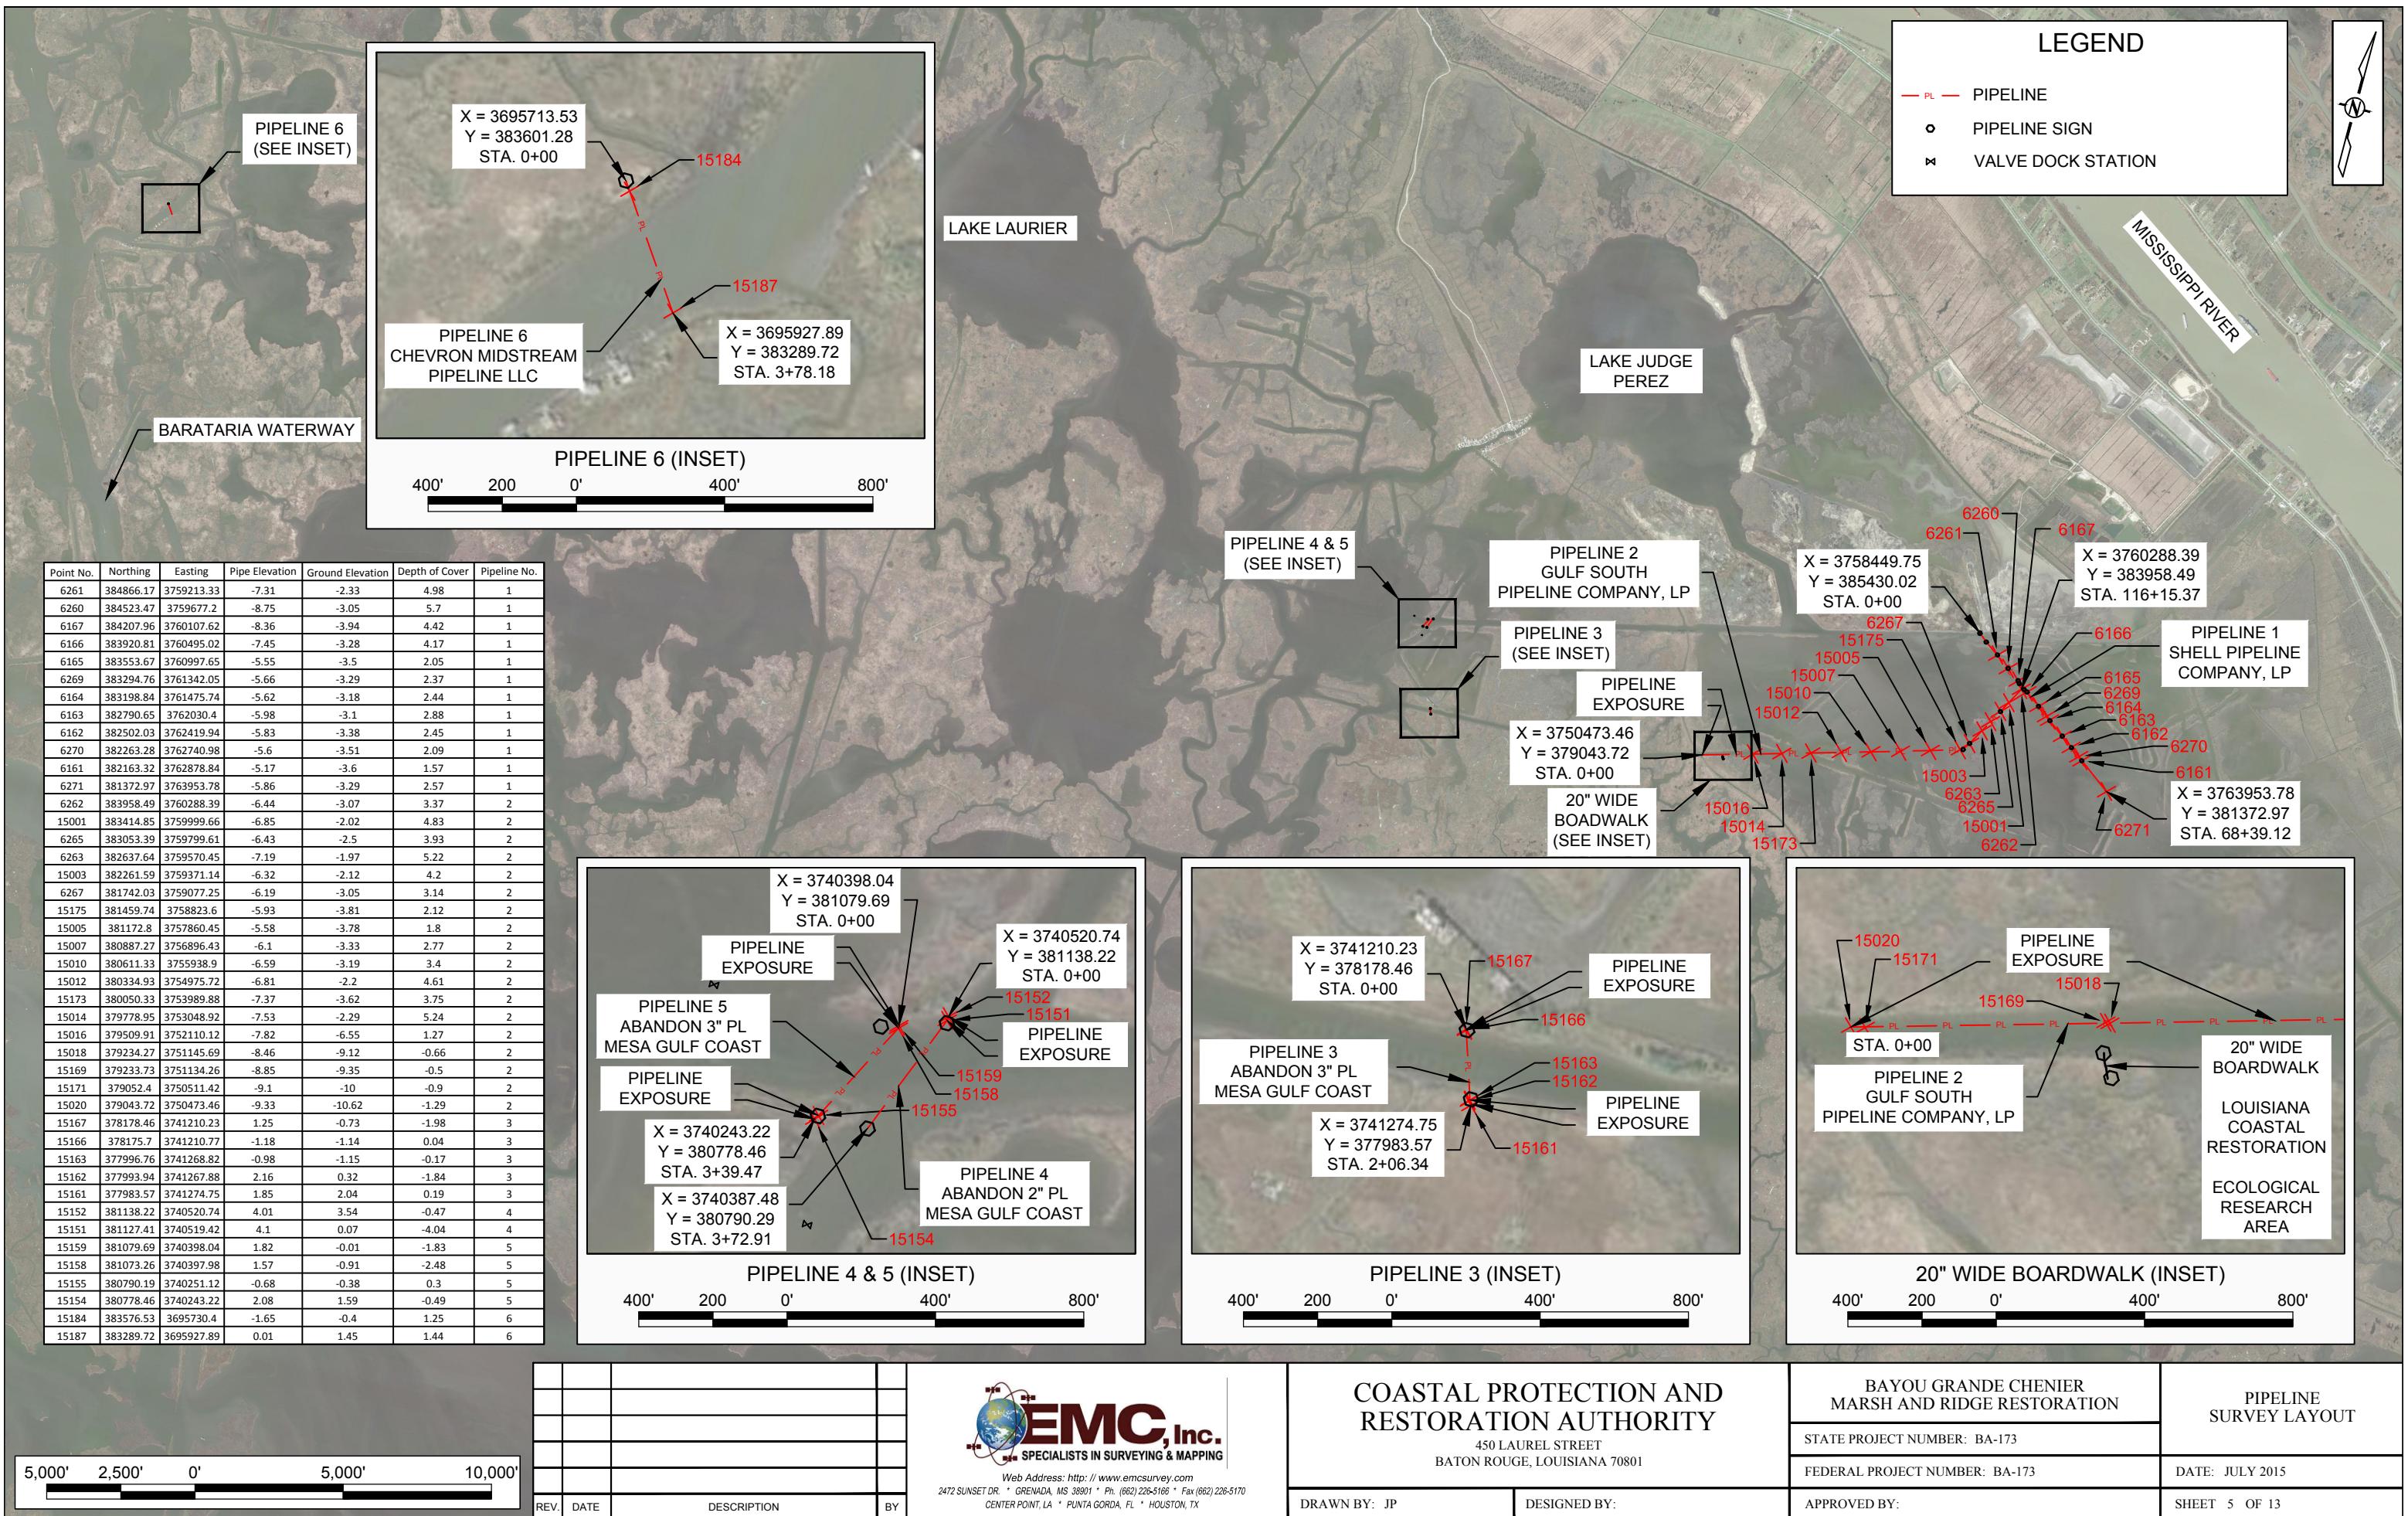


PIPELINE 1 PROFILE

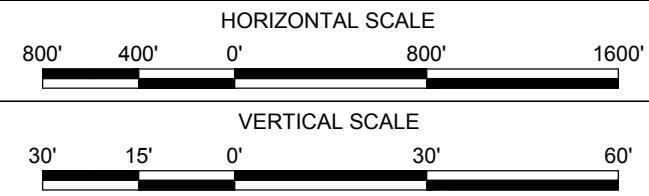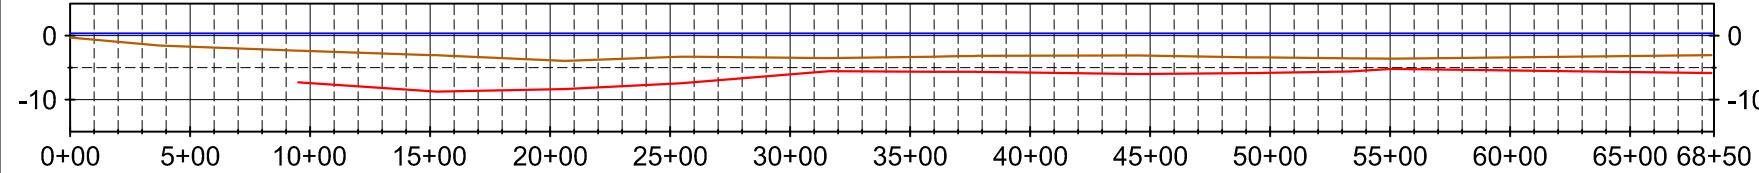


PIPELINE 2 PROFILE

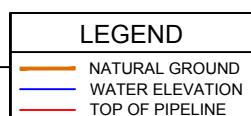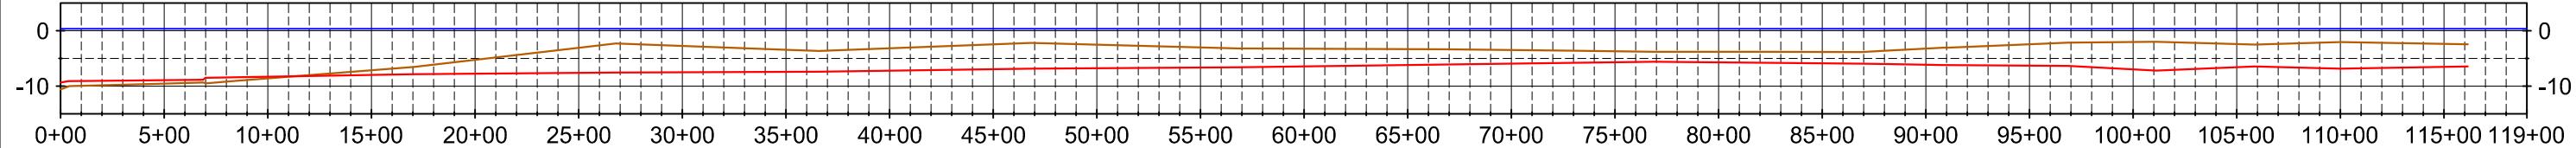


PIPELINE 3 PROFILE

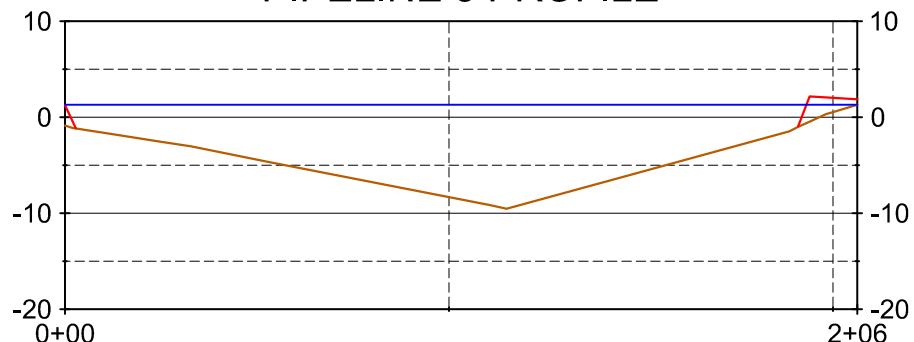


PIPELINE 4 PROFILE

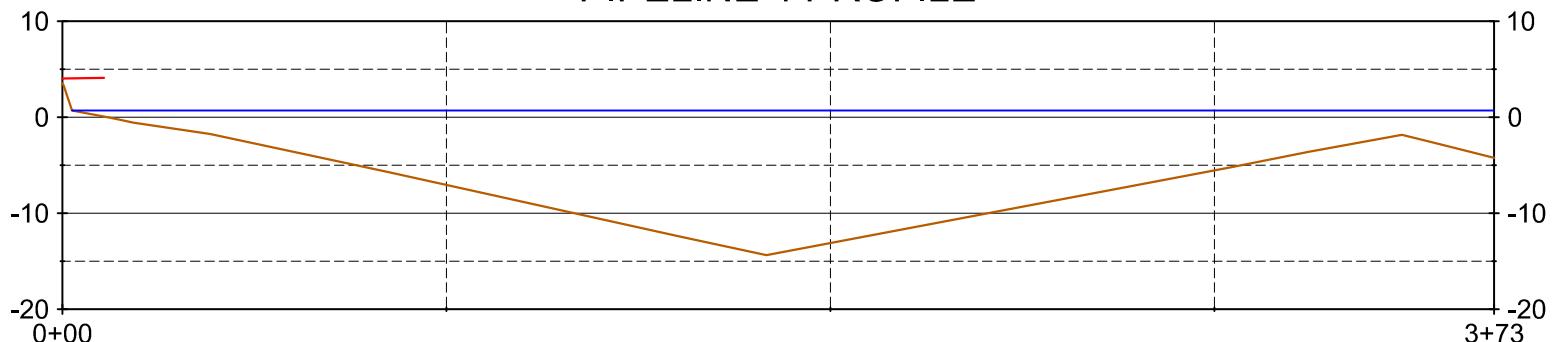

PIPELINE 5 PROFILE

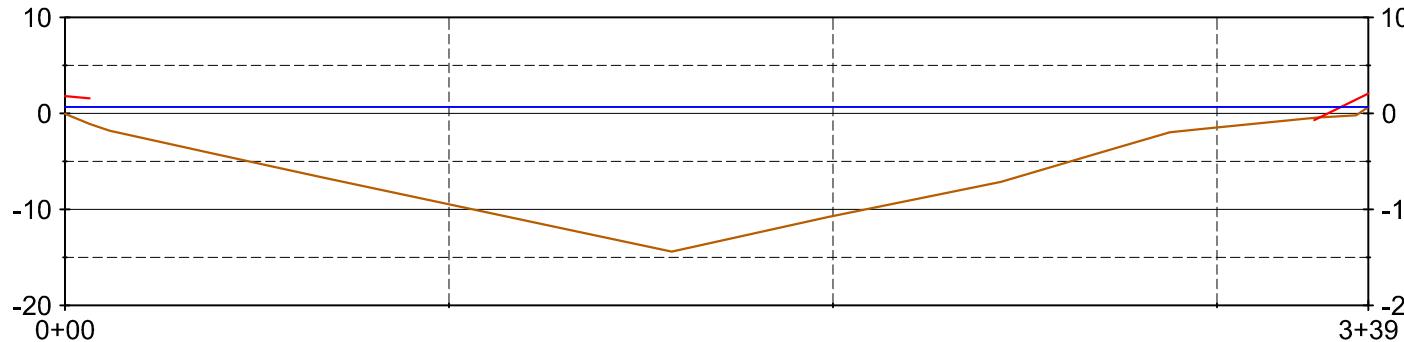

PIPELINE 6 PROFILE

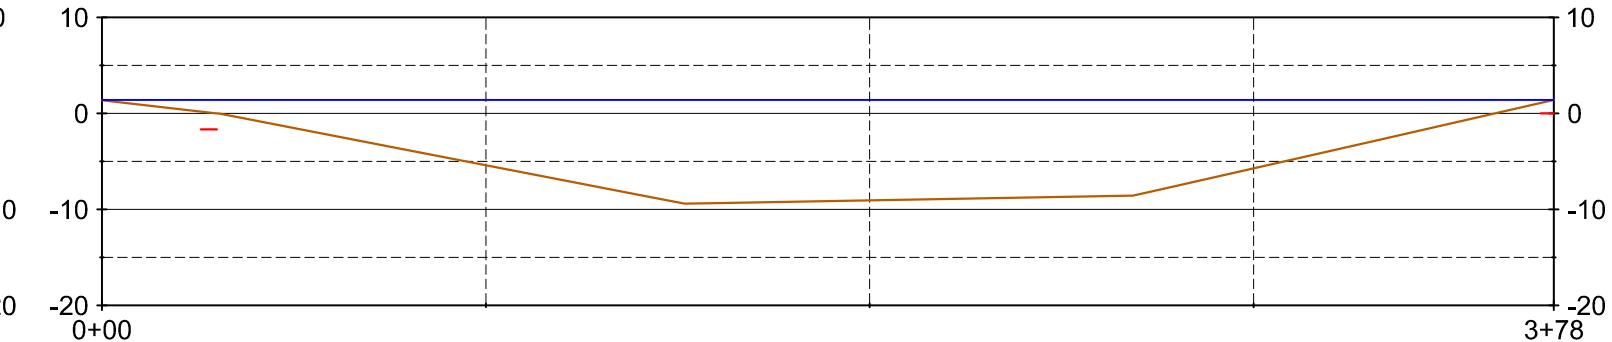

REV.	DATE	DESCRIPTION	BY
------	------	-------------	----



Web Address: <http://www.emcsurvey.com>
2472 SUNSET DR. • GRENADE, MS 38901 • Ph. (662) 226-5166 • Fax (662) 226-5170
CENTER POINT, LA • PUNTA GORDA, FL • HOUSTON, TX

COASTAL PROTECTION AND
RESTORATION AUTHORITY
450 LAUREL STREET
BATON ROUGE, LOUISIANA 70801

DRAWN BY: JP DESIGNED BY:

BAYOU GRANDE CHENIER
MARSH AND RIDGE RESTORATION
STATE PROJECT NUMBER: BA-173
FEDERAL PROJECT NUMBER: BA-173

Pipeline
Profile Sheet
DATE: JULY 2015
SHEET 6 OF 13


AVERAGE MARSH
COORDINATES


POINT	NORTHING	EASTING	AVE. ELEV.
1	381933.45	3749329.75	0.65
2	379550.42	3750781.81	0.54
3	376941.98	3752647.75	0.82
4	374914.99	3746846.35	0.46
5	380020.02	3747887.20	0.49






MISSISSIPPI RIVER




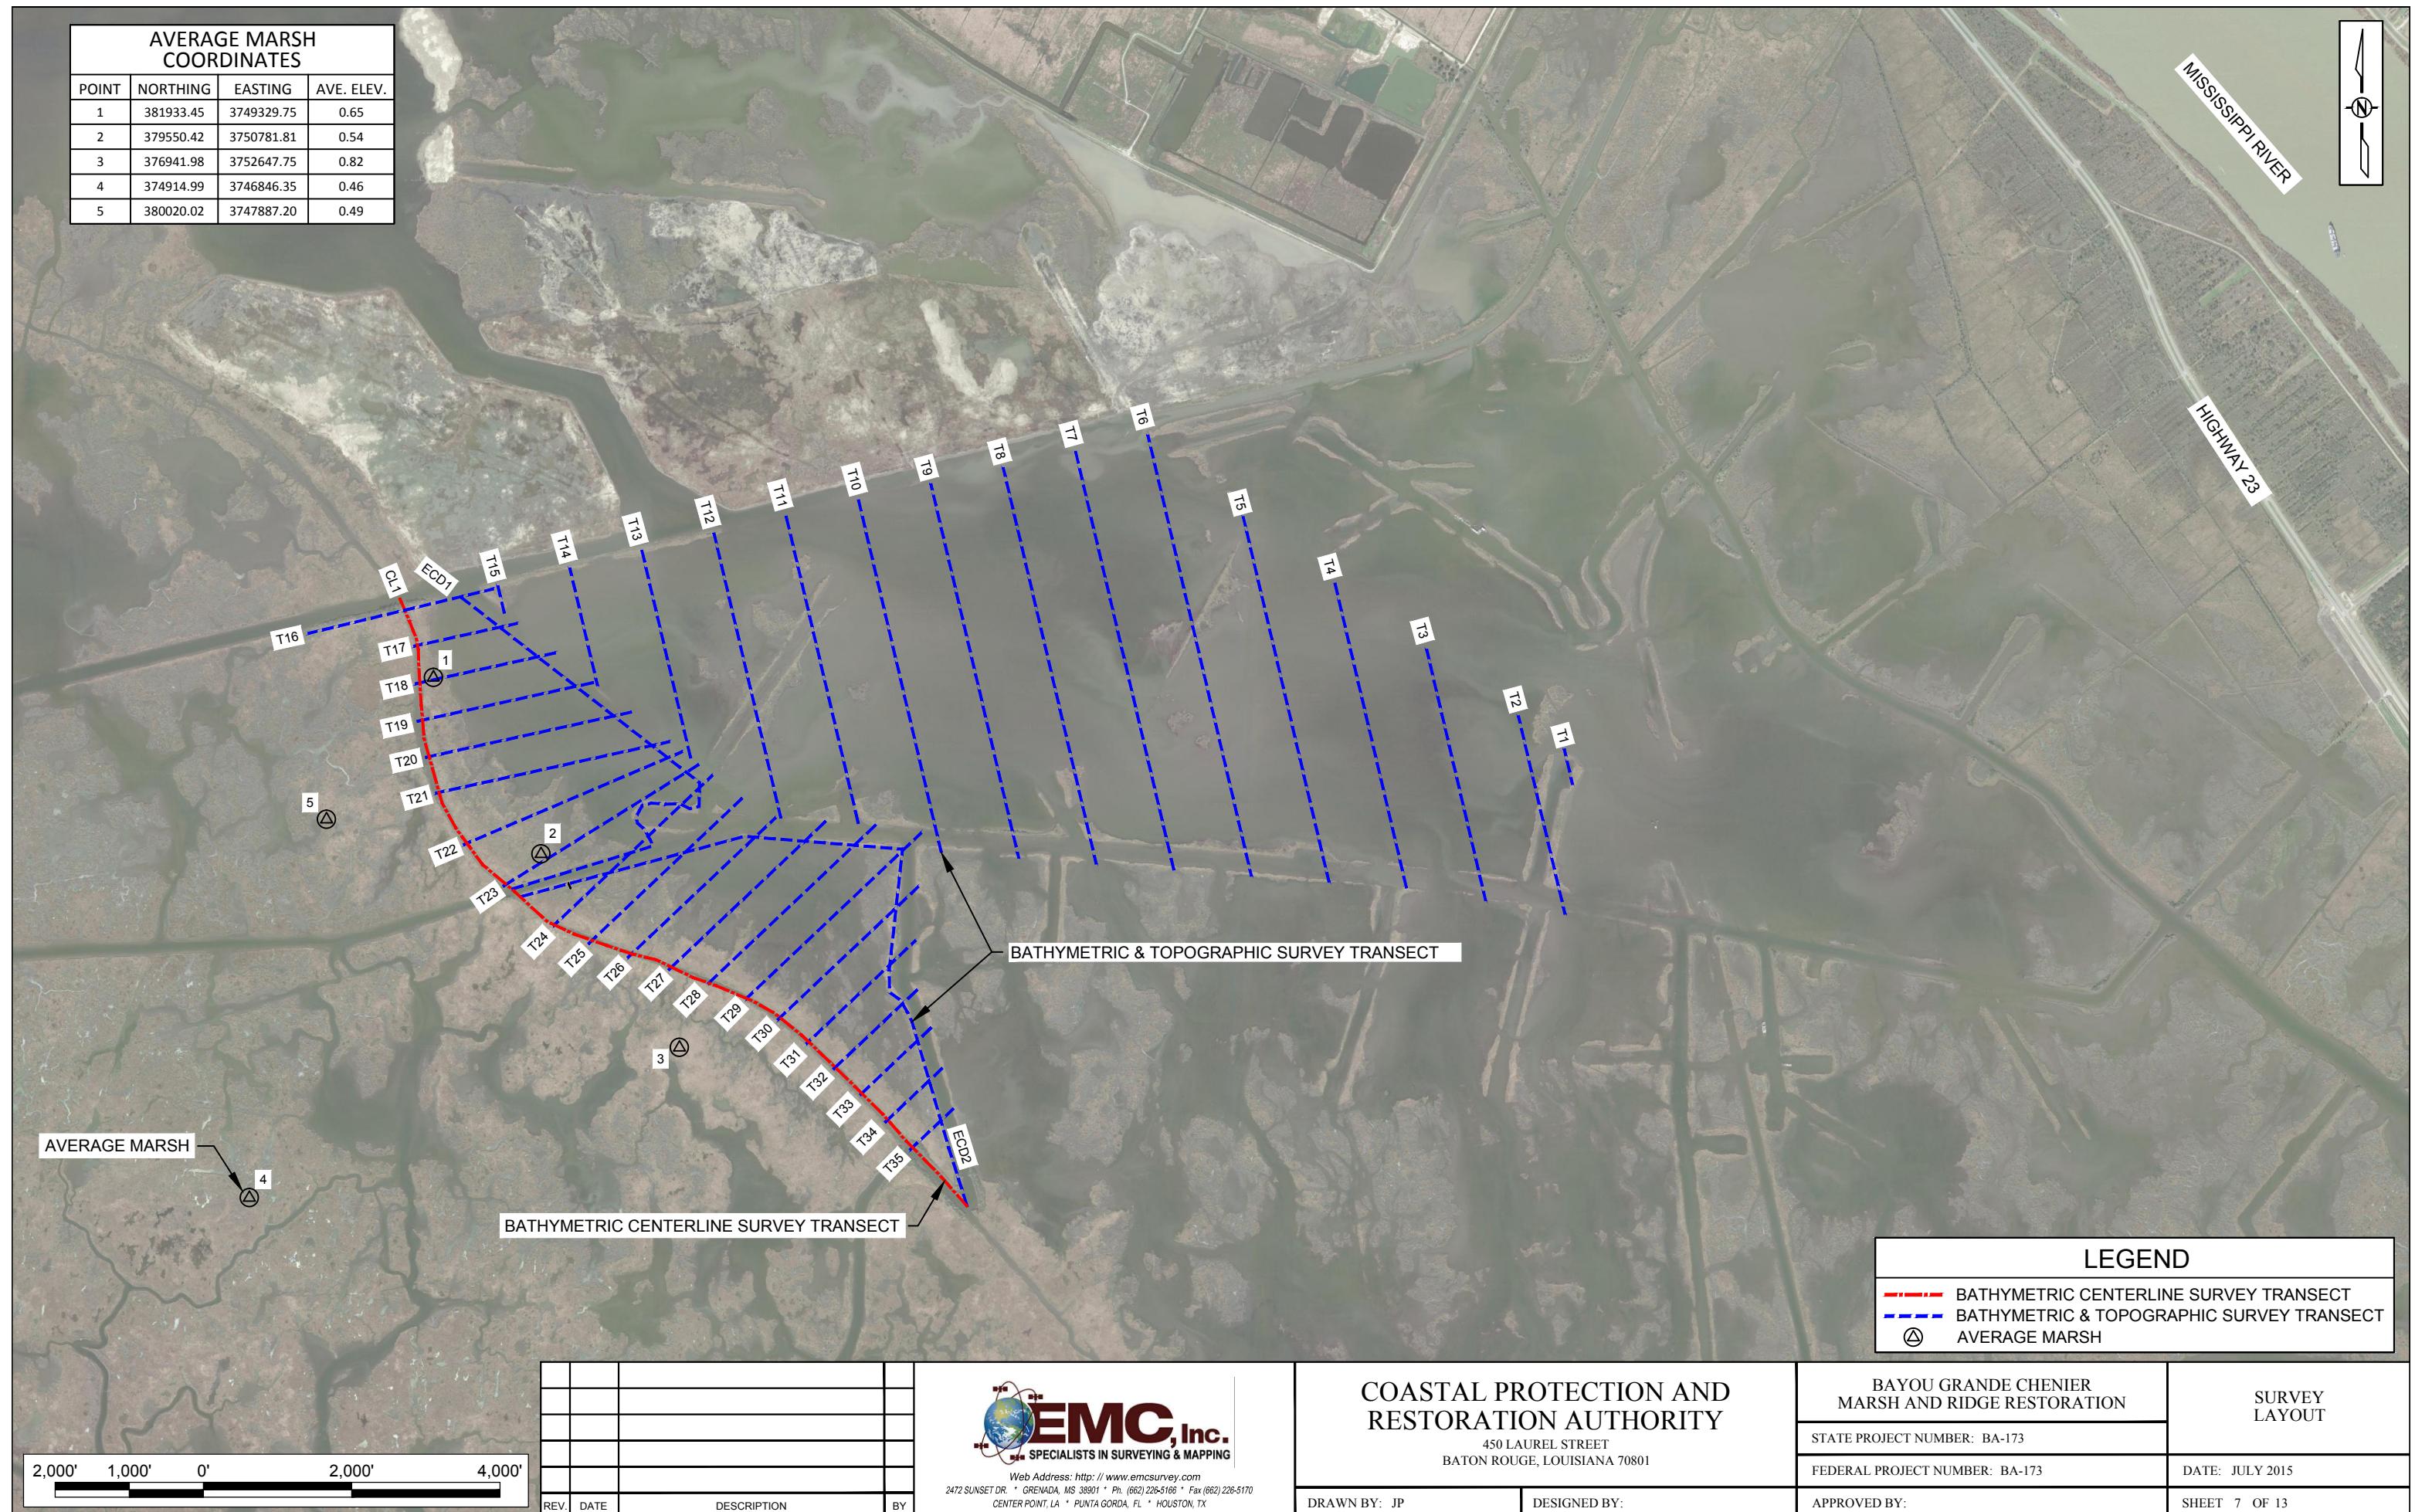
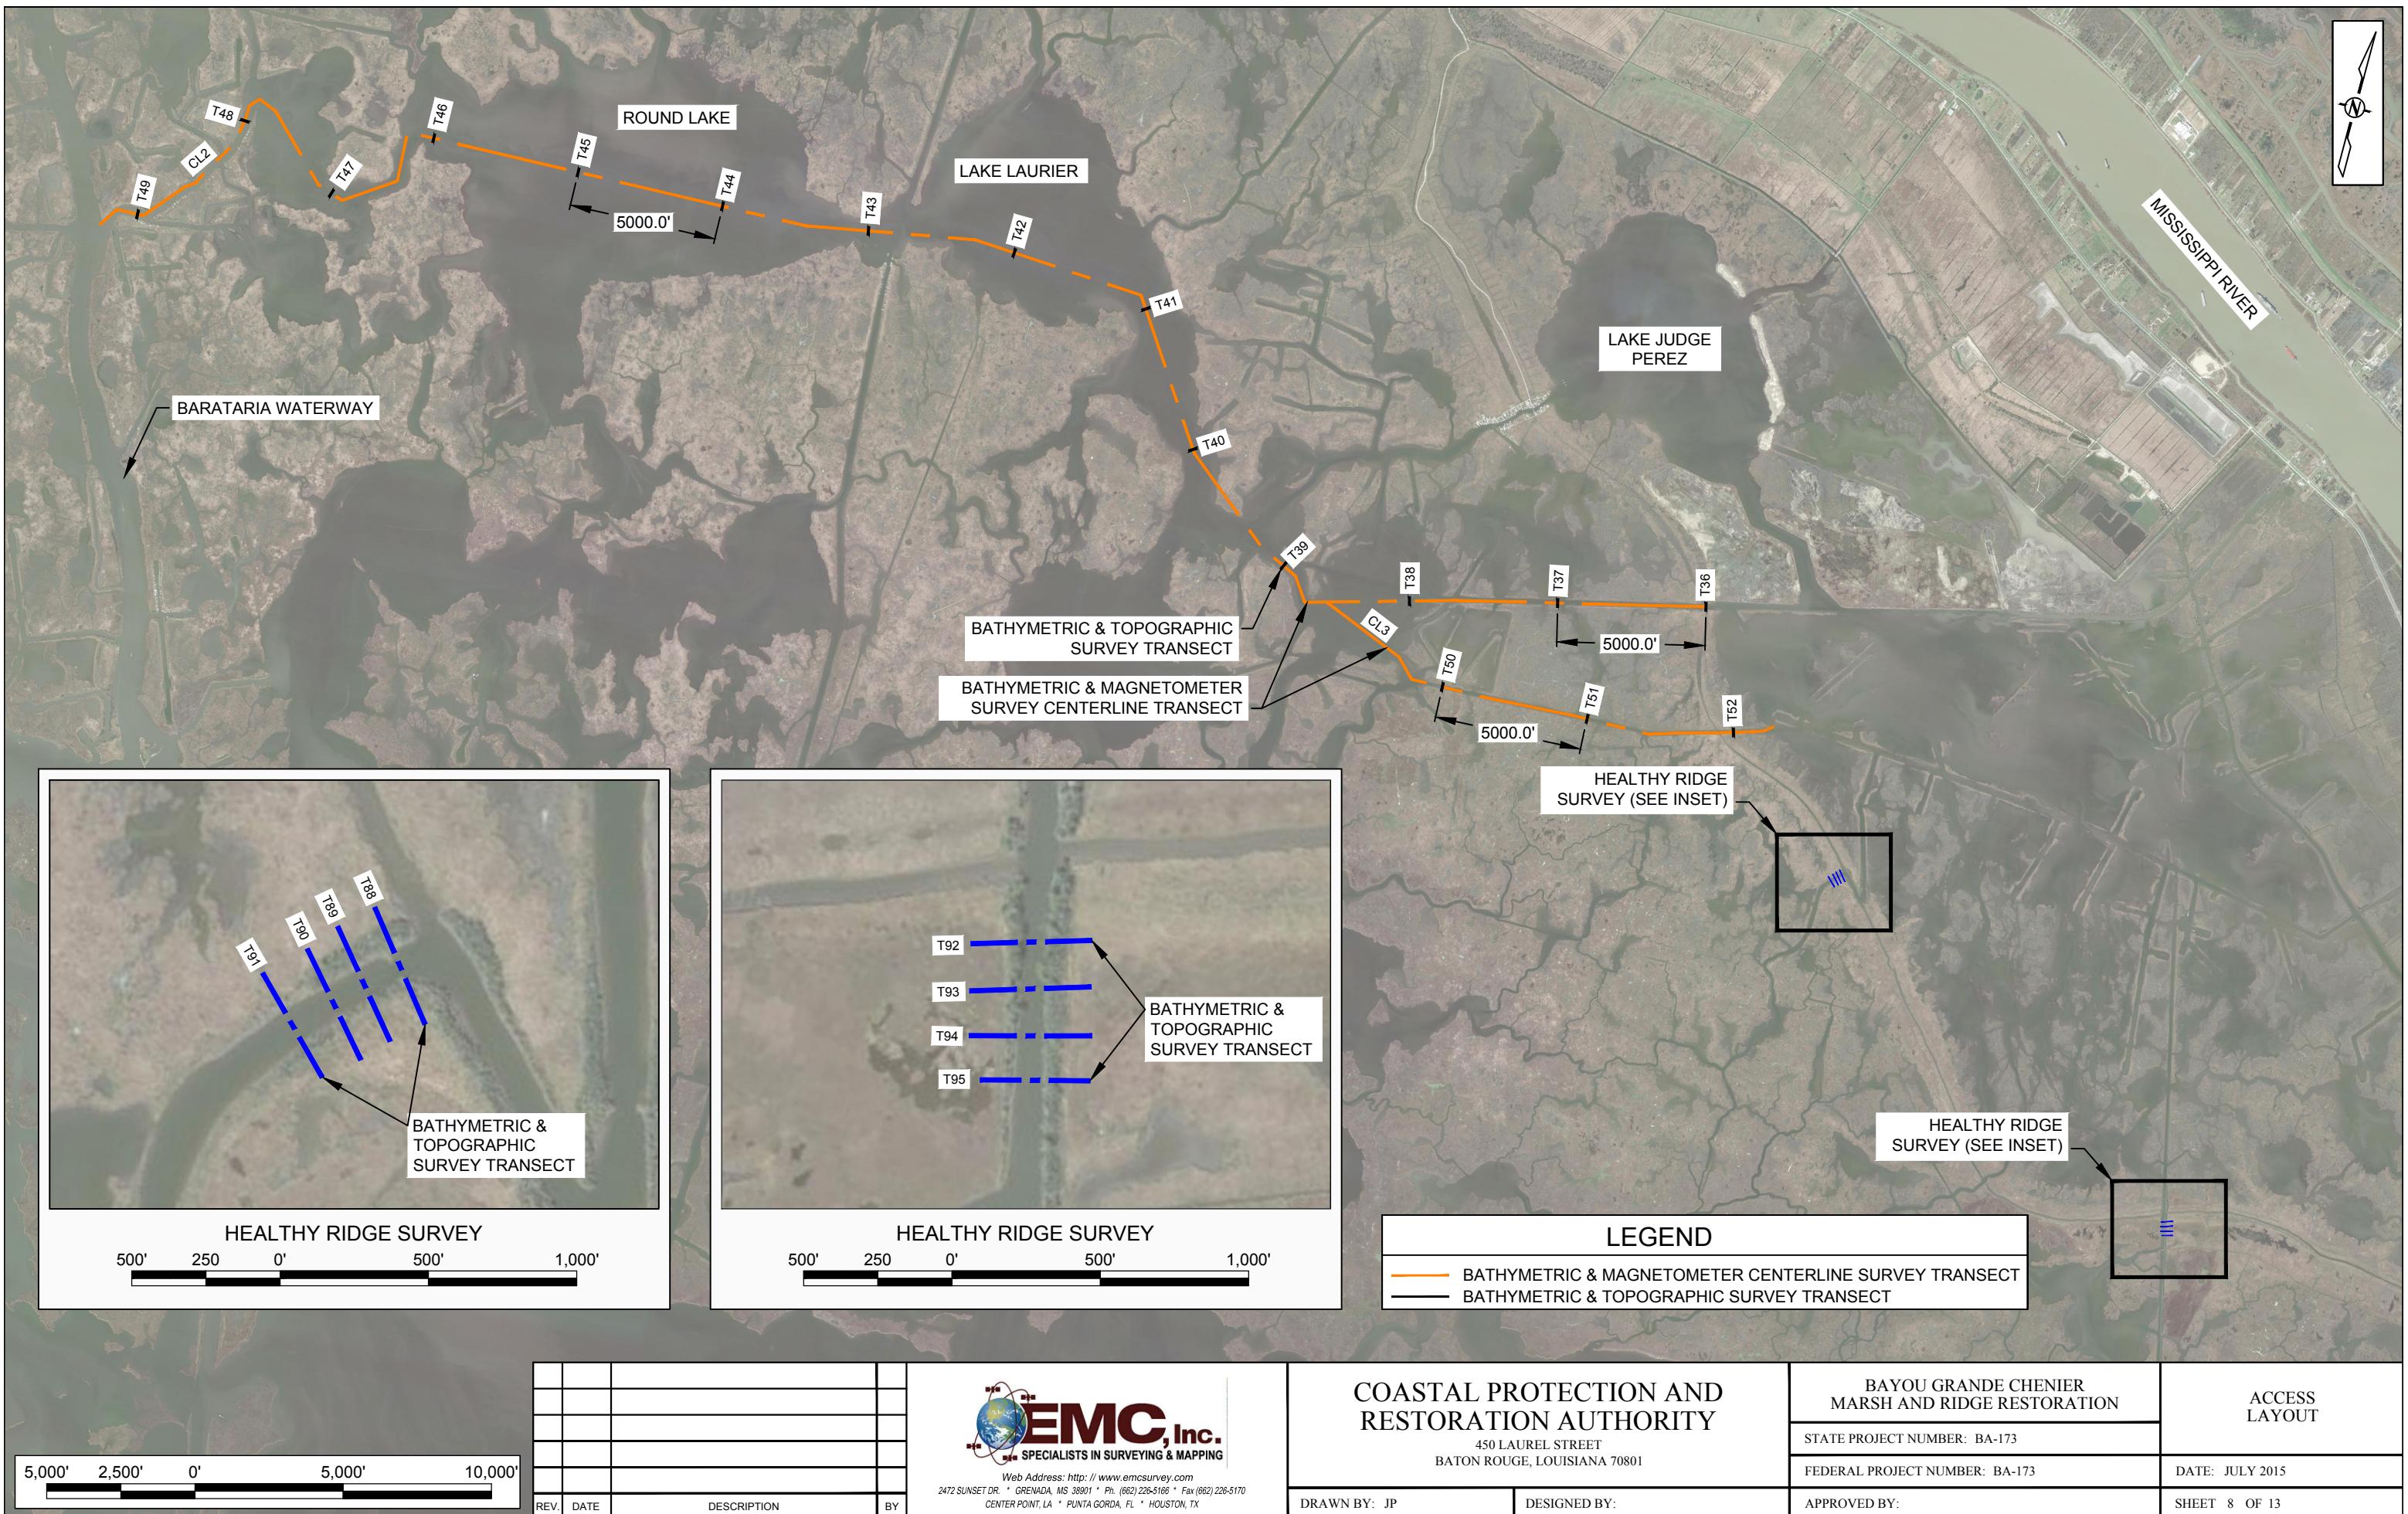
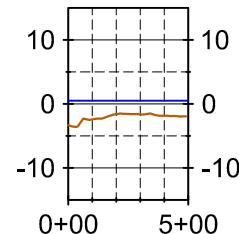
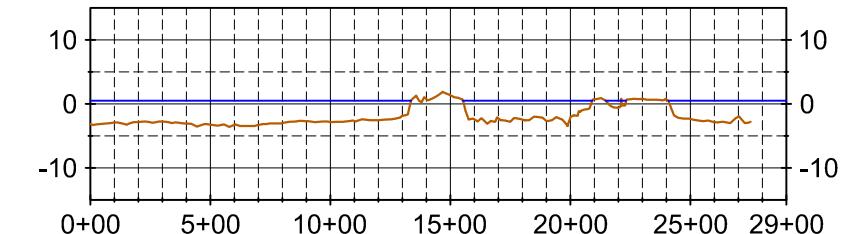
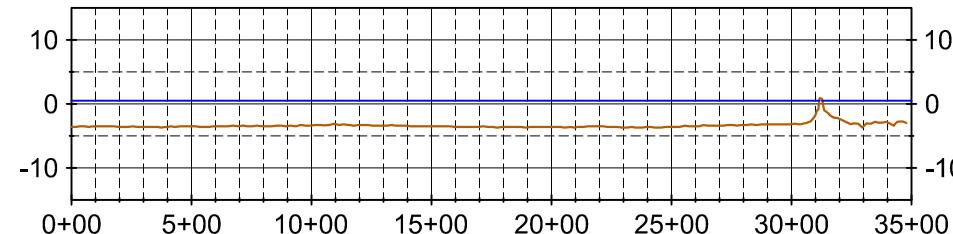
HIGHWAY 23





T1 PROFILE**T2 PROFILE****T3 PROFILE**

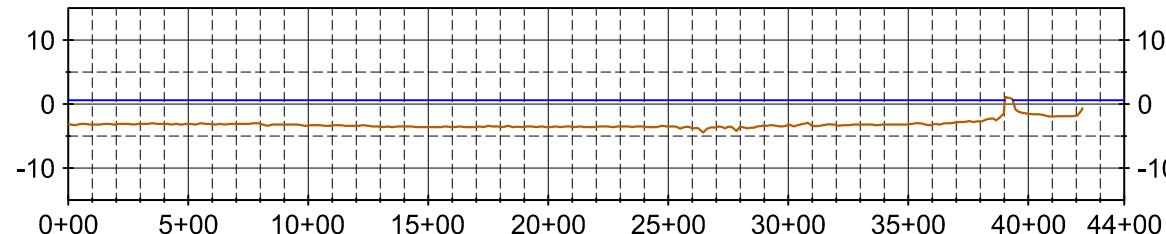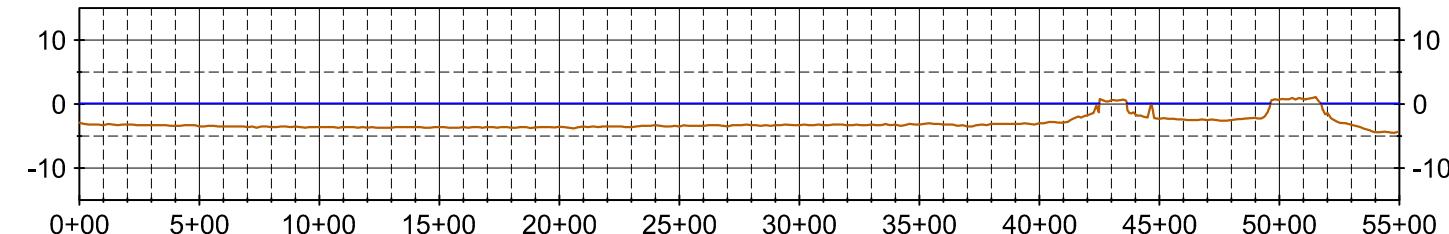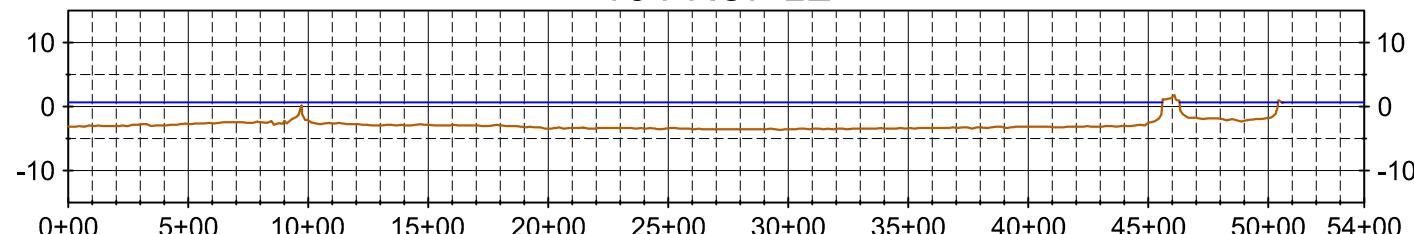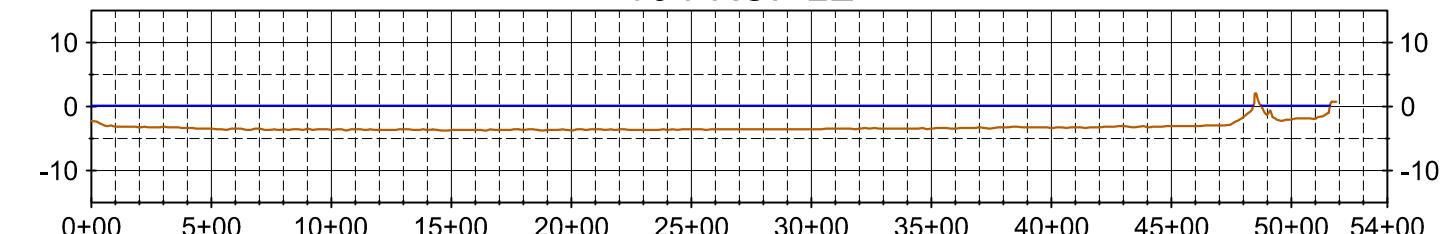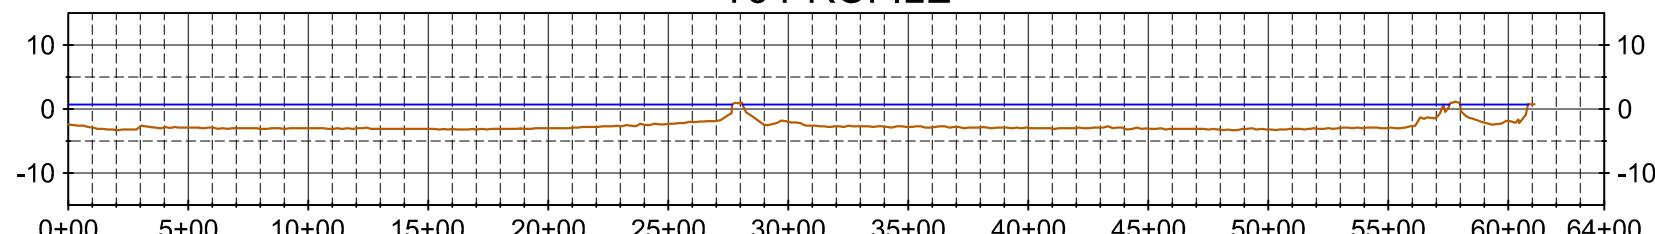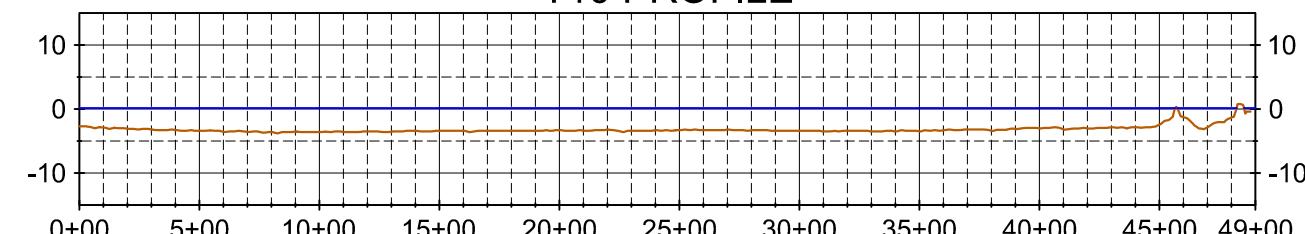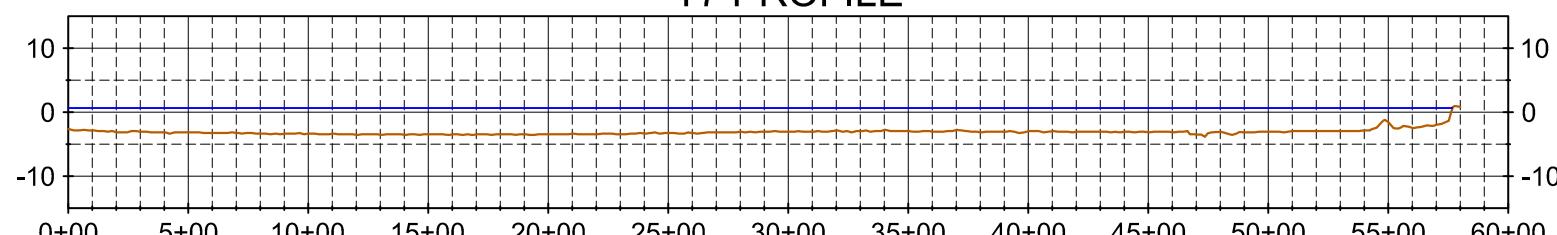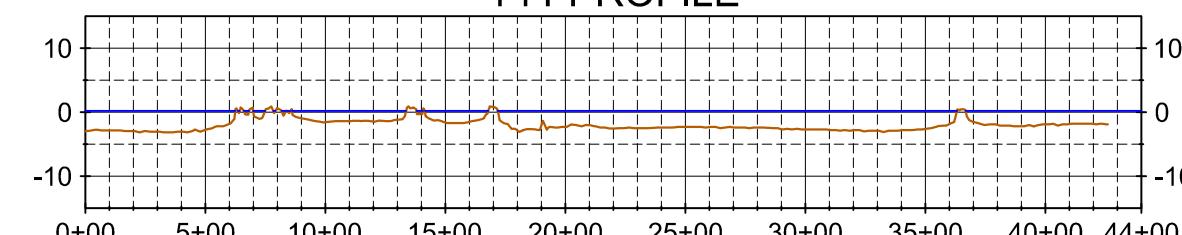LEGEND
— NATURAL GROUND
— WATER ELEVATION

T4 PROFILE**T8 PROFILE****T5 PROFILE****T9 PROFILE****T6 PROFILE****T10 PROFILE****T7 PROFILE****T11 PROFILE**

HORIZONTAL SCALE				
800'	400'	0'	800'	1600'
VERTICAL SCALE				
30'	15'	0'	30'	60'
REV.	DATE	DESCRIPTION	BY	



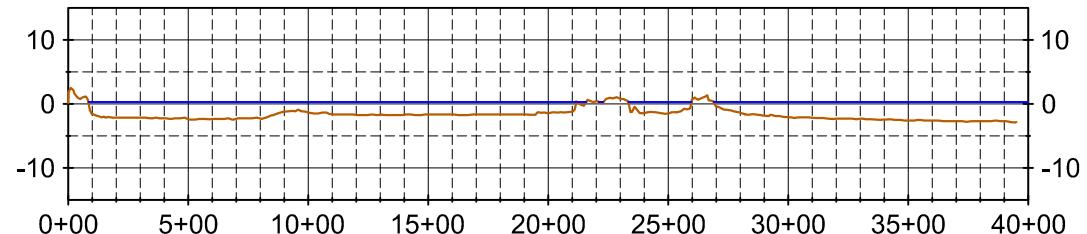
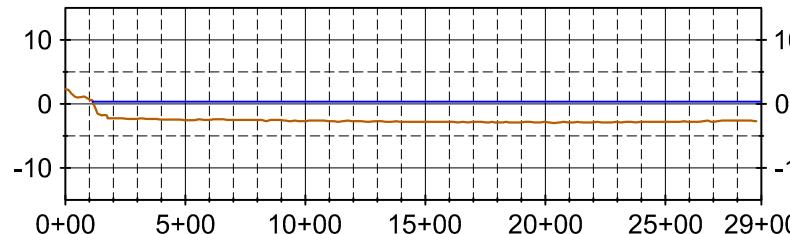
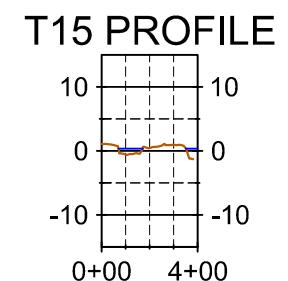
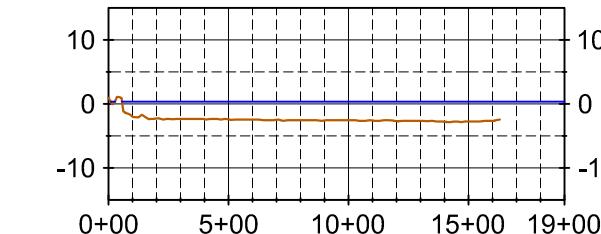
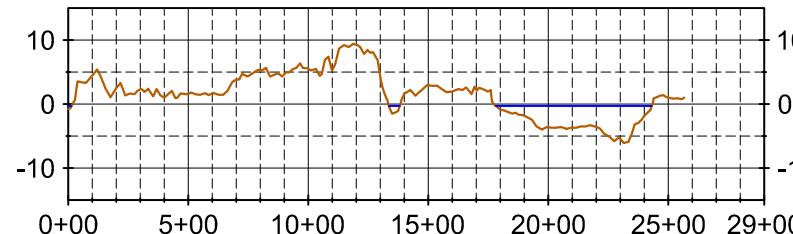
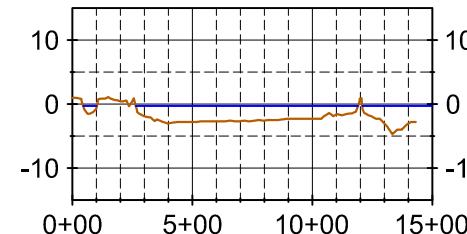
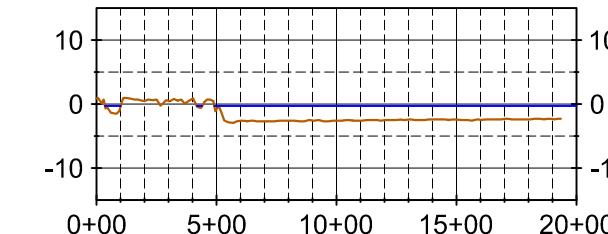
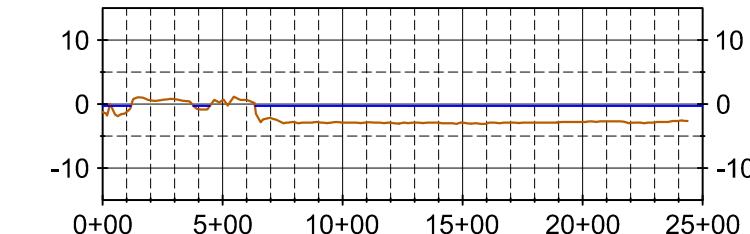
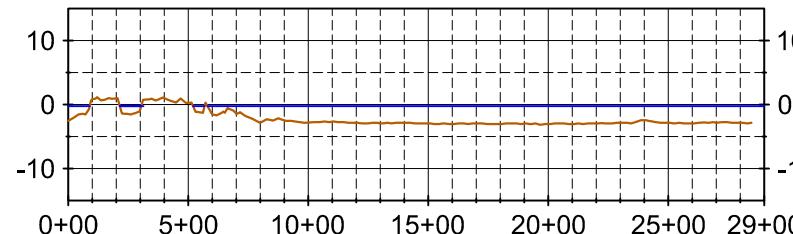
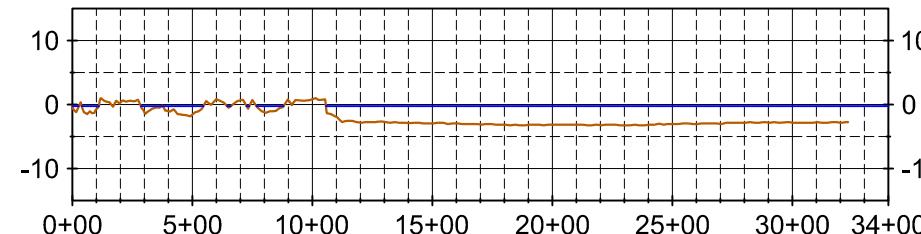
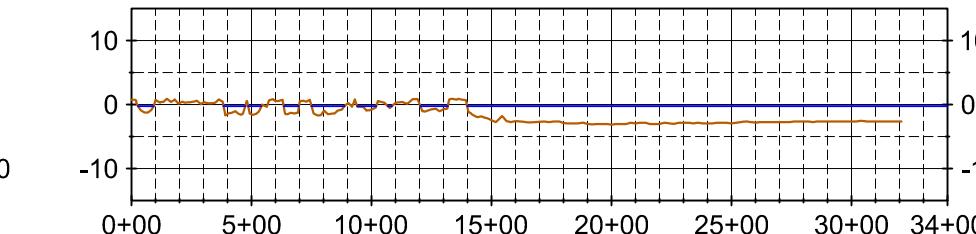
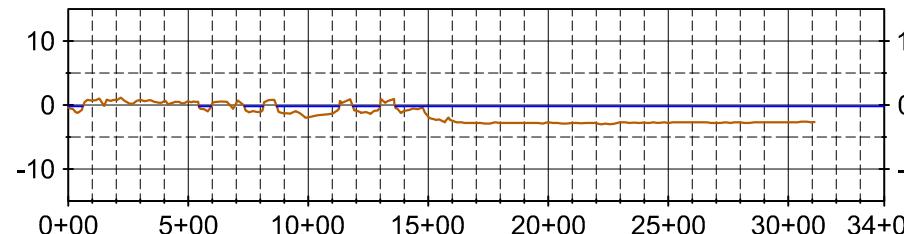
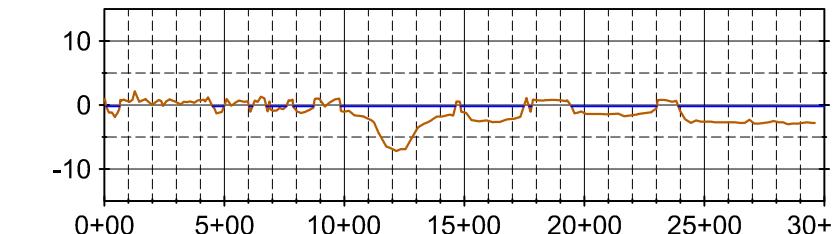
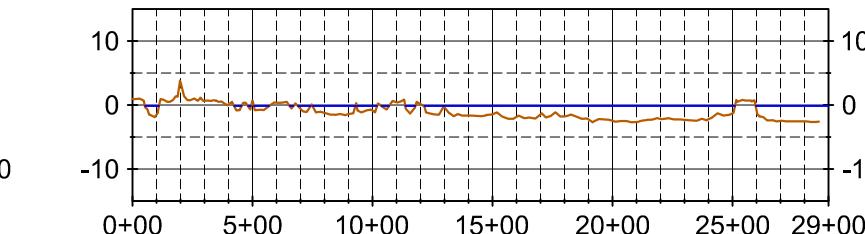
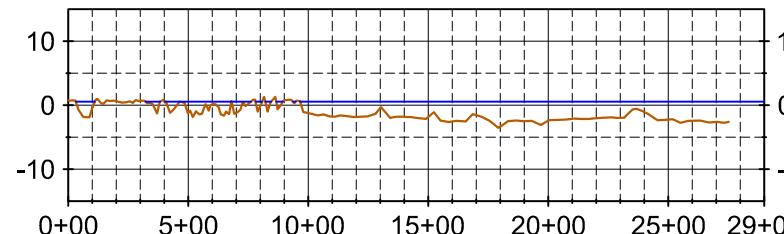
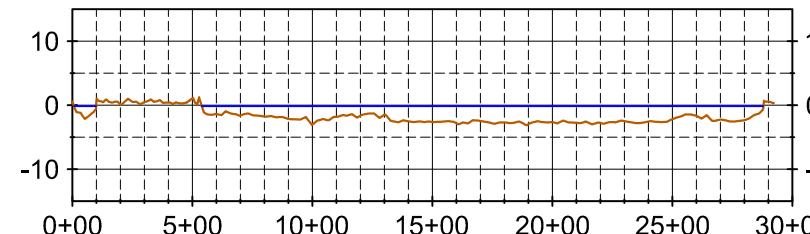
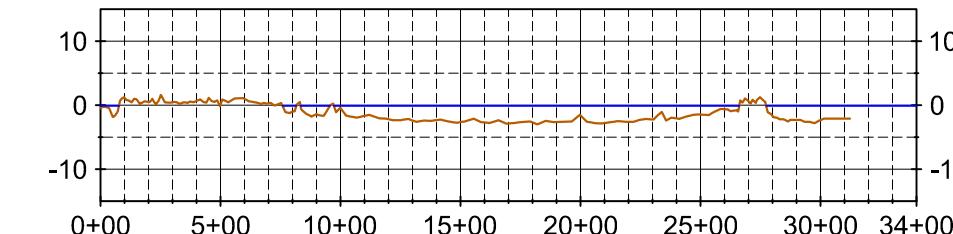
COASTAL PROTECTION AND RESTORATION AUTHORITY
450 LAUREL STREET
BATON ROUGE, LOUISIANA 70801

DRAWN BY: JP DESIGNED BY:

APPROVED BY: SHEET 9 OF 13

BAYOU GRANDE CHENIER
MARSH AND RIDGE RESTORATION
STATE PROJECT NUMBER: BA-173
FEDERAL PROJECT NUMBER: BA-173

PROFILE SHEET
DATE: JULY 2015

T12 PROFILE**T13 PROFILE****T14 PROFILE****T16 PROFILE****T17 PROFILE****T18 PROFILE****T19 PROFILE****T20 PROFILE****T21 PROFILE****T22 PROFILE****T23 PROFILE****T24 PROFILE****T25 PROFILE****T26 PROFILE****T27 PROFILE****T28 PROFILE**

LEGEND
— NATURAL GROUND
— WATER ELEVATION











HORIZONTAL SCALE				
800'	400'	0'	800'	1600'
VERTICAL SCALE				
30'	15'	0'	30'	60'
REV.	DATE	DESCRIPTION	BY	

EMC, Inc.
SPECIALISTS IN SURVEYING & MAPPING
Web Address: <http://www.emcsurvey.com>
2472 SUNSET DR. • GRENADE, MS 38901 • Ph. (662) 226-5166 • Fax (662) 226-5170
CENTER POINT, LA • PUNTA GORDA, FL • HOUSTON, TX

COASTAL PROTECTION AND RESTORATION AUTHORITY
450 LAUREL STREET
BATON ROUGE, LOUISIANA 70801
DRAWN BY: JP DESIGNED BY:
APPROVED BY:

BAYOU GRANDE CHENIER MARSH AND RIDGE RESTORATION
STATE PROJECT NUMBER: BA-173
FEDERAL PROJECT NUMBER: BA-173
APPROVED BY:

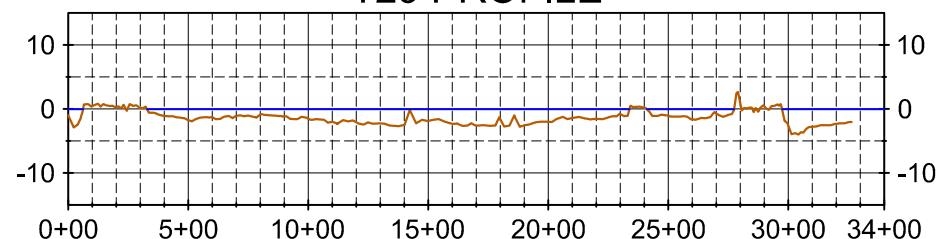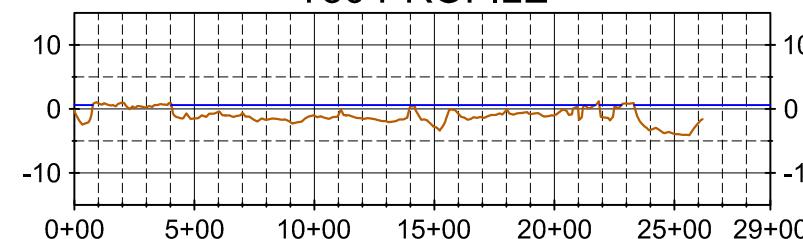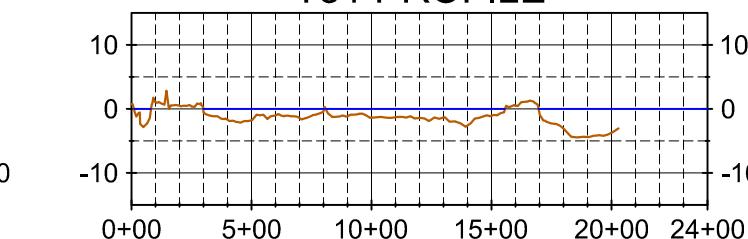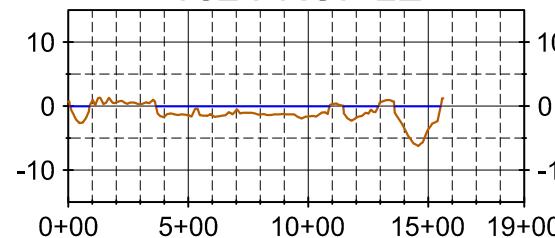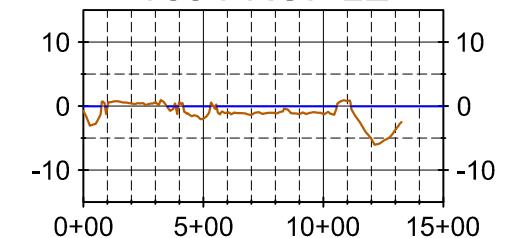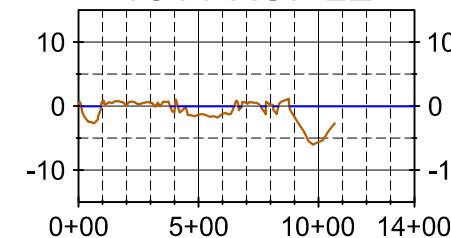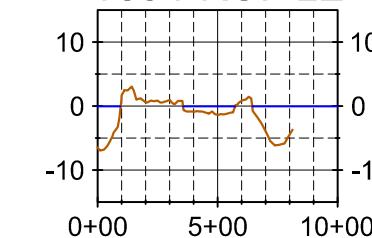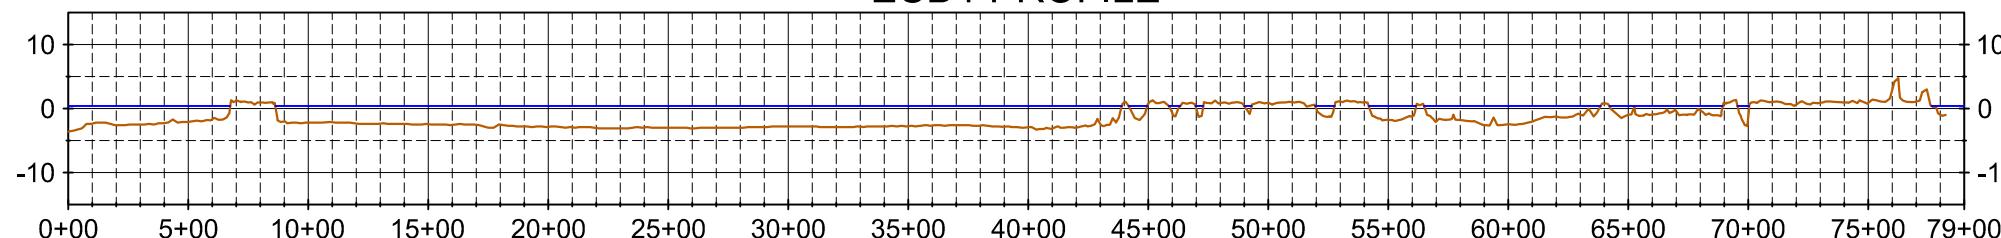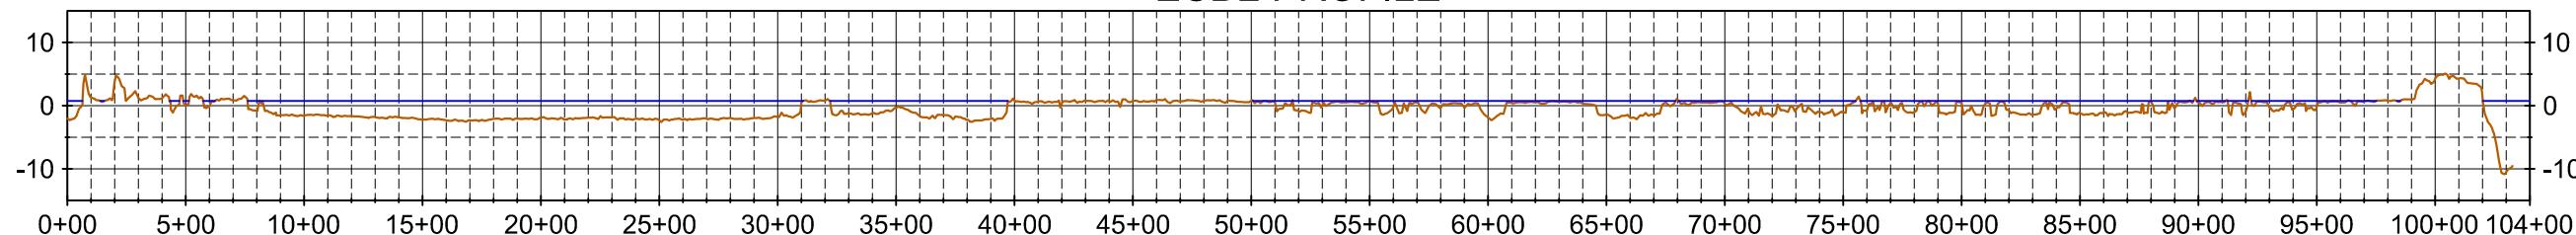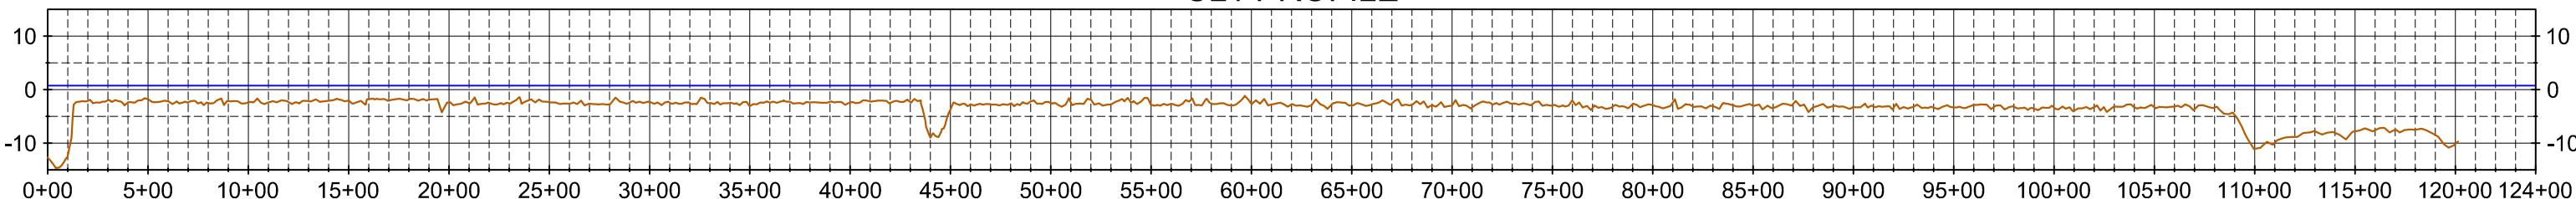PROFILE SHEET
DATE: JULY 2015
SHEET 10 OF 13

T29 PROFILE**T30 PROFILE****T31 PROFILE****T32 PROFILE****T33 PROFILE****T34 PROFILE****T35 PROFILE****ECD1 PROFILE****ECD2 PROFILE****CL1 PROFILE**

HORIZONTAL SCALE
800' 400' 0' 800' 1600'

VERTICAL SCALE
30' 15' 0' 30' 60'

REV.	DATE	DESCRIPTION	BY



COASTAL PROTECTION AND RESTORATION AUTHORITY
450 LAUREL STREET
BATON ROUGE, LOUISIANA 70801

DRAWN BY: JP DESIGNED BY:

BAYOU GRANDE CHENIER
MARSH AND RIDGE RESTORATION
STATE PROJECT NUMBER: BA-173

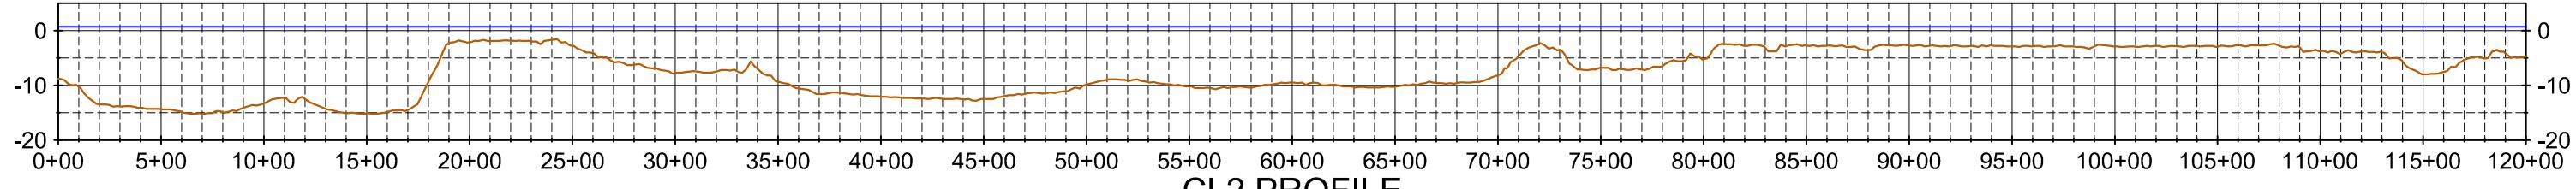
FEDERAL PROJECT NUMBER: BA-173

PROFILE SHEET
DATE: JULY 2015


APPROVED BY:

SHEET 11 OF 13


CL2 PROFILE




CL2 PROFILE

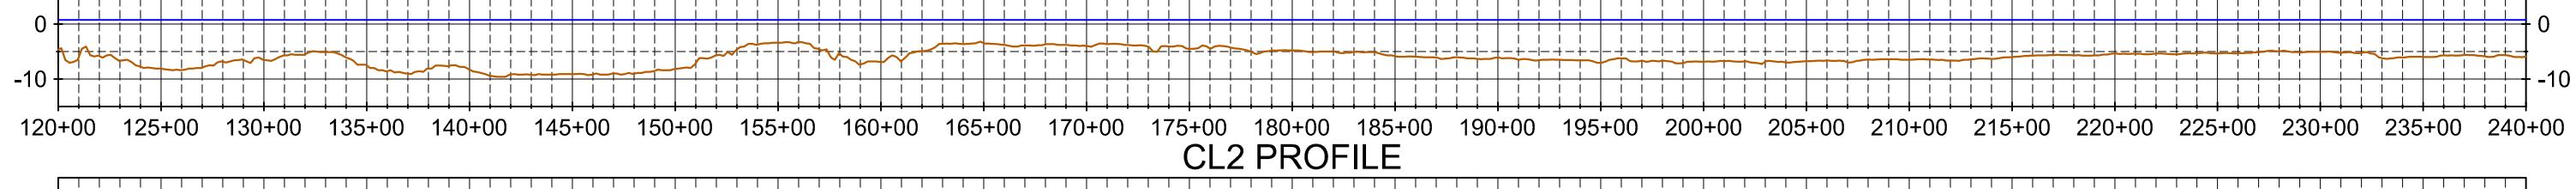


CL2 PROFILE

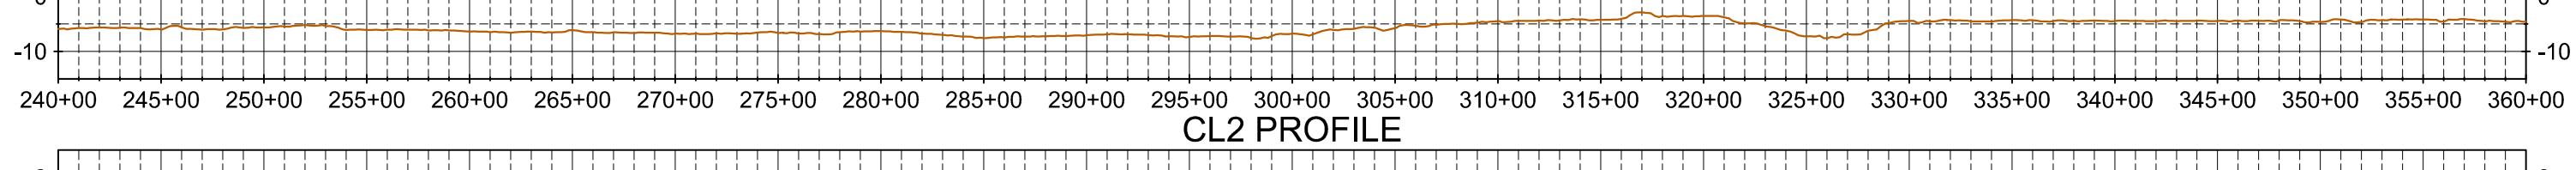


CL2 PROFILE

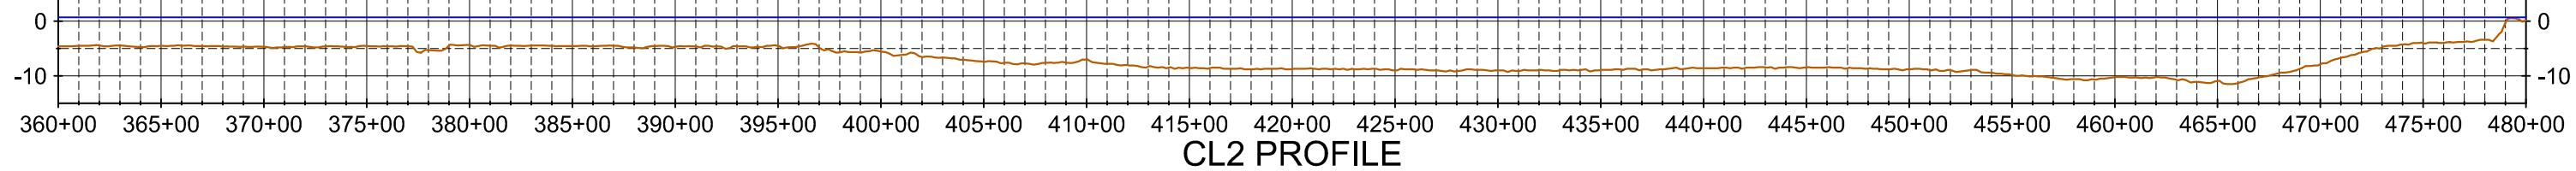


CL2 PROFILE

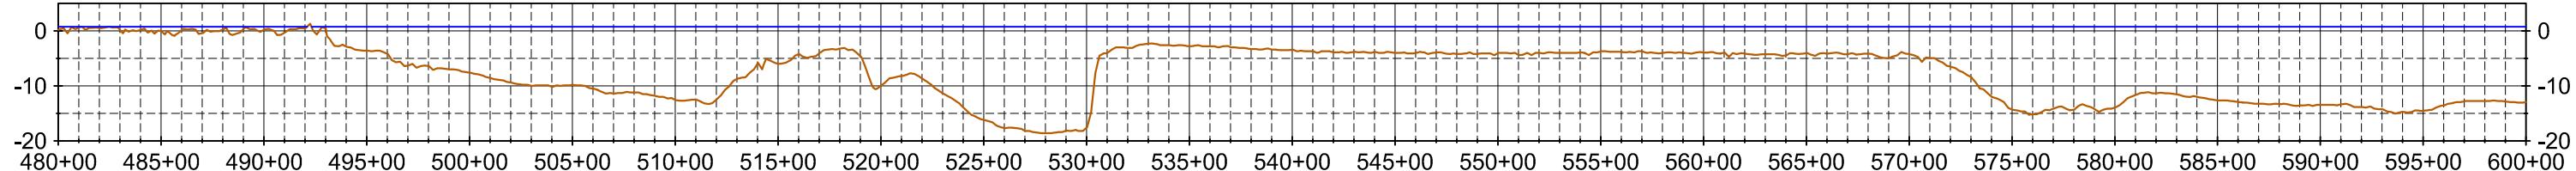


CL2 PROFILE

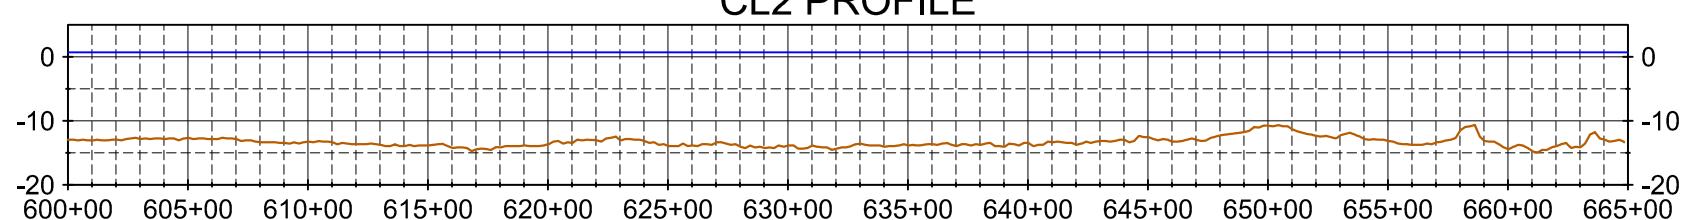

CL3 PROFILE

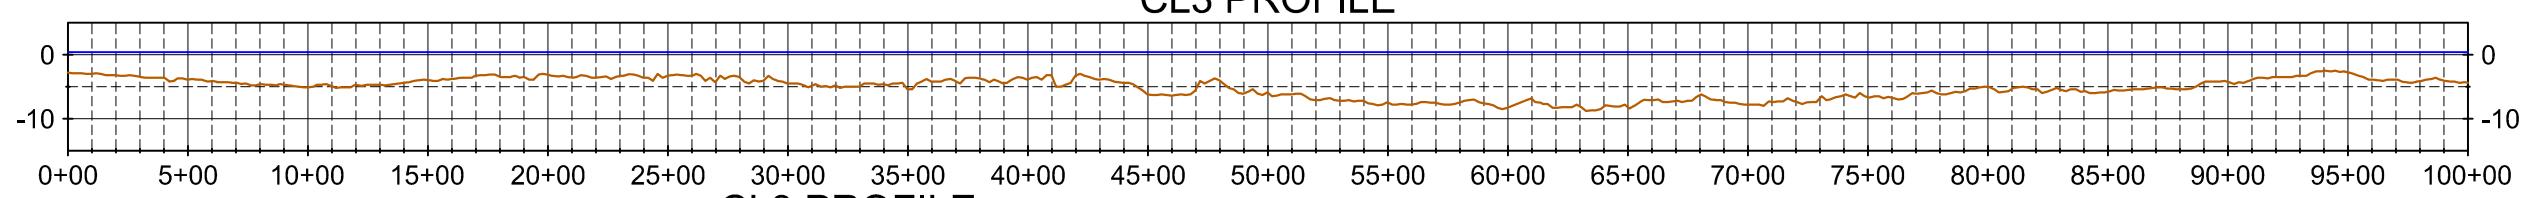

CL3 PROFILE

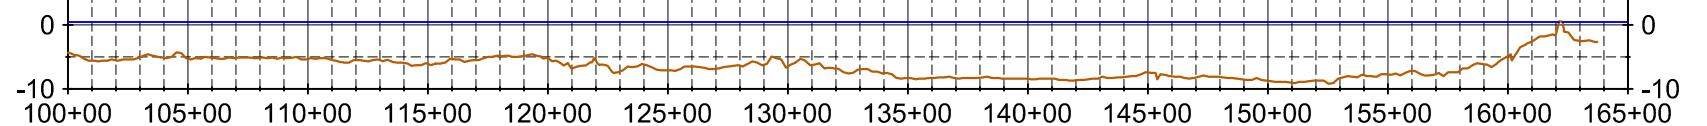

HORIZONTAL SCALE
800' 400' 0' 800' 1600'

VERTICAL SCALE
30' 15' 0' 30' 60'

REV.	DATE	DESCRIPTION	BY



COASTAL PROTECTION AND
RESTORATION AUTHORITY
450 LAUREL STREET
BATON ROUGE, LOUISIANA 70801

DRAWN BY: JP

DESIGNED BY:

BAYOU GRANDE CHENIER
MARSH AND RIDGE RESTORATION

STATE PROJECT NUMBER: BA-173

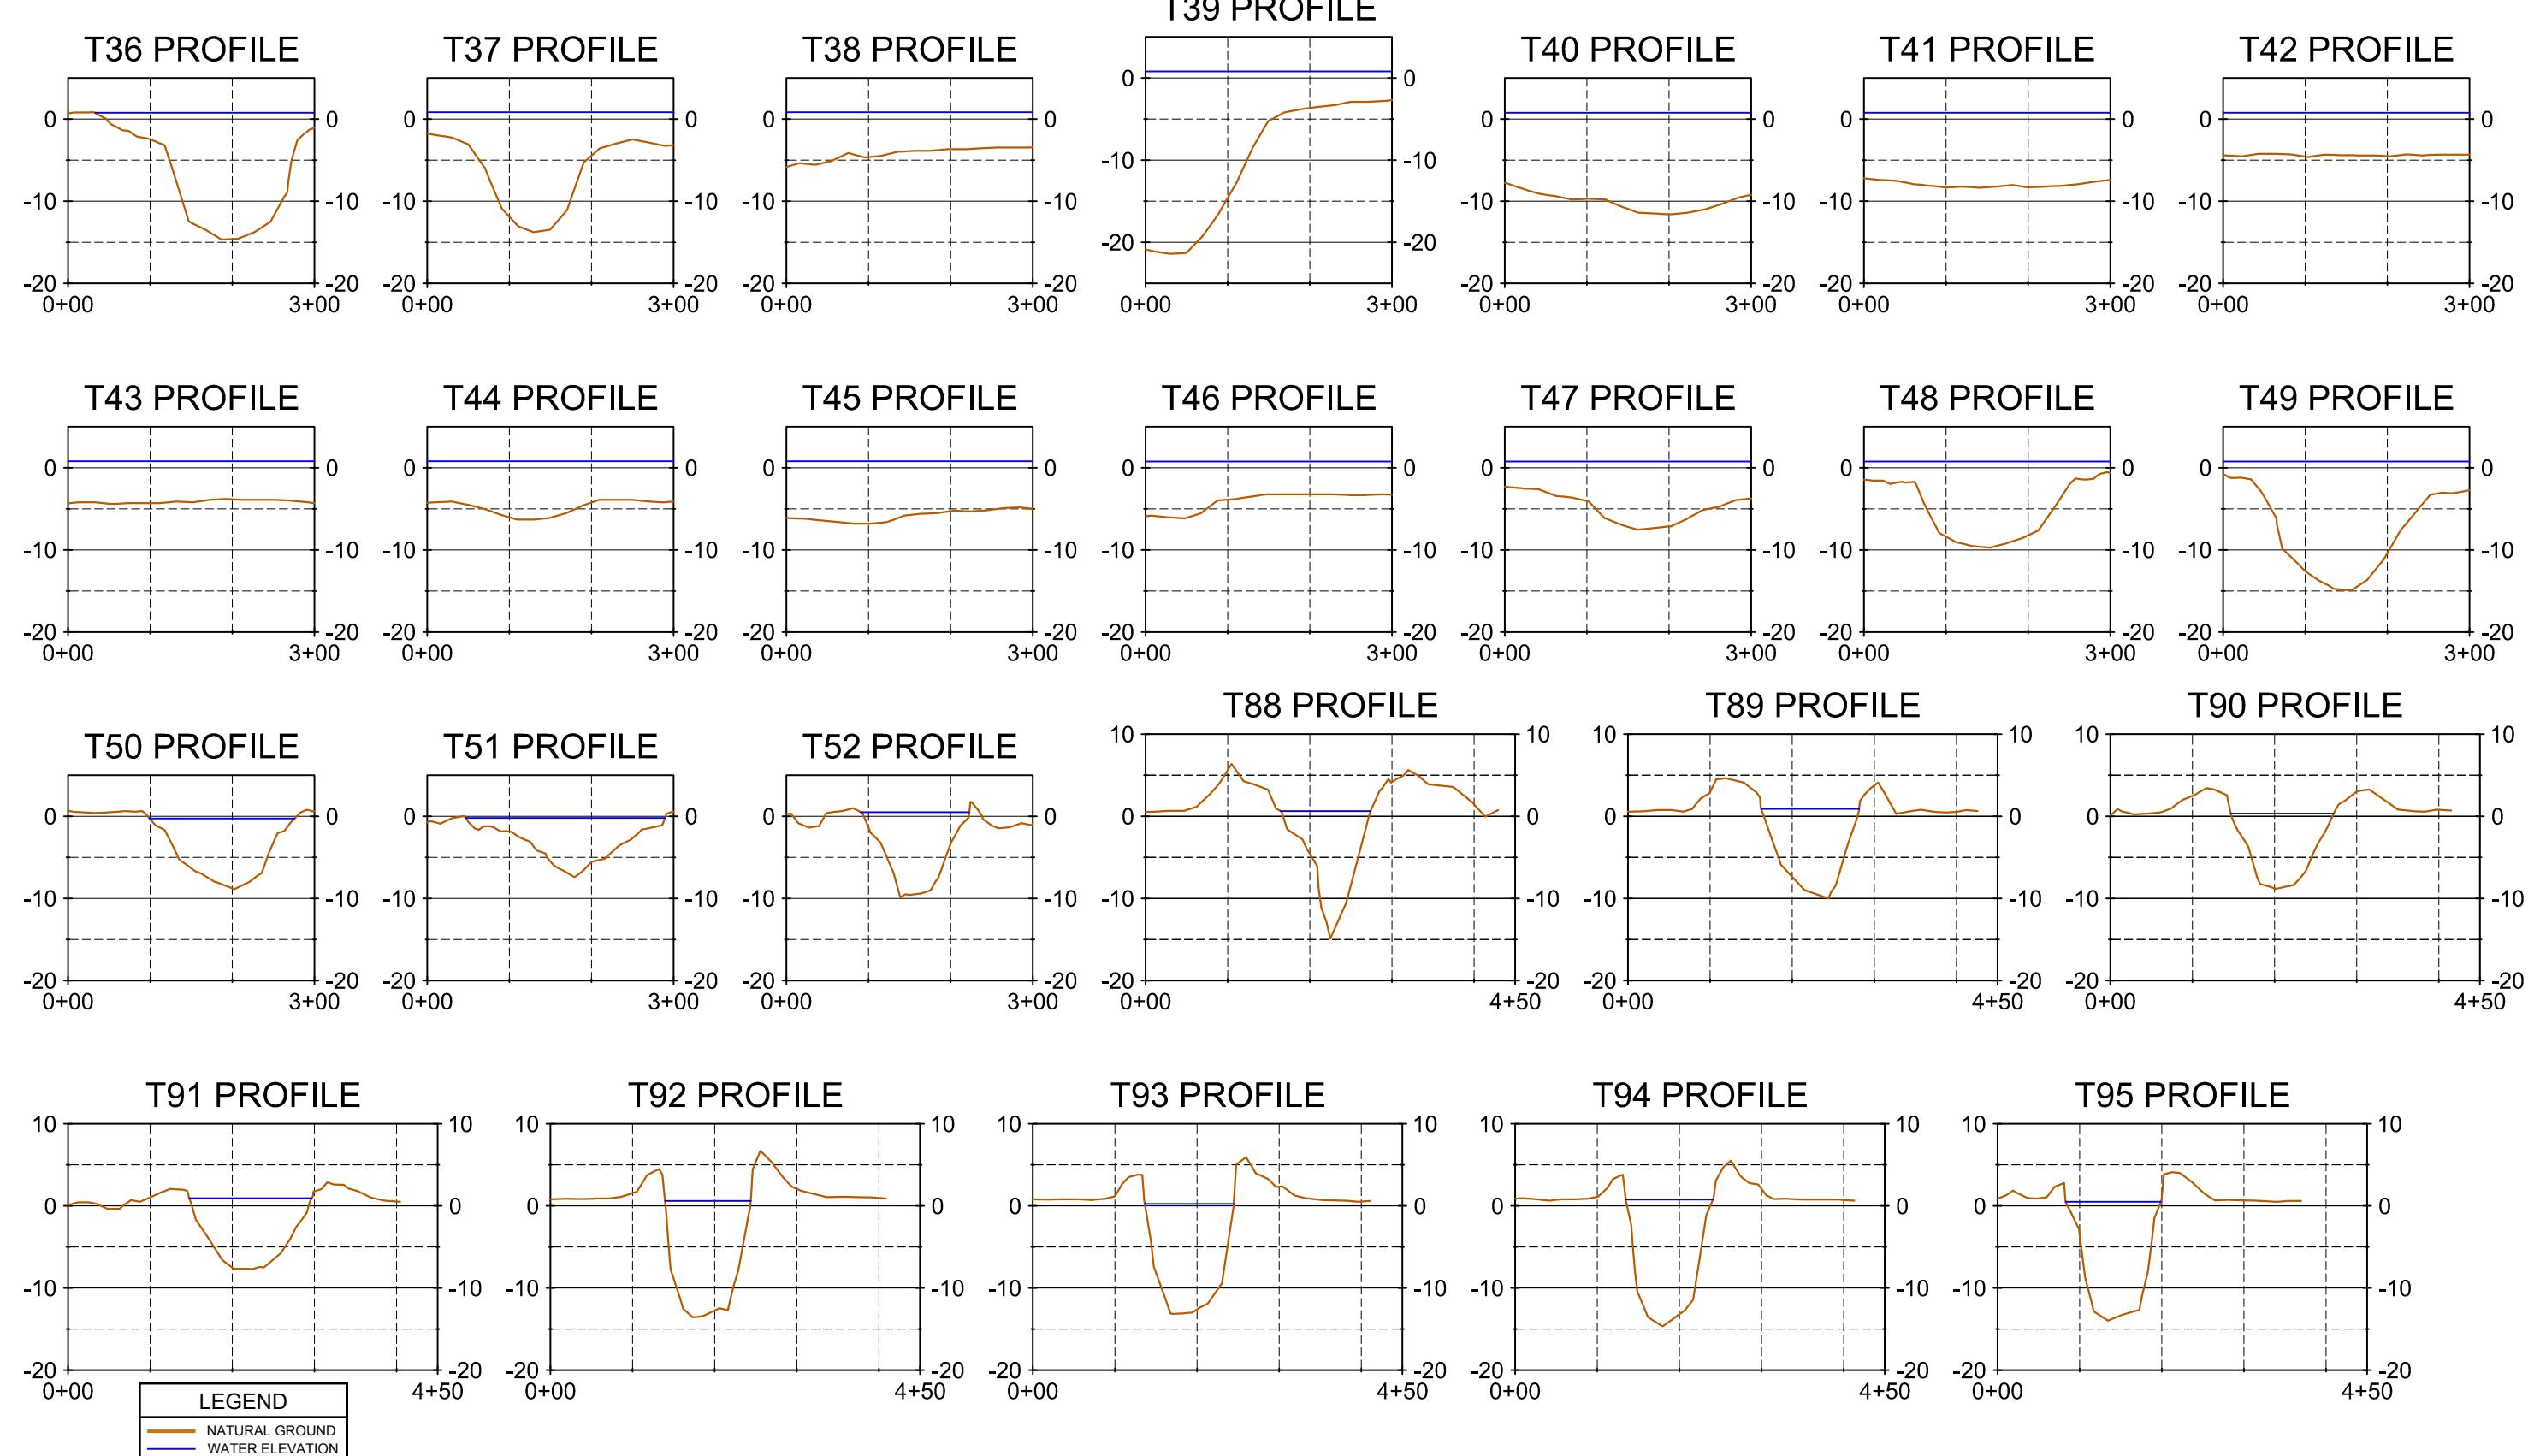
FEDERAL PROJECT NUMBER: BA-173

PROFILE
SHEET

DATE: JULY 2015

APPROVED BY:

SHEET 12 OF 13



200'	100'	0'	200'	400'	HORIZONTAL SCALE
20'	10'	0'	20'	40'	VERTICAL SCALE

REV. DATE DESCRIPTION BY



COASTAL PROTECTION AND
RESTORATION AUTHORITY
450 LAUREL STREET
BATON ROUGE, LOUISIANA 70801

DRAWN BY: JP	DESIGNED BY:	APPROVED BY:
--------------	--------------	--------------

BAYOU GRANDE CHENIER
MARSH AND RIDGE RESTORATION
STATE PROJECT NUMBER: BA-173

FEDERAL PROJECT NUMBER: BA-173

PROFILE
SHEET

DATE: JULY 2015

SHEET 13 OF 13

Section 7: Field Notes

I

BAYOU GRAND CHERIER

MARSH AND RIDGE RESTORATION

BA - 173

TOPOGRAPHIC, BATHYMETRIC, MAGNETOMETRIC

PLAQUEMINES PARISH, LA

APRIL 2015

CONTRACT NO.:

SURVEY BY: E.M.C. INC.
GRENADE, MS.

ITEM: RA-173

SURVEY PRY: R. HUTCHINSON SR
R. HUTCHINSON JR
C. PERRITT

INDEX

PAGE

CONTENTS

- 1 Gage Readings
 2-3 Hydro C/L Profile
 4 Hydro Lines
 5 Gage Readings
 6 Hydro Lines
 7 Gage Readings
 8-11 Hydro Lines
 12 Gage Readings
 13-18 Hydro Lines
 19 Base Setup Check
 20 Tying Existing Gage
 21 RTK Lines T-1
 22 RTK Base Setup Check
 23 IR GBC-1
 24 IR GBC-2
 25-29 T LINE T-2 To T-9
 30 RTK Base Setup Check
 31-35 Line T-7 To T-11
 36 Base Setup Check
 37-44 Line T-11 To T-19

CONT'D NEXT Pg

INDEX CONT'D

Page	CONTENTS
45	BASE SETUP, Check
46	T-16
47-50	T-20 TO T-31
51	BASE SETUP, Check
52-53	LINE: T-32 TO T-35 T-35
54-58	LINE T-34 TO T-30
59	BASE SETUP, Check
60-63	LINE T-29 TO T-24
64	BASE SETUP, Check
65-66	LINE T-23 - T-19
67	BASE SETUP, Check
68	C/L PROFILE ON CANAL
69	LINE T-17
70	PROFILE OF SMALL ISLANDS
71	LINE T-50 TO T-52

Gage Readings

Gage
Reading

Time

1.18

09:36

1.30

12:05

1.45

14:23

04/08/15

Date

APRIL 08, 2015

" "

" " "

H₂O Lines % Profile

File: BB098-CLI.RAW AZ-310
BB098-CLIA.RAW 331
BB098-CLIB.RAW 344

04/08/15 C

Description

Center line profile

Line %L 3

%L PROFILE HYDRO

Files: BB09A - CL3 - RAW

BB09A - CL3A.RAW

BB09A - ~~CL3B~~ CL3B - RAW

BB09A - CL3C.RAW

04/08/15

3

Hydro Line

T - 1

File: BB09A - T1. RAW

Hydro Line T2

File: BB09A - T2. RAW

File: BB09A - T3. RAW

File: ~~BB09A~~ BB09A - T2A. RAW

File: BB09A - T3A. RAW

BB09A - T3B. RAW

BB09A - T3C. RAW

04/08/15

4

Need RTK

Delete *

Need RTK

* DELETE *

Need RTK

Hydro Lines
Gage Readings

Gage
Readings

Time

1.56

12:49

1.66

15:00

DATE:

APRIL 09, 2015

5

Hydro Lines

Line T-4

File :

BB099 - T4

BB099 - T4A

Line T-5

File :

BB099 - T5

BB099 - T5A

Line T-6

File :

BB099 - T6

BB099 - T6A

BB099 - T6B

BB099 - T6C

File :

BB09 - T7

04/09/15

6

NEEDS SOME RTK

NEEDS RTK

Needs RTK

* Delete

80

Gage Readings

Gage
Readings

Time

1.0

8:30

1.4

14:00

04/10/15

2

DATE

APR. 10, 2015

APR. 10, 2015

Hydro Lines

Line T-8

File

BB100-T8 . RAW
BB100-T8A . RAW
BB100-T8B . RAW

Line T9

BB100-T9 . RAW
BB100-T9A . RAW

Line T10

BB100-T10 . RAW
BB100-T10A . RAW

04/10/15

Needs RTK

Needs some RTK

Needs a little RTK

Hydro Lines

Line T-11

File

BB100-T11.RAW

BB100-T11A.RAW

BB100-T11B.RAW

BB100-T11D.RAW

BB100-T11E.RAW

LINE ~~T-12~~ T-12

File:

BB100-T12.RAW

BB100-T12A.RAW

BB100-T12B.RAW

BB100-T12C.RAW

04/10/15

5

* DELETE * NEED TO RTK

* DELETE * NEED TO RTK

NEEDS RTK

NOTE: DELETE BB100-T11C

NEED RTK

Hydro Lines

LINE T-13

FILE

BB100 ~~T~~ 13.RAW

BB100 - T13A.RAW

File

BB100 - T14.RAW

BB100 - T14A.RAW

File

BB100 - T15.RAW

BB100 - T15A.RAW

08/10/15

NECA RTK

NECA RTK

NECA RTK

Hydro Lines

Line ECA 1

File:

BB100 - ECDI. RAW

BB100 - ECDIA. RAW

04/10/15

11

NEER RTK on ISLAND

Gage ReadingsGage
Readings

Time

0.6

08:00

0.75

11:10

1.0

14:35

04/11/15

DATE:

APR. 11, 2015

APR. 11, 2015

04/11/15

Hydro Lines

Line T-16

File

BB101 - T16

Line T-17

File

BB101 - T17

BB101 - T17A

Line T-18

File

BB101 - T18

Line T-19

File

BB101 - T19

69/11/15

HILLS LAND

NEEDS RTK ON LAND

NEEDS RTK ON ISLANDS

NEED RTK ACROSS LAND

NEED RTK ACROSS LAND

Hydro Lines

Line T-20

File BB101-T20.RAW

Line T-21

File BB101-T21.RAW

Line T22

File BB101-T22.RAW

Line T-23.

File BB101-T23.RAW

09/11/15

NEED RTK ACROSS LAND

NEED RTK ACROSS LAND

NEED RTK ACROSS LAND

NEED RTK ACROSS LAND ? BETWEEN ISLANDS

Hydro Lines

Line T24

File

~~BB101 - T24 *DELETE*~~

BB101 - T24A.RAW

BB101 - T24B.RAW

BB101 - T24C.RAW

Line T25

File

BB101 - T25.RAW

BB101 - T25A.RAW

~~BB101 - T25B.RAW~~


Line T26

File

BB101 - T26.RAW

04/11/15

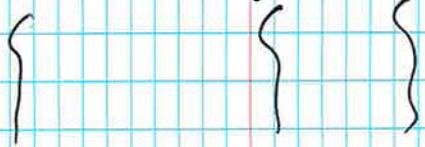~~NEED RTK ON RIDGES, ISLANDS~~



Needs RTK Across Ridges & Islands

Needs some RTK

Hydro Lines

Line T27

FILE BB101-T27.RAW

Line T-28

FILE BB101-T28.RAW

Line T-29

FILE BB101-~~T29~~T29.RAW

FILE BB101-T29A.RAW

04/11/15

Needs RTK on Ridges & ISLANDS

Needs RTK ON RIDGES & ISLANDS

Needs RTK ON RIDGES & ISLANDS

Hydro Lines

Line T-30

File BB101-T30.RAW ~~X~~ Delete ~~X~~ NEED RTK ON LAND
BB101-T30A.RAW

Line T-31

File BB101-T31.RAW NEED RTK ON BANKS

Line T-32

File BB101-T32.RAW

Hydro Lines

Line - 33

File

BB101 - T33. RAW

Line T - 34

File

BB101 - T34. RAW

Line T - 35

File

BB101 - T35

04/11/15

NEED RTK ON BANKS

NEED RTK ON RAMPS

~~NEED RTK ON BANK~~

RTK BASE Setup

BASE e IRGCB-1

TRIMBLE R8 No

ANT HT 2.00 meters

N-385290.369 E-3755335.991 EL. 0.957

Check on IRGCB-2

PG N-379603.248 E-3755927.133 EL. 1.320

FWD N-379603.257 E-3755927.142 EL. 1.337

FWD N.

FILE: GB GBC-HC 04/13/15¹⁴

15

Rover unit

TRIMBLE R8 No

ANT HT 2.00 meters

Gage CRMS 0260 - H01

PT No CODE ANT/HY

101 Post ~~6.562~~^{0.560}

102 NAIL 6.562

103 Gage "

GAGE
ReADING TIME

1.10 08:300

File: GAGE - HC

04/13/15 20

ITEM DESCRIPTION

Top of 4" x 4" Post

Top of 6" x 6" Nail

SHOT at 3.00 FT mark of Gage

PHOTO NO 5046

Line T-1

At No Code ANTH
X104-125 SNS 6.562

~~Line T-2~~

08/19/15

21

Description

Shallow in open water

RTK BASE SETUP

BASE @ IR GBC-1
TRIMBLE R8 NO 5257
ANT HT. 2.000 METERS

Check on IR-GBC-2

PUB N. 3796 03.248 E 3755927.133 EL. 1.320
END N. 3796 03.259 E 3755927.107 EL. 1.305
END N. 3796 03.229 E 3755927.109 EL. 1.285

FILE: 5257/1²²

START:

END:

FILE:

04/22/15

22

Rover unit

Trimble R8 No 0906
Ant Ht 2.000

N 500

N ~~256~~ 755

IR GBC-1

IR GBC-1 is a $\frac{3}{4}$ "
IRON ROD 12.0 FT IN
LENGTH. SET 0.2 FT.
ABOVE GRAVE. LOCATED
312 FT EAST OF POINT
OF MARSH GRASS.

1,000.0 FT. WEST OF BOAT
RAMP. 35. FT BACK OF
SOUTH TBLK OF CANAL

HAND HELD POSITION
LAT - 29-33-03.0
Long 89-49-42.2

23

04/22/15



N

S

IR GBC-1

IR GBC-2

IR GBC-2 is a $\frac{3}{4}$ "
IRON ROD 12 FT IN
LENGTH. SET 0.3 FT
ABOVE GROUND. SET 37.0
SOUTH OF TDK OF CANAL
AND 34 FT EAST OF TDE
OF CANAL.


HAND HELD POSITION

LAT 29-32-07.1

LONG 89-50-21.5

04/22/15

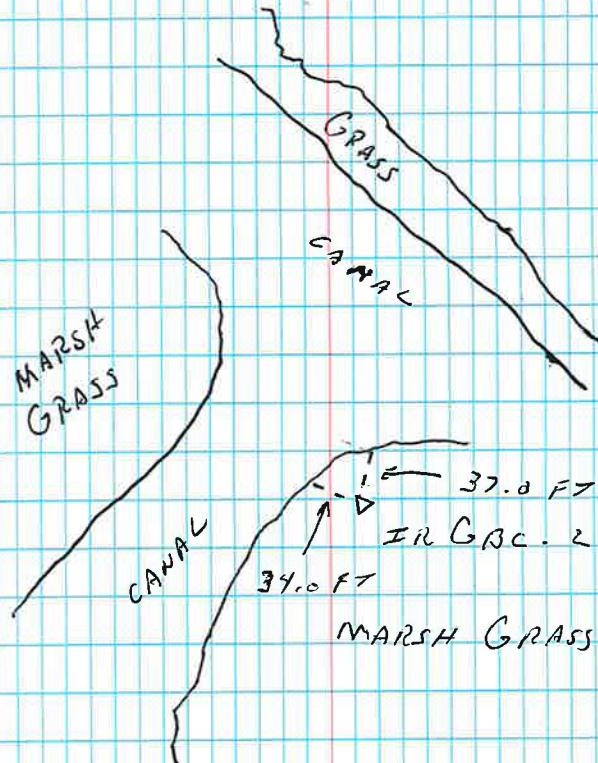A
N



Line T-2 RTK

PT No. Code Ant HR

X501 SNS G.56L

X502 WE "

X503 TBK "

X504 MSH "

X527 TBK "

X528 WE "

~~X529~~ ~~WE~~ SNS "

544 WE "

545 TBK "

546 MSH "

553 ~~TBK~~ MSH "

554 WE MSH "

558 TBK "

559 WE "

560-627 SNS "

04/22/15

Description

SOUNDING

W/E @ EDGE OF GRASS

TBK MARSH

NS

TBK CANAL

W/E "

SHOT IN CANAL

W/E "

TBK CANAL

NS MARSH

~~TBK~~ "

~~WE~~ LATE MARSH

TBK LAKE

W/E W/E

SHOT IN LAKE

Line T-3 RTK

Ptno Case ANTH

X628 SNA 6.5G

X630 W/E "

X631 TJK "

633 W/E "

X634 SNA "

X649 W/E "

X650 TJK "

X651 1454 "

File:

04/22/18

Description

SHOT IN LAKE

W/E " "

TJK "

W/E "

SHOT IN LAKE

W/E A LAND

TJK

~~1454~~ Grass

Line T-4 RTK

27

PT NO.	CODE	ANT/FIT
X654	SNO	6.56L
X654	WE	6.56L
X656	TOK	"
X652	WE	"
X653	SNO	"
X659	WE	"
X660	TOK	"
X661	M5H	"
X663	TOK	"
X664	WE WE	"
X665-80	SNO	"

Description

~~SHOT IN LAKE~~~~W/LC @ ISLAND~~~~TOK @ T Blk ISLAND~~

W/LC @ ISLAND

SHOT IN CANAL

W/LC @ ISLAND

TOK "

W/LC IN GRASS

TOK LAKE

WE

SHOT IN LAKE

04/22/15

Line T-5 RTK

PT NO	CASE	ACT RD
X630	SNO	G.SLR
X681	WE	"
682-83	TAK	"
684	WE	"
685	SNO	"
690	WE	"
691	TAK	"
692	MSH	"
698	TAK	"
699	WB	"
700	SNO	"
708	WE	"
709	TAK	"
710-11	MSH	"
712	TAK	"

04/22/15

Description

SHOT IN LAKE
W/E C ISLANDS
TAK "
W/E C "
SHOT IN LAKE
W/E C ISLANDS
TAK "
NG BRUSH
TAK
W/E
SHOT IN CANAL
W/E C ISLANDS
TAK "
SHOT ON ISLANDS
TAK "

Line T-6 RTK

PT NO	CODE	ANT HT
-------	------	--------

X713	SNO	6.562
X718	WE	"
X719	TBK	"
X720	1XSH	"
X722	TBK	"
X723	WE	"
X724	SNO	"
X740	WE	"
X741	TBK	"
X742	MSH	"
X744	TBK	"
X745	WE	"
X746- 54 ⁵⁴	SNO	"

04/22/15

Description

SHOT IN CANAL

W/E @ ISLANDS

TBK " "

SHOT ON ISLANDS

TBK "

W/E @ "

SHOT IN LAKE

W/E @ ISLANDS

TBK @ "

SHOT ON ISLANDS

TBK ISLANDS

W/E "

SHOT IN LAKE

RTK BASE SETUP

BASE @ IR GBC-1

TRIMBLE R8 NO 5257

ANT HT 2.000 METERS

CHECK ON IR GBC-2

PUB N 379603.248 E 3755927.133 EL 1.320

END N 379603.277 E 3755927.150 EL 1.305

END N 379603.219 E 3755927.112 EL 1.354

FILE : 52571130

START : 13:03

END : 18:56

FILE: GrandChenier

04/23/15

Rover unit

TRIMBLE R8 NO 0906

ANT HT. 2.000 METERS

PT 756

PT 970

RTK Line T-T RTK

PT NO	CODE	ANT HT
X 757	SNO	6.562
X 758	WE	"
X 759	TBK	"
X 760	M512	"
X 762	TBK	"
X 763	WE	"
X 764-68	SNO	"


Description

SHOT in LAKE

W/E "

TBK ISLAND

MSH on "

TBK ISLAND

W/E "

SHOT in CANAL

Line T-8 RTK

PT No Code Aut At

X769 SNO 6.562

X777 WE "

X778 TBK "

X779 MSH "

X787 TBK "

X788 WE "

X789 SNO "

X807 WE "

X808 TBK "

X809 MSH "

823 TBK "

824 WE "

825-831 SNO "

»

File: GRANU CHEWICK

04/23/15

32

Description

SHOT IN LAKE

W/E C ISLAND

TBK "

NJ MARSH GRASS

TBK ISLANDS

W/E S

SHOT IN CANAL

W/E C ISLAND

TBK "

NJ MARSH GRASS

TBK ISLANDS

W/E G

SHOT IN CANAL

Line T.S RTK

A-Td Cane ALT

X 832	SNA	6.562
88838	WE MSH	"
880	WE	"
841	TBK	"
842	MSH	"
843	TBK	"
844	WE	"
845-51	SNA	"

878	SNA	"
882	WE	"
882	TBK	"
884	MSH	"
885	TBK	"

File: GRANDE CHANICE

04/23/15

Description

SHOT IN CANAL
~~W/E~~ ISLANDS & MARSH GRASS
 W/E & ISLANDS
 TBK & "
 SHOT ON ISLANDS
 TBK "
 W/E & "
 SHOT IN LAKE

SHOT IN CANAL
 W/E & ISLANDS
 TBK & "
 MSH MARSH
 TBK ISLANDS

LINE T-10 RTK

PTN#	CASE	ANT HT
852	SNA	6.562
857-59	MSH	"
860	SNA	"
868	WE	"
870	TOK	"
871	MSH	"
872	TBK	"
874	WE	"
875, 877	SNA	"

FILE: GRAND CHEROKEE

04/03/15

39

DESCRIPTION

SALT IN LAKE

EDGE GRASS IN WATER

NG "

WE @ ISLAND

TOK ISLAND

NG MSH

TBK ISLAND

WEC "

SHOT IN FLOODED MARSH

Line T-11 RTK

PR No Case ANT FT

X886 SNO 6.562

X892 WE "

X893 TBK "

X894 MSH "

X896 TBK "

X897 WE "

X898 SNO "

X907 WE "

X908 TBK "

X909 MSH "

X910 TBK "

X911 WE "

X912 SNO "

X927 ~~WE~~ MSH "

928 MSH "

X935 TBK "

X936 ~~WE~~

X937 SNO "

96-969 MSH "

FILE: GRAN CHENIER 04/23/15

35

Description

SHT IN CANAL

W/E C ISLAND

TBK C "

Ng IN MARSH GRASS

TBK C ISLAND

W/E C "

SHT IN LAKE

W/E C ISLAND

TBK C ISLAND

MSH Ng IN GRASS

TBK C ISLAND

WE C "

SHT IN OLD CHANNEL

Edge MARSH GRASS

Ng MARSH ON ISLAND

TBK C ISLAND

W/B

SHT IN CORE

Edge MARSH GRASS & W/E

RTK BASE SET UP

~~LINe T-91 CONTO RTK~~

Antenna Code

ANT165

BASE @ IRGC-1

TRIMBLE R8 No 5257

ANT HT 2.000 meters

Check on IRGC-1

PUB N-379603, 248 E. 3755927.133 E. 1.320

FWD N-379603, 284 E. 3755927.149 E. 1.305

FWD N-379603, 260 E. 3755927.149 E. 1.272

File: 52571140

START: 13:01

END:

File: GRANU CHEN-ER

24
04/03/15

Description

Rover UNIT

TRIMBLE R8 No 0906

ANT HT 2.000 METERS

PT 971

PT 1326

-

Line T-11 CONTO RT4

PT NO Cade ANT HT

x972	SND	G-562
x975	WE	"
x976	TOK	"
x977	MASH	"
x984	TOK	"
x985	WE	"
x986 - 983 SND		"

File: GRAND CHENIER

04/29/15

Description

SHOT IN SHALLOW WATER Between ISLANDS
 W/E @ ISLAND
 TOK "
 NG MARSH
 TSE ISLANDS
 W/E "
 SHOT in LAKE

Line T-12 RTK

Az No Case Azimuth

x994 SNO 6.562.

x999 WE "

x1000 TBK "

x1001 NS "

1008 TBK "

1009 WE "

1010 SNO "

1048 WE "

1049 ~~TBK~~ "

1050 MSH "

1063 TBK "

1064 WE "

1065 SNO "

1082 WE "

1083 TBK "

1084 MSH "

1091 TBK "

1092 WE "

1093 SNO "

File GRAND CHERIEZ

09/24/15

Description

SHOT IN CANAL

W/E C ISLAND

TBK C "

NS ON ISLAND

TBK @ ISLANDS

W/G "

SHOT IN LAKE

W/E C ISLANDS

TBK ISLAND

NS ON MARSH ISLAND

TBK OLD CANAL

WE " "

SHOT " "

~~WE~~ WE C ISLANDS

TBK @ "

NS ON MARSH ISLAND

TBK ISLAND

W/G

SHOT IN SHALLOW WATER

Line T-13 RTK

PT NO	CODE	ANT #
1108	SND	6.562
1113	WE	"
1114	TBK	"
1115	NJS	"
1126	TBK	"
1127	WE	"
1128-29	SND	"

T-14 RTK

PT NO	CODE	ANT #
1130	SND	6.562
1132	WE	"
1133	TBK	"
1134	NJS	"
1142	TBK	"
1143	WE	"
1144-51	SND	"

File: Grans cherier 04/24/15

Description

SHOT IN LAKE
W/E @ ISLANDS
TBK "
NG IN BRUSH ON ISLAND
TBK ISLANDS
W/E
SHOT IN CANAL

SHOT IN CANAL
W/E @ ISLANDS
TBK "
NG IN BRUSH ON ISLAND
TBK OF ISLANDS
W/E "
SHOT IN LAKE

Line T-15 RTK

PT NO	CASE	ANT AT
1152	SNO	6,262
1157	WE	"
1158	TBK	"
1159	NG	"
1170	TBK	"
1171	WE	"
1172	SNO	"
1180	WE	"
1181	TBK	"
1182	NG	"
1188	TBK	"
1189	WE	"
1190	SNO	"

FILE: GRAND C HENRICK

04/24/75

40

DESCRIPTION

SHOT IN LAKE

W/E ON ISLAND

TBK ON "

NG IN BRUSH ON ISLAND

TBK OF POCKET / BAY

WE " "

SNO IN POCKET

W/E IN "

TBK OF POCKET

NG IN BRUSH ON ISLAND

TBK OF ISLAND

WE " "

SHOT IN CANAL

Line T-16

Prno	Code	ANT HT
------	------	--------

X1192-01	SNA	6.562
X1202	WE	"
X1203	TBK	"
X1204	SNO	"
1211	WE	"
1212	TBK	"
1213-1222	Ng	"

1223	Ng	"
1224	TBK	"
1225	WE	"
1226	SNA	"
1231	WE	"
1232	TBK	"

File: Gramo Chancer 04/29/15

Description

SHOT IN LAKE
W/E C ISLANDS
TBK ISLANDS
SHOT IN LAKE
~~W/E C ISLANDS~~
TBK ISLANDS
NG IN BRUSH ON ISLAND

NG IN BRUSH
TBK CANAL
WE C "
SHOT IN CANAL
W/E OF CANAL
TBK CANAL

LINE T-17 12TH

PT NO Code ANT HT

X1233	MSH	6.562
1237	TBK	"
1238	WE	"
1239	SNA	"
X1244	WE	"
X1245	TBK	"
X1246	MSH	"
1257	TAK	"
1258	WE	"
1259-66	SNA	"

FILE: GRAND CHERICK

04/29/15

92

DESCRIPTION

NG MARSH

TBK CANAL

W/E "

SHOT IN CANAL

WE C CANAL

TBK

NG MARSH

TBK LAKE

W/E "

SHOT IN LAKE

Line T-18 TBK

AT Hs Coca Ant At

1267	TBK	6.562
1268	WE	"
1269-73	SNA	"
1274	MSH	"
1299	TAK	"
1300	WE	"
1301	SNO	"
1306	WE	"
1307	TBK	"
1308-9	MSH	"


DESCRIPTION

TOP OF ISLAND
W/E " "
SHOT IN LAKE
NO MARSH
TAK CANAL
W/E "
SHOT IN CANAL
WE @ CANAL
TBK CANAL
MARSH

Line T-19

PT NO	CODE	ANT HT
1312	TBK	6.568
1313	WE	"
1314	SNA	"
1324	WE	"
1325	TBK	"
1326		

File: Grand Chenier 09/29/15

44

Description

TBK CANAL

w/e "

SHOT IN CANAL

w/e e "

TBK "

MARSH

RTK BASE SCRAP

BASE c IR GBC-1
TRIMBLE R8 No 5257
ANT HT 2.000 METERS

CHECK ON GBC-2

Fwd N. 379603.248 E. 3755927.133 EL 1.320
Fwd N. 379603.268 E. 3755927.135 EL 1.335
Fwd N. 379603.249 E. 3755927.140 EL 1.253

FILE: ~~4252578150~~

START: 13:11

~~FILE: 4252578150~~:


45

ROCK UNIT:

TRIMBLE R8 No. 0906

ANT HT 2.000 meters

AT 1327

PT 1491

Line T-16 cont'd

anno code

Ant-HT

X1328-46 Ng

5.85

File: Grand Cenice

04/25/15

46

Description

Ng in Blush

Line T-20 RTK

PT NO	CASE	AUTMID
-------	------	--------

X1347	TBK	G.562
1348	WE	"
1349	SNS	"
X1350	WE	"
X1359	TBK	"

Line T-21 RTK

X1360	TBK	G.562
1361	WE	"
1362	SNS	"
1371	WE	"
1372	TBK	"

Line T-22 RTK

1373	TBK	G.562
1374	WE	"
1375	SNS	"
1381	WE	"
1382	TBK	"


Description

TBK CANAL
W/E C "
SHOT IN CANAL
W/E C CANAL
TBK "

TBK CANAL
WE
SHOT IN CANAL
WE
TBK "

TBK CANAL
W/E "
SHOT IN CANAL
WE
TBK "

Line T-23 RTK

RTNO	code	ANTHT
X1383	TBK	6.562
X1384	WE	"
X1385	SNO	"
1392	WE	"
1393	TBK	"

Line T-24 RTK

1394	MSH	6.562
X1395	TBK	"
1396	WE	"
1397	SNO	"
1403	WE	"
1404	TBK	"

T-25 RTK

1405	TBK	6.562
1406	WE	"
1407	SNO	"
X1411	WE	"
1414	TBK	"
1415-19	MSH	"

File: Grams Cherrick 04/25/15

Description

TBK CANAL.

W/E "

SHOT "

W/E "

TBK "

ASH MARSH

TBK CANAL

W/E C "

SHOT IN CANAL

W/E "

TBK "

TBK CANAL

W/E "

SHOT IN CANAL

W/E " "

TBK "

Ng MARSH

Line T-26

PT NO	CASE	ANTHR
X1420	MSH	6.562
X1424	TBK	"
X1425	WE	"
X1426	SNO	"
1431	WE	"
1432	TBK	"

Line T-27

X1433	MSH	6.562
1434	TBK	"
1435	WE	"
1436	SNO	"
1437	WE	"
1445	TBK	"

Line T-28

X1446	TBK	6.562
1447	WE	"
1448	SNO	"
X1455	WE	"
1456	TBK	"

File: GRONA CHEWICK

04/25/15

49

Description

NS MARSH
 TBK CANAL
 WE
 SHOT IN CANAL
 W/E
 TBK "

NS MARSH
 TBK CANAL
 WE "
 SHOT IN CANAL
 WE
 TBK

TBK CANAL
 WE
 SHOT IN CANAL
 W/E
 TBK "

Line T-29 RTK

PT NO	CODE	AUT HT
X1458	TBK	6.562
X1458	WE	"
14589	SND	"
1466	WE	"
1467	TBK	"

Line T-30 RTK

X1468	TBK	6.562
1469	WE	"
1470	SND	"
1477	WE	"
1478	TBK	"

Line T-31 RTK

X1479	MSH	6.562
X1480	TBK	"
1481	WE	"
1482	SND	"
1489	WE	"
1490	TBK	"

File: Grand Chenier 04/25/15

50

Description

TBK CANAL

W/E "

SHOT IN CANAL

WE "

TBK "

TBK CANAL

W/E "

SHOT IN "

W/E

TBK CANAL

NS MARSH

TBK CANAL

WE C "

SHOT IN "

WE C CANAL

TBK "

RTK BASE SETUP

STATION DATE ACTUAL

BASE & IR GBC-1
TRIMBLE R8 NO 5257
ANT HT 2.000 METERS

Check on IR GBC-2

Aug N. 379603.248 E. 3755927.133 EL 1.320

FMS N. 379603.246 E. 3755927.146 EL. 1.293

FMS N. 379603.317 E. 3755927.166 EL. 1.264

File: 52571160

START: 13:05

END:

51

File: GRANDE CHERICE 04/26/15

Description

Base unit
TRIMBLE R8 NO. 0806
ANT HT. 2.000 METERS

PT 1492

PT 1970

Line T-32 RTK

PT NO	LOC	ANT NT
-------	-----	--------

X1493	MASH TBK	6.562
X1494	TBK	"
X1495	WE	"
X1496	SND	"
1503	WE	"
1504	TBK	"

Line - T-33 RTK

1505	TBK	6.562
1506	WE	"
1507	SND	"
1514	WE	"
1515	TBK	"

Line T-34 RTK

1516	MASH	6.562
1517	TBK	"
1518	WE	"
1519	SND	"
1527	WE	"
1528	TBK	"

File: Grand Cenice

04/26/15

Description

NG MARSH

TBK CANAL

W/E "

SHOT IN CANAL

WE " "

TBK "

TBK CANAL

WE "

SHOT IN CANAL

WE "

TBK "

NG MARSH

TBK CANAL

W/E "

SHOT IN CANAL

WE "

TBK "

Line T-35 RTK

Pr No	Code	Ant Ht
X1529	TBK	6.562
X1530	WE	"
X1531	SNO	"
153L-41	SNO	10.52
1542	NSH	6.562
1543	WE	"
1544	SNO	"
1561	WE	"
1562	TBK	"
1563	NJ	"
1567	TBK	"
1568	WE	"
1569	SNO	"

File: GRAND CREEK 04/26/15

Description

TBK CANAL. @ EDGE BRUSH

W/E C "

SHOT IN CANAL

". "

EDGE MARSH GRASS

W/E IN MARSH

SHOT IN FLACED MARSH

W/E

TBK MARSH

NJ IN BRUSH

TBK CANAL

W/E C "

SHOT IN CANAL

Live T-34 cont'd

PT NO	CODE	ANT HT
X1570	SNA	6.562
X1571	WG	"
X1572	TAK	"
X1573	NS	"
X1575	MWH	"
X1576	WC	"
X1577	MS4	"
X1597	WE	"
X1598	SND	"
X1614	WE	"
X1615	TAK	

File: GRAND CHERICK 09/26/15

Description

SHOT IN CANAL

W/E "

TAK "

SHOT IN MARSH

EDGE MARSH

W/E @ MARSH

SHOT IN MARSH WATER, GRASS

W/E OF OPEN MARSH WATER

SHOT IN WATER OF MARSH

W/E @ GRASS LINE

TAK MARSH @ GRASS LINE

Line T-33 RTK

PT NO COOC ANT#

X1616 TJK 6,562

X1617 WE "

1618 SNO "

1628 WE "

1629 MSH "

1631 WG "

1632 SNA "

1670 WE "

1671 TJK "

1672 NS "

1675 TJK "

1676 WE "

1677 SNO "

File: GRANO Cienega 04/26/15

55

Description

TJK MARSH @ GRASS LINE

W/E MARSH @ " "

SHOT IN MARSH WATER

W/E @ ISLAND

IN MARSH GRASS

W/E @ ISLAND

SHOT IN OPEN WATER

W/E OF MARSH

TJK "

NS IN BRUSH

TJK CANAL

W/E "

SHOT IN CANAL

Line T-32 RTK

PT NO	CODE	ANT HT
1678	SRS	6.562
1679	TBK WE	"
1680	N TJK	"
1681	N ₅	"
1686	TBK	"
1687	WE	"
1688	SNA	"
169170	MSH	"
1709	SNA	"
1752	WE	"
1753	TBK	"

File: Grand Cherric 04/06/05

Description

SHOT IN CANAL

W/E E S

TBK CANAL

N₅ IN BRUSH

TBK MARSH

W/E "

SHOT IN OPEN WATER

ON SMALL ISLAND

SHOT IN OPEN WATER

W/E E MARSH

TBK E MARSH

Line T-31 RTK

Dr No	CONT'D	ANHHS
X1754	TBK	6.562
X1755	WE	"
X1756	SNO	"
X1835	W/E	"
1836	MST	"
1846	TBK	"
1847	W/E	"
1848	SNO	"

File: GRANA CHAINER 04/26/15

Description

TBK MARSH

WE C "

Sht in open water

W/E of marsh

MARSH GRASS

TBK CANAL

W/E C "

~~Sht~~ Sht in canal

Line T-30 RTIs

AP No.	Code	Altitude
X1849	MASH	6.566
X1850	SNS	"
X1865	MASH	"
X1866-70	MASH	"
X1871	SNS	"
1897	MASH	"
1898	MASH	"
1900	SNS MASH	"
1901	SNS	"
1968	WES	"
1969	TBLC	"

FILE: GRASS CUTTER 04/26/15 58

Description (Needs to extend to
both canals with bussy)

MARSH @ SMALL ISLAND

SHOT IN OPEN WATER

EDGE MARSH

NG MARSH & ISLAND

SHOT IN OPEN WATER

EDGE OF SMALL ISLAND

NG on " "

EDGE OF " "

SHOT IN OPEN WATER

N/E C MARSH

TBLC "

RTK BASE SETUP

PTN 0001

ANTHT

BASE C IN GBC-1

TRINOLE RB NO 5257

ANTHT 2.00 METERS

CHECK ON IR GBC-2

AUG N-379603.248 E-3755927.133 EL 1.320

FRA N-379603.280 E-3755927.171 EL 1.297

FUN -378603.247 E-3755927.140 EL 1.276

FILE: 15:51 5257 1180

START: 15:51

END:

FILE: GRAND CANYON

04/26/15

55

Description

ROVER UNIT

PT 1971

PT 2550

Line T-28 cont'd

AT NO	CODE	ANT/HY
-------	------	--------

X1972	MSH	6,562
-------	-----	-------

X1973	SNO	"
-------	-----	---

XZ079-83	MSH	"
----------	-----	---

Z084	SNO	"
------	-----	---

Z103	MSH	"
------	-----	---

Line T-28 cont'd RTK

Z104	MSH	6,562
------	-----	-------

Z105	SNO	"
------	-----	---

Z173	MSH	"
------	-----	---

File: A~~1~~-GRAND CANYON

09/28/15

Description

MARSH

SHOT IN OPEN WATER EXTENDS TO CANAL
IN MARSH GRASS

SHOT IN OPEN WATER

EDGE MARSH GRASS. (EXTENDS WITH BUGGY)

NG IN MARSH GRASS (EXTENDS WITH BUGGY)

SHOT IN OPEN WATER

SHOT IN MARSH GRASS EXTENDS TO CANAL

Line T-27 cont'd RTK

Br no	Code	ANTHT
X2174	MSH	6.562
2175-	SNA	"
2274		
2275-79	VME	"
2280	TBK	"
2281-83	MSH	"

Line T-26 cont'd RTK

2284	SNA	6.562
2286	MSH	"

L

File: GRAND CHERICK

04/28/15

Description

ING MASH GRASS (EXTEND TO CANAL)
SHRT IN CANAL

W/@ GRASS LINE
TBK OLD CHANNEL
MASH

SHRT IN OPEN WATER (BEGAN IN LAKE)
● MASH @ GRASS LINE

LINE ~~25~~ T2 R25 RTK

PT NO CODE ANT HT

2347 MS4 6.562

2384 SNO ..

2444 WE ..

2445 TJK ..

2446-49 MS4 ..

2450 WE ..

2451-54 SNO ..

File: Grand Cenier 04/28/15

62

Description

ICE MARS/ GRASS IN WATER (EXTENDS TO LAND)

SHOT IN OPEN WATER

W/E C ISLAND

TBK C ..

NG MARS/ GRASS

W/E C ISLAND

SHOT IN OPEN WATER

Line T-24 cont'd (RTK)

PT NO	CODE	ANT/HY
2455-58	SND	6.562
2459	WE	"
2460	TOP MSH	"
2467	TBK	"
2468	WE	"
2469	SND	"
2484	WE	"
2485	TBK	"
2486	MSH	"
2491	TBK	"
2492	WE	"
2493	SND	"
2506-07	MSH	"
2508	SND	"
2526	WE	"
2527	TBK	"
2528-31	MSH	"
2532	TBK	"
2533	WE	"
2534	SND	-
2540-43	MSH	"
2541	SND	"
2549	MSH	"

File: GRAND CHERICE

04/28/15

Description

SHOT IN OPEN WATER

W/E O ISLANDS

ACROSS MARSH & TAK

TBK ISLANDS

W/E CANAL

SHOT IN OLD CANAL

W/E O ISLANDS

TBK "

NO MARSH

TBK ISLANDS

W/E .. "

SHOT IN OPEN WATER

POINT OF ~~O~~ ISLANDS

SHOT ACROSS CANAL

WE O ISLANDS

TBK "

MARSH

TBK ISLANDS

W/E "

SHOT IN OPEN WATER

MARSH

SHOT IN OPEN WATER

NEAR EDGE MARSH

RTK Base Setup

Base @ IR GBc-1

Trimble R8 No 5257

ANT HT. 2.00 meters

Check on IR GBc-2

PUB N.379603.248 E.3755927.133 EL. 1.32

FWD N.379603.178 E.3755927.203 EL. 1.265

FWD N.379603.243 E.3755927.217 EL. 1.309

File : 52571240

START : 12:50

END :

File : ~~RTK~~ GRAN CADENIR 05/04/15

64

Rover unit

Trimble R8 No 0906

ANT HT. 2.00 meters

PT 0551

PT 073643

Line T-23

PT#₁₁₁₁ CODE ANT HT

X2552	SNO	6.562
Z570-	MASH	"
2644 ²⁴		

Line T-22

X2645 ²⁵	SNO	6.562
X2635	MASH	"
X2636-61	MASH	"

Line T21

X2662-63	SNO	6.562
X2669	Edge MASH	"
Z670-		
2714		

File: GRASS CHENIGR

05/04/15

65

Description

SHOT IN OPEN WATER IN MARSH
NG IN GRASS IN WATER (MARSH)

SHOT IN OPEN WATER
EDGE MARSH GRASS IN WATER (MARSH)
NG MARSH

SHOT IN OPEN WATER
EDGE MARSH
NG "

Line T-20

PTNO	CODE	AUTH#
X2715	SNS	6,562
2732	MSH	"
X2733	MSH	"

LINE T19

X2734	MSH	6,562
X2735-42	SNS	"

File: GRASS CHANGER 05/04/15
66

DESCRIPTION

Shot in open water
Edge MARSH Grass & water (MARSH)
MS " "

~~Shot in open water~~ Edge Grass
Shot in open water

RTK BASE Setup

Points Code Antennae

BASE @ IR GBC - 1
TRIMBLE R8 No 5257
ANT HT 2.000 METERS

Check on IR GBC - 2

PoB N 379603.248 E 3755927.133 EL 1.320
Fwd N 379603.265 E 3755927.133 EL 1.294
Fwd N 379603.412 E 3755927.146 EL 1.469

File: 52571250

START: 12:49

END:

File: Gross Clevier

05/04/15

67

Description

ROVER UNIT
TRIMBLE R8 No 0906
ANT HT 2.000 METERS

PT 2744

PT 3474

CL 1 Profile

Part No. Code Author

P2745	CL	10.52
P2747	CL	15.35
P2748	CL	10.52
P2987-89 CL		15.35
P2995	CL	10.52
P3334-	CL	15.35
3371		

File: Grand Chienick 05/05/15

Description

GL CANAL on CL 1

" " "

" " "

" " "

Lide T-17
~~Estano~~ ~~Pro~~ ~~Fixe~~

PTNO CODE ANTHM

X3372 SNO 6.5CL

X3381-82 WE "

X3383-88 SNO "

69

File: GRANU CHENIER 05/05/15

Description

SIGHT IN OPEN WATER

WE @ END OF ISLEANO

ISLAND PROFILE

PTN#	CODE	ANT HT
A3389	SNS	6.562
JJ95	WE	"
3396	NS	"
3410	WE	"
3411-13	SNS	"

FILE: GRANDE CHERNIER

05/05/15

70

DESCRIPTION

SHOT IN OPEN WATER @ ENS OF ISLAND
W/E @ ENS OF ISLANDS
SHOT ON ISLAND
W/E @ ENS OF ISLANDS
SHOT IN OPEN WATER

Line T-50

PRNS COOC ANY HT

X3414	TBK	10.52
3415	WE	"
3416	SNO	"
3420	SNO	15.35
3428	WE	"
3429	TBK	"

T-51

3430	TBK	5.85 10.52
3431	WE	5.85
3432	SNO	15.35
3456	WE	"
3457	TBK	"

File: GRASS CHERICK 05/05/15

Description

TBK CANAL

w/e "

SOUNDINGS

"

w/e / GRASS LINE

TBK in MARSH

TBK in MARSH

w/e OR GRASS LINE

SHOT in CANAL

w/e / GRASS LINE

TBK in MARSH

Line T52

AP No CONC ACT HT

XJ958	TBK	5.85
J459	WG	"
J460	SND	15.35
J472	WE	"
J473	TBK	"

File: GRASS CROWNIC

05/05/15

Description

TBK

w/c / GRASS Line

SHOT IN CROWN

W/c / C GRASS Line

TBK IN BIRDS

BAYOU GRANDE CHENIER

MARSH AND RIDGE RESTORATION

BA- 173

TOPOGRAPHIC, BATHYMETRIC, MAGNETOMETER

PLAQUEMINES PARISH, LA.

MAY 2015

CONTRACT NO:

ITEM NO : BA-173

SURVEY BY: E.M.C. INC.
GRENADA, MS.

SURVEY BY: R. HUTCHINSON SR
R. HUTCHINSON JR.
C. PERRIT

INDEX

Page

CONTENTS

- 1 BASE SETUP & CHECK
 2-3 Line ECD 1
 4 RTK BASE SETUP & CHECK
 5 Line T-92 AND T-88
 6 RANDOM topo SHOTS
 7 SITE NO 3A & 4A & 5A
 8 SITE NO 1 AND 2
 9 BASE SETUP & CHECK
 10 Sketch of Gage
 11-18 MAG Lines
 19 BASE SETUP & CHECK
 20 X-SEC T-19
 21-24 Lines @ MCA SITE
 25 BASE SETUP & CHECK
 26-29 Lines @ MCB SITE
 30-31 Line T-20 TO
 32 BASE SETUP & CHECK
 33-35 Line T-27 TO T-35
 35-36 Line T-30 TO T-28

CONT'D next p

INDEX

PAGE

CONTENTS

- 37 BASE SETUP / Check
 38 TBM / Line ECD 2
 39 BASE SETUP / Check
 40 W/S ELEV. FOR HYDRO
 41-42 Line ECD 2
 43 BASE SETUP / Check
 44 W/S ELEV. FOR HYDRO
 45 Line ECD 2
 46 Line T-28 / T-29
 47 BASE SETUP / Check
 48-49 Line T-2 To T-11
 50 T-19, ECD 1, T-30 To 31
 51 PHOTOS
 52 BASE SETUP / Check
 53 Line T-24
 53 TOPO C STUDY PLOTS
 54 TOPO OF PIPELINE SIGNS
 55 BASE SETUP / Check
 56 % CANAL RESHOT
 57 CONTROL POINT
 58 CONTINUATION Pg

INDEX

Page

CONTENTS

58	BASE SETTING Check
59-60	Pipe Lines PROBES
61	MAG INVEST Points
62	BASE SETTING Check
63	MAG INVEST Points
64	Base setting
65	Line T-48, 49 Extances
66	BASE SETTING Check
67	Line T-50, T-36
68	Gage Readings

RTK BASE setup

BASE C = GBC-1
TRIMBLE R8 No 5257
ANT HT 2.000 meters

Check on IR GBC-2

Pt N. 379603. 248 E. 3755927. 133 EL. 1.320
Eqs N. 379603. 253 E. 3755927. 144 EL. 1.305
Fro. N. 379603. 290 E. 3755927. 169 EL. 1.246

File: 52571260

START: 13.03

Eqs: 20; 31

File: GRAND CANYON 05/06/15 1

ROVER UNIT

TRIMBLE R8 No. 0906
ANT HT 2.000 meters

Pt 3475

Dt 3744

Line BC 01

PT NO CODE ANT HR

3476	SNA	6.562
3488	WE	"
3489	MSH	"
3491	SNA	"
3493	MSH	"
3498	SNA W/E	"
3499	SNA	6.562
3502	MSH	"
3503	SNA	"
3565	WE	"
3566-83	SNA	"
3584	WE	"
3585-86	MSH	"
3587	SNA	"
3627	MSH	"
3628-31	MSH	"
3632-45	SNA	"
3646	MSH	"
3648	SNA	"
3653	MSH	"

File: GRASS CHENIER 05/06/15

2

Description

SHOT IN OPEN WATER

W/E / GRASS LINE

N/A IN GRASS

SHOT IN WATER @ GRASS LINE
IN GRASS

W/E @ GRASS LINE

SHOT IN WATER

~~MSH~~ IN GRASS~~SHOT IN OPEN WATER~~

EDGE OF GRASS AND OPEN WATER

SHOT IN OPEN WATER

W/E @ GRASS LINE OF ISLAND
MARSH

SHOT IN OPEN WATER

EDGE GRASS @ MARSH

MARSH

SHOT IN OPEN WATER

~~MSH~~ IN MARSH GRASS

SHOT IN CANAL

EDGE MARSH

Line Ecol Cont'd

Pt no Coot Avt Hr

3654	MSA	6.562
3702	SNG	"
3707	MSA	"
3713-43	SNG	"

File: Grand Chienier 05/06/15 3

Description

MS in marsh
SHOT in CORAL
IN GRASS
SHOT in CORAL

RTK BASE UNIT

BASE @ IR GBC-1

TRIMBLE R8 NO 5257

ANT HT 2.000 meters

CHECK ON IR GBC-2

P03 N 379603.248 E 3755927.133 EL 1.320

F04 N 379603.265 E 3755927.157 EL 1.270

F05 N 379603.676 E 3755927.195 EL 1.296

File: 52571270

START: 14:30

END:

FILE: GRASS CHECKER

05/07/15

9

ROVER UNIT

TRIMBLE R8 NO 090C

ANT HT 2.000 meters

Pt 3745

Pt 3979

Line T-92

No	Code	Altitude
3748	MOT	6.562
3767	TBK	"
3768	WE	"
3769	SNS	"
3776	WE	"
3777-	MSH	"
3800		

Line T-88

3801	MSH	6.562
3823	TBK	"
3824	SW WE	"
3825	WE SNS	"
3831	WE	"
3832	TBK	"
3833-54	MSH	"

File: GRASS CHANNEL 05/05/15

5

Description

Ng in MARSH & BRUSH
 Tbk CANAL in water
 w/e
 SWANING IN CANAL
 w/e @ MARSH
 Ng in MARSH

Ng in GRASS & Light Brush
 CANAL
 w/e CANAL
 SHOT IN CANAL
 w/e
 Tbk CANAL
 Ng in GRASS & BRUSH

ToPo SHOTS

PTN#	CODE	ANT HT
3855	SNA	6.562
3857	W.C.	"
3858	TBK	"
3859-61	Ng	"
3862	MSA	"
3863	SNA	6.562
3865	VIE	"
3866	TBK	"
3867	Ng	"
3872	MSA	"
3873	TBK	"

File: GRAND CAYENA 05/07/15

C

Description

SHOT IN CANAL

W/E @ CANAL

TBK CANAL

Ng IN BRUSH

Ng IN MARSH

SHOT IN CANAL

W/E @ CANAL

TBK "

Ng IN BRUSH

Ng IN MARSH

TBK CANAL @ Lock Point @ Intersection

SITE No. 3A

P# NO CODE AUTH

3874-13 MSH 6.562

SITE - 4 A

3894-13 MSH 6.562

SITE 5 A

3916-35 MSH 6.562

File CMA

05/07/15

2

Description

NG MARSH

Moved Site 3
To New Location
Called Site 3A

NG MARSH

Moved Site 4 To
New Location
Called Site 4A

NG MARSH

Moved Site 5 To
New Location
Called Site 5A

SITE 1

#1 no case

AUGUST

3936-57 MASH

6.562

SITE 2

3958-78 MASH

6.560

File. GRAIN CHOCHEA

05/07/18

8

Description

NS MARSH

NS MARSH

27k BASE setup

BASE @ IRGCB-1

Trimble R8 No. 5257

ANT HT. 2.000 meters

Check on IRGCB-2

Avg N 379603.248 E. 3755927.137 EL. 1.320

Fwd N 379603.266 E. 3755927.140 EL. 1.274

Fwd N 379603. E. 3755927. EL.

File: 52571310

START: 19.05

END:

File Grand Canyon

05/11/15

9

Rover Unit

Trimble R8 No. 0906

ANT HT. 2.000 meters

PT 3747

Gage & TBM

PT NO	CODE	AUT FT	ELEV.
3748	TOP 4x4 Post	0.00	6.80 [REDACTED]
3748A	TOP 4x4 Post	0.00	6.10 [REDACTED]
3749	60 D NAIL	6.562	[REDACTED] 4.02

Gage Reading	TIME	DATE
0.9	03:30	5/11/15

~~How~~ HAND HELD POSITION

29-33-02-5

89-49-45-8

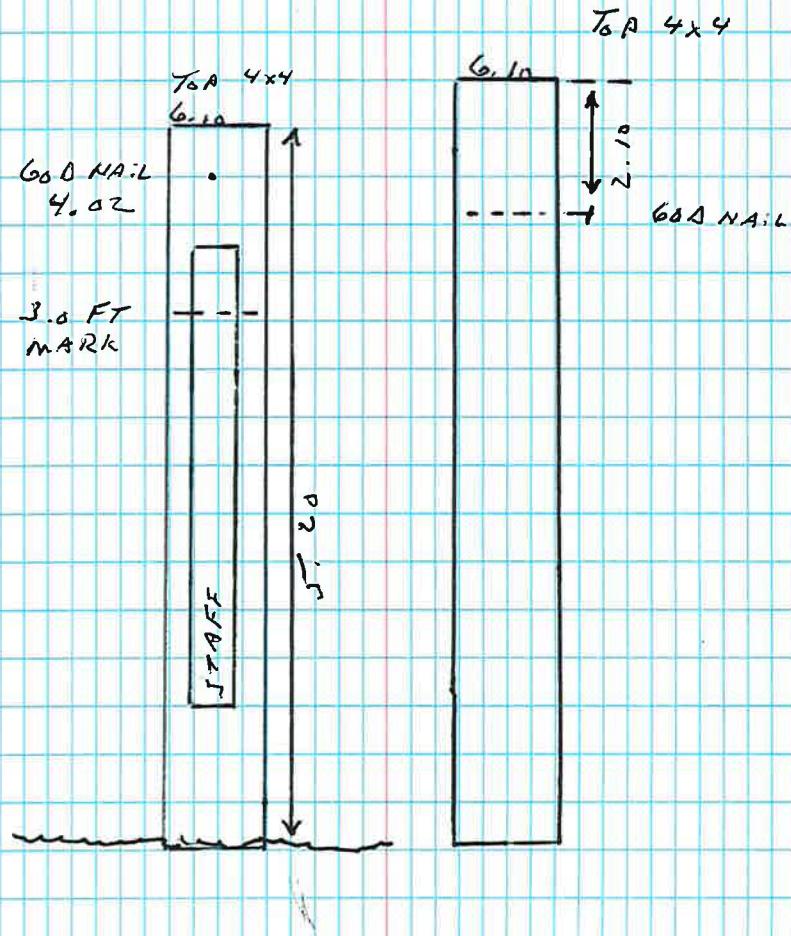
PHT No. 2223
2224

File: Grand Chancer

05/11/15

10

Description



MAS Lines

Line	File Name
M5	BB132-M5.RAW
M4	BB132-M4.RAW
M4	BB132-M4A.RAW
M3	BB132-M3.RAW
M2	BB132-M2.RAW
M1	BB132-M1.RAW
M1	BB132-M1A.RAW
M6	BB132-M1A.RAW

05/12/15

A2

167-00

347-00

167-00

347-00

167-00

167-00

347-00

MAS Lines

LINE	FILE
M-7	BB133-M7.RAW
M-7	BB133-m7A.RAW
M-8	BB133-M8.RAW
M-8	BB133-M8A.RAW
M-9	BB133-M9.RAW
M-10	BB133-M10.RAW
M-11	BB133-M11.RAW

05/13/15

12

Line A2

167-00

347-00

347-00

167-00

347-00

UNABLE TO GET TO
END OF LINE IN
THICK GRASS. WILL
BE COMPLETED WITH
MARSH BUGGY.

167-00

ISLANDS ON LINE
UNABLE TO CROSS
WITH A 2 BOAT

05/13/15

MAG Lines

Line

File Name

M12

BB133 - M12. RAW

M12

BB133 - M12A. RAW

M13

BB133 - M13. RAW

M13

BB133 - M13A. RAW

M14

BB133 - M14. RAW

M14

BB133 - M14A. RAW

M15

BB133 - M15. RAW

Az

167-00

-

ISLAND ON LINE
UNABLE TO CROSS WITH
AIR BOAT.

167-00

ISLAND ON LINE. UNABLE
TO CROSS WITH AIR BOAT

167-00

"

05/13/15

MAG Lines

Line	File Name
------	-----------

M16	BB133-M16.RAW
-----	---------------

M17	BB133-M17.RAW
-----	---------------

M17	BB133-M17A.RAW
-----	----------------

M18	BB133-M18.RAW
-----	---------------

M19	BB133-M19.RAW
-----	---------------

M19	BB133-M19A.RAW
-----	----------------

LAY BACK

Line A

76.00

76.00

256.00

DELETE

~~256.00~~ *DELETE*

MAG Lines

Line	File Name
M 19	134 - M 19. RAW
M 20	134 - M 20. RAW
M 21	134 - M 21. RAW
M 22	134 - M 22. RAW
M 23	134 - M 23. RAW
M 24	134 - M 24. RAW

05/14/15 5

Line A2

256 - 00

76 - 00

NOTE: LINE RUNS
THROUGH PLOT STUDY
AREA. TOLS TO GO
AROUNDS THESE AREAS

256 - 00

256 - 00

76 - 00

256 - 00

MAS Lines

LINE File Name

M25 134-M25.RAW

M26 134-M26.RAW

M27 134-M27.RAW

1x27 134-M27A.RAW

LAY BACK Line

16

05/14/15

Line A2

~~256-00~~ 76-00

256-00

FOLLOWS CANAL *DELETE*
" " "

17

MAG Lines

Line File Name

M10 138-M10.RAW

M10 138-M10A.RAW

M10 138-M10B.RAW

M10 138-M10C.RAW

Line

M28 138-M28.RAW

M10 138-M10 B.RAW

M29 138-M29-~~R&G~~^{5XX MXT}.RAW

138-M29.RAW

138-M29A.RAW

Line A2

X Delete ~~✓~~

167-00

NOTE: HAS TO
CUT LINE SHORT
DUE TO TREES
AND THICK ~~BUSH~~
BRUSH

Follows Shore Line, Trees, very
Thick Brush on Line.

Run MAG Line Around Tree Line.

MAS Lines

Line

File Name

M 15

138 - M 15. RAW

M 15

138 M 15A. RAW

M 14

138 - M 14. RAW

LAY BACK Line

05/18/15

LINE A2

76 - 00

" "

RTK BASE Setup

BASE C IR GBC-1
Trimble R8 No 5257
Ant Ht. 2.000 meters

Check on IR GBC-2

PUB N. 379603.248 E. 3755927.133 CC. 1.320
FMS N. 379603.212 E. 3755927.061 CC. 1.302
FMS N. 379603.167 E. 3755927.112 CC. 1.253

File: 5257 1390

START: 12:38

END

File: GRAN CHENICK 05/18/15

19

Rover Unit

Trimble R8 No 0906
Ant Ht. 2.000 meters

At ~~3755927~~⁴¹³⁹ 3750

At 4139

X-SEC. T-19

ANAL COAD

3979
~~3951~~ MSH

Year

ANT ANT

6.562

File: Gobios Cen. er

05/18/15

20

Description

Ng marsh

Line MCA-4

Pt No	Code	Alt Alt
4003	TBK	5.85
4004	Ng	"
4012	MSH	"
4013-15	MSH	"
4016	WE	"
4017	SNO	15.35
4019	SNO	20.20
4021	SNO	10.52
4025	WE	"
4026	SLP	5.85
4027	TBK	"
4028	Ng	"
4032	MSH	"
4032-3	MSH	"

37

File: Grans Chenier 05/19/15

21

Description

TBK CANAL

Ng in Brush

Edge Brush @ Edge marsh

Ng MARSH

W/E @ CANAL

Shrub in CANAL

"

"

~~Shrub~~ W/E @ CANAL @ Edge Brush

Slope

TBK CANAL

Ng in Thick Brush

Edge MARSH @ Edge Brush

Ng MARSH

Line MCA-3

PT No	Code	ANTHT
4038	MST	5.85
4043	NJ	"
4044	NJ	"
4050	TJK	"
4051	WE	"
4052	SNG	15.35
4058	WE	5.05
4059	TJK	"
4060	NJ	5.85
4061	AB NJ	"
4065-70	MST	"

File: Grass Clipping

05/19/15

22

Description

NJ MARSH

EDGE BRUSH

NJ IN THICK BRUSH

TJK @ EDGE BRUSH

W/E @ CANAL

SHOT IN CANAL

W/E @ CANAL

TJK "

NJ IN BRUSH

NJ @ EDGE BRUSH

AB MARSH



Line MCA 2

Prno	Code	Antmt
------	------	-------

4071-76	MSH	5.85
4072-77	WL	-
4078-79	F&K NY	..
4080	TOK	
4081	WE	"
4082-89	SND	15.35
4090	WE	5.85
4091	TOK	5.85
4092	NS	"
4097	WL	-
4098-03	MSH	5.85

File: GRAND CHENIER 05/9/75

23

Description

NS in MARSH
 Edge BRUSH
 NS in BRUSH
 TOK CANAL
 W/E
 SHOT in CANAL
 W/E @ CANAL
 TOK CANAL
 NS in BRUSH
 Edge BRUSH @ Edge marsh
 NS marsh

Liz MCA 1

Arno Code Ant #

4104	MSH	5.85
4112	WL	"
4113	NJ	"
4116	TBK	"
4117	WE	"
4118	SND	10.52
4128	WE	5.85
4129	TBK	5.85
4130	NJ	"
4134	WL	"
4135-38	MASH	"

Filer GRAVE CHENIER 05/15/15

24

Description

NJ MARSH
EDGE BRUSH
NJ "
TBK CANAL
W/ICE "
SHELL IN CANAL
WE @ CANAL
TBK "
NJ in BRUSH
EDGE BRUSH, EDGE MARSH
NJ MARSH

RTK BASE Setup

BASE 2 = GCB-2

TRIMBLE R8 No 5257

ANT HT. 2.000 METERS

Check on IR GCB-1

Pos N 385290.369 E 3759335.591 H 0.957

Fwd N 385290.331 E 3759338.032 H 1.003

Fwd N 385290.370 E 3759336.057 H 1.040

File : 5257190.0

START: 7:46

B710

File: GRAN COPIA

05/20/15

25

Rover Unit

TRIMBLE R8 No 0966

ANT HT. 2.000 METERS

P7 4140

P7 4540

MCR - 1

PNR	CODE	ANT HT
4141	MSH	5.85
4147	NL	"
4148	NS	"
4149	TBK	"
4150	WE	"
4151	SNJ	15.75
4155	SND	20.20
4160	WE	5.85
4161	TBK	5.85
4162	NS	"
4163	NS	10.52
4166	NL	5.85
4167-72	MSH	5.85

File : Grand Chenier

05/20/15

26

DESCRIPTION

NS MARSH

Edge Trees

NS BRUSH

TBK CANAL

W/E @ CANAL

SHOT IN CANAL

" "

W/E @ CANAL

TBK CANAL

NS IN THICK BRUSH

" "

Edge Brush @ Edge marsh

NS MARSH

Line MCB-2

Pyra Code	Ant #
4173 MSH	5.85
4179 WL	"
4180 NS	"
4181 NS	10.52
4185 TBK	10.52
4186 WE	10.52
4187 SNS	20.20
4188 WE	5.85
4190 TBK	5.85
4197 NG	5.85
4199 WL	"
4200-06 MSH	5.85

File: Gross chick

05/20/15

27

Description

NG MARSH

EDGE OF THICK BRUSH

NG IN BRUSH & THICK BUSHES

" " "

TBK CANAL

WE C CANAL

SHST IN CANAL

W/E C CANAL

TBK "

NG IN BRUSH

EDGE THICK BRUSH

NG MARSH

MCB-3

PT NO	CODE	ANTHT
4207	MSH	5.85
4213	WL	"
4214	NG	"
4217	TBK	"
4218	WL	"
4219	SNS	15.35
4227	"	5.85
4228	WE	"
4229	TBK	20.20
4230	NG	5.85
4231	"	15.35
4234	WL	5.85
4235-49	MSH	"

File: Grassy CACERIN 05/26/15

Description

NG MARSH

EDGE THICK BRUSH

NG in " "

TOP CANAL

W/E C "

SALT in CANAL

"

Waters Edge

Top Bank of Canal

NG in brush

"

Edge of Thick brush

Marsh

MCB-4

PIN	CODE	ANTHR
4241	MSH	5.85
4247	WL	"
4248	NS	15.35
4252	TBK	"
4253	WE	"
4254	SNS	15.35
4261	WE	10.52
4262	TBK	"
4263	VS	5.85
4265	WL	"
4266-71	Big MSH	5.85

File: Grano cenica or / color

Description

shot in marsh

edge woods / brush

NS "

TBK CANAL

W/E C "

SHOT IN CANAL

W/E C CANAL

TBK CANAL

VS in thick Brush

Edge Woods / Brush

NS MARSH

Line T-20

ATMO CODE ACTIVITY

4272- MSH 5.85

4300

Line T-21

4301-12 MSA 5.85

Line T-22

4313-73 MSH 5.85

Line T-23

4374- MSH 5.85

4405

File: Grand Chienier 05/20/15
30

Description

Ng MARSH

Ng MARSH

Ng MARSH

Ng MARSH

Line T-24

PT NO CAGE ANT #S

4446- MSH 5.85

4440

Line T-25

4441-71 MSH 5.85

Line T-26

4472- MSH 5.85

4539

File: Grand Chienier

05/20/15

31
—

Description

NS MARSH

NS MARSH

NS MARSH

RTK BASE SETUP

Base @ IR GCB-2
Trimble R8 No 5257
ANT HT. 2.000 METERS

Check on IR GCB-1

PUB N. 385290.369 E. 3759335.991 EL 0.857
FWD N. 385290.316 E. 3759335.968 EL 0.908
FWD N. 385290.322 E. 3759336.095 EL 0.877

File : 52571410

START: 13:00

File: GRANA C Henrich 05/21/15

32

Rover unit

Trimble R8 No 0906

ANT HT 2.000 METERS

PT 4541

PT 4872

Line T-27

PT NO CODE

ANT DT

4542-71 MSH

5.85

Line T-28

4572- MSH

5.85

4621-29

Line T-29

46³⁰~~28~~-51 MSH

5.85

Line T-30

4652-80 MSH

5.85

File: Grass Chenier 05/27/15

33

Description

Ng marsh

Ng marsh

Ng marsh

Ng marsh

Line T-31

P140 COOC Ant No

4681- MSH 5.85

4700

Line T-32

4701-25 MSA 5.85

4706 WE "

4811 TDK

Line T-33

4726-54 MSH 5.85

Line T-34

4755-87 MSH 5.85

Line T-35

4788 MSH 5.85

File: Grams checker 05/21/15 34

Description

N_g MARSHN_g marsh
W/E C Causal
TDK "N_g MARSHN_g MARSH

MSH

Line T-35 (cont'd)

PT NO	CODE	ANT 147
4802	WE	5.85
4803	TBK	"
4804	NS	"
4805	NS	15.35
4808	WL	5.85
4809	MSA	5.85

Line T-30

4812	^{SNA} MSA	5.85
4813	WE	"
4814	TBK	"
4815-36	MSA	5.85

Line T-29

4837	WE	5.85
4838	TBK	"
4839 -	MSA	"
4857		

File: GRASS CHEVIER

05/21/15

35

Description

w/e @ CANAL

TBK "

NS DRUSH
L "EDGE WOODS @ EDGE MARSH
H

SHOT IN CANAL

W/E "

TBK "

NS MARSH

W/E

TBK MARSH

NS MARSH

LINE T-~~28~~

PT NO	CASE	ALT NT
4858	SNS	5.85
4859	WE	-
4860	TBK	-
4861-71	MJSB	-

File: GRANO CHENIC 05/21/10

36

Description

SHOT TO CANAL

~~FEAR~~ CANAL W/E CANAL

TBK CANAL

NG MARSH

RTK BASE Setup

BASE C IR GCB-1
TRIMBLE R8 No 5257
ANT HT. 2.000 meters

Check on IR GCB-2

PUB N. 379603.248 E. 3755927.133 EL 1.320
FNU N. 379603.260 E. 3755927.176 EL 1.268
~~FNU N. 379603.~~ E. 3755927. 661
FNU. 379618.684 E. 3755941.8⁹⁵ 8⁹⁴ EL 1.696

FILE: 52571461

START: 15.39

FILE: GRAND CITERIER

05/26/15

37

Rover Unit

TRIMBLE R8 No 0906
ANT HT 2.000 meters

4873

PT 5065

Check on PT 4874 see PG 39

TBM / Line ECAZ

PT No CODE AMT HT

4878 TBM 6.562

(ECAZ-e) ECAZ

4875 - MASH 10.52

5068

FILE: GRAVE CHANGER 05/26/15 38

DESCRIPTION

SET 1"X2" STAKE FOR CHECK POINT
N. 379618.694 E. 3755947.891 EL. 1.644

NJ MASH

RTK BASE setup

BASE @ IR GRBC-2
TRIMBLE R8 NO 5257
ANT HT. 2.000 meters

Check on PT 4874 (TBM)

EST N.379618.694 E.3755947.891 EL. 1.694
FNO 4.379618.671 E.3755947.849 EL. 1.686
FNO N.379618 E.3755947. EL.

File: 52571470

START: 12:54

File: GRANDS CHENIC 05/27/15 39

Rover unit

Trimble R8 No. 0906
Ant Ht. 2.000 meters

PT 5066

PT 5600

w/s ELEV.

PTH₀ CODE

ANTH_H

5067 WS

5.85

5599 WS

5.85

90

File: Grand Cederice

05/27/

Descriptions

w/s e 08:01 EL 0.586

w/s e 11:54 EL. 0.822

Line ECAR

PTN#	CODE	ANT HT
5068	SNO	5.85
5074	WE	"
5075	TBK	"
5076-84	NG	"
5085	TOK	"
5090	NG	"
5115	TBK	"
5116	WE	"
5117	SNO	"
5120	MSH	"
5121	MSH	"
5122	W/E	"
5123	TBK	"
5125	MSH	"
5126	MSH	"
5163	TBK	5.85
5164	WE	"
5165	SNO	5.85
5382	WE	"
5383	TBK	"

GRASS CANAL

05/27/15

41

DESCRIPTION

SHOT IN CANAL

W/E @ BANK

TBK CANAL

NG IN BRUSH

TBK CANAL

NG IN BRUSH (Line Follows Along TBK)

TBK OF Pocket

W/E

SHOT IN CANAL

EDGE MARSH

SHOT IN Fleets ~~as~~ MARSH GRASS

W/E

TBK CANAL

EDGE MARSH

NG IN MARSH GRASS

TBK CANAL

W/E - EDGE MARSH GRASS

SHOT IN EDGE OF CANAL

WE @ ISLAND

TBK ISLAND

ECOL CONT'D

PT N.	CASE	ANT HT
5384	YG MSH	5.85
5397	TBK	"
5398	WE	"
5399	SND	"
5476	WE	"
5477	TBK	"
5478	MSH	"
5598		

FILE: GRANDE CAYMAN

05/27/15

42

DESCRIPTION

NG @ ON ISLAND

TBK ISLAND

W/E C "

SHOT IN SHALLOW WATER

W/E C ISLAND

TBK "

NG ON ISLAND

RTK BASE Setup

BASE @ IR GCR-2

TRIMBLE R8 NO 5257

ANT HT 2.000 METERS

Check on TRIM PT 4874 (secs 38)

ES N 379618.694 E 3755947.891 EL 1.694

END N 379618.626 E 3755947.886 EL 1.694

FWD N 379618.651 E 3755947.890 EL 1.686

File: 52571480

START: 02:46

END: 10:15

File: GRAN CHACRIR 05/28/15

43

Rover Unit

TRIMBLE R8 NO 0906

ANT HT. 2.000 METERS

PT 5686

PT 5909

W/LS ELEVATION

Part No	Code	Actual
---------	------	--------

5601	W/S	5.85
------	-----	------

5908	W/S	5.85
------	-----	------

File: GRASS CLOTH

05/28/15

44

Description

W/LS ELEV. ~~0.746~~ 0.746 Q 07:51

W/LS ELEV 0.949 13.00

Line EAC² cont'd

PT#	COND.	ANT HT
5602	MSH	5.85
5635	MSH	10.52
5850	EW	10.52
5851	NG	"
5874	TBK	5.85
5875	WL	"
5876	SND	10.52
5883-87	WSND	15.35

File: GRAN, C. Henrich 05/28/15

45

Description

NG in MARSH

" "

EDGE WOODS

NG WOODS

TAK CANAL @ Edge woods

W/E @ CANAL @

SHOT in CANAL

" "

Line T 28

PT NO CORE ANTHY

5888-97 SNO 10.52

Line T-69

5888-07 SNO 10.52

Line

File: Grand Chienez

05/28/85

96

Description

SHOT IN CANAL

SHOT IN CANAL

RTK BASE setup

BASE C IR GCB-1
Trimble R8 No. 5257
ANT HT. 2.000 meters

Check on PT IR GCB-2

Est N. 379603.248 E. 3755927.133 E.G. 1.320
Fwd N. 379603.282 E. 3755927.140 G.G. 1.266
Fwd N. 379603.241 E. 3755927.124 G.G. 1.887

File : 52571520

START : 13:20

End

File: BA-173-RH1 06/01/15

92

Rover unit

Trimble R8 No 0906

ANT HT. 2.000 meters

PT 5910

PT 6096

Line T-2

PT NO	CODE	AMT HR
5911-45	SND	10.52

Line T-3

PT NO	CODE	AMT HR
5946-C1	SND	10.52

Line T-7

PT NO	CODE	AMT HR
5962-B3	SND	10.52

Line T-5

PT NO	CODE	AMT HR
5984-	SND	10.52

File: DA-173-RH1

06/6/15

Description

SHOT IN OPEN WATER

SHOT IN OPEN WATER

SHOT IN OPEN WATER

SHOT IN OPEN WATER

Line T-6

BY NO	CODE	AUGUST
6001-03	SNO	10.52
6004	WE	"
6005	MSH	"
6006	WE	"
6007-11	SNO	"

Line T-7

6012-27	SNO	10.52
---------	-----	-------

Line T-11

6028-34	SNO	10.52
---------	-----	-------

~~Line T-24~~

6047	SNO	10.52
------	-----	-------

FILE: BA-17J-1241

06/01/15

49

DESCRIPTION

SHOT IN OPEN WATER
 W/CC @ ISLANDS
 ON "
 W/CC "
 SHOT IN OPEN WATER

SHOT IN OPEN WATER

SHOT IN OPEN WATER

~~SHOT IN OPEN WATER~~

Line in CANAL @ T-19

File: DA-173-RH1

06/01/15

5a

Pr No	Cone	ANT HT	Description
6041-60	SNO	10.52	shot in canal

Line EDC1 Between T-23, E24

6061-67	SNO	10.52	shot in open water
---------	-----	-------	--------------------

Line T-~~20~~³⁰

6068-85	SNO	10.52	shot in open water / CANAL
---------	-----	-------	----------------------------

Line T-~~20~~³¹

6086-85	SNO	10.52	shot in open water
---------	-----	-------	--------------------

Photo S

06/01/15

51

Photo No.

Picture

2227 To 2233

Woods. E Line T-35 @ Point of
ISLAND

Photo 2234

PAST. LOUISIANA COASTAL RESTORATION
COAST WIDE REFERENCE MONITOR SYSTEM
ECOLOGICAL RESEARCH AREA
PHONE NO. 1-225-342-7308

RTK BASE SETUP

BASE @ IRGBC-1
TRINACLE R8 NO 5257
ANT HT. 2.000 METERS

CHECK ON IRGBC-2

PTD N 379603.248 E 3755927.133 EL 1.320
END N 379603.265 E 3755927.136 EL 1.338
END N 379603.283 E 3755927.181 EL 1.245

* File: #2571536

START: 13:05

END:

File: BA-173-RH1

06/02/25

52

Rover UMT

Trinacle R8 N 0906

Ant ht. 2.000 meters

PT: 6097

AT: 6168

Line T-24

DRNG	CODE	ANT HT
------	------	--------

6098-	MJH	5.85
-------	-----	------

6119		
------	--	--

6120-37 CL		10.52 10.65.35
------------	--	------------------------------

6138. ⁴³ SWK		5.85
-------------------------	--	------

6144	Sgn	5.85
------	-----	------

6148	IR	5.85
------	----	------

6146	Sgn	5.85
------	-----	------

File: BA173-RH1

06/02/15

53

Description

NG MARSH

20 inch wide BOARD WALK

WARNING SIGN

PHOTO NO. LOUISIANA COASTAL RESTORATION
COASTWIDE REFERENCE MONITOR SYSTEM
PHOTO NO 1-225-342-7308

1/2" STAINLESS STEEL ROD
PHOTO 2235

WARNING SIGN - SEE ABOVE SEE PAGE 51
PHOTO NO 2234

Pipe Line INFO

PT NO CODE ANHT

6147 SGN 5.85

6149 SGN 5.85

6150 SGN ..

6151-58 SGN 5.85

6159-67 ⁶⁰ SGN 5.85

6161-67 PNC 16.15

File: BA-173-2H-1

06/02/15

54

DESCRIPTION

Pipe Line warning sign

PETROLEUM Pipe Line

SHELL Pipe Line company

PHONE 1-800-852-5614

PHOTO 2236

Photo 2237

Wood sign same info as above

Photo 2238

Pipeline sign same info as above

wooden sign same info

Top of pipe on Pipe Line

RTK BASE SETUPS

~~#46~~ GOR Antenna

BASE C IR GBC-1

TRIMBLE R8 NO 5257

ANT HT 2.000 METERS

Check on # IR GBC-2

PUB N 379603.248 E 3755527.133 EL 1.320

FWD N 379603.284 E 3755527.190 EL 1.275

FWD N 379603.330 E 3755527.167 EL 1.339

File: 52571540

SPDRT: 13:16

File: BA-17J-RH1

06/03/15

55

DESCRIPTION

ROVER UNIT

TRIMBLE R8 NO 0906

ANT HT 2.000 METERS

PT 6168 6169

PT 6258

SL CANAL
RESHOT PT 6042

FILE: BA.173-RH1

06/02

PT NO	CODE	ALT H
6170	SNG	5.85
	Linc T-16	
6172	TRL	5.85
6173	NJ	"
6175	NJ	10.52
6219	TRL	5.85
6232-36	NJ	10.52
6237-44	TRL	10.52
6245	NJ	"
6249	TBK	10.52
6250	WE	10.
6251-55	SNO	10.52

Description

SHOT IN CANAL

Edge woods

Nj woods

" "

Edge woods

Nj woods

Edge woods

Nj Brush

TBK CANAL

w/e c canal

SHOT IN CANAL

Line Runs Along
Tree Line

Runs Along Tree Line

CONTROL POINTS

PT NO	CODE	ANT. Ht.
-------	------	----------

6284 ⁵⁶	ZR	5.85
--------------------	----	------

4255 ⁵⁷	HUB	5.85
--------------------	-----	------

FILE: DA-173-RH1

06/03/15

Description

SET A 10 FT IRON ROO NEAR CAMP HOUSE
FOR CONTROL POINTS

N. 387175.580

Haus Held Pos. Tia

E. 3719410.088

Lat. 29-33-26-5

EL 1.511

Long. 89-57-13-9

SET 1" X 1" HUB FOR CHECK POINT

N. 387160.999

Haus Held

E. 3719420.203

Lat. 29-33-26-4

EL 1.694

Long. 89-57-13-7

RTK BASE SETUP

BASE C IR GAC-1
TIMEABLE PG NO 5257
ANT HT. 2.000 METERS

CHECK ON IR GAC-2

PUB N. 379603.248 E. 3755927.133 EL 1.320
END N. 3796⁶³8.269 E. 3755927.129 EL 1.278
END N. 379603.324 E. 3755927.013 EL 1.266

File: 52571550

START: 13:22

File: DA-173-RH1

06/04/15

58

POWER UNIT
TRANSMITTER PG NO 0906
ANT HT. 2.000 METERS

PT 6259

PT 6272

PIPE LINE PROBES

FILE: RA-173-RH1

06/04/15

53

PT NO	CODE	ANT HT	DESCRIPTION
6260-61 PPE		15.25	Top of Pipe Line See COMPANY INFO ON PAGE 54
6263	I-1	-	Found HOTTING Pipe GULF-SOUTH
	I2	-	JUNK Broken ^{BE.} Piece of METAL
	I3	-	See Pg 54 for Probe on Pipe Line PT 6161 to 6167
6262	I4	-	Found Pipe (bent broken) GULF SOUTH PIPE LINE (GAS PIPE LINE) 1-800-272-3020 / 1-800-850-0051 PHONE NO 2239 2240

PIPE LINE TNS.

PT NO	CODE	ANT ANT
6264	Sgn	5.85
6265	PPE	13.40
6266	Sgn	5.85
6267	PPE	13.40
6268	Sgn	5.85
6269	PPE	13.40 I-5
6270	PPE	13.40 I-6
6271	PPE	13.40 I-7
-	I-8	-

File: BA-177-RH1

06/04/15

DESCRIPTION

PIPE LINE SIGN

TOP PIPE GULF SOUTH SEE PAGE 57

PIPE LINE SIGN GULF SOUTH Pg 55

TOP PIPE GULF SOUTH "

PIPE LINE SIGN GULF SOUTH Pg 59

DID NOT FIND PIPE LINE

TOP OF PIPE SEE Pg 54 FOR INFO

TOP PIPE SEE Pg 54 FOR INFO

TOP PIPE SEE Pg 54 FOR INFO

UNABLE TO DETERMINE DETERMINE
OBJECT. NO PIPE FOUND

Pipe Line Topo

PN. Case ANTRAT

- I9 -

- I10 -

- I11 -

- I12 -

FILE: BA-173-RH1

06/04/10

61

Description

Nothing Found

Found Junk

CRAB TRAP

Found Nothing

RTK BASE SETUP

BASE & IR GGB-2

TRIMBLE R8 NO 5257

ANT HT 2.000 METERS

Check on Pt 4874 TBM

EST N. 379618.694 E. 3755947.891 EL. 1.694

FWD N. 379618.672 E. 3755947.898 EL. 1.651

FWD N. 379618.671 E. 3755947.898 EL. 1.

File. 52571586

START : 13:03

FILE: BA-173.RIN

05/08/15

62

ROVER UNIT TRIMBLE

R8 NO 0906

ANT HT 2.000 METERS

Pt 6273

Pipe Line Tops

No. Code Amt At

- IZ3 -

- I-24 -

File: BA-173-RH1

06/08/15

Description

Found Nothing

Found Nothing

RTK BASE SETUP

BASE @ PT 6256 see Pg 57
TRIMBLE R8 N. 5257
ANT HT 2,000 meters

Check on PT 6257 see Pg 57
EST N. 387160.999 E. 3719420.203 EL 1.694
FWD N. 387160.944 E. 3719420.147 EL 1.691
FWD N. 387160.973 E. 3719420.168 EL 1.679

FILE: S2571581

START: 16:22

File - BA-173-RH

06/08/15

64

Paver unit

Trimble R8 model

Ant ht 2,000 meters

PT 6274

PT 6308

Line T-48

File: BA-173-2141

06/08/15

65

PT No

Code

ANT N#

Description

6275-9" SNO

10.5L

SHOT IN SHALLOW WATER

Line T-49

6295-07 SNO

10.5L

SHOT IN SHALLOW WATER

RTK BASE Setup

BASE @ IN GCB-2

TRIMBLE R8 No. 5257

ANT HT. 2.000 METERS

Check on Pt 4874 TBM

EST N. 379618.694 E. 3755947.891 EL. 1.644

FNO N. 379618.680 E. 3755947.878 EL. 1.651

FNO N. 379618 E. 3755947. EL.

File : 52571590

START: 73.39

FILE: BA-173-RH1

06/09/15

66

Rover Unit

TRIMBLE R8 No. 0906

ANT HT. 2.000 METERS

Pt 6309

Line T50

File: BA-173-RH1

06/09/15

62

PT No	Code	Ant Ht
6310-22	MSH	5.85

Description

Ng MARSH

Line T36

PT No	Code	Ant Ht
632J	SNO	5r85
632S	SNO	10.52
633G	MSH	"
633J	WE	"
6338-41	MSH	5.85

SHOT IN EDGE OF CANAL

' " " "

EDGE GRASS & MARSH

W/E OF CANAL

Ng MARSH

Gage Readings

Gage	Readings	Time
------	----------	------

OLD	1.27	9:19
-----	------	------

NEW	0.3	10:20
-----	-----	-------

06/09/15

68

EMC INC.

GRAND BAYOU CHESTER

MARSH RESTORATION

CONTRACT NO.

EMC INC.

GEOGRAPHIC MS, 38901

PC H. CLARK

T. COLE

& T. MOORE

π BASE-TRIMBLE RB-3 GDSS #2374

ROVER-TRIMBLE RG-2 GDSS #7074

INDEX

Pg 1-7 MISSING MAIL LINE DATA

Pg 8 BASE SETUP & CHECKIN

Pg 9 INVESTIGATION TARGETS

MAG LINE GAPS
FILE: GBC-HC

1
6-4-15

LINE M7

FILE NAME: M7.RAW ↪
M7-001.RAW ←
M7-002.RAW
M7-003.RAW

LINE M8

FILE NAME M8.RAW
M8-001.RAW
M8-002.RAW

LINE M6

FILE NAME M6.RAW

LINE M5

FILE NAME M5.RAW

LINE M4

FILE NAME M4.RAW

LAD BACK LINE
MAIN LINE

MAG LINE GAPS

LINE M3

FILE NAME: M3.RAW

LINE M1

FILE NAME: M1.RAW

M1-0001.RAW

LINE M9

FILE NAME: M9.RAW

LINE MID

FILE NAME: MID.RAW

MID-0001.RAW

LINE M2B

FILE NAME: M2B.RAW

M2B-0001.RAW

~~11282~~

2
6-4-15

MAG LINE GAPS

3

6-4-15

LINES 11

FILE NAME: M11.RAW

M11-0001.RAW

M11-0002.RAW

6-5-15

MAP LINE GAPS

LINE M12

FILE NAME: M12 RAW
M-001 RAW

~~LINE~~

LINE M13

FILE NAME M13 RAW
M-001 RAW

LINE M14

FILE NAME M14 RAW

LINE M15

FILE NAME M15 RAW

LINE M16

UNABLE TO GET M16

ALL LARGE TREES & GROWN

UP

LINE M17 [REDACTED]

FILE NAME M17 RAW

FILE NAME (LINE M18)

" " M18 RAW
M18-001 RAW

6-5-15

MAG LIDE GAPS

LINE M19

FILE NAME

m19 RAW

m19_001 RAW

LINE M20

FILE NAME

m20 RAW

LINE M21

FILE NAME

" "

m21 RAW DELETE

m21_001 RAW

LINE M22

FILE NAME

m22 RAW

LINE M23

FILE NAME

m23 RAW

LINE M24

FILE NAME

m24 RAW

LINE M27

FILE NAME

m27 RAW

MAG LINE GAPS

LINE M25

FILE NAME m25 Raw

LINE M26

FILE NAME m26 Raw

6a

6-5-15

MAG LINE GAPS

7
6-6-15

LINE M29

LINE NAME M29.RAW
M29_0001.RAW
M29_0002.RAW
M29_0003.RAW
M29_0004.RAW
M29_0005.RAW

LINE M13

LINE NAME M13.RAW

LINE M28

LINE NAME M28_0002.RAW
M28_0003.RAW

LINE M16

FILE NAME M16.RAW

NOTE: RAW ALONG EDGE OF WOODS
M28_0004.RAW

NOTE: RAW ALONG EDGE OF WOODS
& BARGE

BASE SETUP
FILE: GBL-HL.DC

BASE & IR GBL-1
TRIMBLE RB-3 GNSS # 2374
TRIMBLE INTERNAL ANT.
ALT. 6.562 SFT.

ROVER TRIMBLE RL-2 GNSS # 7074

124 IR GBL-2 6.562 IR GBL-2

N 379603.290

E 3755927.138

EL 1.321

ERROR

N - 0.042

E - 0.005

EL - 0.001

F-CLOUDY & HOT

8
6-7-15

CLARK & PARTY

SEE RONNIE H. BOOK IROD RD

SEE RONNIE H. BOOK IROD RD

N 379603.248

E 3755927.133

EL 1.320

6-7-15

INVESTIGATION

PT. # CODE ROD DESCRIPTION

I13 FOUND OLD WIRE
NOTHING ELSE

I14 COULD NOT FIND ANYTHING
MAYBE CRAB TRAP

I15 FOUND OLD CRAB TRAP

I16 FOUND SMALL PIECE METAL

I17 NOTHING FOUND

I18 NOTHING FOUND

I19 NOTHING FOUND

I20 CRAB TRAP

I21 NOTHING FOUND

I22 CRAB TRAP

COASTAL RESTORATION AND PROTECTION
BAYOU GRANDE CHENIER MARSH & RIDGE (BA-173)

EMC Job # 15-029

CONTRACTOR: EMC INC.
GRENADA, MS.

PARTY: J. PEE
A. GANN
C. PETTIT

INSTRUMENTS: GPS TRIMBLE RTK

1-2 PROBE & LOCATE FOUND P/L

3 SHOTS NEEDED ON PROFILE

4 EXTEND SECTIONS T51 & T52

5-6 LOCATE ABANDON P/L'S
MESA GULF COAST

7 CONFIRM ELEV'S @ P10 & 11
OTHER EFFORT FOUND P3 & 8

8 INVESTIGATE POSSIBLE P/L
I17, I23, I43, I37 & I103

9 SET NEW CONTROL POINTS

10 LOCATE EXISTING P/L
CHEV. MIDSTREAM LLC

11 SKETCH OF P/L CROSSINGS

12-13 EXTRA SHOTS ON P/L

CPRA STATE OF LA,

BASE C GBC-Z

SEE R. HUTCHINSON Book Pg. 38 BK 2

Pg. 66 BK 2

CK 15000 TO PT # 4874

Found N = 379618.473 E = 3755947.861 EL = 1.645

Pub N = 379618.494 E = 3755947.891 EL = 1.644

PT NAME CODE Rod DESCRIPTION

15001 PPE 13.30 TOP OF PIPE P1

15002 SND 5.85 Sounding

15003 PPE 13.30 TOP OF PIPE P2

15004 SND 5.85 Sounding

15005 PPE 13.30 TOP OF PIPE P4

15006 SND 5.85 Sounding

15007 PPE 13.30 TOP OF PIPE P5

15008 SND 5.85 Sounding

FILE: BA173_15B_JP

JUNE 9, 2015

SET

SET UP JUNE 9, 2015

CFRA STATE OF LA,

BASE C GBC-2

CK 15009 TO PT # 4874

Found N = 379618.700 E = 3755947.917 EL = 1.649

Pub N = 379618.694 E = 3755947.891 EL = 1.644

PT NAME	CODE	Rod	DESCRIPTION	
15010	PPE	13.30	TOP OF PIPE	P6
15011	SND	5.85	OUNDING	
15012	PPE	13.30	TOP OF PIPE	P7
15013	SND	5.85	OUNDING	
15014	PPE	13.30	TOP OF PIPE	P9
15015	SND	5.85	OUNDING	
15016	PPE	13.30	TOP OF PIPE	P12
15017	SND	10.52	OUNDING	
15018	PPE	13.30	TOP OF PIPE	P10
15019	SND	15.35	OUNDING	
15020	PPE	13.30	TOP OF PIPE	P11
15021	SND	15.35	OUNDING	

FILE: BA173-158-3P

JUNE 10, 2015

(NOTE: SECOND EFFORT P3 & P8 NOT FOUND)

CPRA STATE OF LA.

BASE C GBC-2

CK 15022 TO Pt # 4874

Found N=379618.683 E=3755947.911 EL= 1.632

Pub N=379618.694 E=3755947.891 EL= 1.644

Pt NAME	CODE	Rod	DESCRIPTION
15023-25	SNDg	10.52	SOUNDINGS
15026	EGL	"	EDGE MARSH GRASS
15027-101	MSH	"	SHOTS IN MARSH
15102	EGL	"	EDGE MARSH GRASS
15103-08	SND	"	SOUNDINGS

CK 15109 TO Pt # 4874

Found N=379618.692 E=3755947.887 EL= 1.647

Pub N=379618.694 E=3755947.891 EL= 1.644

FILE: BA 73 158-3P

JUNE 11, 2015

CPLA STATE OF LA.

4

BASE C GBC-Z

CK 15110 TO Pt # 4874

Found N=379618.631 E=3755947.892 EL= 1.637

Pub N=379618.694 E=3755947.891 EL= 1.644

Pt Name	Code	Rod	Description
15111-120	MSH	10.52	MARSH RANGE T52
15121	TBK	"	T.B. CHANNEL
15122-125	SND	"	SND IN "
15126	TBK	"	T.B. CHANNEL
15127-138	MSH	"	MARSH
15139	SND		SND IN CHANNEL T51
15140-146	MSH		MARSH

CK 15147 TO Pt # 4874

Found N=379618.679 E=3755947.882 EL= 1.641

Pub N=379618.694 E=3755947.891 EL= 1.644

FILE: BA173-158-3P

JUNE 15, 2015

CPLA STATE OF LA.

BASE C GBC-2

CK 15148 TO PT #4874

Found N=379618.700 E=3755947.857 EL=1.639

Pub N=379618.694 E=3755947.891 EL=1.644

PT NAME	CODE	RD	DESCRIPTION
15149	SGN	10.52	SIGN POLES WARNING
15150	"	"	" "
15151	PPE	5.85	TOP OF 2" VISIBLE PIPE
15152	"	"	" "
15153	DOCK	"	VALVE DOCK STATION
15154-55	PPE	5.85	TOP OF 3" PIPE
15156-57	SGN	"	SIGN POLES WARNING
15158-59	PPE	"	TOP OF VISIBLE 3" P.PE
15160	DOCK	"	VALVE DOCK STATION

FILE: BA173_158_JP JUNE 16, 2015

ABANDON

NOTE: HIGH PRESSURE PIPELINE CROSSING
MESA GULF COAST

1-800-889-2423

VALVE GAUGES REGISTER NO
PRESSURE C DOCK STATIONS
PIPES ARE RUSTED SEVERELY
PROBE IN CHANNEL NOT FOUND

Photos: SHOT 15149 Photo IMG-1

"	15151	"	IMG-2
"	15153	"	IMG-3
"	15154	"	IMG-4
"	15158	"	IMG-5
"	15159	"	IMG-6

CPR A STATE OF LA,

PT NAME	CODE	ROD	DESCRIPTION
15161-63	PPE	15.35	TOP OF 3" VISABLE PIPE
15164-65	SGN	"	SIGN POLES WARNING
15165		10.52	
15166-67	PPE	+0.52	" " "
15160-67	PPE	15.35	TOP OF 3" VISABLE P.PE

FILE: 8A173-158-JP

JUNE 16, 2015

MESA GULF COAST
SEE NOTE Pg. 5

Img-7

Img-8

C P R A STATE OF LA.

BASE C GBC-2

CK 15168 TO PT # 4874

Found N = 379618.6700 E = 3755947.901 EL = 1.638

Pub N = 379618.694 E = 3755947.891 EL = 1.644

PT NAME	CODE	ROD	DESCRPTION
15169	PPE	13.30	TOP OF PIPE P10
15170	SND	15.35	Sndg C "
15171	PPE	13.30	TOP OF PIPE P11
15172	SND	15.35	Sndg C "
15173	PPE	13.30	TOP OF PIPE P8
15174	SND	10.52	Sndg C "
15175	PPE	13.30	TOP OF PIPE P3
15176	SND	10.52	Sndg C "

FILE: BA173-158-JP JUNE 17, 2015

CONFIRM ELEV.^s C P10 & P11

3RD EFFORT PROBE & FOUND P3 & P8

CPIRA STATE OF LA,

SITE VISIT

I 17 OPEN WATER

PROBE TIME APPROX. 45 MIN.^s

NOTHING FOUND

I 23 \ THICK MARSH GRASS

I 43 / PROBE TIME APPROX. 1 HOUR

NOTHING FOUND

I 37 SMALL CHANNEL

FOUND METAL SHEET TYPE

MATERIAL

I 103 OPEN WATER

FOUND CONCRETE/REBAR FORM

NO EVIDENCE OF PIPELINE

FILE: BA173_198_JP

JUNE 17, 2015

NOTE: NO EVIDENCE OF PIPELINE
C THESE SITE LOCATIONS

CPIRA STATE OF LA,

FILE

BA173-158-JP

JUNE 18, 2015

BASE C GBC-3 PT # 6256
SEE BK 2 Pg 57

CK 15177 PT II 6257

Found N = 387160.985 E = 3719420.160 EL = 1.697

Pub N = 387160.999 E = 3719420.203 EL = 1.694

PT NAME	CODE	ROD	DESCRIPTION
C15178	1/2" PIPE	6.562	CONTROL POINT BASE
C15179	1/2" Rod	" "	CHECK

BASE C C15178

N = 383691.425

E = 3709695.593

EL = 2.139

CK 15180 TO C15179

Found N = 383690.808 E = 3709715.146 EL = 1.950

SET N = 383690.825 E = 3709715.171 EL = 1.926

C15181	5/8" REBAR	6.562	5/8" REBAR SET FOR CONTROL
C15182	"	" "	" "

C PRA STATE OF LA,

10

BASE C C15181

N = 385643.411

E = 3697181.679

EL = 1.830

CK 15183 TO C15182

Found N = 385643.943 E = 3697181.591 EL = 1.716

SET N = 385643.948 E = 3697181.552 EL = 1.715

PT NAME	CODE	RD	DESCRIPTION
15184	PPE	13.30	TOP OF PIPE
15185	Snd	5.85	Sndg
15186	SGN	"	GROUND C SIGN POST
15187	PPE	13.30	TOP OF PIPE
15188	NG	5.85	NGROUND MARSH
15189	Snd	15.35	Sndg

CK 15190 TO 15182


Found N = 385643.944 E = 3697181.589 EL = 1.730

Pub N = 385643.978 E = 3697181.552 EL = 1.715

FILE: BA173-158-JP JUNE 19, 2015


PETROLEUM PIPELINE CROSSING
CHEVRON MIDSTREAM PL LLC
1-800-762-3404

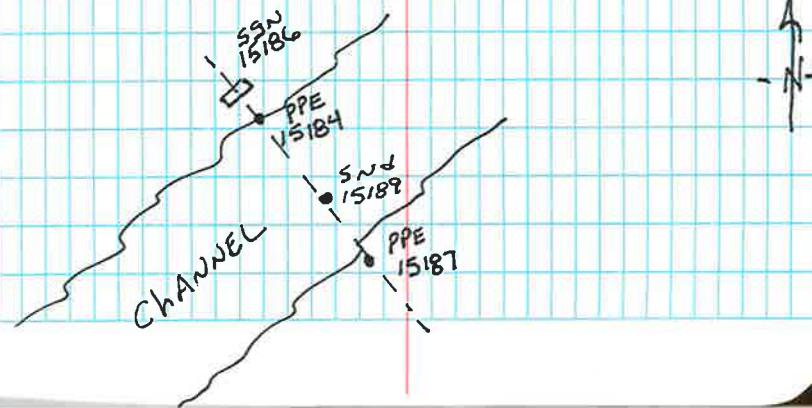Photo: 2242



CPIA STATE OF LA.

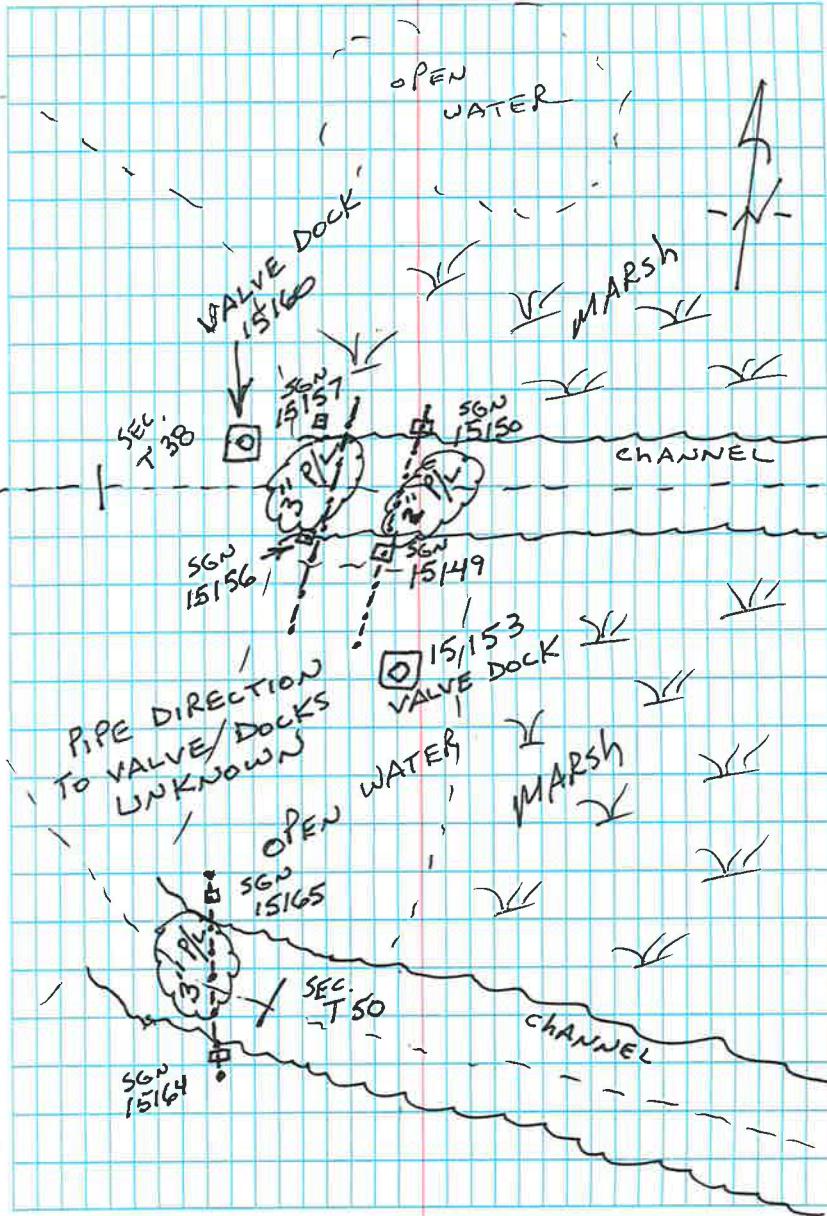11



CPRA STATE OF LA,

FILE: BA173-15B-JP JUNE 20, 2015

BASE C GBC-Z

N = 379403.282

E = 3755927.139

EL = 1.265

CK15191 TO PT^{II} 4874

Found N = 379418.708 E = 3755947.845 EL = 1.661

Pub N = 379418.694 E = 3755947.891 EL = 1.644

PT NAME	CODE	ROD	DESCRIPTION
15192	TBK	5.85	T.B. EDGE MARSH
15193	SND	"	TOE
15194	"	15.35	SNDING
15195	"	10.52	"
15196	"	"	MARSH GRASS LINE EDGE
15197	"	"	SNDING

15198	TBK	5.85	T.B.
15199	TOE	10.52	TOE
15200	SND	15.35	Sndg S
15201	"	"	"

SOUTH CHANNEL

North CHANNEL EAST P/L

CPRA STATE OF LA,

PT NAME	CODE	ROD	DESCRIPTION
---------	------	-----	-------------

15202	TBK	15.35	T.B.
-------	-----	-------	------

15203-04	SND	"	Sndgs
----------	-----	---	-------

15205 15205-06	SND	"	"
-------------------	-----	---	---

I25 PROBE SEARCH NEAR CHANNEL
NO PIPE FOUND

FILE: BA173-158-JP JUNE 20, 2015

1 North channel west P/C

1

BAYOU GRANDE CHENIER

MARSH ZONE RESTORATION

BA - 173

TOPOGRAPHIC, BATHYMETRIC, MAGNETOMETER

PLAQUES MINES PARISIEN, LA

JUNE 2015

CONTRACT NO.

ITEM NO: BA-173

SURVEY BY: E.M.C. INC
GRENADA, MS

SURVEY BY: R. HUTCHINSON
R. HUTCHINSON JR
C. PERRITT

INDEX

Page

CONTENTS

1	BASE SETUP & CHECK
2	MAG LINE ON CL-2
3	BASE SETUP & CHECK
4	MAG LINE ON CL-3
5-6	MAG ON INVESTIGATION POINTS
7	BASE SETUP & CHECK
8-10	MAG ON INVESTIGATION POINTS
11-	BASE SETUP & CHECK
12-17	MAG ON INVESTIGATION POINTS
18	BASE SETUP & CHECK
19-23	MAG ON INVESTIGATION POINTS

RTK BASE Setup

BASE @ IR GBC - 2

TRIMBLE R8 No 5257

ANT AT 2.000 meters

Check on Pt 4874 sec Pj J8 Bk 2
EST N. 379618.694 E - 3755947.891 EL 1.644
FWD N. 379618.699 E - 3755947.882 EL 1.641
FWD N. 379618 E - 3755947. EL

File: BA-173-RH1

06/10/15

1

Rover UNIT

TRIMBLE R8 No 0906

ANT Ht 2.000 meters

Pt 6342

Mag Lines CL-2

06/10/15

2

Line

File Name

CL-2

CL2.RAW

CL2-0001.RAW

CL2-0002.RAW

CL2-0003.RAW

CL2-0004.RAW

CL-1

CL1-0.RAW

Lay Back Lines

R7K BASE SETUP

3

BASE C IR GBC - 2

TRIMBLE R8 No 5257

ANT HT. 2.000 meters

06/11/15

FILE: DA-173-RH1

RAVER UNT

TRIMBLE R8 No 0906

ANT HT 2.000 meters

Check on PT 4874 Sec Blk 2 Pg 38

EST N 379618.684 E 3755947.891 EL 1.644

END N 379618.664 E 3755947.914 EL 1.644

File

START: 13.04

MAS Lines

Area Code ~~AZ 477~~

Line File Name

CL3 CL3.RAW

06/11/15 4

INVESTIGATION Points

INV PT

File

~~107~~

I 107

000-1100 . RAW
000-1102 . RAW
000-1103 . RAW
000-1104 . RAW
000-1105 . RAW

I 17

000-1113 . RAW
000-1114 . RAW
000-1115 . RAW
000-1116 . RAW
000-1117 . RAW
000-1118 . RAW
~~1120~~
000-1120 . RAW
000-1121 . RAW

06/11/15 5

Piece of CHAIN

CRAB TRAP

MAG INVEST POINTS

INVEST

FILE

I 103

000-1129.RAW

000-1130.RAW

000-1131.RAW

000-1133.RAW

I 11

000-1141.RAW

000-1142.RAW

000-1143.RAW

000-1144.RAW

I 10

000-1153.RAW

000-1154.RAW

000-11~~55~~⁵⁶.RAW000-115~~7~~.RAW

4

Lay BACK Line 0002.RAW

"

"

"

0003.RAW

06/11/15

CABLE

CRAB POT

SCRAP IRON OFF A OLD BOAT

RTK BASE Setup

BASE C = R GBC-1

Trimble RB No 5257

ANT HT. 2.000 meters

Check on PT 4874 TBLK Pg 38
See BE 2.

EST N.379618.694 E.3755947.891 EL. 1.644

Fwd. N.379618.694 E.3755947.854 EL. 1.642

File: 52571661

START: 13:27

File: BA-173-RH1

06/15/15

2

POWER UNIT

Trimble RB No 0906

ANT HT. 2.000 meters

PT 6344

MAG INVEST POINTS

I-IV A

File

I-23

000-1232.RAW
000-1233.RAW
000-1235.RAW
000-1236.RAW

I-43

000-1254.RAW
000-1255.RAW
000-1256.RAW
000-1257.RAW

I-37

000-1307.RAW
000-1308.RAW
000-1310.RAW
000-1311.RAW

I-113

000-1329.RAW
000-1330.RAW
000-1331.RAW
000-1332.RAW

File: BA-173. RH1

06/15/15

5

CABLE

DID NOT FIND ANY THINGS
NO EVIDENCE OF PIPE LINE

SCRAP IRON FROM BOAT

CRAB TRAP

POINT CLOSE TO BANK WITH TREES
IN WATER

MAG INVEST Points

INVEST

FILE

I114

000-1342. RAW
000-1343. RAW
000-1344. RAW
000-1345. RAW

I112

000-1421
000-1423. RAW
000-1424. RAW
000-1425. RAW
000-1426. RAW

I27

000-1436. RAW
000-1437. RAW
000-1438. RAW
000-1439. RAW

I108

000-1446. RAW
000-1447. RAW
000-1448. RAW
000-1449. RAW

FILE: BA173.RH1 06/15/15

9

CRAB TRAP

DELETE X
SCRAPE IT DOWN

~~CRAB POT~~

CRAB TRAP

MAG INVEST POINTS

INVEST

FILE

I 39

000-1505.RAW
000-1507.RAW
000-1508.RAW
000-1509.RAW

I 19

000-1519.RAW
000-1520.RAW
000-1521.RAW
000-1522.RAW

I 18

000-1526.RAW
000-1527.RAW
000-1528.RAW
000-1529.RAW

LAY BACK - 0004

LAY BACK - 0005

LAY BACK - 0006

FILE: BA-173-R4

06/15/15

10

CRAB TRAPS

NOTE: ~~I 15, I 16~~
UNABLE TO RUN
DUE TO BARGE PARKED
ON LINE OR NEAR
TARGET.

CRAB TRAP IN
CHANNEL.

SCRAP FROM OFF BOAT

Delete *

PTK Base Setup

BASE C IN GBC-1

TRIMBLE R8 NO. 525

ANT HT. 2.00 meters

Check on PT 4874 See Blk 2 Pg 38
Est N. 379618.694 E. 3755947.853 & L. 1.644
Fwd. N. 379618.644 E. 3755947.853 & L. 1.650

File: 5257167

File: BA.173.RH, 06/16/15

"

Rover unit

Trimble R8 0906

Ant ht. 2.000 meters

PT 6345

MAG INVEST Points

INVEST

File

LAY BACK - 0007.RAW

LAY BACK - 0008. "

I225

000-0940.RAW

000-0941.RAW

000-0942.RAW

000-0944.RAW

I105

000-0947.RAW

000-0948.RAW

000-0950.RAW

000-0951.RAW

I109

000-0959.RAW

~~000-100~~

~~59.000~~ RAW

000-0959-0001.RAW

000-1002.RAW

000-1003.RAW

File: BA-173-R111

06/16/15

12

CRAB TRAPS.

Point Close To Bank

CRAB TRAP.

Point Close To BANK OF CRABS

CRAB TRAP

MAG INVEST. Points

INVEST

File

I 228

000-1009.RAW
000-1010.RAW
000-1011.RAW
000-1012.RAW

I 106

000-1027.RAW
000-1028.RAW
000-1029.RAW
000-1030.RAW

I 104

000-1034.RAW
000-1035.RAW
000-1036.RAW
000-1037.RAW

I 40

000-1044.RAW
000-1045.RAW
000-1047.RAW
000-1050.RAW

FILE: PA-173-RH1

06/16/15

13

CRAB TRAP

WIRE/CABLE

WIRE/CABLE

SCRAP IRON OFF BOAT

MAG INVEST. Points

PT

File.

I30

000-1107.RAW

000-1108.RAW

000-1109.RAW

000-1110.RAW

000-1112.RAW

I35

000-1127.RAW

000-1127-0001.RAW

000-1129-0001.RAW

000-1130-0001.RAW

I110

000-1136.RAW

000-1137.RAW

000-1138.RAW

000-1139.RAW

File: BA-123-RH1 06/16/15

14

CRAZ POT / SCRAP IRON

JUNK

CABLE

MAG INVEST. PT

INV PT

FILE

I 2

000-1144-0001.RAW

000-1145.RAW

000-1147.RAW

000-1147-0001.RAW

I 102

000-1152-Raw

000-1153-0001.RAW

000-1154-0001.RAW

000-1155.RAW

I 36

000-1203.RAW

000-1209.RAW

000-1210.RAW

000-1211.RAW

I 111

000-1221.RAW

000-1223.RAW

000-1224.RAW

000-1225.RAW

File: BA-173-RH1

06/16/15

15

Wire

SCRAP IRON

STEEL PLATE

SCRAP IRON

May Invent Points

INPUT

File

I9

000-1333-0001.RAW
000-1334.RAW
000-1335.RAW
000-1336.RAW

I01

000-1343-0001.RAW
000-1344-0001.RAW
000-1345.RAW
000-1346.RAW

I100

000-1352.RAW
000-1352-0001.RAW
000-1353.RAW
000-1354.RAW

I25

000-1420.RAW
000-1420-0001.RAW
000-1421.0001.RAW
000-1422.RAW

File: BA-173-RA1

06/16/15

Nothing Found

Found Nothing

GRAB TRAP

~~unk~~ UNKNOWN

MAG INVEST Points

INPUT

FILE

I 221

000-1438-0001.RAW
000-1439-0001.RAW
000-1440.RAW
000-1441.RAW

I 222

000-1446-0001.RAW
000-1447-0001.RAW
000-1448-0001.RAW
000-1449-0001.RAW
000-1457.RAW

I 223

000-1509.RAW
000-1510.R
000-1511.RAW
000-1512.RAW

FILE: BA-173-RH1

06/16/15

CRAB TRAP

CRAB TRAP

* Delete

Wire Basket & CABLE

RTK BASE

BASE @ INO GBC - 2

TRIMBLE R8 NO. 5257

ANT HT 2.000 METERS

Check on Pt 4874 See Bk2 Pg 38

EAST N. 379618, 694 E. 3755947.891 EL. 1.694

END 14-379618, 655 E. 3755947.912 EL. 1.657

FILE: 52571680

START: 13-12

FILE: BA-173-BH1

06/17/15

18

Rover w.r.t

TRIMBLE R8 NO. 0906

ANT HT 2.000 METERS

1

PT 6347

MAG INVEST Points

INPUT

FILE

Lay Back - 0009.RAW
Lay Back - 0010.RAW

I220

000-0915.RAW
000-0916.RAW
000-0917.RAW
000-0918

I218

000-0925.RAW
000-0926.RAW
000-0927.RAW
000-0928.RAW

I219

000-0934.RAW
000-0936.RAW
000-0937.RAW
000-0937.001.RAW

File: BA-173-RH1

06/17/15

19

CRAB TRAPS *

~~Pipe Line~~

CRAB TRAPS

CRAB TRAPS

NOTE:
LOTS OF CRAB
TRAPS IN
AREA

MAG Invest Points

IHU Pt

File

I213

000-0952.RAW

000-0953.RAW

000-0954.RAW

000-0955.RAW

I214

000-1004.RAW

I215

000-1012.0001.RAW

000-1013.RAW

000-1014.RAW

000-1015.RAW

I216

000-1024.RAW

000-1025.RAW

000-1026.RAW

000-1027.0001.RAW DELETE

000-1028.0001.RAW

File: DA-173-RH1

06/17/15

20

CRAZ TRAPS

~~ABANDON Pipe Line~~

Founds CABLE

SECTION TO BE OLD SUNK PLATFORM
WITH ABANDON PIPE LINE

PHOTO 2241

~~ABANDON~~

~~ABANDON Pipe Line~~

~~Founds CABLE~~ Founds Nothing.

AFTER PROBING

~~SCRAP~~

AFTER PROBING Nothing Founds

Mag INvest Points

INPUT

File.

I217

000.1042.RAW
 000.1043.RAW
 000.1044.0001.RAW
 000.1045.0001.RAW

I212

000.1058.RAW
 000.1058.0001.RAW
 000.1100.0001.RAW
 000.1101.RAW

I209

000.1241.RAW
 000.1242.RAW
 000.1242.0001.RAW
 000.1244.RAW

I210

000.1250.RAW
 000.1251.RAW
 000.1252.RAW
 000.1253.RAW

File: BA-173-Rd1

06/17/15

CRAB TRAP

CRAB TRAP

CRAB TRAP

Possible Pipe Line (No Pipe)
 Probe For 30 minutes.
~~Set~~ Sunked CRAB TRAP

1408 INVEST Points

Ind. At

File

I211

000-1255-001.RAW
000-1256-001.RAW
000-1257-001.RAW
000-1258.RAW

I200

000-1304.RAW
000-1305.RAW
000-1306.RAW
000-1307-0001.RAW

I201

000-1312-0001.RAW
000-1313.RAW
000-1314.RAW
000-1315.RAW

I202

000-1323.RAW
000-1324.RAW
000-1325.RAW
000-1326.RAW

File: BA-123-RD1 06/17/15

22

Possible Pipe Line

Probe for 30 minutes nothing found

Probe
Pipeline (Found Nothing)

~~GRAB TRAP~~ Sonar BOAT

UNKNOWN OBJECT IN DEEP WATER

MAG INVEST 10 mins

INV. #

File

I203

000-1330-0001-.RAW
000-1331-0001-.RAW
000-1332-.RAW
000-1333-~~RA~~0002-.RAW
000-1333-0003-.RAW

I204

000-1337-.RAW
000-1338-.RAW
000-1339-.RAW
000-1339-0001-.RAW

I205

000-1342.0001-.RAW
000-1343.0002-.RAW
000-1344.0002-.RAW
000-1344.0003-.RAW

I206

CRAB TRAP NEAR BANK

I207

" " "

I208

000-1404-.RAW

File: RA173-RH1

06/17/15

SUNKEN ~~GARDEN~~ CRAB TRAP

CRAB TRAP SUNK

Pipe-Line Crossing

CRAB TRAP

~~14 Ag Survey Points~~

BASE setup

Survey

File

BASE @ 6256 GSC -3

TRIMBLE 28 No.

ANT HT 2.000 METERS

Check on Pt 6257

Est. N. 387160.999 E-3719420.203 El 1.694

Frig. N. 387160.875 E-3719420.146 El 1.693

File : 52571690

START 13:28

File: BA-173-RH1

06/17/15

24

Pt 6348

Pipeline Pages

PTNO CODE ANT H7

BASE @ IR GBC - 2

TRINOLC R8 NO 0906

ANT H7 2.000 meters

Check on PT 4874 see AKZ Pg 38

EST. N 37° 6' 18.694 E -37° 55' 947.891 EL 1.654

END. N 37° 6' 18.691 E -37° 55' 947.843 EL 1.639

File: BA-173. R41

06/18/15

25

Rover unit

TRINOLC R8 NO

ANT H7

PT 6349

MAG INVEST Points

Inv No F

PROB CODE ANTI FT

I213 - -

I215 - -

I216 - -

I220 - -

FILE: PA-173-PA1 06/20/15

26

Description

Fence CABLE

AFTER PROBING NOTHING WAS FOUND

NOTHING FOUND AFTER PROBING

CHARGE SOURCE TO CRAB TRAP