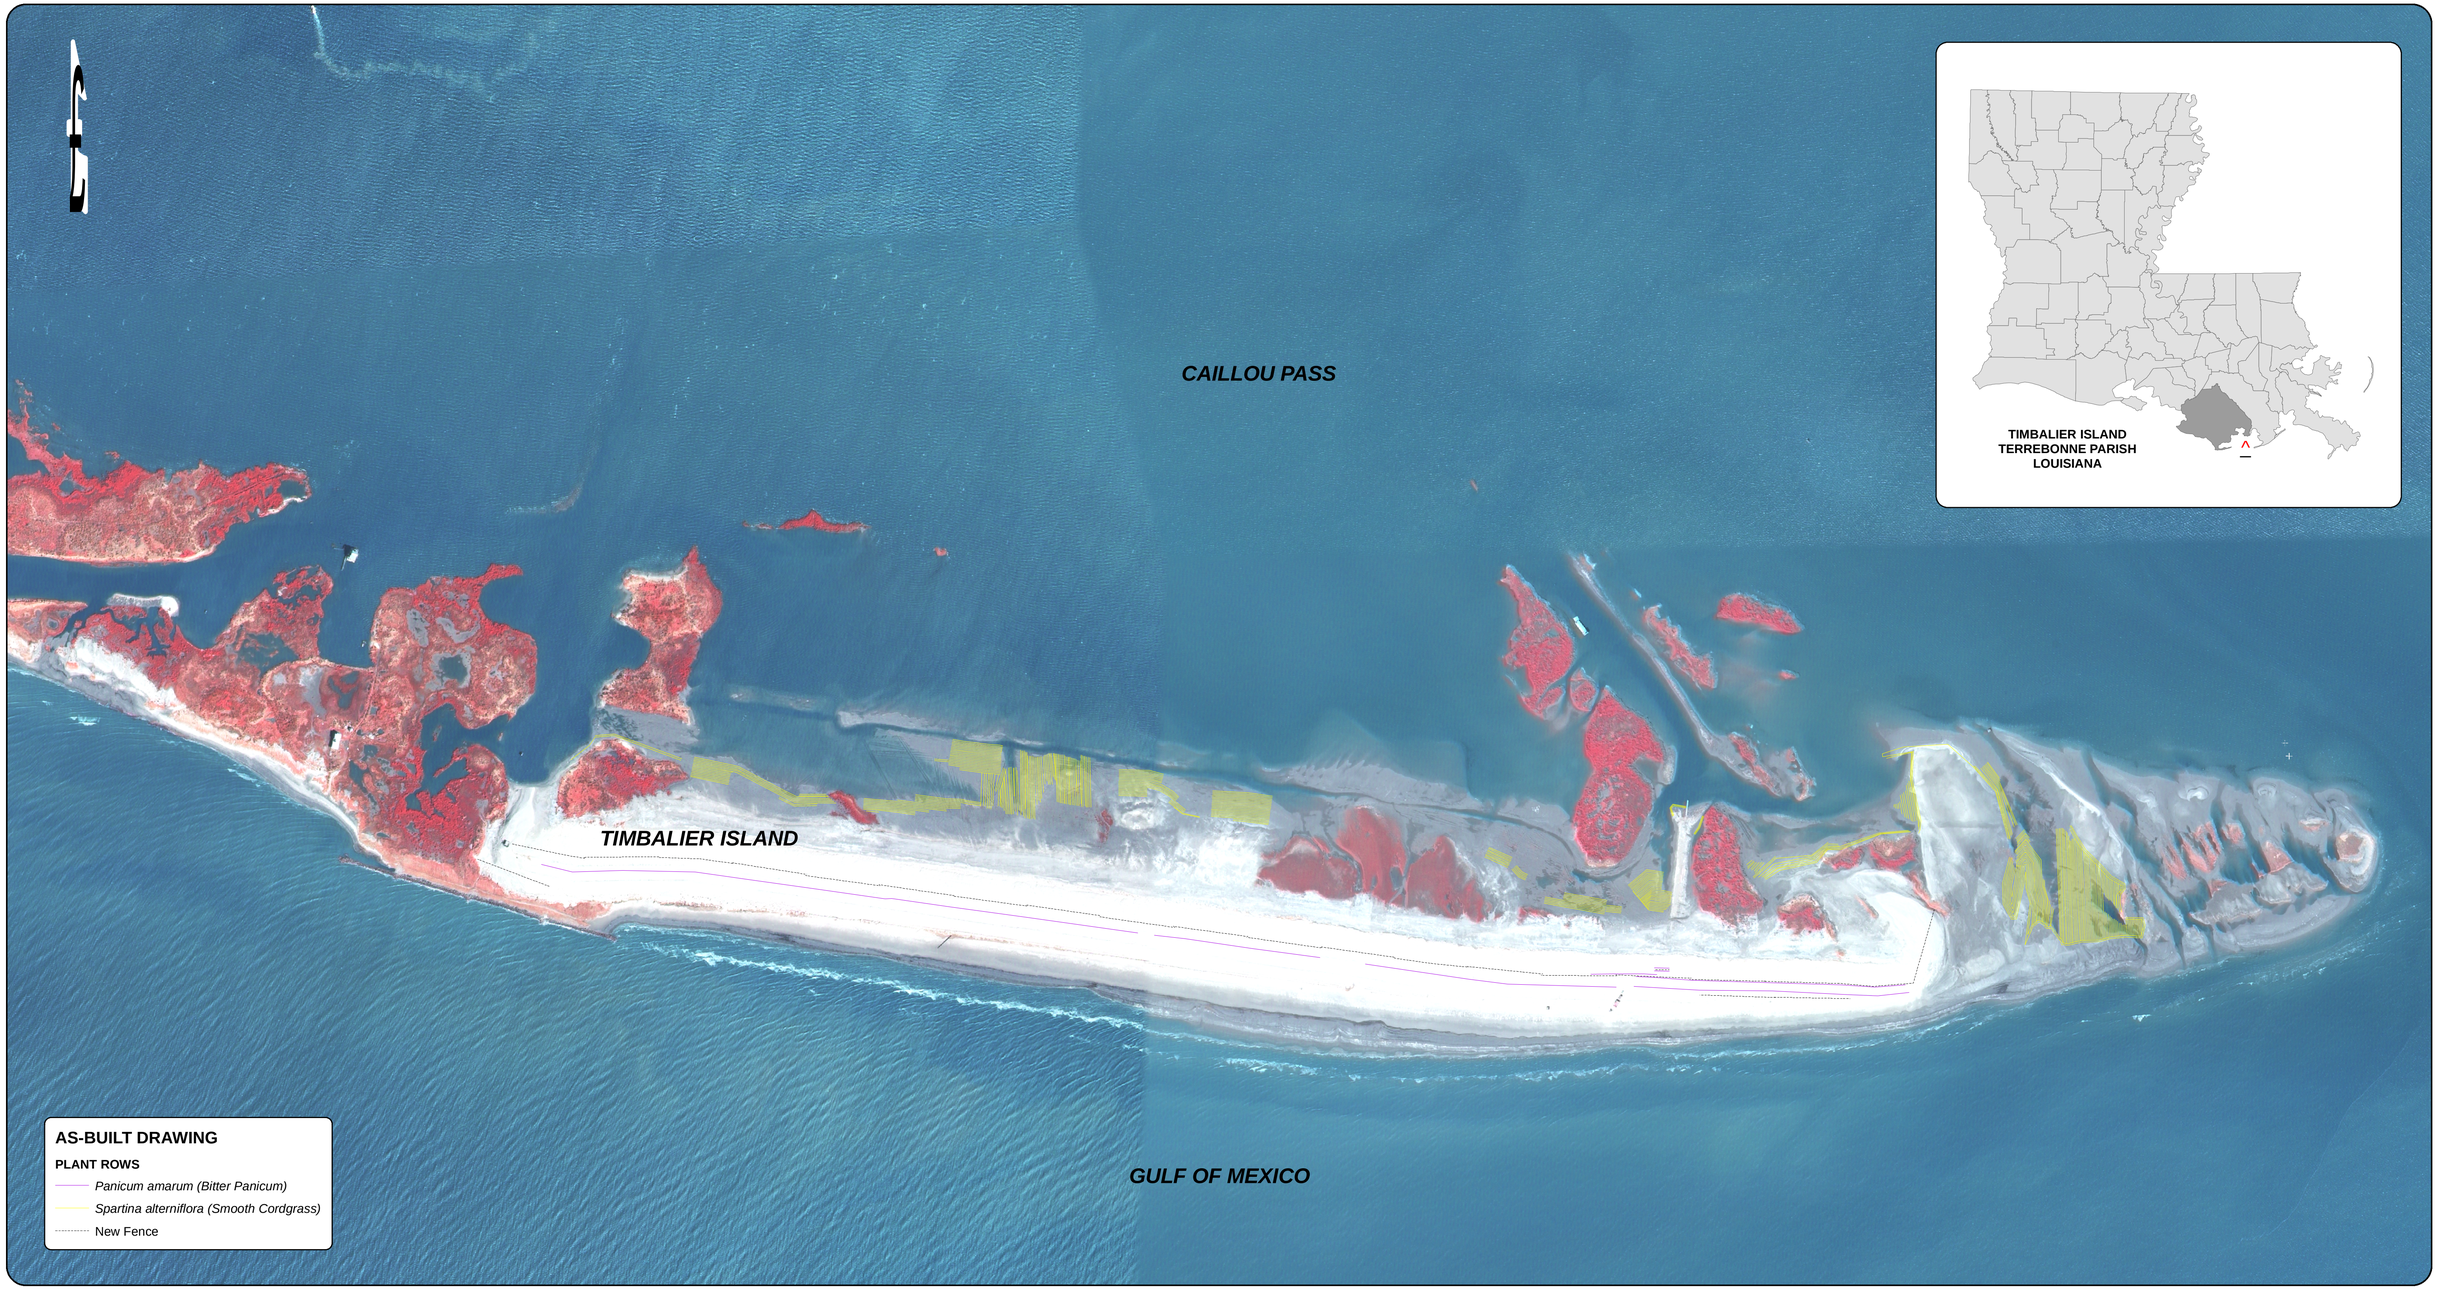


Feet
0 500 1,000 2,000 3,000 4,000

283 Corporate Drive
P.O. Box 3106
Houma, LA 70361

Voice: (985) 879-2731
Fax: (985) 876-9052

Morris P. Hebert, Inc.
client focused solutions

One Sterling Place
10101 SW Freeway, Ste 400
Houston, TX 77074


Voice: (713) 219-1470
Fax: (713) 219-4171

Surveying - Engineering - Environmental Services - GIS
http://www.mphinc.com

BLACK LAKE MARSH, INC.

AS-BUILT FOR TIMABLIER ISLAND VEGETATIVE PLANTINGS - PHASE II
DNR-CED PROJECT TE-40 / EPA PROJECT XTE-45a
TERREBONNE PARISH, LOUISIANA

DRAWN BY:	GML	SHEET:	1
CHECKED BY:	DEC	SCALE:	1 " equals 500 '
APPROVED BY:	DEC	DATE:	6/13/06
DRAWING NO.:	G: 9037DNR0001A0.MXD		

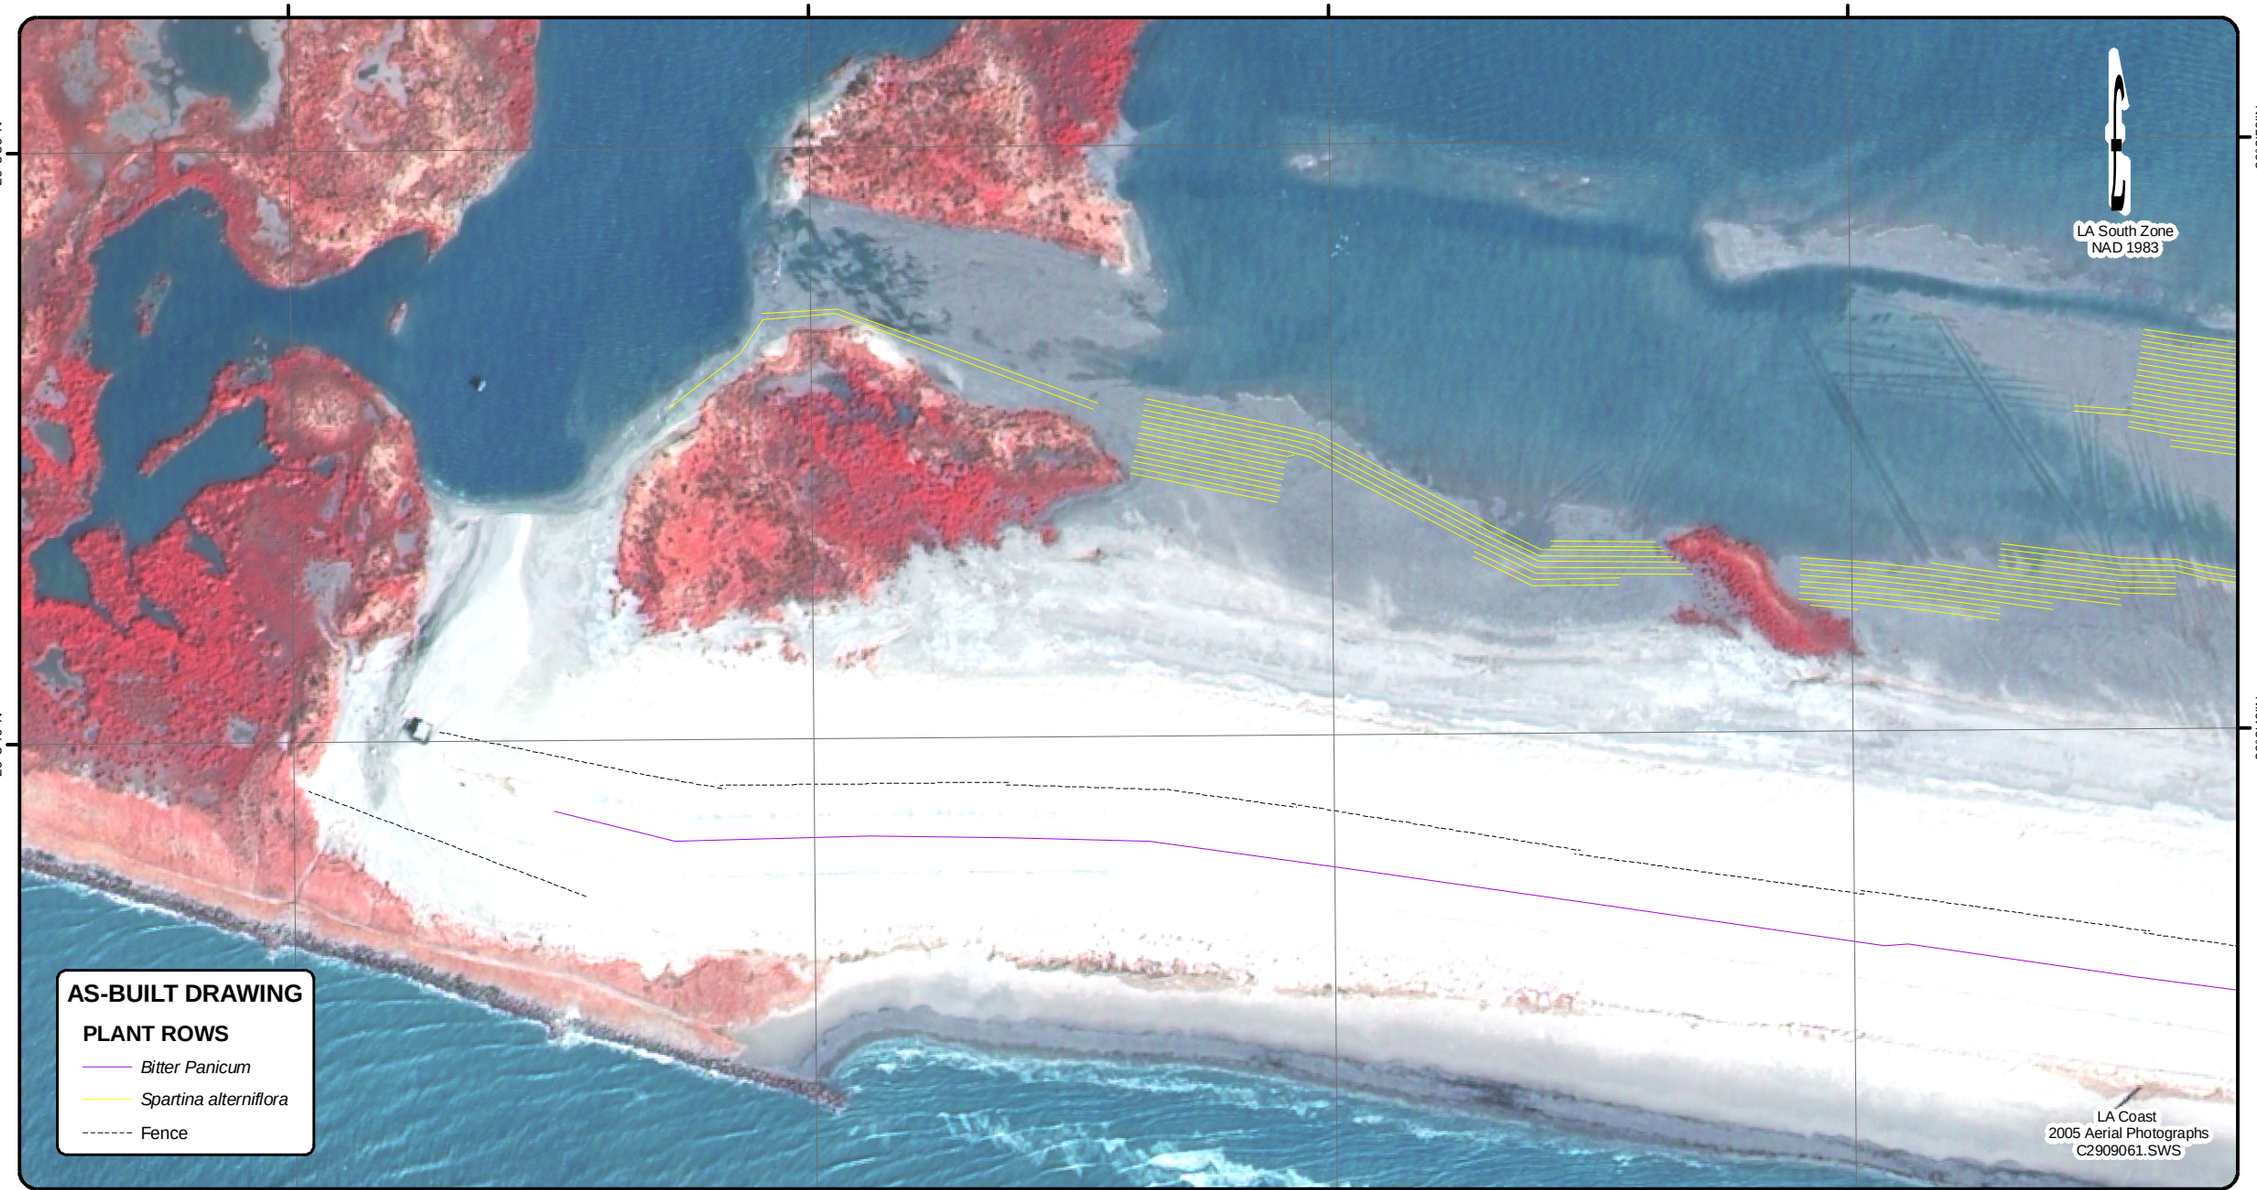

283 Corporate Drive
P.O. Box 3106
Houma, LA 70361
Voice: (985) 879-2731
Fax: (985) 876-9052

mph
Morris P. Hebert, Inc.
client focused solutions


One Sterling Place
10101 SW Freeway, Ste 400
Houston, TX 77074
Voice: (713) 219-1470
Fax: (713) 219-4171

Surveying - Engineering - Environmental Services - GIS
http://www.mphinc.com

BLACK LAKE MARSH, INC.

AS-BUILT FOR TIMABLIER ISLAND VEGETATIVE PLANTINGS - PHASE II
DNR-CED PROJECT TE-40 / EPA PROJECT XTE-45a
TERREBONNE PARISH, LOUISIANA

DRAWN BY:	GML	SHEET:	2
CHECKED BY:	DEC	SCALE:	1 " equals 300 '
APPROVED BY:	DEC	DATE:	6/13/06
DRAWING NO.:	G: 9037DNR0002A0.MXD		

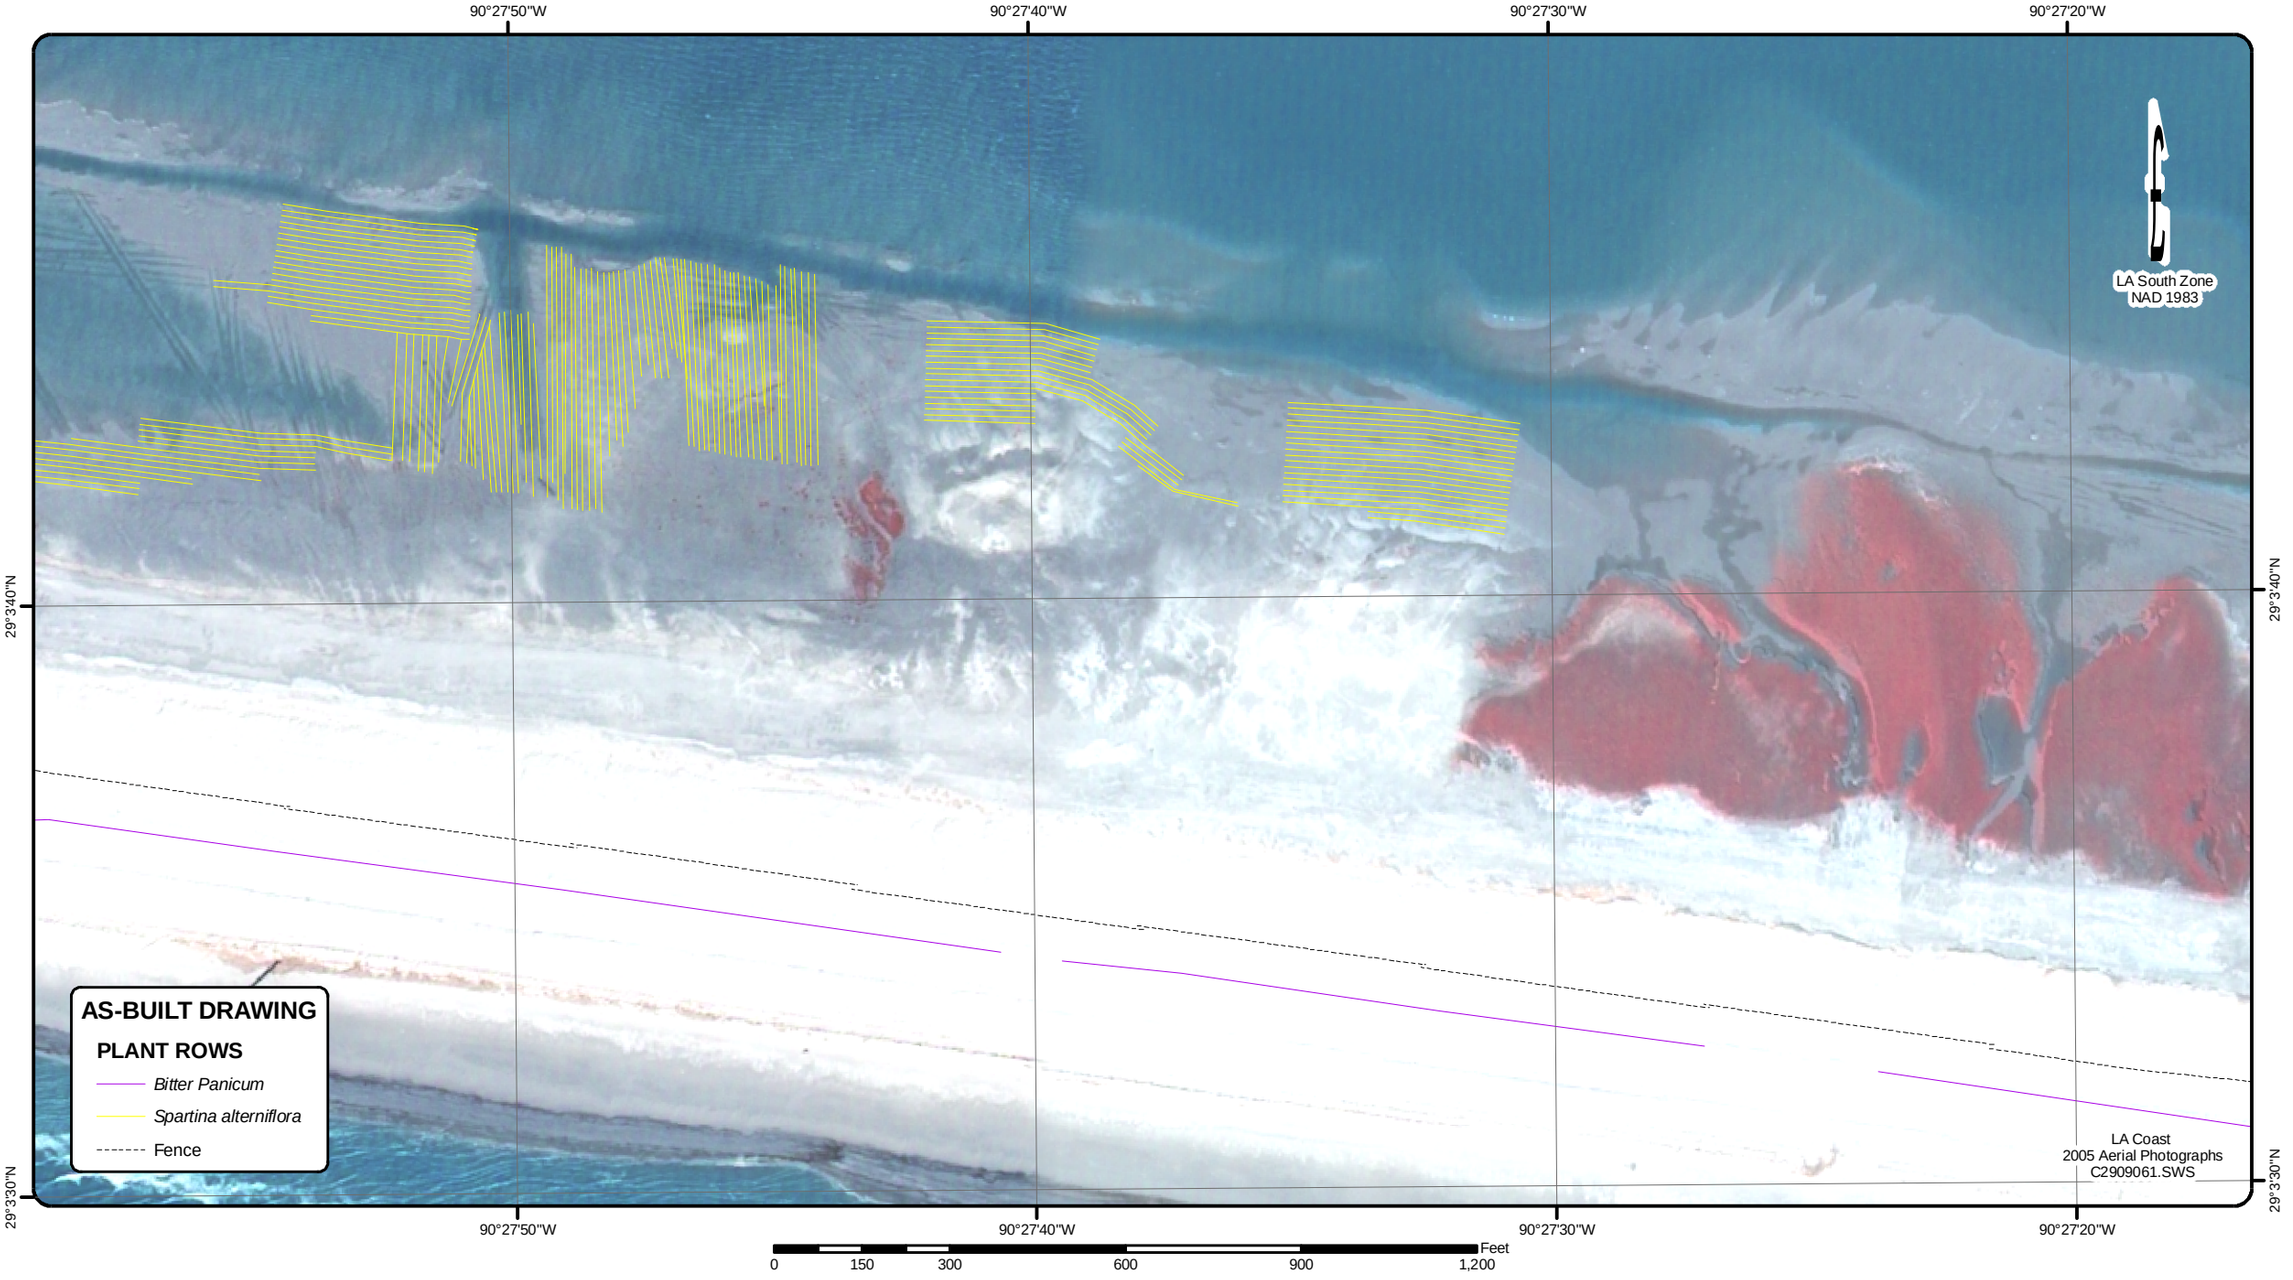

283 Corporate Drive
P.O. Box 3106
Houma, LA 70361
Voice: (985) 879-2731
Fax: (985) 876-9052

mph
Morris P. Hebert, Inc.
client focused solutions


One Sterling Place
10101 SW Freeway, Ste 400
Houston, TX 77074
Voice: (713) 219-1470
Fax: (713) 219-4171

Surveying - Engineering - Environmental Services - GIS
http://www.mphinc.com

BLACK LAKE MARSH, INC.

AS-BUILT FOR TIMABLIER ISLAND VEGETATIVE PLANTINGS - PHASE II
DNR-CED PROJECT TE-40 / EPA PROJECT XTE-45a
TERREBONNE PARISH, LOUISIANA

DRAWN BY:	GML	SHEET:	3
CHECKED BY:	DEC	SCALE:	1 " equals 300 '
APPROVED BY:	DEC	DATE:	6/13/06
DRAWING NO.:	G: 9037DNR0003A0.MXD		

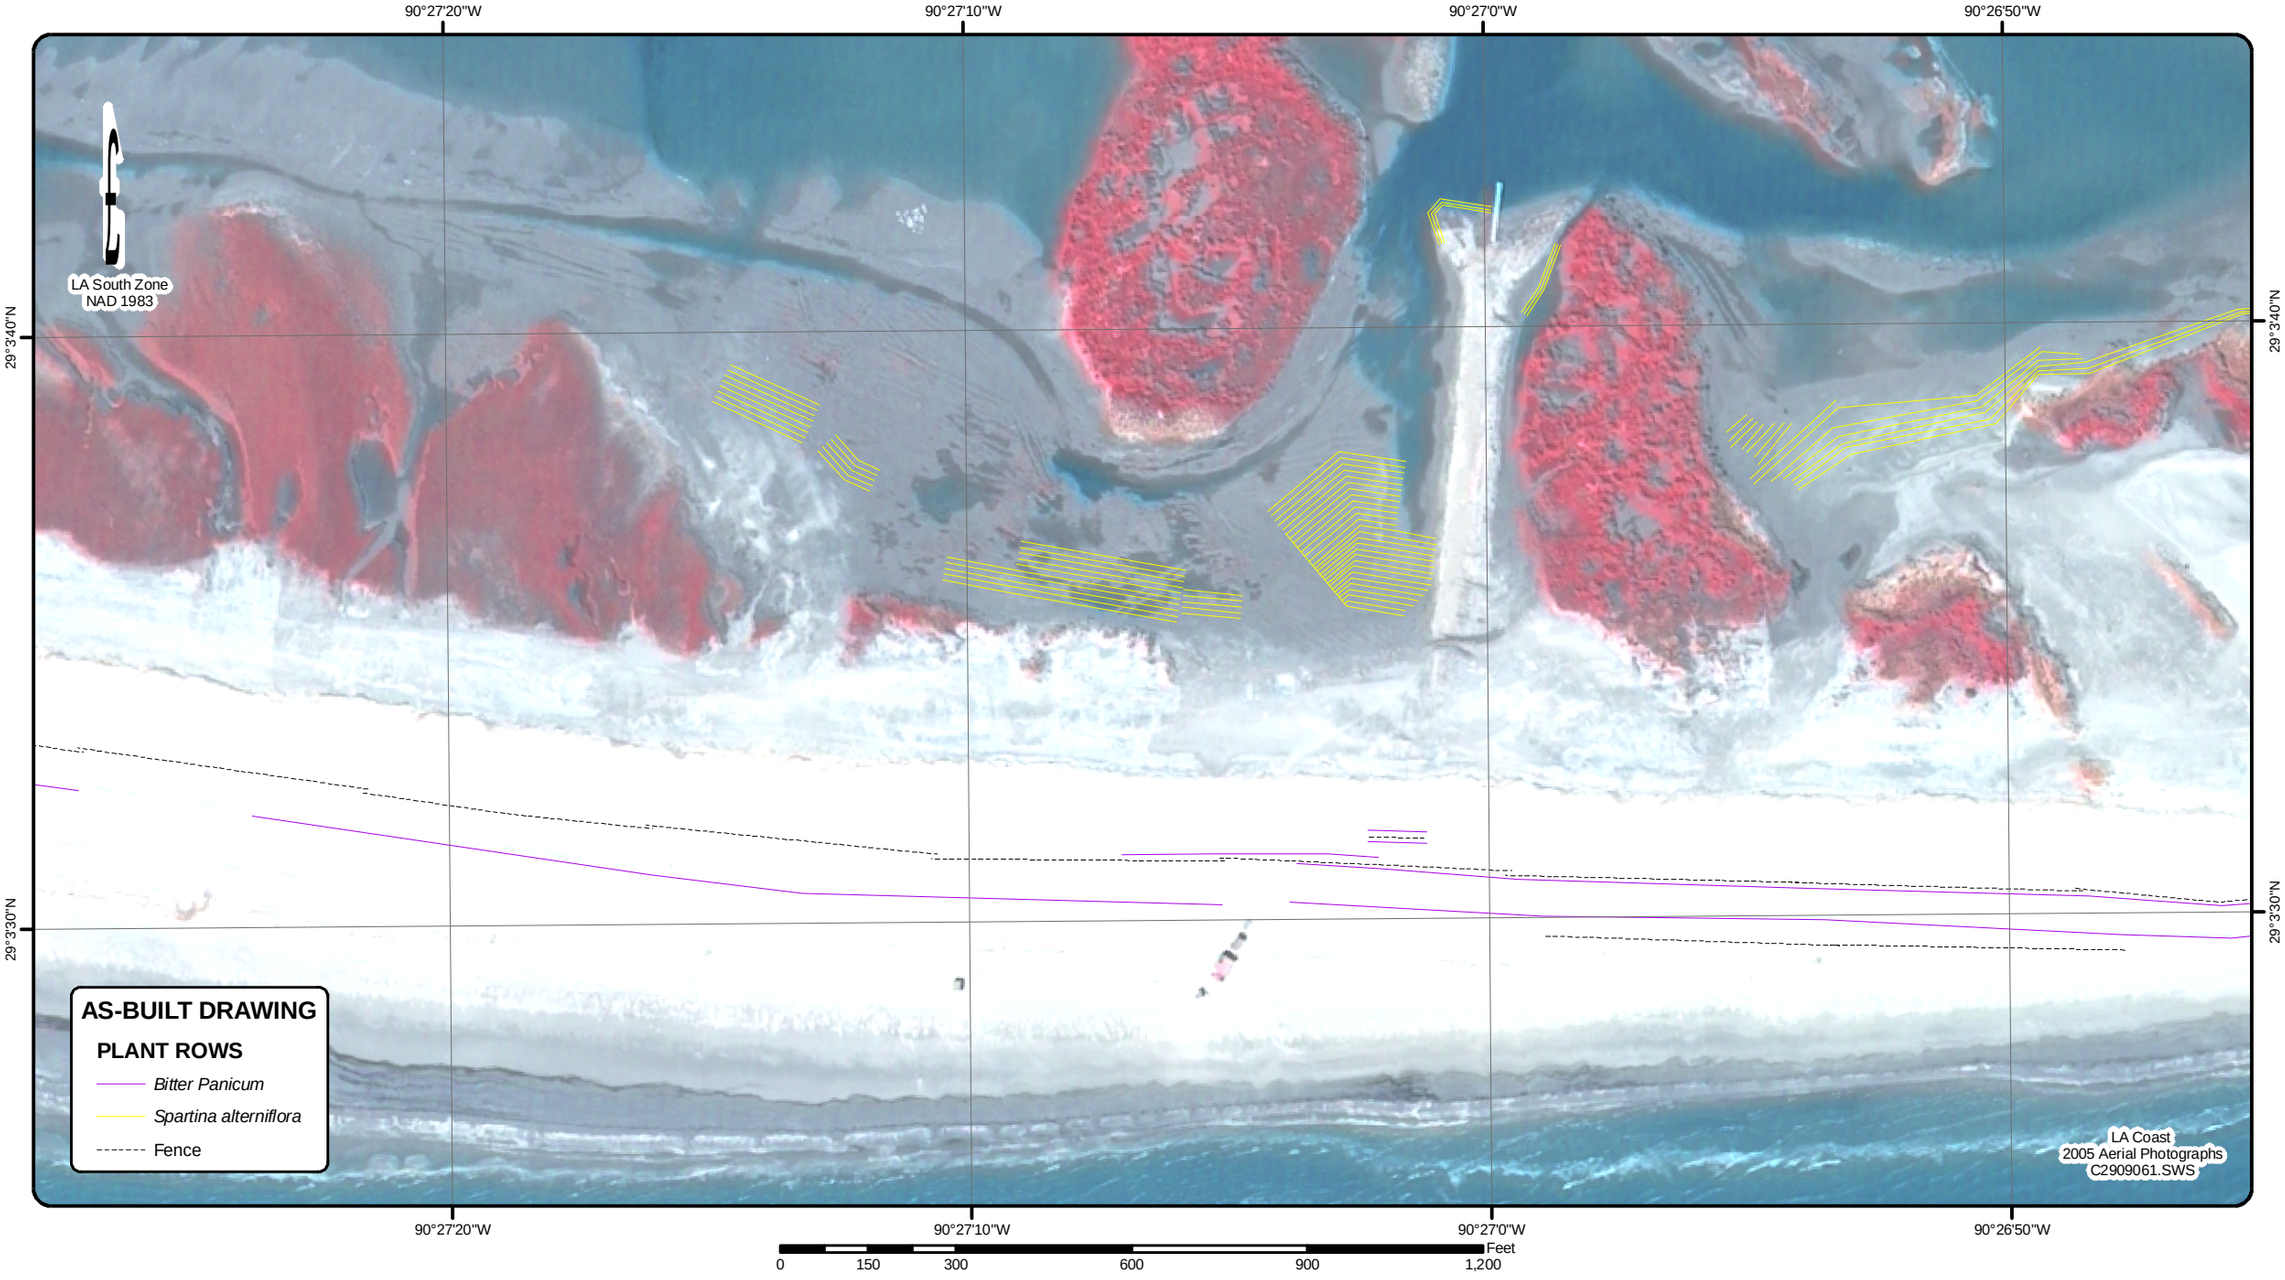

283 Corporate Drive
P.O. Box 3106
Houma, LA 70361
Voice: (985) 879-2731
Fax: (985) 876-9052

One Sterling Place
10101 SW Freeway, Ste 400
Houston, TX 77074
Voice: (713) 219-1470
Fax: (713) 219-4171


mph Morris P. Hebert, Inc. client focused solutions

Surveying - Engineering - Environmental Services - GIS
http://www.mphinc.com

BLACK LAKE MARSH, INC.

AS-BUILT FOR TIMABLIER ISLAND VEGETATIVE PLANTINGS - PHASE II
DNR-CED PROJECT TE-40 / EPA PROJECT XTE-45a
TERREBONNE PARISH, LOUISIANA

DRAWN BY:	GML	SHEET:	4
CHECKED BY:	DEC	SCALE:	1 " equals 300 '
APPROVED BY:	DEC	DATE:	6/13/06
DRAWING NO.:	G: 9037DNR0004A0.MXD		

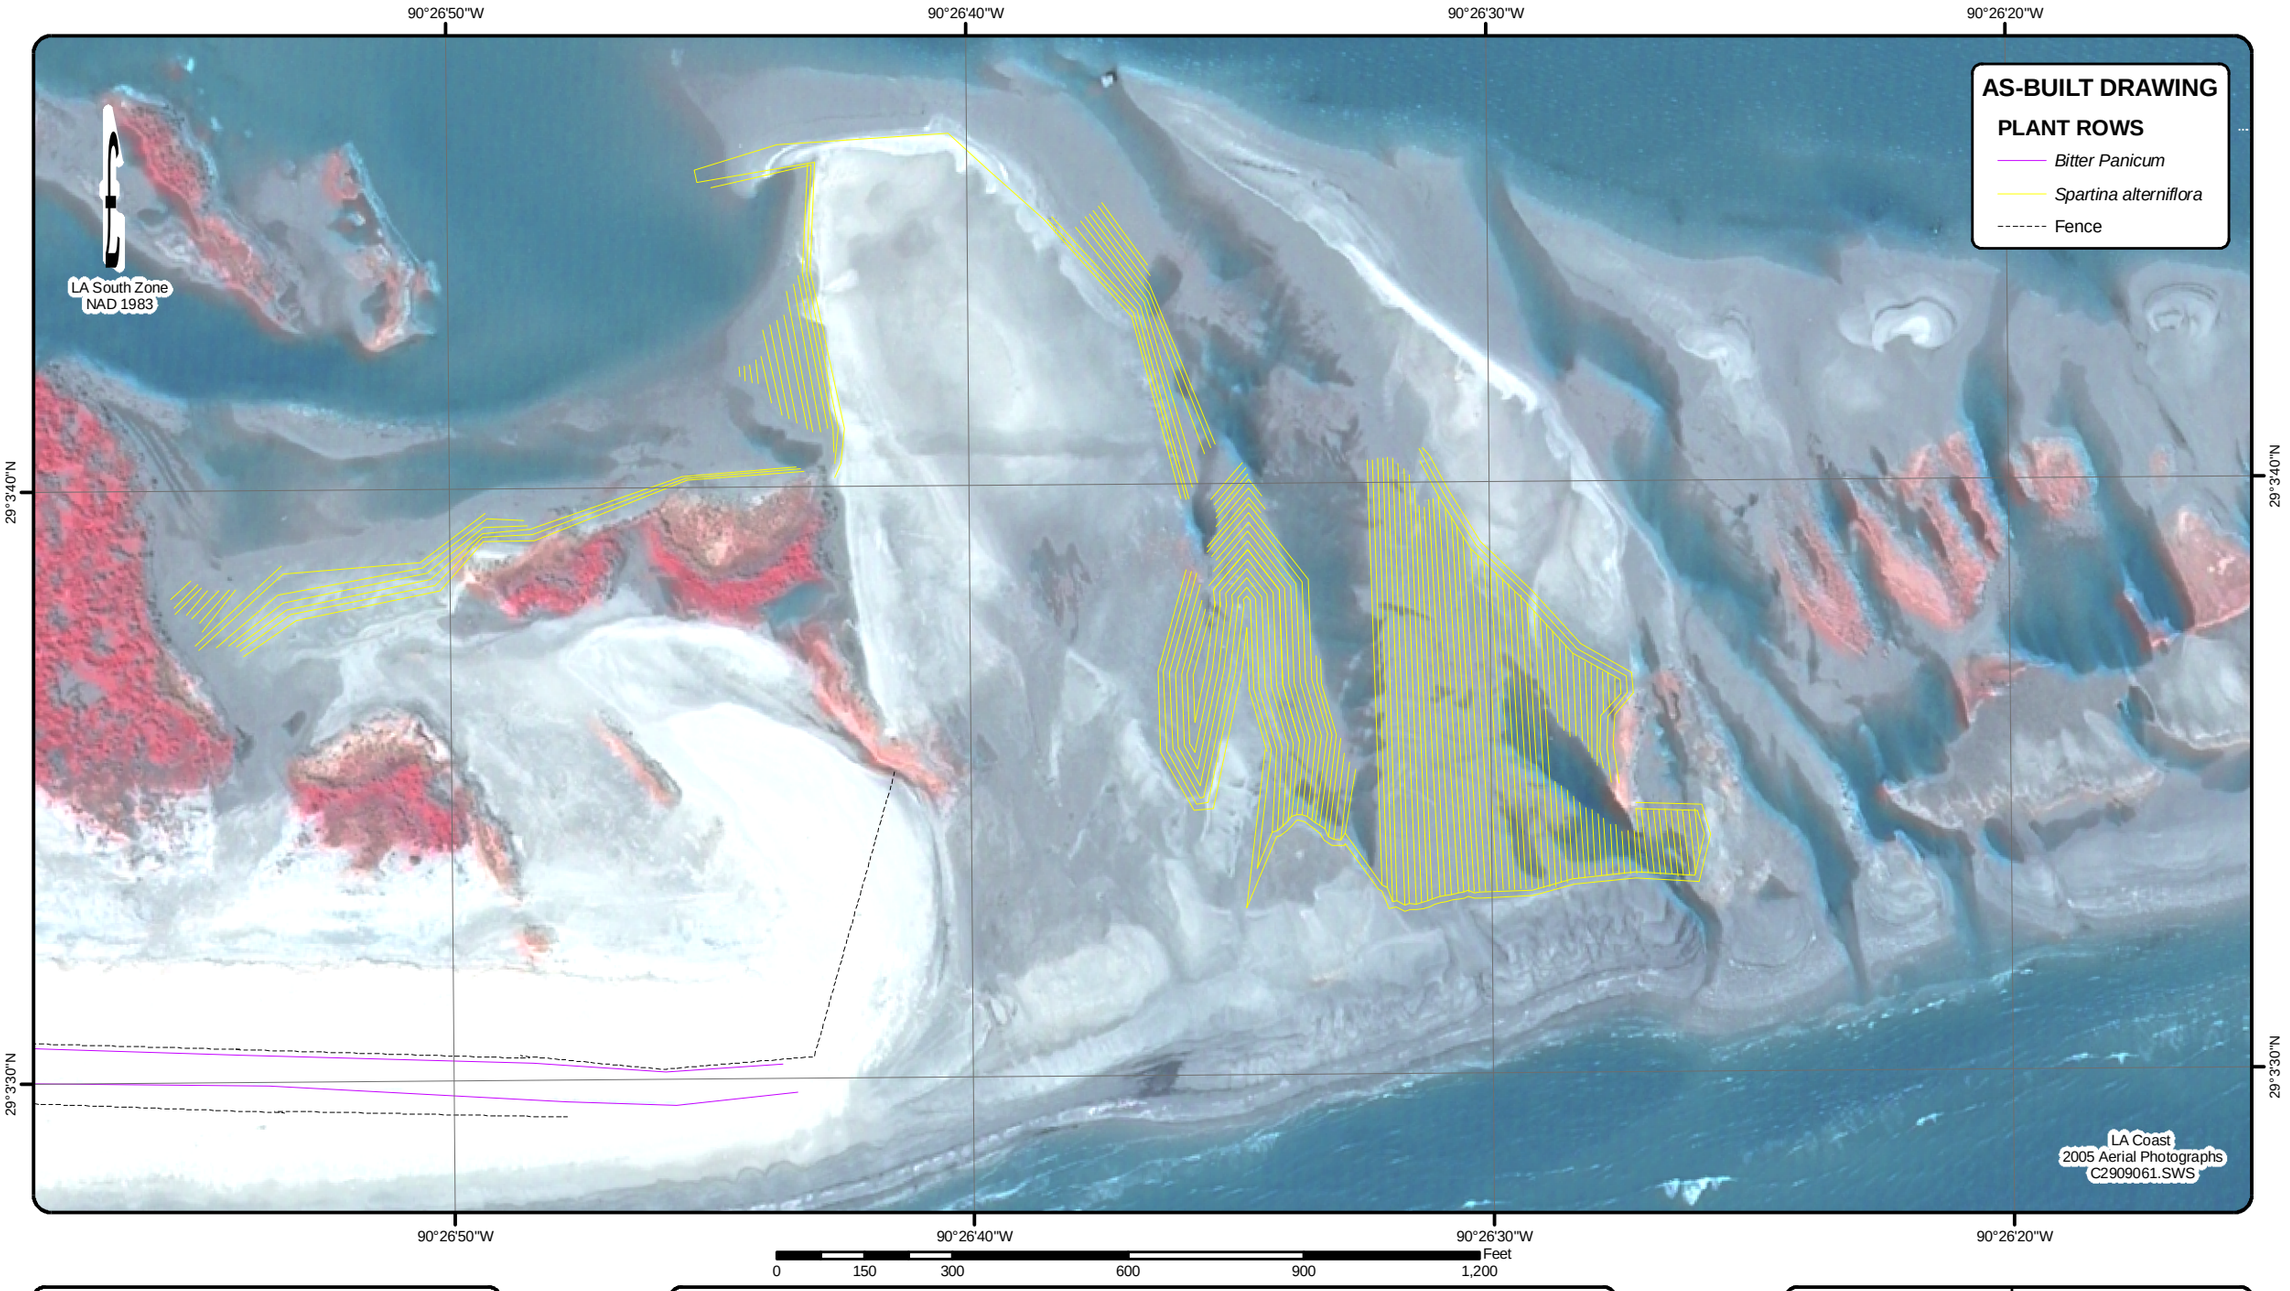

283 Corporate Drive
P.O. Box 3106
Houma, LA 70361
Voice: (985) 879-2731
Fax: (985) 876-9052

mph
Morris P. Hebert, Inc.
client focused solutions

One Sterling Place
10101 SW Freeway, Ste 400
Houston, TX 77074
Voice: (713) 219-1470
Fax: (713) 219-4171

Surveying - Engineering - Environmental Services - GIS
http://www.mphinc.com

BLACK LAKE MARSH, INC.

AS-BUILT FOR TIMABLIER ISLAND VEGETATIVE PLANTINGS - PHASE II
DNR-CED PROJECT TE-40 / EPA PROJECT XTE-45a
TERREBONNE PARISH, LOUISIANA

DRAWN BY:	GML	SHEET:	5
CHECKED BY:	DEC	SCALE:	1 " equals 300 '
APPROVED BY:	DEC	DATE:	6/13/06
DRAWING NO.:	G: 9037DNR0005A0.MXD		