
SHT. NO.	DESCRIPTION
1	TITLE SHEET
2	VICINITY MAP
3	GENERAL LAYOUT
4	SUBAREA "A" LAYOUT
5-5A	SUBAREA "A" COORDINATES
6	SUBAREA "B" LAYOUT
7-7A	SUBAREA "B" COORDINATES
8	TERRACE DETAILS

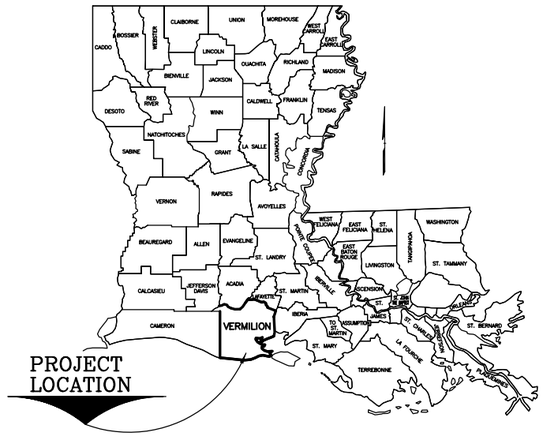

VICINITY MAP

PECAN ISLAND TERRACE CREATION PROJECT

(ME-14/XME-22)

SOUTH OF THE
PECAN ISLAND COMMUNITY
AND LA HWY. 82
VERMILION PARISH, LOUISIANA

FOR

U.S. DEPARTMENT OF COMMERCE
NATIONAL OCEANIC AND ATMOSPHERIC ADMINISTRATION
NATIONAL MARINE FISHERIES SERVICE

IN COOPERATION WITH
STATE OF LOUISIANA
DEPARTMENT OF NATURAL RESOURCES
COASTAL RESTORATION DIVISION

STATE OF LOUISIANA
DAVID P. HIDALGO
REG. No. 27074
REGISTERED
PROFESSIONAL ENGINEER
IN
CIVIL ENGINEERING

PROJECT DESCRIPTION: PECAN ISLAND TERRACE CREATION PROJECT (ME-14/XME-22)

PROJECT NO.: 99-33

DATE: SEPTEMBER 2003


AUCOIN & ASSOCIATES, INC.
CONSULTING ENGINEERS
AND LAND SURVEYORS
EUNICE, LOUISIANA

LOUISIANA DEPARTMENT OF NATURAL RESOURCES

PECAN ISLAND TERRACE CREATION PROJECT (ME-14/XME-22)

AS-BUILT DRAWINGS

File name: H:\CONST\99-33\As-Builts\TITLE.DWG

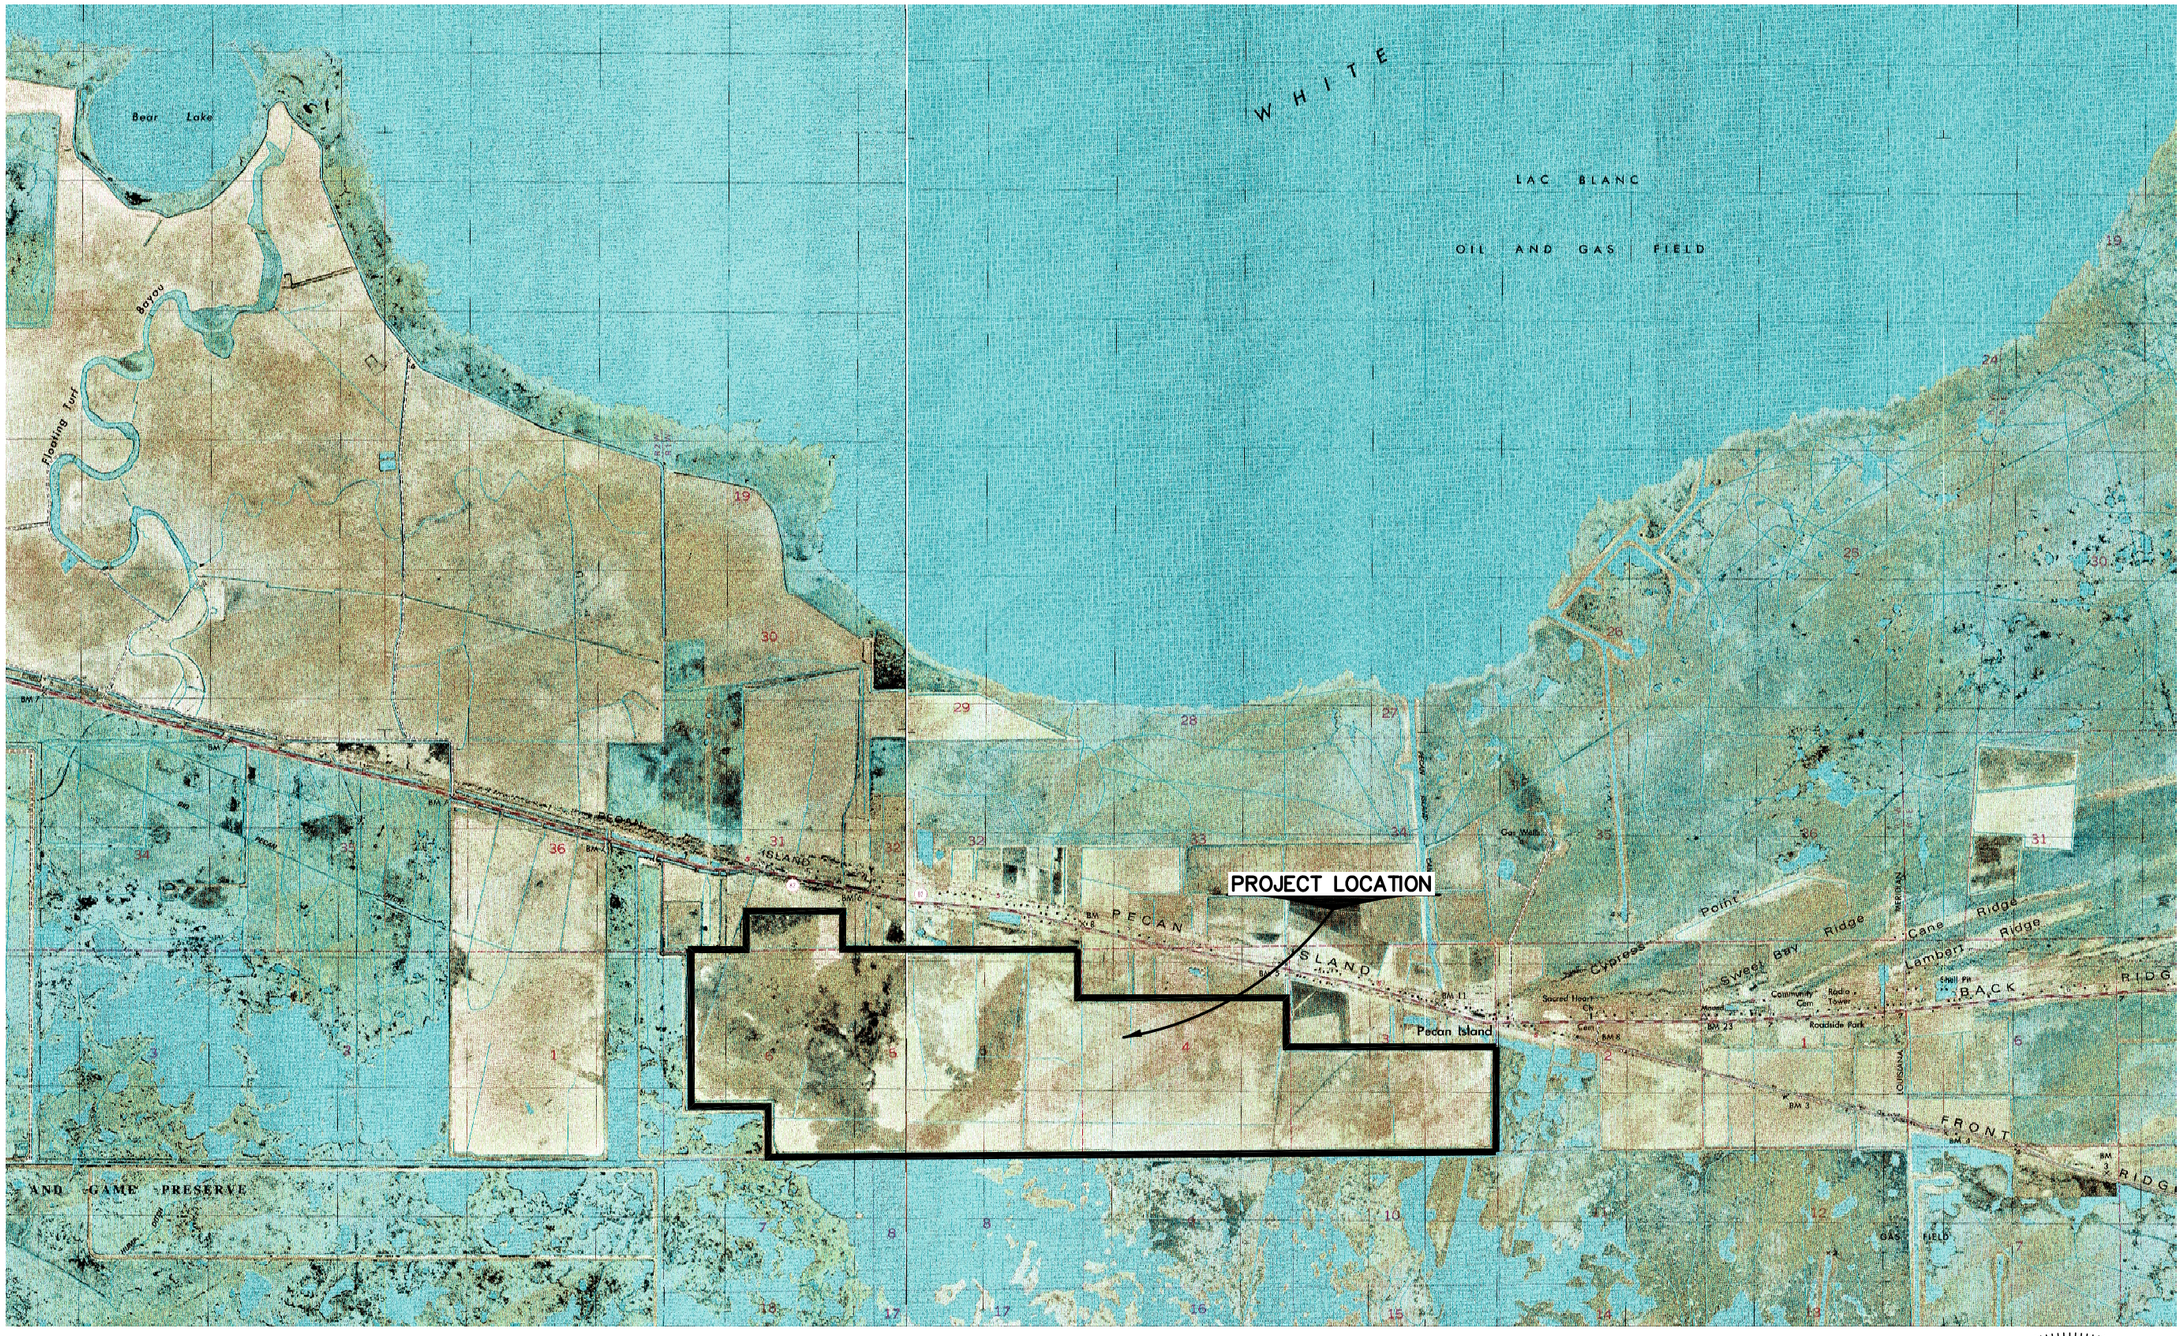

NORTH

2000 0 2000 4000 6000

Scale: 1" = 2000'

STATE OF LOUISIANA
DAVID P. HIDALGO
REG. No. 27074
REGISTERED
PROFESSIONAL ENGINEER
IN
CIVIL ENGINEERING

H:\CONST\99-33\As-Builts\VICINITY.DWG

SHEET NUMBER 2

AUCOIN & ASSOCIATES, INC.
CONSULTING ENGINEERS
AND LAND SURVEYORS
EUNICE, LOUISIANA

PROJECT BOOK	99-33
DETAILED	A.P.M.
CHECKED	D.P.H.
DATE	SEPTEMBER 2003
SHEET	2


NO.	DATE	REVISION DESCRIPTION	BY

LOUISIANA DEPARTMENT OF NATURAL RESOURCES

VICINITY MAP

PECAN ISLAND TERRACE CREATION PROJECT
(ME-14/XME-22)

AS-BUILT DRAWINGS

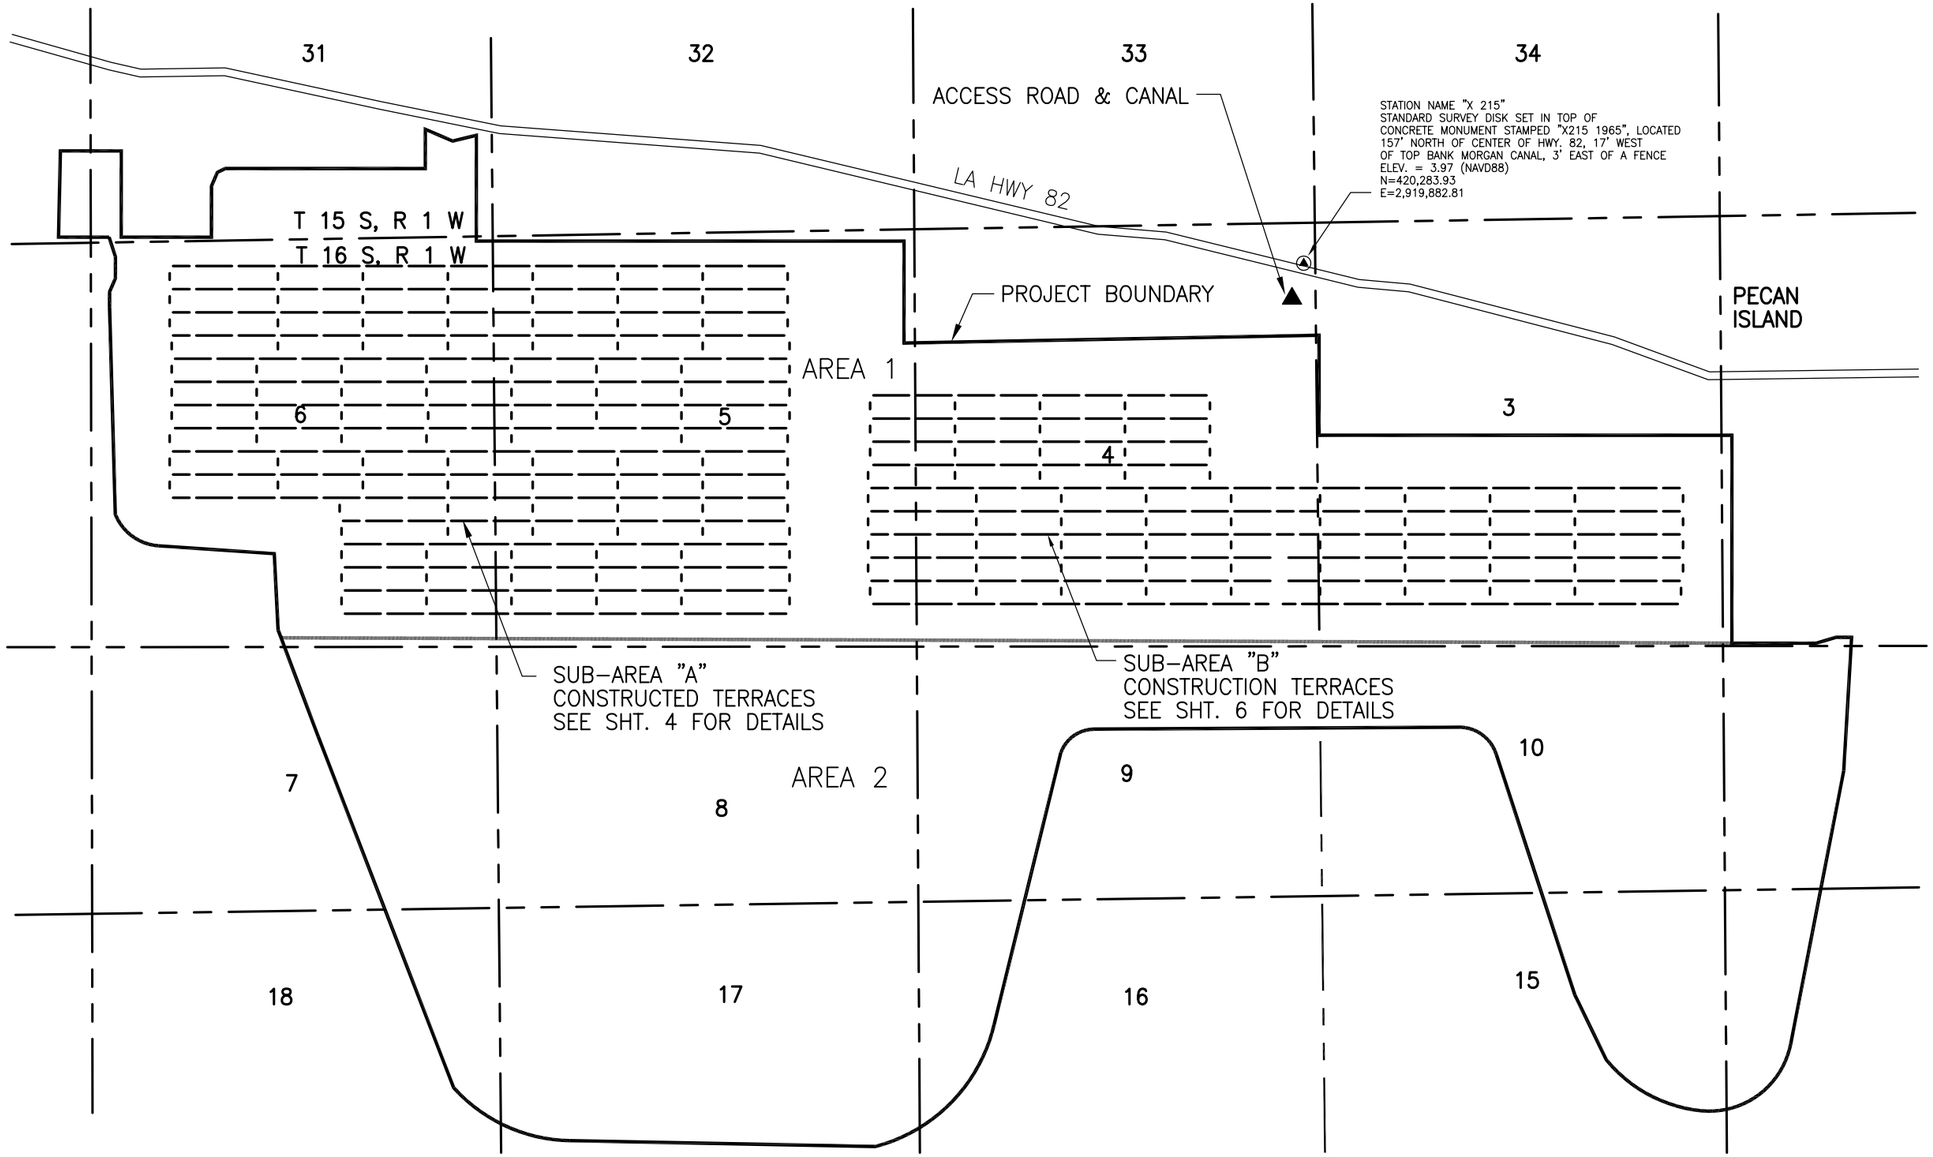

NORTH

1000 0 1000 2000 3000

Scale: 1" = 1000'

STATE OF LOUISIANA
DAVID P. HIDALGO
REG. No. 27074
REGISTERED
PROFESSIONAL ENGINEER
IN
CIVIL ENGINEERING

H: \Const\99-33\As Builts\layout.dwg

SHEET NUMBER 3

AUCOIN & ASSOCIATES, INC.
CONSULTING ENGINEERS
AND LAND SURVEYORS
EUNICE, LOUISIANA

PROJECT BOOK 99-33
DETAILED A.P.M.
CHECKED D.P.H.
DATE SEPTEMBER 2003
SHEET 3


NO.	DATE	REVISION DESCRIPTION	BY

LOUISIANA DEPARTMENT OF NATURAL RESOURCES

GENERAL LAYOUT

PECAN ISLAND TERRACE CREATION PROJECT
(ME-14/XME-22)

AS-BUILT DRAWINGS

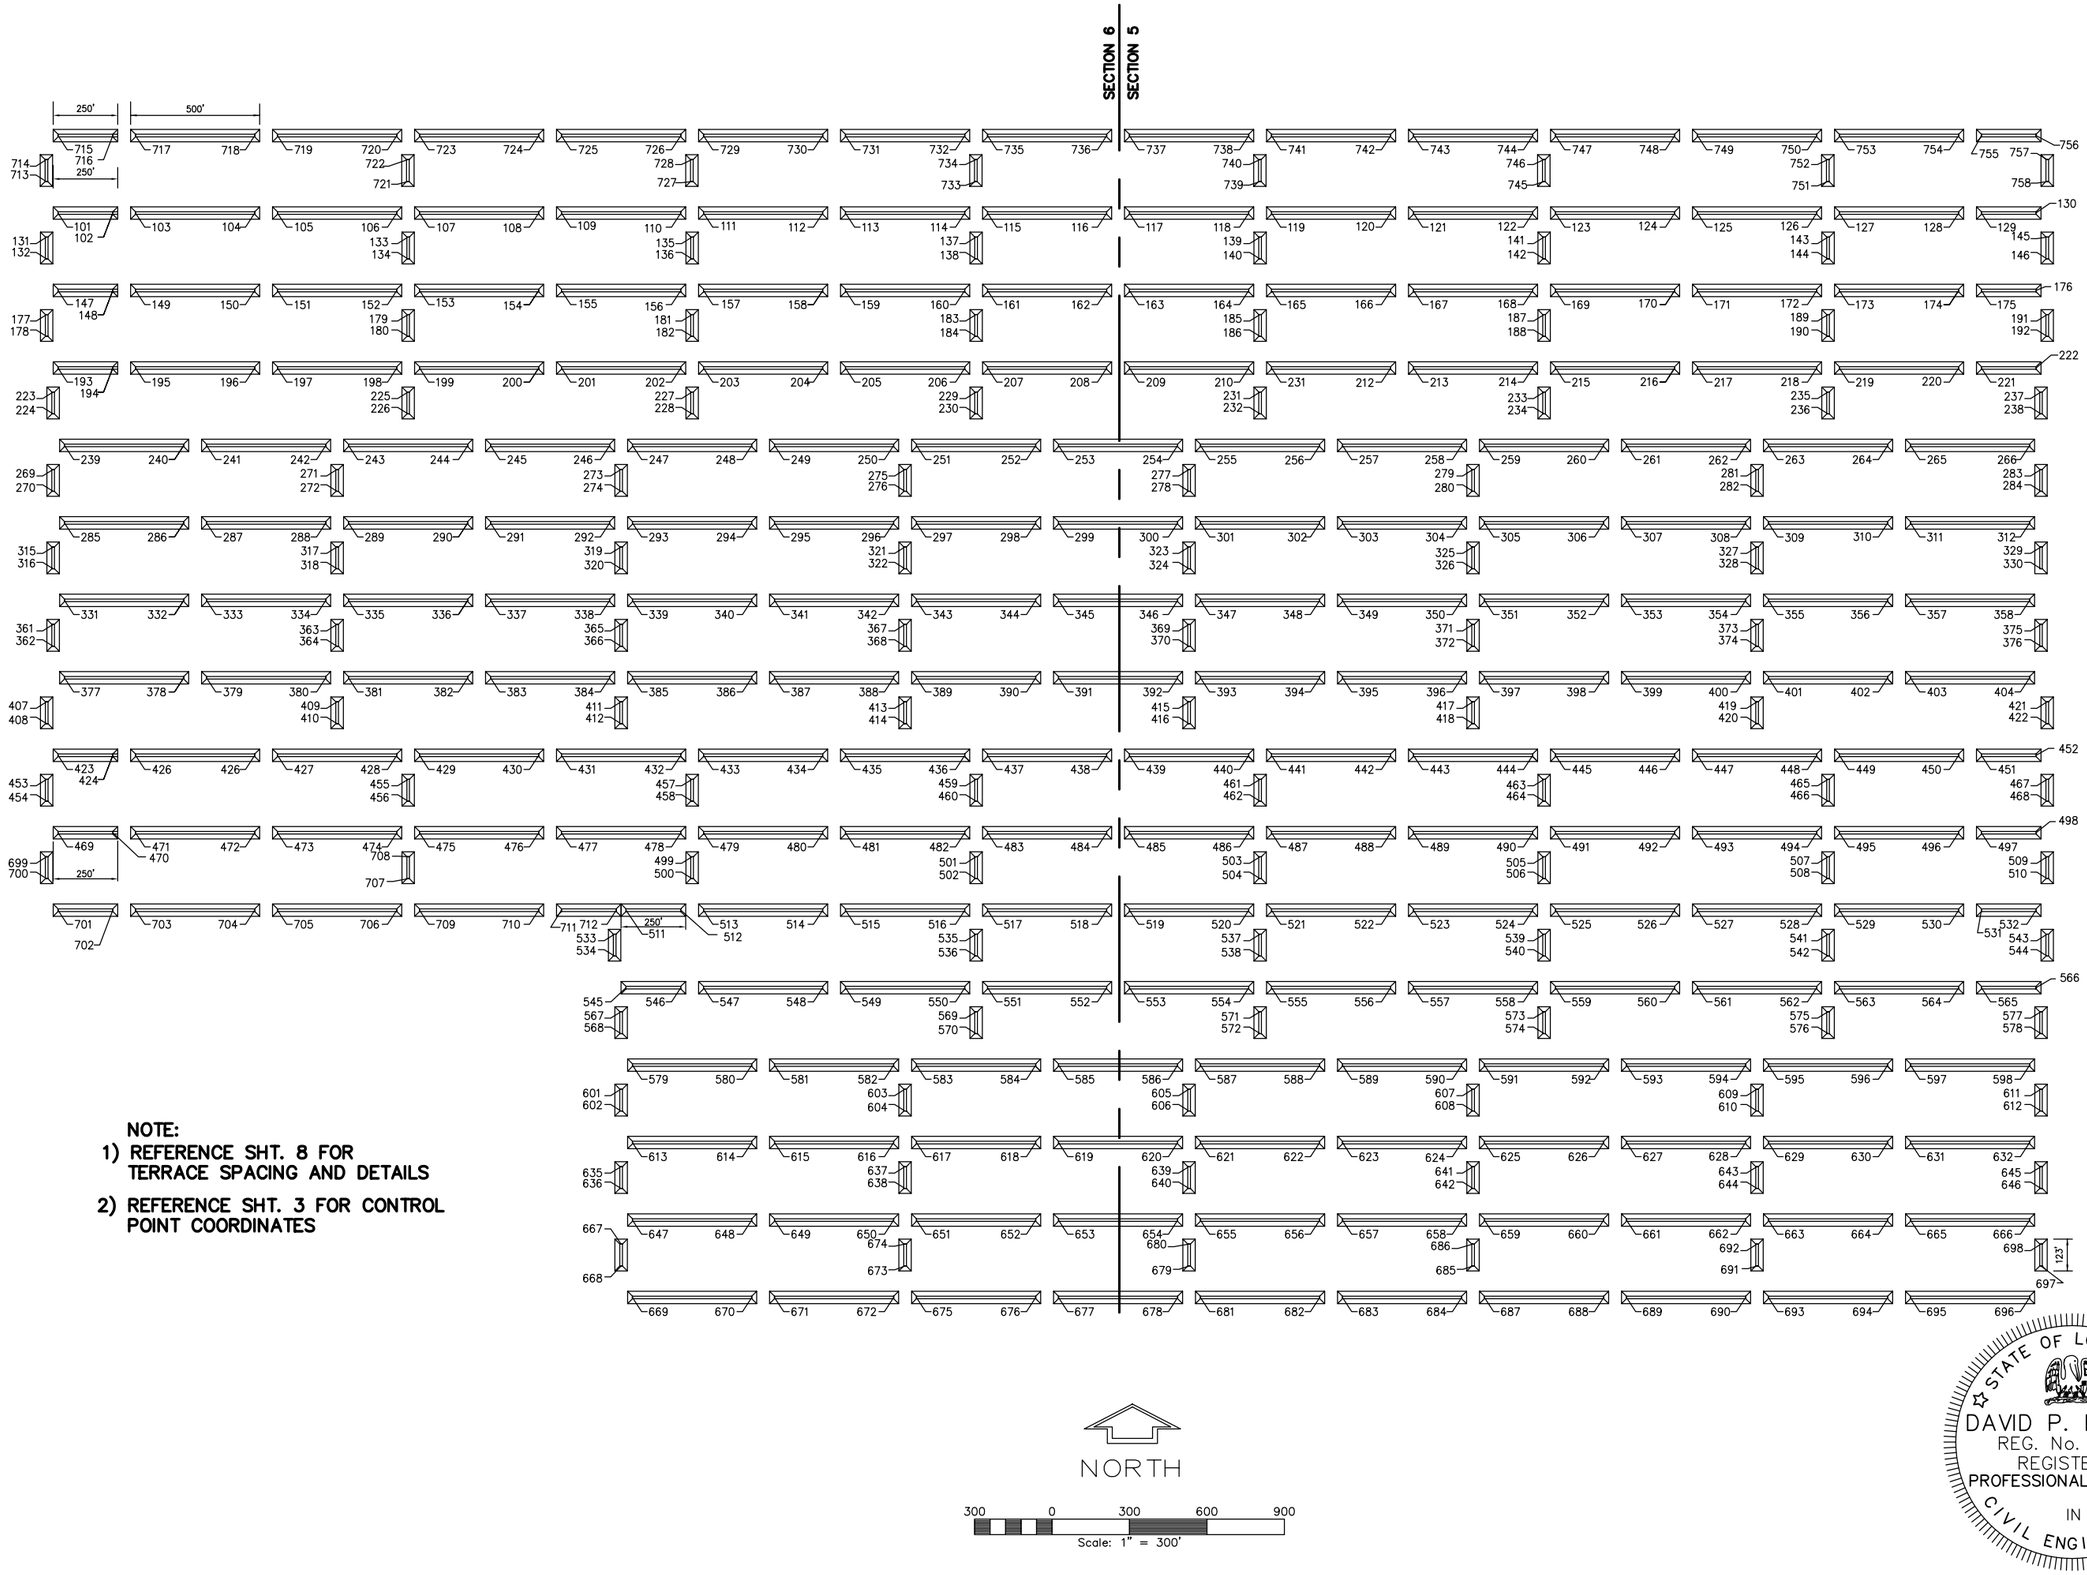

NOTE:
1) REFERENCE SHT. 8 FOR TERRACE SPACING AND DETAILS
2) REFERENCE SHT. 3 FOR CONTROL POINT COORDINATES

NORTH

300 0 300 600 900
Scale: 1" = 300'

H:\Const\99-33\As-Builts\layout-1.dwg

SHEET NUMBER 4

AUCOIN & ASSOCIATES, INC.
CONSULTING ENGINEERS
AND LAND SURVEYORS
EUNICE, LOUISIANA

PROJECT BOOK	99-33
DETAILED	A.P.M.
CHECKED	D.P.H.
DATE	SEPTEMBER 2003
SHEET	4

NO.	REVISION DESCRIPTION	BY	DATE

LOUISIANA DEPARTMENT OF NATURAL RESOURCES

SUBAREA "A" LAYOUT

PECAN ISLAND TERRACE CREATION PROJECT
(ME-14/XME-22)

STATE OF LOUISIANA
DAVID P. HIDALGO
REG. No. 27074
REGISTERED
PROFESSIONAL ENGINEER
IN
CIVIL ENGINEERING

AS-BUILT DRAWINGS

NO.	NORTHING	EASTING
669	415747.1187	2907471.1098
670	415747.1187	2907933.1098
671	415747.1187	2908021.1098
672	415747.1187	2908483.1098
673	415869.1187	2908527.1098
674	415954.1187	2908527.1098
675	415747.1187	2908571.1098
676	415747.1187	2909033.1098
677	415747.1187	2909121.1098
678	415747.1187	2909583.1098
679	415869.1187	2909627.1098
680	415954.1187	2909627.1098
681	415747.1187	2909671.1098
682	415747.1187	2910133.1098
683	415747.1187	2910221.1098
684	415747.1187	2910683.1098
685	415869.1187	2910727.1098
686	415954.1187	2910727.1098
687	415747.1187	2910771.1098
688	415747.1187	2911233.1098
689	415747.1187	2911321.1098
690	415747.1187	2911783.1098
691	415869.1187	2911827.1098
692	415954.1187	2911827.1098
693	415747.1187	2911871.1098
694	415747.1187	2912333.1098
695	415747.1187	2912421.1098
696	415747.1187	2912883.1098
697	415869.1187	2912927.1098
698	415954.1187	2912927.1098
699	417454.1187	2905202.1098
700	417369.1187	2905202.1098
701	417247.1187	2905246.1098
702	417247.1187	2905458.1098
703	417247.1187	2905546.1098
704	417247.1187	2906008.1098
705	417247.1187	2906096.1098
706	417247.1187	2906558.1098
707	417369.1187	2906602.1098
708	417454.1187	2906602.1098
709	417247.1187	2906646.1098
710	417247.1187	2907108.1098
711	417247.1187	2907196.1098
712	417247.1187	2907408.1098
713	420069.1187	2905201.1098
714	420154.1187	2905201.1098

NO.	NORTHING	EASTING
714	420154.1187	2905201.1098
715	420247.1187	2905246.1098
716	420247.1187	2905458.1098
717	420247.1187	2905546.1098
718	420247.1187	2906008.1098
719	420247.1187	2906096.1098
720	420247.1187	2906558.1098
721	420069.1187	2906601.1098
722	420154.1187	2906601.1098
723	420247.1187	2906646.1098
724	420247.1187	2907108.1098
725	420247.1187	2907196.1098
726	420247.1187	2907658.1098
727	420069.1187	2907701.1098
728	420154.1187	2907701.1098
729	420247.1187	2907746.1098
730	420247.1187	2908208.1098
731	420247.1187	2908296.1098
732	420247.1187	2908758.1098
733	420069.1187	2908801.1098
734	420154.1187	2908801.1098
735	420247.1187	2908846.1098
736	420247.1187	2909308.1098
737	420247.1187	2909396.1098
738	420247.1187	2909858.1098
739	420069.1187	2909901.1098
740	420154.1187	2909901.1098
741	420247.1187	2909946.1098
742	420247.1187	2910408.1098
743	420247.1187	2910496.1098
744	420247.1187	2910958.1098
745	420069.1187	2911001.1098
746	420154.1187	2911001.1098
747	420247.1187	2911046.1098
748	420247.1187	2911508.1098
749	420247.1187	2911596.1098
750	420247.1187	2912058.1098
751	420069.1187	2912101.1098
752	420154.1187	2912101.1098
753	420247.1187	2912146.1098
754	420247.1187	2912608.1098
755	420247.1187	2912696.1098
756	420247.1187	2912908.1098
757	420154.1187	2912951.1098
758	420069.1187	2912951.1098

STATE OF LOUISIANA
DAVID P. HIDALGO
REG. No. 27074
REGISTERED
PROFESSIONAL ENGINEER
IN
CIVIL ENGINEERING

SHEET NUMBER 5A

AUCOIN & ASSOCIATES, INC.
CONSULTING ENGINEERS
AND LAND SURVEYORS
EUNICE, LOUISIANA

PROJECT BOOK 99-33
DETAILED A.P.M.
CHECKED D.P.H.
DATE SEPTEMBER 2003
SHEET 5A

NO.	REVISION DESCRIPTION	DATE	BY

LOUISIANA DEPARTMENT OF NATURAL RESOURCES

SUBAREA "A" COORDINATES
PECAN ISLAND TERRACE CREATION PROJECT
(ME-14/XME-22)

AS-BUILT DRAWINGS

H: \Const\99-33\As-Builts\layout-1A.dwg

NO.	NORTHING	EASTING
101	419947.1187	2905246.1098
102	419947.1187	2905458.1098
103	419947.1187	2905546.1098
104	419947.1187	2906008.1098
105	419947.1187	2906096.1098
106	419947.1187	2906558.1098
107	419947.1187	2906646.1098
108	419947.1187	2907108.1098
109	419947.1187	2907196.1098
110	419947.1187	2907658.1098
111	419947.1187	2907746.1098
112	419947.1187	2908208.1098
113	419947.1187	2908296.1098
114	419947.1187	2908758.1098
115	419947.1187	2908846.1098
116	419947.1187	2909308.1098
117	419947.1187	2909396.1098
118	419947.1187	2909858.1098
119	419947.1187	2909946.1098
120	419947.1187	2910408.1098
121	419947.1187	2910496.1098
122	419947.1187	2910958.1098
123	419947.1187	2911046.1098
124	419947.1187	2911508.1098
125	419947.1187	2911596.1098
126	419947.1187	2912058.1098
127	419947.1187	2912146.1098
128	419947.1187	2912608.1098
129	419947.1187	2912696.1098
130	419947.1187	2912907.1098
131	419854.1187	2905202.1098
132	419769.1187	2905202.1098
133	419854.1187	2906602.1098
134	419769.1187	2906602.1098
135	419854.1187	2907702.1098
136	419769.1187	2907702.1098
137	419854.1187	2908802.1098
138	419769.1187	2908802.1098
139	419854.1187	2909902.1098
140	419769.1187	2909902.1098
141	419854.1187	2911002.1098
142	419769.1187	2911002.1098
143	419854.1187	2912102.1098
144	419769.1187	2912102.1098
145	419854.1187	2912951.1098
146	419769.1187	2912951.1098
147	419647.1187	2905246.1098
148	419647.1187	2905458.1098
149	419647.1187	2905546.1098
150	419647.1187	2906008.1098
151	419647.1187	2906096.1098
152	419647.1187	2906558.1098
153	419647.1187	2906646.1098
154	419647.1187	2907108.1098
155	419647.1187	2907196.1098
156	419647.1187	2907658.1098
157	419647.1187	2907746.1098
158	419647.1187	2908208.1098
159	419647.1187	2908296.1098
160	419647.1187	2908758.1098
161	419647.1187	2908846.1098
162	419647.1187	2909308.1098
163	419647.1187	2909396.1098
164	419647.1187	2909858.1098
165	419647.1187	2909946.1098

NO.	NORTHING	EASTING
166	419647.1187	2910408.1098
167	419647.1187	2910496.1098
168	419647.1187	2910958.1098
169	419647.1187	2911046.1098
170	419647.1187	2911508.1098
171	419647.1187	2911596.1098
172	419647.1187	2912058.1098
173	419647.1187	2912146.1098
174	419647.1187	2912608.1098
175	419647.1187	2912696.1098
176	419647.1187	2912908.1098
177	419554.1187	2905202.1098
178	419469.1187	2905202.1098
179	419554.1187	2906602.1098
180	419469.1187	2906602.1098
181	419554.1187	2907702.1098
182	419469.1187	2907702.1098
183	419554.1187	2908802.1098
184	419469.1187	2908802.1098
185	419554.1187	2909902.1098
186	419469.1187	2909902.1098
187	419554.1187	2911002.1098
188	419469.1187	2911002.1098
189	419554.1187	2912102.1098
190	419469.1187	2912102.1098
191	419554.1187	2912952.1098
192	419469.1187	2912952.1098
193	419347.1187	2905246.1098
194	419347.1187	2905458.1098
195	419347.1187	2905546.1098
196	419347.1187	2906008.1098
197	419347.1187	2906096.1098
198	419347.1187	2906558.1098
199	419347.1187	2906646.1098
200	419347.1187	2907108.1098
201	419347.1187	2907196.1098
202	419347.1187	2907658.1098
203	419347.1187	2907746.1098
204	419347.1187	2908208.1098
205	419347.1187	2908296.1098
206	419347.1187	2908758.1098
207	419347.1187	2908846.1098
208	419347.1187	2909308.1098
209	419347.1187	2909396.1098
210	419347.1187	2909858.1098
211	419347.1187	2909946.1098
212	419347.1187	2910408.1098
213	419347.1187	2910496.1098
214	419347.1187	2910958.1098
215	419347.1187	2911046.1098
216	419347.1187	2911508.1098
217	419347.1187	2911596.1098
218	419347.1187	2912058.1098
219	419347.1187	2912146.1098
220	419347.1187	2912608.1098
221	419347.1187	2912696.1098
222	419347.1187	2912908.1098
223	419254.1187	2905227.1098
224	419169.1187	2905227.1098
225	419254.1187	2906602.1098
226	419169.1187	2906602.1098
227	419254.1187	2907702.1098
228	419169.1187	2907702.1098
229	419254.1187	2908802.1098
230	419169.1187	2908802.1098

NO.	NORTHING	EASTING
231	419254.1187	2909902.1098
232	419169.1187	2909902.1098
233	419254.1187	2911002.1098
234	419169.1187	2911002.1098
235	419254.1187	2912102.1098
236	419169.1187	2912102.1098
237	419254.1187	2912927.1098
238	419169.1187	2912927.1098
239	419047.1187	2905271.1098
240	419047.1187	2905733.1098
241	419047.1187	2905821.1098
242	419047.1187	2906283.1098
243	419047.1187	2906371.1098
244	419047.1187	2906833.1098
245	419047.1187	2906921.1098
246	419047.1187	2907383.1098
247	419047.1187	2907471.1098
248	419047.1187	2907933.1098
249	419047.1187	2908021.1098
250	419047.1187	2908483.1098
251	419047.1187	2908571.1098
252	419047.1187	2909033.1098
253	419047.1187	2909121.1098
254	419047.1187	2909583.1098
255	419047.1187	2909671.1098
256	419047.1187	2910133.1098
257	419047.1187	2910221.1098
258	419047.1187	2910683.1098
259	419047.1187	2910771.1098
260	419047.1187	2911233.1098
261	419047.1187	2911321.1098
262	419047.1187	2911783.1098
263	419047.1187	2911871.1098
264	419047.1187	2912333.1098
265	419047.1187	2912421.1098
266	419047.1187	2912883.1098
269	418954.1187	2905227.1098
270	418869.1187	2905227.1098
271	418954.1187	2906327.1098
272	418869.1187	2906327.1098
273	418954.1187	2907427.1098
274	418869.1187	2907427.1098
275	418954.1187	2908527.1098
276	418869.1187	2908527.1098
277	418954.1187	2909627.1098
278	418869.1187	2909627.1098
279	418954.1187	2910727.1098
280	418869.1187	2910727.1098
281	418954.1187	2911827.1098
282	418869.1187	2911827.1098
283	418954.1187	2912927.1098
284	418869.1187	2912927.1098
285	418747.1187	2905271.1098
286	418747.1187	2905733.1098
287	418747.1187	2905821.1098
288	418747.1187	2906283.1098
289	418747.1187	2906371.1098
290	418747.1187	2906833.1098
291	418747.1187	2906921.1098
292	418747.1187	2907383.1098
293	418747.1187	2907471.1098
294	418747.1187	2907933.1098
295	418747.1187	2908021.1098

NO.	NORTHING	EASTING
296	418747.1187	2908483.1098
297	418747.1187	2908571.1098
298	418747.1187	2909033.1098
299	418747.1187	2909121.1098
300	418747.1187	2909583.1098
301	418747.1187	2909671.1098
302	418747.1187	2910133.1098
303	418747.1187	2910221.1098
304	418747.1187	2910683.1098
305	418747.1187	2910771.1098
306	418747.1187	2911233.1098
307	418747.1187	2911321.1098
308	418747.1187	2911783.1098
309	418747.1187	2911871.1098
310	418747.1187	2912333.1098
311	418747.1187	2912421.1098
312	418747.1187	2912883.1098
315	418654.1187	2905227.1098
316	418569.1187	2905227.1098
317	418654.1187	2906327.1098
318	418569.1187	2906327.1098
319	418654.1187	2907427.1098
320	418569.1187	2907427.1098
321	418654.1187	2908527.1098
322	418569.1187	2908527.1098
323	418654.1187	2909627.1098
324	418569.1187	2909627.1098
325	418654.1187	2910727.1098
326	418569.1187	2910727.1098
327	418654.1187	2911827.1098
328	418569.1187	2911827.1098
329	418654.1187	2912927.1098
330	418569.1187	2912927.1098
331	418447.1187	2905271.1098
332	418447.1187	2905733.1098
333	418447.1187	2905821.1098
334	418447.1187	2906283.1098
335	418447.1187	2906371.1098
336	418447.1187	2906833.1098
337	418447.1187	2906921.1098
338	418447.1187	2907383.1098
339	418447.1187	2907471.1098
340	418447.1187	2907933.1098
341	418447.1187	2908021.1098
342	418447.1187	2908483.1098
343	418447.1187	2908571.1098
344	418447.1187	2909033.1098
345	418447.1187	2909121.1098
346	418447.1187	2909583.1098
347	418447.1187	2909671.1098
348	418447.1187	2910133.1098
349	418447.1187	2910221.1098
350	418447.1187	2910683.1098
351	418447.1187	2910771.1098
352	418447.1187	2911233.1098
353	418447.1187	2911321.1098
354	418447.1187	2911783.1098
355	418447.1187	2911871.1098
356	418447.1187	2912333.1098
357	418447.1187	2912421.1098
358	418447.1187	2912883.1098

NO.	NORTHING	EASTING
361	418354.1187	2905227.1098
362	418269.1187	2905227.1098
363	418354.1187	2906327.1098
364	418269.1187	2906327.1098
365	418354.1187	2907427.1098
366	418269.1187	2907427.1098
367	418354.1187	2908547.1098
368	418269.1187	2908547.1098
369	418354.1187	2909627.1098
370	418269.1187	2909627.1098
371	418354.1187	2910727.1098
372	418269.1187	2910727.1098
373	418354.1187	2911827.1098
374	418269.1187	2911827.1098
375	418354.1187	2912927.1098
376	418269.1187	2912927.1098
377	418147.1187	2905271.1098
378	418147.1187	2905733.1098
379	418147.1187	2905821.1098
380	418147.1187	2906283.1098
381	418147.1187	2906371.1098
382	418147.1187	2906833.1098
383	418147.1187	2906921.1098
384	418147.1187	2907383.1098
385	418147.1187	2907471.1098
386	418147.1187	2907933.1098
387	418147.1187	2908021.1098
388	418147.1187	2908483.1098
389	418147.1187	2908571.1098
390	418147.1187	2909033.1098
391	418147.1187	2909121.1098
392	418147.1187	2909583.1098
393	418147.1187	2909671.1098
394	418147.1187	2910133.1098
395	418147.1187	2910221.1098
396	418147.1187	2910683.1098
397	418147.1187	2910771.1098
398	418147.1187	2911233.1098
399	418147.1187	2911321.1098
400	418147.1187	2911783.1098
401	418147.1187	2911871.1098
402	418147.1187	2912333.1098
403	418147.1187	2912421.1098
404	418147.1187	2912883.1098
407	418054.1187	2905202.1098
408	417969.1187	2905202.1098
409	418054.1187	2906327.1098
410	417969.1187	2906327.1098
411	418054.1187	2907427.1098
412	417969.1187	2907427.1098
413	418054.1187	2908527.1098
414	417969.1187	2908527.1098
415	418054.1187	2909627.1098
416	417969.1187	2909627.1098
417	418054.1187	2910727.1098
418	417969.1187	2910727.1098
419	418054.1187	2911827.1098
420	417969.1187	2911827.1098
421	418054.1187	2912951.1098
422	417969.1187	2912951.1098
423	417847.1187	2905246.1098
424	417847.1187	2905458.1098
425	417847.1187	2905546.1098

NO.	NORTHING	EASTING
426	417847.1187	2906008.1098
427	417847.1187	2906096.1098
428	417847.1187	2906558.1098
429	417847.1187	2906646.1098
430	417847.1187	2907108.1098
431	417847.1187	2907196.1098
432	417847.1187	2907658.1098
433	417847.1187	2907746.1098
434	417847.1187	2908208.1098
435	417847.1187	2908296.1098
436	417847.1187	2908758.1098
437	417847.1187	2908846.1098
438	417847.1187	2909308.1098
439	417847.1187	2909396.1098
440	417847.1187	2909858.1098
441	417847.1187	2909946.1098
442	417847.1187	2910408.1098
443	417847.1187	2910496.1098
444	417847.1187	2910958.1098
445	417847.1187	2911046.1098
446	417847.1187	2911508.1098
447	417847.1187	2911596.1098
448	417847.1187	2912058.1098
449	417847.1187	2912146.1098
450	417847.1187	2912608.1098
451	417847.1187	2912696.1098
452	417847.1187	2912908.1098
453	417754.1187	2905202.1098
454	417669.1187	2905202.1098
455	417754.1187	2906602.1098
456	417669.1187	2906602.1098
457	417754.1187	2907702.1098
458	417669.1187	2907702.1098
459	417754.1187	2908802.1098
460	417669.1187	2908802.1098
461	417754.1187	2909902.1098
462	417669.1187	2909902.1098
463	417754.1187	2911002.1098
464	417669.1187	2911002.1098
465	417754.1187	2912102.1098
466	417669.1187	2912102.1098
467	417754.1187	2912951.1098
468	417669.1187	2912951.1098
469	417547.1187	2905246.1098
470	417547.1187	2905458.1098
471	417547.1187	2905546.1098
472	417547.1187	2906008.1098
473	417547.1187	2906096.1098
474	417547.1187	2906558.1098
475	417547.1187	2906646.1098
476	417547.1187	2907108.1098
477	417547.1187	2907196.1098
478	417547.1187	2907658.1098
479	417547.1187	2907746.1098
480	417547.1187	2908208.1098
481	417547.1187	2908296.1098
482	417547.1187	2908758.1098
483	417547.1187	2908846.1098
484	417547.1187	2909308.1098
485	417547.1187	2909396.1098
486	417547.1187	2909858.1098
487	417547.1187	2909946.1098
488	417547.1187	2910408.1098
489	417547.1187	2910496.1098
490	417547.1187	2910958.1098

NO.	NORTHING	EASTING
491	417547.1187	2911046.1098
492	417547.1187	2911508.1098
493	417547.1187	2911596.1098
494	417547.1187	2912058.1098
495	417547.1187	2912146.1098
496	417547.1187	2912608.1098
497	417547.1187	2912696.1098
498	417547.1187	2912908.1098
499	417454.1187	2907702.1098
500	417369.1187	2907702.1098
501	417454.1187	2908802.1098
502	417369.1187	2908802.1098
503	417454.1187	2909902.1098
504	417369.1187	2909902.1098
505	417454.1187	2911002.1098
506	417369.1187	2911002.1098
507	417454.1187	2912102.1098
508	417369.1187	2912102.1098
509	417454.1187	2912951.1098
510	417369.1187	2912951.1098
511	417247.1187	2907446.1098
512	417247.1187	2907658.1098
513	417247.1187	2907746.1098
514	417247.1187	2908208.1098
515	417247.1187	2908296.1098
516	417247.1187	2908758.1098
517	417247.1187	2908846.1098
518	417247.1187	2909308.1098
519	417247.1187	2909396.1098
520	417247.1187	2909858.1098
521	417247.1187	2909946.1098
522	417247.1187	2910408.1098
523	417247.1187	2910496.1098
524	417247.1187	2910958.1098
525	417247.1187	2911046.1098
526	417247.1187	2911508.1098
527	417247.1187	2911596.1098
528	417247.1187	2912058.1098
529	417247.1187	2912146.1098
530	417247.1187	2912608.1098
531	417247.1187	2912696.1098
532	417247.1187	2912908.1098
533	417154.1187	2907402.1098
534	417069.1187	2907402.1098
535	417154.1187	2908802.1098
536	417069.1187	2908802.1098
537	417154.1187	2909902.1098
538	417069.1187	2909902.1098
539	417154.1187	2911002.1098
540	417069.1187	2911002.1098
541	417154.1187	2912102.1098
542	417069.1187	2912102.1098
543	417154.1187	2912951.1098
544	417069.1187	2912951.1098
545	416947.1187	2907446.1098
546	416947.1187	2907658.1098
547	416947.1187	2907746.1098
548	416947.1187	2908208.1098
549	416947.1187	2908296.1098
550	416947.1187	2908758.1098
551	416947.1187	2908846.1098
552	416947.1187	2909308.1098
553	416947.1187	2909396.1098
554	416947.1187	2909858.1098
555	416947.1187	2909946.1098

NO.	NORTHING	EASTING
556	416947.1187	2910408.1098
557	416947.1187	2910496.1098
558	416947.1187	2910958.1098
559	416947.1187	2911046.1098
560	416947.1187	2911508.1098
561	416947.1187	2911596.1098
562	416947.1187	2912058.1098
563	416947.1187	2912146.1098
564	416947.1187	2912608.1098
565	416947.1187	2912696.1098
566	416947.1187	2912908.1098
567	416854.1187	2907427.1098
568	416769.1187	2907427.1098
569	416854.1187	2908802.1098
570	416769.1187	2908802.1098
571	416854.1187	2909902.1098
572	416769.1187	2909902.1098
573	416854.1187	2911002.1098
574	416769.1187	2911002.1098
575	416854.1187	2912102.1098
576	416769.1187	2912102.1098
577	416854.1187	2912927.1098
578	416769.1187	2912927.1098
579	416647.1187	2907471.1098
580	416647.1187	2907933.1098
581	416647.1187	2908021.1098
582	416647.1187	2908483.1098
583	416647.1187	2908571.1098
584	416647.1187	2909033.1098
585	416647.1187	2909121.1098
586	416647.1187	2909583.1098
587	416647.1187	2909671.1098
588	416647.1187	2910133.1098
589	416647.1187	2910221.1098
590	416647.1187	2910683.1098
591	416647.1187	2910771.1098
592	416647.1187	2911233.1098
593	416647.1187	2911321.1098
594	416647.1187	2911783.1098
595	416647.1187	2911871.1098
596	416647.1187	2912333.1098
597	416647.1187	2912421.1098
598	416647.1187	2912883.1098
601	416554.1187	2907427.1098
602	416469.1187	2907427.1098
603	416554.1187	2908527.1098
604	416469.1187	2908527.1098
605	416554.1187	2909627.1098
606	416469.1187	2909627.1098
607	416554.1187	2910727.1098
608	416469.1187	2910727.1098
609	416554.1187	2911827.1098
610	416469.1187	2911827.1098
611	416554.1187	2912927.1098
612	416469.1187	2912927.1098
613	416347.1187	2907471.1098
614	416347.1187	2907933.1098
615	416347.1187	2908021.1098
616	416347.1187	2908483.1098
617	416347.1187	2908571.1098
618	416347.1187	2909033.1098
619	416347.1187	2909121.1098
620	416347.1187	2909583.1098

NO.	NORTHING	EASTING
621	416347.1187	2909671.1098
622	416347.1187	2910133.1098
623	416347.1187	2910221.1098
624	416347.1187	2910683.1098
625	416347.1187	2910771.1098
626	416347.1187	2911233.1098
627	416347.1187	2911321.1098
628	416347.1187	2911783.1098
629	416347.1187	2911871.1098
630	416347.1187	2912333.1098
631	416347.1187	2912421.1098
632	416347.1187	2912883.1098
635	416254.1187	2907427.1098
636	416169.1187	2907427.1098
637	416254.1187	2908527.1098
638	416169.1187	2908527.1098
639	416254.1187	2909627.1098
640	416169.1187	2909627.1098
641	416254.1187	2910727.1098
642	416169.1187	2910727.1098
643	416254.1187	2911827.1098
644	416169.1187	2911827.1098
645	416254.1187	2912927.1098
646	416169.1187	2912927.1098
647	416047.1187	2907471.1098
648	416047.1187	2907933.1098
649	416047.1187	2908021.1098
650	416047.1187	2908483.1098
651	416047.1187	2908571.1098
652	416047.1187	2909033.1098
653	416047.1187	2909121.1098
654	416047.1187	2909583.1098
655	416047.1187	2909671.1098
656	416047.1187	2910133.1098
657	416047.1187	2910221.1098
658	416047.1187	2910683.1098
659	416047.1187	2910771.1098
660	416047.1187	2911233.1098
661	416047.1187	2911321.1098
662	416047.1187	2911783.1098
663	416047.1187	2911871.1098
664	416047.1187	2912333.1098
665	416047.1187	2912421.1098
666	416047.1187	2912883.1098
667	415954.1187	2907427.1098
668	415869.1187	2907427.1098

H:\Const\99-33\As-Built\layout-1A.dwg

SHEET NUMBER 5

AUCOIN & ASSOCIATES, INC.
CONSULTING ENGINEERS
AND LAND SURVEYORS
EUNICE, LOUISIANA

PROJECT 99-33
BOOK
DETAILED A.P.M.
CHECKED D.P.H.
DATE SEPTEMBER 2003
SHEET 5

NO. DATE BY REVISION DESCRIPTION


LOUISIANA DEPARTMENT OF NATURAL RESOURCES

SUBAREA "A" COORDINATES
PECAN ISLAND TERRACE CREATION PROJECT
(ME-14/XME-22)

STATE OF LOUISIANA
DAVID P. HIDALGO
REG. No. 27074
REGISTERED
PROFESSIONAL ENGINEER
IN
CIVIL ENGINEERING

AS-BUILT DRAWINGS



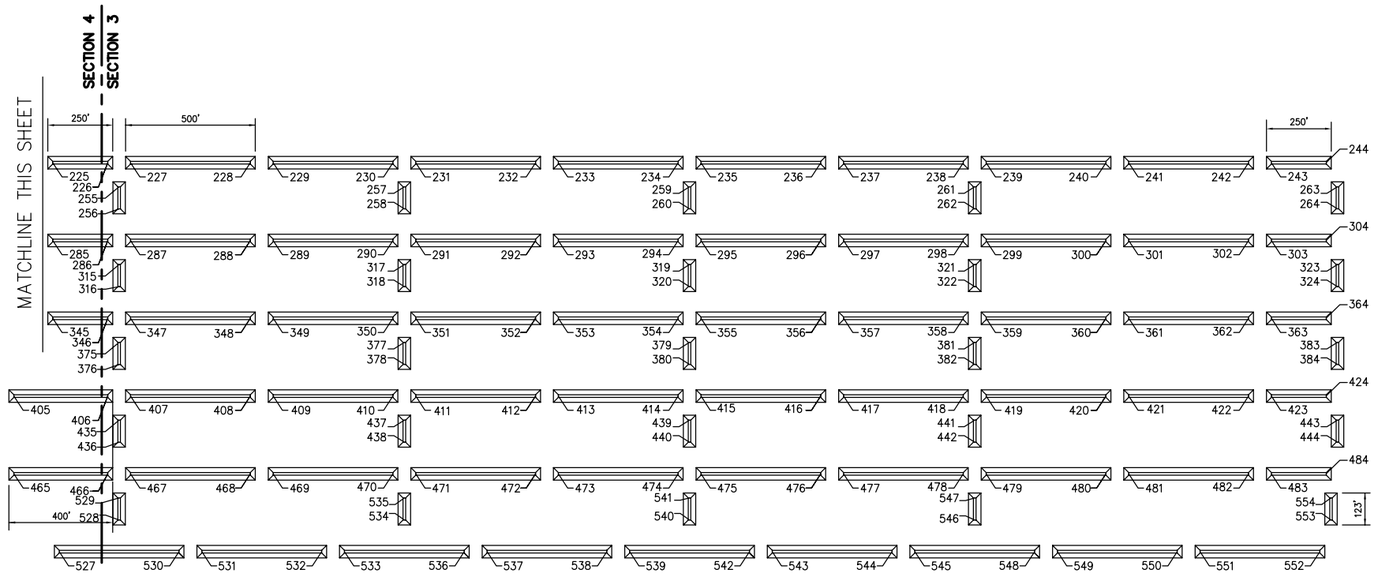

NOTE:
1) REFERENCE SHT. 8 FOR TERRACE SPACING AND DETAILS
2) REFERENCE SHT. 3 FOR CONTROL POINT COORDINATES

STATE OF LOUISIANA
DAVID P. HIDALGO
REG. No. 27074
REGISTERED
PROFESSIONAL ENGINEER
IN
CIVIL ENGINEERING

SHEET NUMBER 6

AUCOIN & ASSOCIATES, INC.
CONSULTING ENGINEERS
AND LAND SURVEYORS
EUNICE, LOUISIANA

PROJECT BOOK	99-33	DRAWN	A.P.M.	DATE	SEPTEMBER 2003
		DETAILED	D.P.H.	SHEET	6
		CHECKED			

NO.	DATE	REVISION DESCRIPTION	BY

LOUISIANA DEPARTMENT OF NATURAL RESOURCES

SUBAREA "B" LAYOUT
PECAN ISLAND TERRACE CREATION PROJECT
(ME-14/XME-22)

AS-BUILT DRAWINGS

H:\Const\99-33\As-Builts\layout-2.dwg

NO.	NORTHING	EASTING
485	417372.1864	2914362.6525
486	417372.1864	2914574.6525
487	417072.1864	2914362.6525
488	417072.1864	2914574.6525
489	416772.1864	2914362.6525
490	416772.1864	2914574.6525
491	416472.1864	2914362.6525
492	416472.1864	2914574.6525
493	416172.1864	2914362.6525
494	416172.1864	2914574.6525
495	416079.1864	2914343.6525
496	415994.1864	2914343.6525
497	415872.1864	2914387.6525
498	415872.1864	2914849.6525
499	415872.1864	2914937.6525
500	415872.1864	2915399.6525
501	415872.1864	2915487.6525
502	415994.1864	2915718.6525
503	416079.1864	2915718.6525
504	415872.1864	2915949.6525
505	415872.1864	2916037.6525
506	415872.1864	2916499.6525
507	415872.1864	2916587.6525
508	415994.1864	2916818.6525
509	416079.1864	2916818.6525
510	415872.1864	2917049.6525
511	415872.1864	2917137.6525
512	415872.1864	2917599.6525
513	415872.1864	2917687.6525
514	415994.1864	2917918.6525
515	416079.1864	2917918.6525
516	415872.1864	2918149.6525
517	415872.1864	2918237.6525
518	415872.1864	2918699.6525
519	415872.1864	2918787.6525

NO.	NORTHING	EASTING
520	415994.1864	2919018.6525
521	416079.1864	2919018.6525
522	415872.1864	2919249.6525
523	415872.1864	2919337.6525
524	415872.1864	2919499.6525
525	415872.1864	2919687.6525
526	415872.1864	2919849.6525
527	415872.1864	2919937.6525
528	415994.1864	2920168.6525
529	416079.1864	2920168.6525
530	415872.1864	2920399.6525
531	415872.1864	2920487.6525
532	415872.1864	2920949.6525
533	415872.1864	2921037.6525
534	415994.1864	2921268.6525
535	416079.1864	2921268.6525
536	415872.1864	2921499.6525
537	415872.1864	2921587.6525
538	415872.1864	2922049.6525
539	415872.1864	2922137.6525
540	415994.1864	2922368.6525
541	416079.1864	2922368.6525
542	415872.1864	2922599.6525
543	415872.1864	2922687.6525
544	415872.1864	2923149.6525
545	415872.1864	2923237.6525
546	415994.1864	2923468.6525
547	416079.1864	2923468.6525
548	415872.1864	2923699.6525
549	415872.1864	2923787.6525
550	415872.1864	2924249.6525
551	415872.1864	2924337.6525
552	415872.1864	2924799.6525
553	415994.1864	2924842.6525
554	416079.1864	2924842.6525

H:\Const\99-33\As-Builts\layout-2A.dwg

STATE OF LOUISIANA
DAVID P. HIDALGO
REG. No. 27074
REGISTERED
PROFESSIONAL ENGINEER
IN
CIVIL ENGINEERING

SHEET NUMBER 7A

AUCOIN & ASSOCIATES, INC.
CONSULTING ENGINEERS
AND LAND SURVEYORS
EUNICE, LOUISIANA

PROJECT 99-33
BOOK
DETAILED A.P.M.
CHECKED D.P.H.
DATE SEPTEMBER 2003
SHEET 7A

NO.	DATE	REVISION DESCRIPTION	BY

LOUISIANA DEPARTMENT OF NATURAL RESOURCES

SUBAREA "B" COORDINATES
PECAN ISLAND TERRACE CREATION PROJECT
(ME-14/XME-22)

AS-BUILT DRAWINGS

NO.	NORTHING	EASTING
101	418572.1864	2914387.6525
102	418572.1864	2914849.6525
103	418572.1864	2914937.6525
104	418572.1864	2915399.6525
105	418572.1864	2915487.6525
106	418572.1864	2915949.6525
107	418572.1864	2916037.6525
108	418572.1864	2916499.6525
109	418572.1864	2916587.6525
110	418572.1864	2917049.6525
111	418572.1864	2917137.6525
112	418572.1864	2917599.6525
113	418572.1864	2917687.6525
114	418572.1864	2918149.6525
115	418572.1864	2918237.6525
116	418572.1864	2918699.6525
117	418479.1864	2914343.6525
118	418394.1864	2914343.6525
119	418479.1864	2915443.6525
120	418394.1864	2915443.6525
121	418479.1864	2916543.6525
122	418394.1864	2916543.6525
123	418479.1864	2917643.6525
124	418394.1864	2917643.6525
125	418479.1864	2918743.6525
126	418394.1864	2918743.6525
127	418272.1864	2914387.6525
128	418272.1864	2914849.6525
129	418272.1864	2914937.6525
130	418272.1864	2915399.6525
131	418272.1864	2915487.6525
132	418272.1864	2915949.6525
133	418272.1864	2916037.6525
134	418272.1864	2916499.6525
135	418272.1864	2916587.6525
136	418272.1864	2917049.6525
137	418272.1864	2917137.6525
138	418272.1864	2917599.6525
139	418272.1864	2917687.6525
140	418272.1864	2918149.6525
141	418272.1864	2918237.6525
142	418272.1864	2918699.6525
143	418179.1864	2914343.6525
144	418094.1864	2914343.6525
145	418179.1864	2915443.6525
146	418094.1864	2915443.6525
147	418179.1864	2916543.6525
148	418094.1864	2916543.6525
149	418179.1864	2917643.6525
150	418094.1864	2917643.6525
151	418179.1864	2918743.6525
152	418094.1864	2918743.6525
153	417972.1864	2914387.6525
154	417972.1864	2914849.6525
155	417972.1864	2914937.6525
156	417972.1864	2915399.6525
157	417972.1864	2915487.6525
158	417972.1864	2915949.6525
159	417972.1864	2916037.6525
160	417972.1864	2916499.6525
161	417972.1864	2916587.6525
162	417972.1864	2917049.6525
163	417972.1864	2917137.6525
164	417972.1864	2917599.6525
165	417972.1864	2917687.6525
166	417972.1864	2918149.6525
167	417972.1864	2918237.6525
168	417972.1864	2918699.6525
169	417879.1864	2914343.6525
170	417794.1864	2914343.6525
171	417879.1864	2915443.6525
172	417794.1864	2915443.6525
173	417879.1864	2916543.6525
174	417794.1864	2916543.6525
175	417879.1864	2917643.6525
176	417794.1864	2917643.6525
177	417879.1864	2918743.6525
178	417794.1864	2918743.6525
179	417672.1864	2914387.6525
180	417672.1864	2914849.6525
181	417672.1864	2914937.6525
182	417672.1864	2915418.6525
183	417672.1864	2915468.6525
184	417672.1864	2915949.6525
185	417672.1864	2916037.6525
186	417672.1864	2916499.6525
187	417672.1864	2916587.6525
188	417672.1864	2917049.6525
189	417672.1864	2917137.6525
190	417672.1864	2917599.6525
191	417672.1864	2917687.6525
192	417672.1864	2918149.6525
193	417672.1864	2918237.6525
194	417672.1864	2918699.6525
195	417579.1864	2914318.6525
196	417494.1864	2914318.6525
197	417579.1864	2915443.6525
198	417494.1864	2915443.6525
199	417579.1864	2916543.6525
200	417494.1864	2916543.6525
201	417579.1864	2917643.6525
202	417494.1864	2917643.6525
203	417579.1864	2918743.6525
204	417494.1864	2918743.6525
205	417372.1864	2914662.6525
206	417372.1864	2915124.6525
207	417372.1864	2915212.6525
208	417372.1864	2915674.6525
209	417372.1864	2915762.6525
210	417372.1864	2916224.6525
211	417372.1864	2916312.6525
212	417372.1864	2916774.6525
213	417372.1864	2916862.6525
214	417372.1864	2917324.6525
215	417372.1864	2917412.6525
216	417372.1864	2917874.6525
217	417372.1864	2917962.6525
218	417372.1864	2918424.6525
219	417372.1864	2918512.6525
220	417372.1864	2918974.6525
221	417372.1864	2919062.6525
222	417372.1864	2919524.6525
223	417372.1864	2919612.6525
224	417372.1864	2919824.6525
225	417372.1864	2919912.6525
226	417372.1864	2920124.6525
227	417372.1864	2920212.6525
228	417372.1864	2920674.6525
229	417372.1864	2920762.6525
230	417372.1864	2921224.6525
231	417372.1864	2921312.6525
232	417372.1864	2921774.6525
233	417372.1864	2921862.6525
234	417372.1864	2922324.6525
235	417372.1864	2922412.6525
236	417372.1864	2922874.6525
237	417372.1864	2922962.6525
238	417372.1864	2923424.6525
239	417372.1864	2923512.6525
240	417372.1864	2923974.6525
241	417372.1864	2924062.6525
242	417372.1864	2924524.6525
243	417372.1864	2924612.6525
244	417372.1864	2924824.6525
245	417279.1864	2914318.6525
246	417194.1864	2914318.6525
247	417279.1864	2915718.6525
248	417194.1864	2915718.6525
249	417279.1864	2916818.6525
250	417194.1864	2916818.6525
251	417279.1864	2917918.6525
252	417194.1864	2917918.6525
253	417279.1864	2919018.6525
254	417194.1864	2919018.6525
255	417279.1864	2920168.6525
256	417194.1864	2920168.6525
257	417279.1864	2921268.6525
258	417194.1864	2921268.6525
259	417279.1864	2922368.6525
260	417194.1864	2922368.6525
261	417279.1864	2923468.6525
262	417194.1864	2923468.6525
263	417279.1864	2924868.6525
264	417194.1864	2924868.6525
265	417072.1864	2914662.6525
266	417072.1864	2915124.6525
267	417072.1864	2915212.6525
268	417072.1864	2915674.6525
269	417072.1864	2915762.6525
270	417072.1864	2916224.6525
271	417072.1864	2916312.6525
272	417072.1864	2916774.6525
273	417072.1864	2916862.6525
274	417072.1864	2917324.6525
275	417072.1864	2917412.6525
276	417072.1864	2917874.6525
277	417072.1864	2917962.6525
278	417072.1864	2918424.6525
279	417072.1864	2918512.6525
280	417072.1864	2918974.6525
281	417072.1864	2919062.6525
282	417072.1864	2919524.6525
283	417072.1864	2919612.6525
284	417072.1864	2919824.6525
285	417072.1864	2919912.6525
286	417072.1864	2920124.6525
287	417072.1864	2920212.6525
288	417072.1864	2920674.6525
289	417072.1864	2920762.6525
290	417072.1864	2921224.6525
291	417072.1864	2921312.6525
292	417072.1864	2921774.6525
293	417072.1864	2921862.6525
294	417072.1864	2922324.6525
295	417072.1864	2922412.6525
296	417072.1864	2922874.6525
297	417072.1864	2922962.6525
298	417072.1864	2923424.6525
299	417072.1864	2923512.6525
300	417072.1864	2923974.6525
301	417072.1864	2924062.6525
302	417072.1864	2924524.6525
303	417072.1864	2924612.6525
304	417072.1864	2924824.6525
305	416979.1864	2914318.6525
306	416894.1864	2914318.6525
307	416979.1864	2915718.6525
308	416894.1864	2915718.6525
309	416979.1864	2916818.6525
310	416894.1864	2916818.6525
311	416979.1864	2917918.6525
312	416894.1864	2917918.6525
313	416979.1864	2919018.6525
314	416894.1864	2919018.6525
315	416979.1864	2920168.6525
316	416894.1864	2920168.6525
317	416979.1864	2921268.6525
318	416894.1864	2921268.6525
319	416979.1864	2922368.6525
320	416894.1864	2922368.6525
321	416979.1864	2923468.6525
322	416894.1864	2923468.6525
323	416979.1864	2924868.6525
324	416894.1864	2924868.6525
325	416772.1864	2914662.6525
326	416772.1864	2915124.6525
327	416772.1864	2915212.6525
328	416772.1864	2915674.6525
329	416772.1864	2915762.6525
330	416772.1864	2916224.6525
331	416772.1864	2916312.6525
332	416772.1864	2916774.6525
333	416772.1864	2916862.6525
334	416772.1864	2917324.6525
335	416772.1864	2917412.6525
336	416772.1864	2917874.6525
337	416772.1864	2917962.6525
338	416772.1864	2918424.6525
339	416772.1864	2918512.6525
340	416772.1864	2918974.6525
341	416772.1864	2919062.6525
342	416772.1864	2919524.6525
343	416772.1864	2919612.6525
344	416772.1864	2919824.6525
345	416772.1864	2919912.6525
346	416772.1864	2920124.6525
347	416772.1864	2920212.6525
348	416772.1864	2920674.6525
349	416772.1864	2920762.6525
350	416772.1864	2921224.6525
351	416772.1864	2921312.6525
352	416772.1864	2921774.6525
353	416772.1864	2921862.6525
354	416772.1864	2922324.6525
355	416772.1864	2922412.6525
356	416772.1864	2922874.6525
357	416772.1864	2922962.6525
358	416772.1864	2923424.6525
359	416772.1864	2923512.6525
360	416772.1864	2923974.6525
361	416772.1864	2924062.6525
362	416772.1864	2924524.6525
363	416772.1864	2924612.6525
364	416772.1864	2924824.6525
365	416679.1864	2914318.6525
366	416594.1864	2914318.6525
367	416679.1864	2915718.6525
368	416594.1864	2915718.6525
369	416679.1864	2916818.6525
370	416594.1864	2916818.6525
371	416679.1864	2917918.6525
372	416594.1864	2917918.6525
373	416679.1864	2919018.6525
374	416594.1864	2919018.6525
375	416679.1864	2920168.6525
376	416594.1864	2920168.6525
377	416679.1864	2921268.6525
378	416594.1864	2921268.6525
379	416679.1864	2922368.6525
380	416594.1864	2922368.6525
381	416679.1864	2923468.6525
382	416594.1864	2923468.6525
383	416679.1864	2924868.6525
384	416594.1864	2924868.6525
385	416472.1864	2914662.6525
386	416472.1864	2915124.6525
387	416472.1864	2915212.6525
388	416472.1864	2915674.6525
389	416472.1864	2915762.6525
390	416472.1864	2916224.6525
391	416472.1864	2916312.6525
392	416472.1864	2916774.6525
393	416472.1864	2916862.6525
394	416472.1864	2917324.6525
395	416472.1864	2917412.6525
396	416472.1864	2917874.6525
397	416472.1864	2917962.6525
398	416472.1864	2918424.6525
399	416472.1864	2918512.6525
400	416472.1864	2918974.6525
401	416472.1864	2919062.6525
402	416472.1864	2919524.6525
405	416472.1864	2919762.6525
406	416472.1864	2920124.6525
407	416472.1864	2920212.6525
408	416472.1864	2920674.6525
409	416472.1864	2920762.6525
410	416472.1864	2921224.6525
411	416472.1864	2921312.6525
412	416472.1864	2921774.6525
413	416472.1864	2921862.6525
414	416472.1864	2922324.6525
415	416472.1864	2922412.6525
416	416472.1864	2922874.6525
417	416472.1864	2922962.6525
418	416472.1864	2923424.6525
419	416472.1864	2923512.6525
420	416472.1864	2923974.6525
421	416472.1864	2924062.6525
422	416472.1864	2924524.6525
423	416472.1864	2924612.6525
424	416472.1864	2924824.6525
425	416379.1864	2914318.6525
426	416294.1864	2914318.6525
427	416379.1864	2915718.6525
428	416294.1864	2915718.6525
429	416379.1864	2916818.6525
430	416294.1864	2916818.6525
431	416379.1864	2917918.6525
432	416294.1864	2917918.6525
433	416379.1864	2919018.6525
434	416294.1864	2919018.6525
435	416379.1864	2920168.6525
436	416294.1864	2920168.6525
437	416379.1864	2921268.6525
438	416294.1864	2921268.6525
439	416379.1864	2922368.6525
440	416294.1864	2922368.6525
441	416379.1864	2923468.6525
442	416294.1864	2923468.6525
443	416379.1864	2924868.6525
444	416294.1864	2924868.6525
445	416172.1864	2914662.6525
446	416172.1864	2915124.6525
447	416172.1864	2915212.6525
448	416172.1864	2915674.6525
449	416172.1864	2915762.6525
450	416172.1864	2916224.6525
451	416172.1864	2916312.6525
452	416172.1864	2916774.6525
453	416172.1864	2916862.6525
454	416172.1864	2917324.6525
455	416172.1864	2917412.6525
456	416172.1864	2917874.6525
457	416172.1864	2917962.6525
458	416172.1864	2918424.6525
459	416172.1864	2918512.6525
460	416172.1864	2918974.6525
461	416172.1864	2919062.6525
462	416172.1864	2919524.6525
465	416172.1864	2919762.6525
466	416172.1864	2920124.6525
467	416172.1864	2920212.6525
468	416172.1864	2920674.6525
469	416172.1864	2920762.6525
470	416172.1864	2921224.6525
471	416172.1864	2921312.6525
472	416172.1864	2921774.6525
473	416172.1864	2921862.6525
474	416172.1864	2922324.6525
475	416172.1864	2922412.6525
476	416172.1864	2922874.6525
477	416172.1864	2922962.6525
478	416172.1864	2923424.6525
479	416172.1864	2923512.6525
480	416172.1864	2923974.6525
481	416172.1864	2924062.6525
482	416172.1864	2924524.6525
483	416172.1864	2924612.6525
484	416172.1864	2924824.6525

STATE OF LOUISIANA
DAVID P. HIDALGO
REG. No. 27074
REGISTERED
PROFESSIONAL ENGINEER
IN
CIVIL ENGINEERING

H:\Const\99-33\As-Builts\layout-2A.dwg

SHEET NUMBER 7

AUCOIN & ASSOCIATES, INC.
CONSULTING ENGINEERS
AND LAND SURVEYORS
EUNICE, LOUISIANA

PROJECT BOOK 99-33
DETAILED A.P.M.
CHECKED D.P.H.
DATE SEPTEMBER 2003
SHEET 7


NO.	DATE	BY

REVISION DESCRIPTION


LOUISIANA DEPARTMENT OF NATURAL RESOURCES

SUBAREA "B" COORDINATES
PECAN ISLAND TERRACE CREATION PROJECT
(ME-14/XME-22)

AS-BUILT DRAWINGS

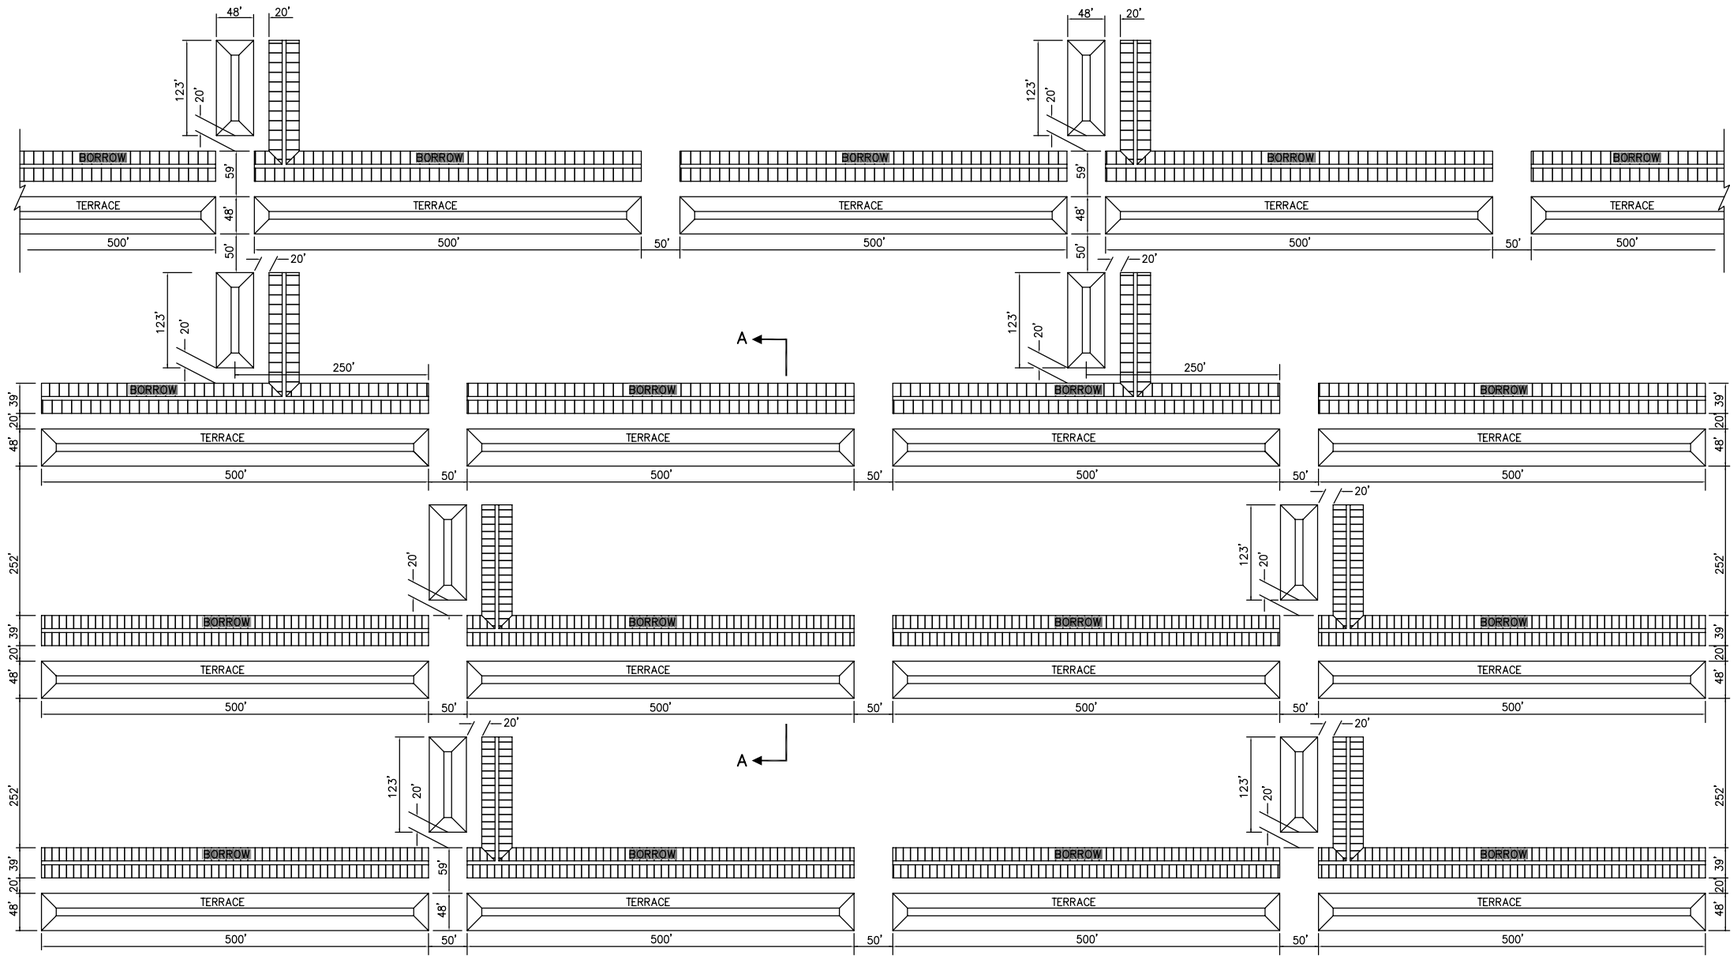

TYPICAL TERRACE DETAIL
NOT TO SCALE

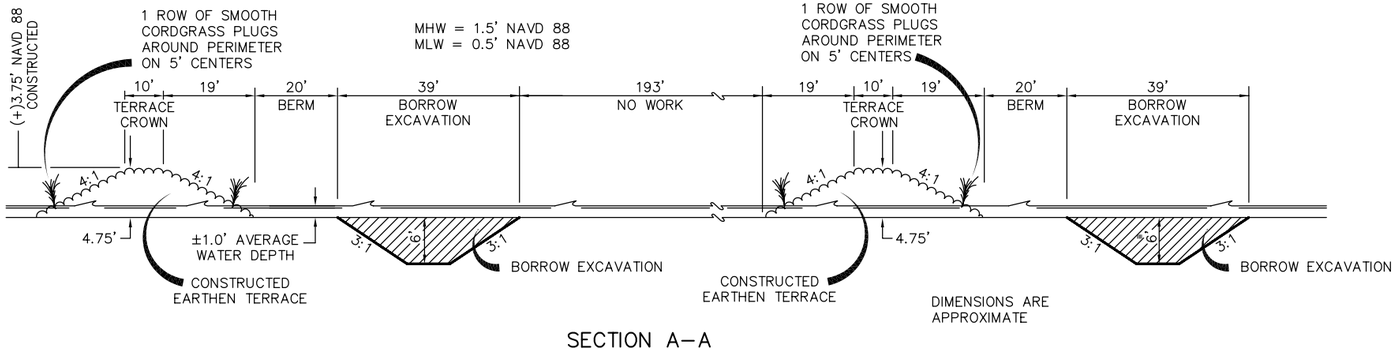

SECTION A–A
NOT TO SCALE

AUCOIN & ASSOCIATES, INC.
CONSULTING ENGINEERS
AND LAND SURVEYORS
EUNICE, LOUISIANA

SHEET NUMBER 8

PROJECT NO.	99-33		
BOOK			
DETAILED	A.P.M.		
CHECKED	D.P.H.		
DATE	SEPTEMBER 2003		
SHEET	8		

NO.	DATE	REVISION DESCRIPTION	BY

LOUISIANA DEPARTMENT OF NATURAL RESOURCES

TERRACE DETAILS
PECAN ISLAND TERRACE CREATION PROJECT
(ME-14/XME-22)

STATE OF LOUISIANA
DAVID P. HIDALGO
REG. No. 27074
REGISTERED
PROFESSIONAL ENGINEER
IN
CIVIL ENGINEERING

AS-BUILT DRAWINGS

File Name: H:\Const\99-33\As-Builts\detail.dwg