



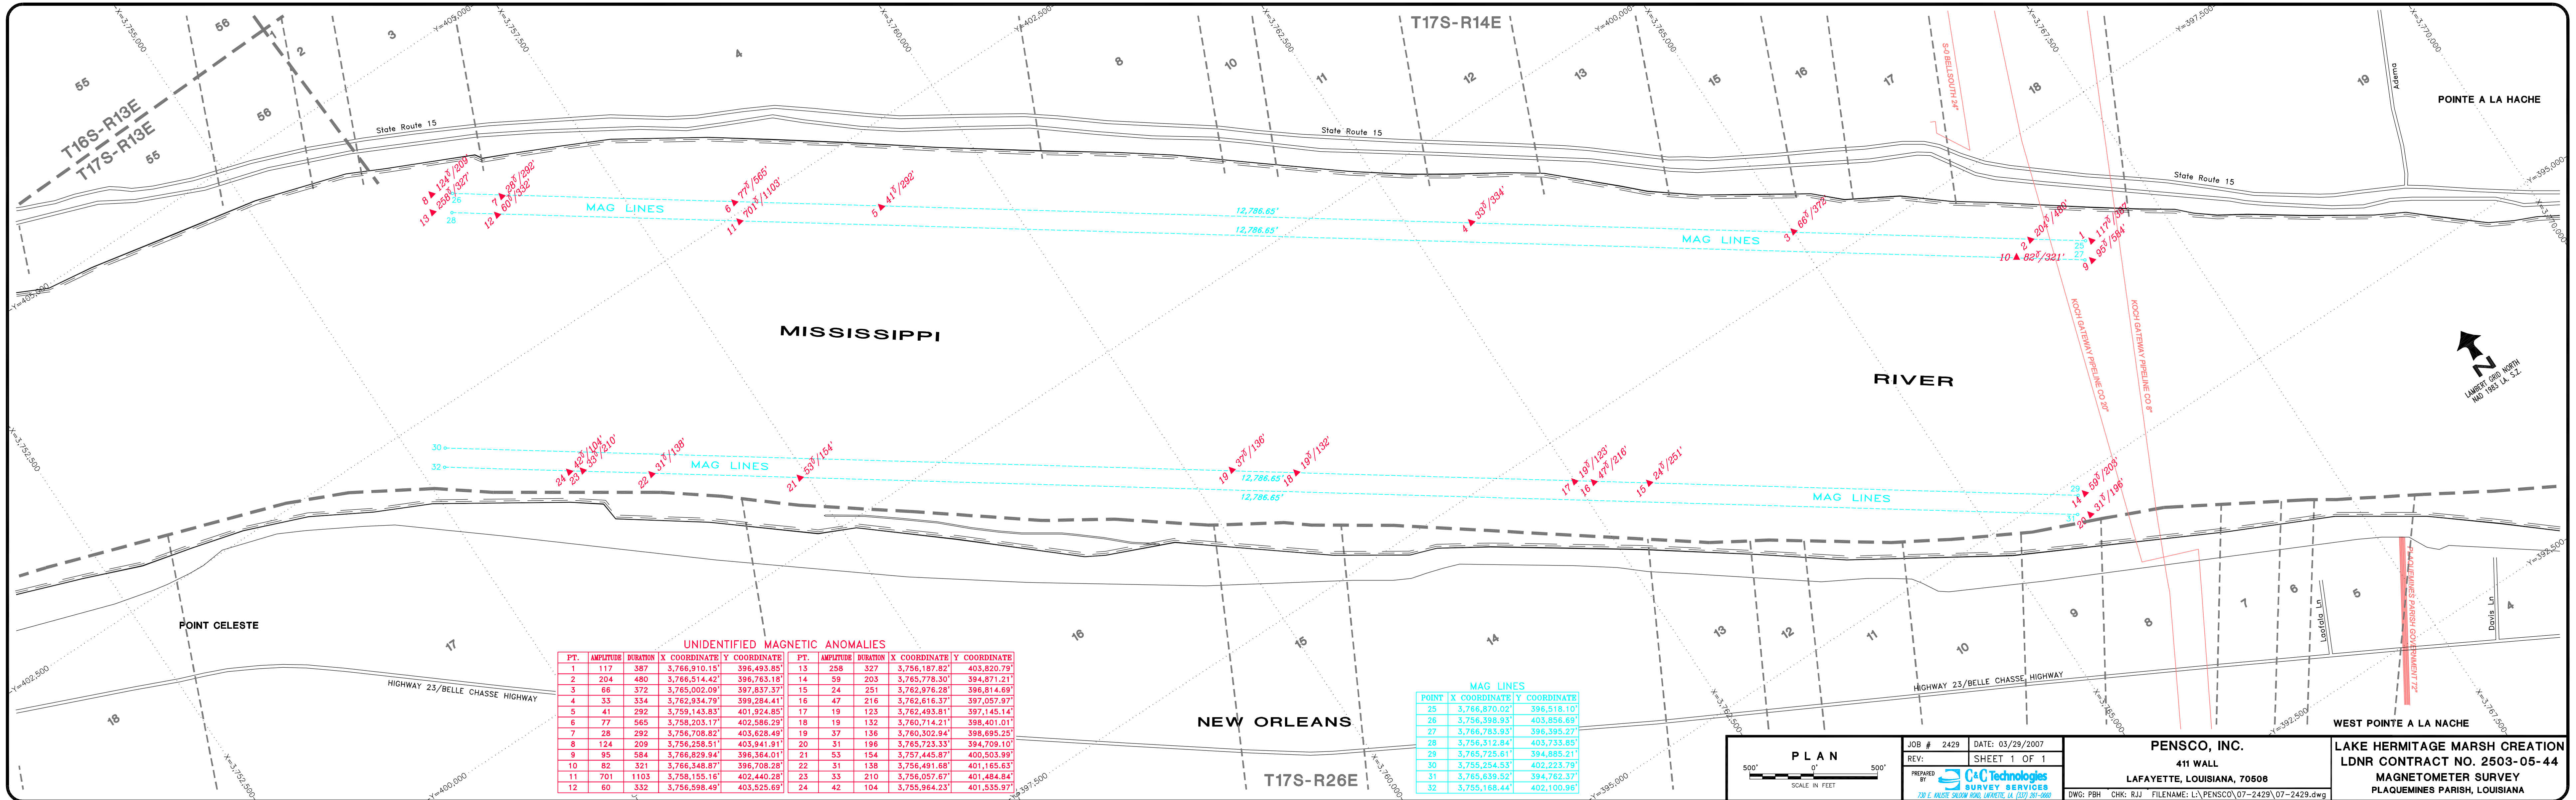

UNIDENTIFIED MAGNETIC ANOMALIES									
PT.	AMPLITUDE	DURATION	X COORDINATE	Y COORDINATE	PT.	AMPLITUDE	DURATION	X COORDINATE	Y COORDINATE
1	117	387	3,766,910.15'	396,493.85'	13	258	327	3,756,187.82'	403,820.79'
2	204	480	3,766,514.42'	396,763.18'	14	59	203	3,765,778.30'	394,871.21'
3	66	372	3,765,002.09'	397,837.37'	15	24	251	3,762,976.28'	396,814.69'
4	33	334	3,762,934.79'	399,284.41'	16	47	216	3,762,616.37'	397,057.97'
5	41	292	3,759,143.83'	401,924.85'	17	19	123	3,762,493.81'	397,145.14'
6	77	565	3,758,203.17'	402,586.29'	18	19	132	3,760,714.21'	398,401.01'
7	28	292	3,756,708.82'	403,628.49'	19	37	136	3,760,302.94'	398,695.25'
8	124	209	3,756,258.51'	403,941.91'	20	31	196	3,765,723.33'	394,709.10'
9	95	584	3,766,829.94'	396,364.01'	21	53	154	3,757,445.87'	400,503.99'
10	82	321	3,766,348.87'	396,708.28'	22	31	138	3,756,491.68'	401,165.63'
11	701	1103	3,758,155.16'	402,440.28'	23	33	210	3,756,057.67'	401,484.84'
12	60	332	3,756,598.49'	403,525.69'	24	42	104	3,755,964.23'	401,535.97'

MAG LINES		
POINT	X COORDINATE	Y COORDINATE
25	3,766,870.02'	396,518.10'
26	3,756,398.93'	403,856.69'
27	3,766,783.93'	396,395.27'
28	3,766,312.84'	403,733.85'
29	3,765,725.61'	394,885.21'
30	3,755,254.53'	402,223.79'
31	3,765,639.52'	394,762.37'
32	3,755,168.44'	402,100.96'

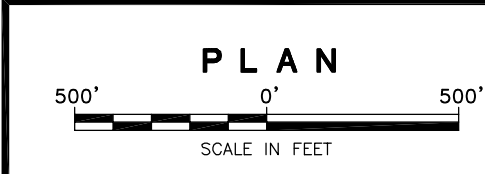

JOB # 2429

DATE: 03/29/2007

REV:

SHEET 1 OF 1

PREPARED BY

C&C Technologies
SURVEY SERVICES
730 E. KALISTE SALOON ROAD, LAFAYETTE, LA 70503-2811-0000

PENSCO, INC.

411 WALL

LAFAYETTE, LOUISIANA, 70508

DWG: PBH

CHK: RJJ

FILENAME: L:\PENSCO\07-2429\07-2429.dwg

LAKE HERMITAGE MARSH CREATION

LDNR CONTRACT NO. 2503-05-44

MAGNETOMETER SURVEY

PLAQUEMINES PARISH, LOUISIANA