


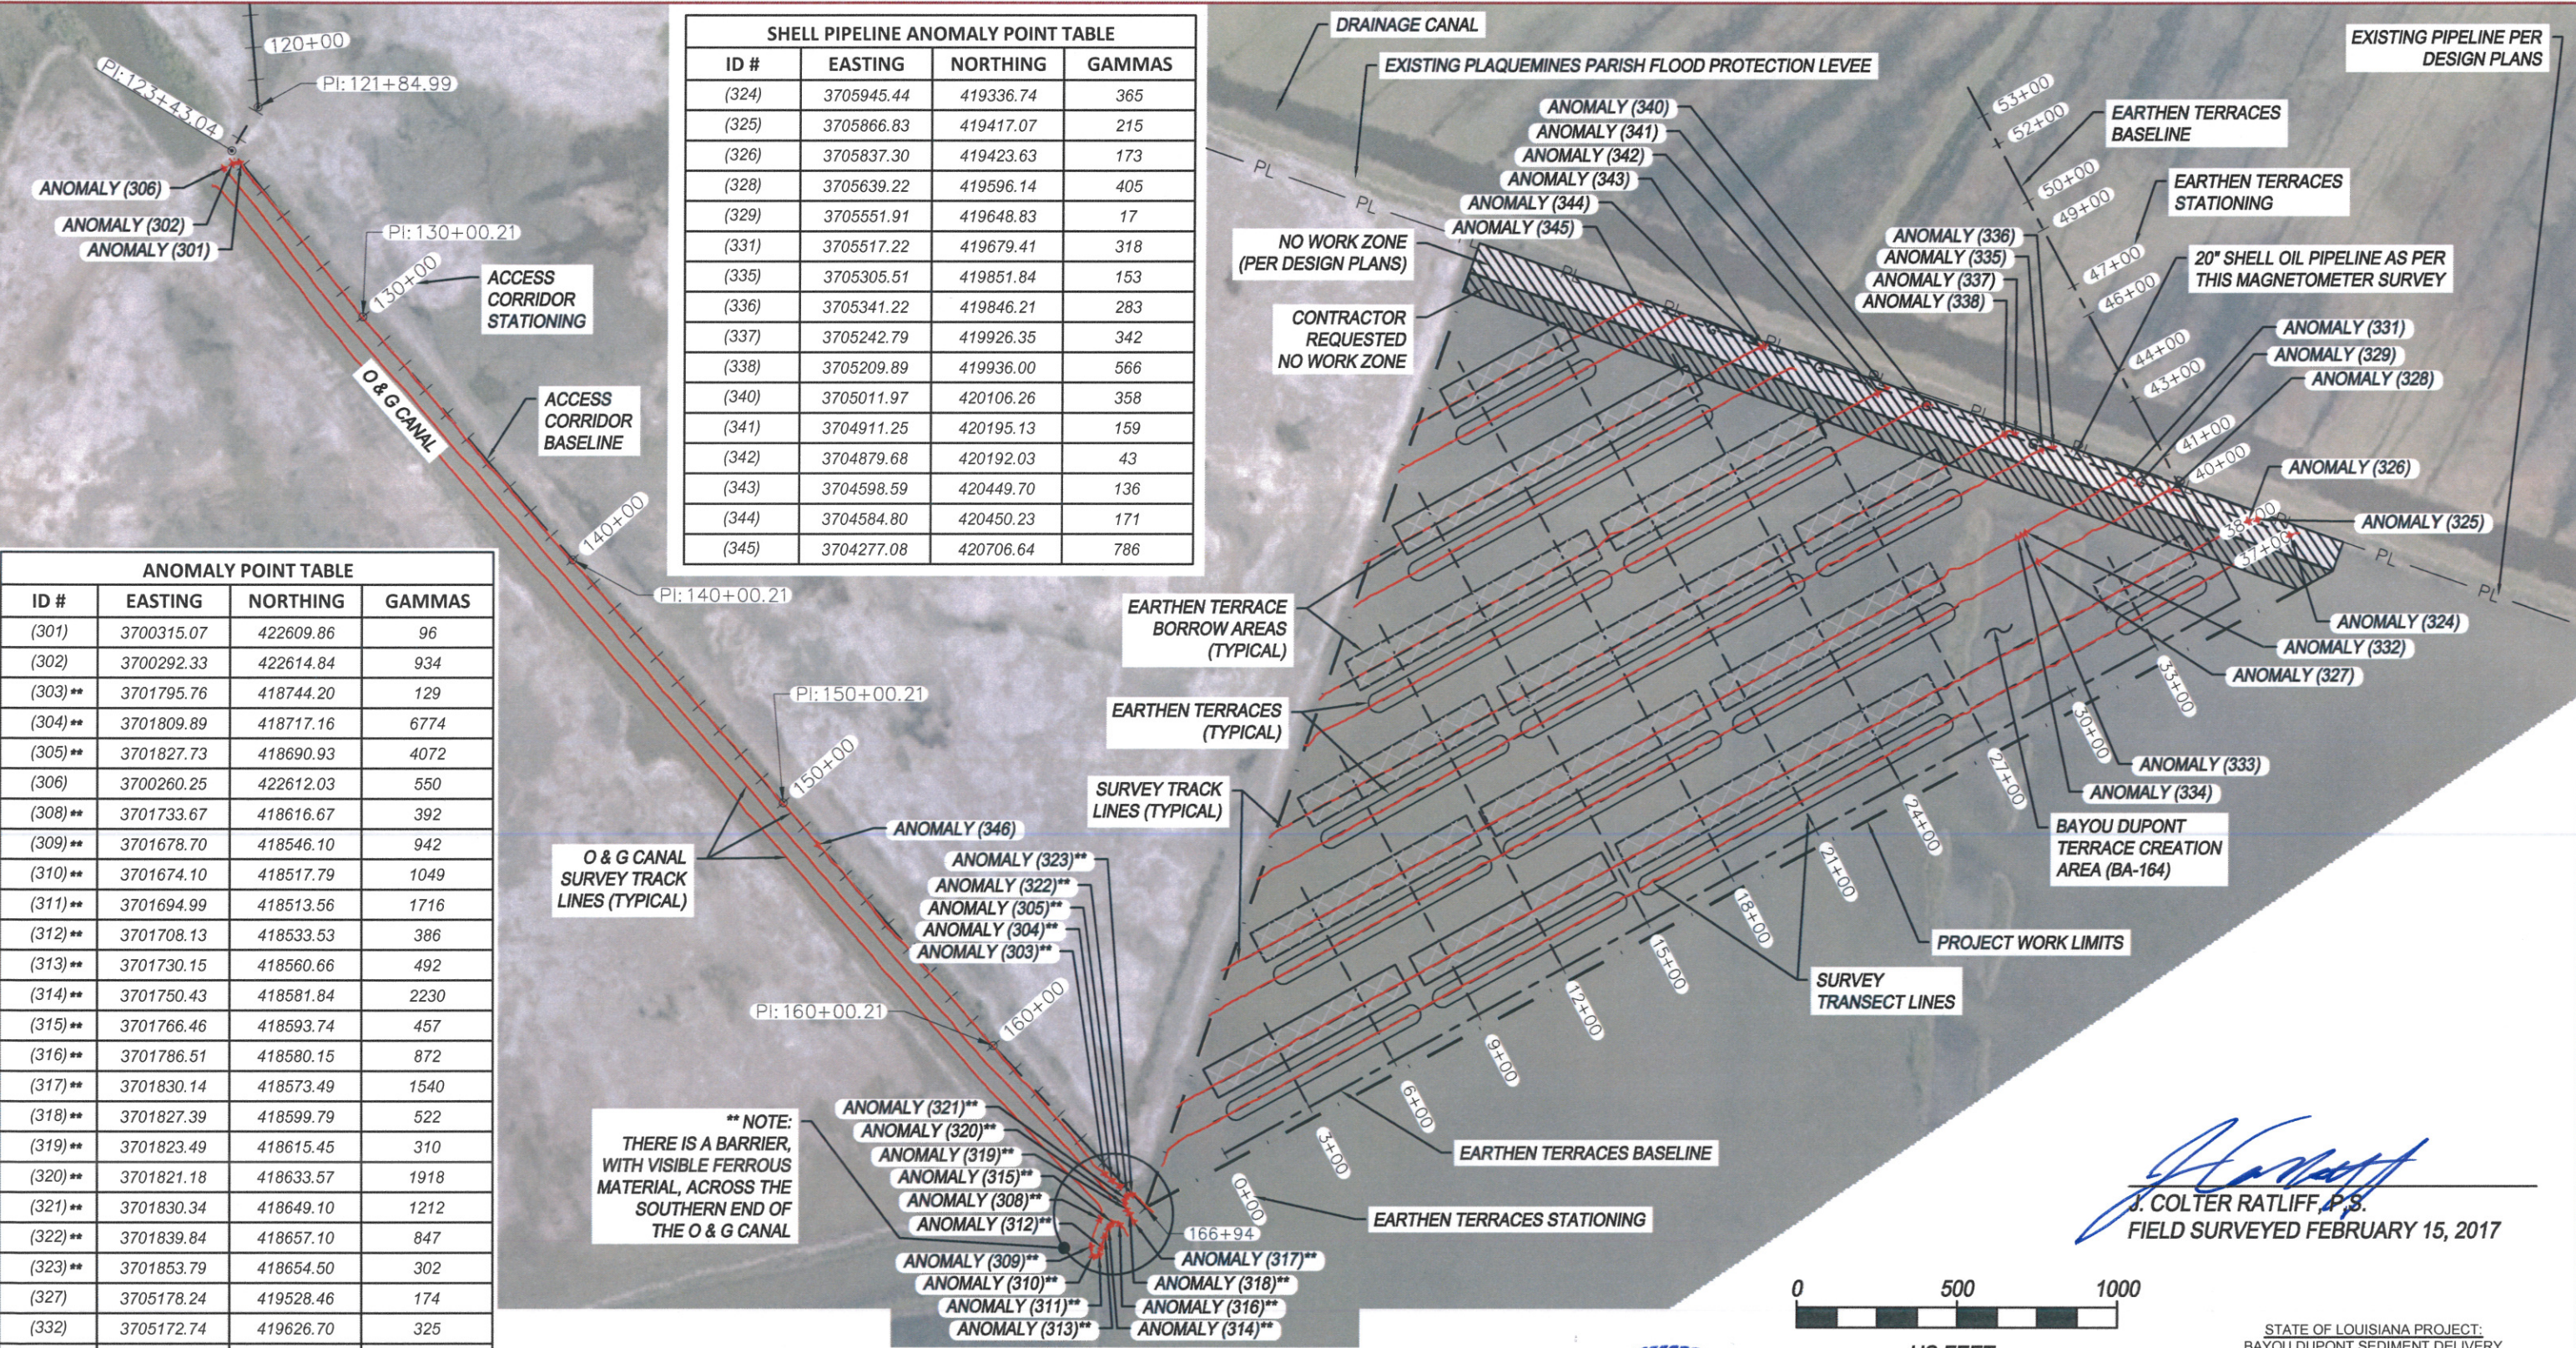

ANOMALY POINT TABLE			
ID #	EASTING	NORTHING	GAMMAS
(301)	3700315.07	422609.86	96
(302)	3700292.33	422614.84	934
(303)**	3701795.76	418744.20	129
(304)**	3701809.89	418717.16	6774
(305)**	3701827.73	418690.93	4072
(306)	3700260.25	422612.03	550
(308)**	3701733.67	418616.67	392
(309)**	3701678.70	418546.10	942
(310)**	3701674.10	418517.79	1049
(311)**	3701694.99	418513.56	1716
(312)**	3701708.13	418533.53	386
(313)**	3701730.15	418560.66	492
(314)**	3701750.43	418581.84	2230
(315)**	3701766.46	418593.74	457
(316)**	3701786.51	418580.15	872
(317)**	3701830.14	418573.49	1540
(318)**	3701827.39	418599.79	522
(319)**	3701823.49	418615.45	310
(320)**	3701821.18	418633.57	1918
(321)**	3701830.34	418649.10	1212
(322)**	3701839.84	418657.10	847
(323)**	3701853.79	418654.50	302
(327)	3705178.24	419528.46	174
(332)	3705172.74	419626.70	325
(333)	3705157.29	419622.37	93
(334)	3705141.60	419619.79	190
(346)	3701298.73	420007.97	30

- SURVEYOR'S NOTES:**
- COPIES OF THIS SURVEY WITHOUT AN ORIGINAL SIGNATURE AND SEAL IN BLUE INK ARE NOT VALID. ANY ALTERATION OF THIS SURVEY, IN WHOLE OR PART, WITHOUT PRIOR WRITTEN PERMISSION OF TICE ENGINEERING, INC. IS PROHIBITED.
 - THIS SURVEY IS REFERENCED TO THE LOUISIANA STATE PLANE, SOUTH ZONE (1702), NAD (83). ALL UNITS SHOWN HEREON ARE IN U.S. SURVEY FEET.
 - ALL ELEVATIONS ARE REFERENCED TO NAVD 88 (GEOID 03). ELEVATIONS SHOWN IN PARENTHESIS REPRESENT AN ELEVATION BELOW ZERO.
 - A PROTON MAGNETOMETER HAS BEEN USED TO LOCATE MAGNETIC ANOMALIES ON THIS SITE. WHILE REASONABLE EFFORTS HAVE BEEN MADE TO LOCATE ALL MAGNETIC ANOMALIES WITHIN THE SITE LIMITS THIS SURVEY MAY NOT SHOW ALL MAGNETIC ANOMALIES.
 - IF SHOWN, THE BACKGROUND AERIAL IMAGE(S) ARE PROVIDED BY BING ONTERRA SERVER AND/OR GOOGLE EARTH AND ARE SHOWN FOR GRAPHICAL PURPOSES ONLY.

SHELL PIPELINE ANOMALY POINT TABLE			
ID #	EASTING	NORTHING	GAMMAS
(324)	3705945.44	419336.74	365
(325)	3705866.83	419417.07	215
(326)	3705837.30	419423.63	173
(328)	3705639.22	419596.14	405
(329)	3705551.91	419648.83	17
(331)	3705517.22	419679.41	318
(335)	3705305.51	419851.84	153
(336)	3705341.22	419846.21	283
(337)	3705242.79	419926.35	342
(338)	3705209.89	419936.00	566
(340)	3705011.97	420106.26	358
(341)	3704911.25	420195.13	159
(342)	3704879.68	420192.03	43
(343)	3704598.59	420449.70	136
(344)	3704584.80	420450.23	171
(345)	3704277.08	420706.64	786

MAGNETOMETER SURVEY
BA-43 (EB) / BA-164 AREAS 1, 2A, 2B, & 3



GRID NORTH
NAD 83
LOUISIANA STATE PLANE SOUTH

J. Colter Ratliff, P.S.
J. COLTER RATLIFF, P.S.
FIELD SURVEYED FEBRUARY 15, 2017

STATE OF LOUISIANA PROJECT:
BAYOU DUPONT SEDIMENT DELIVERY
MARSH CREATION #3
BA-164 EARTHEN TERRACES

TEI

TICE
ENGINEERING, INC.
ENGINEERS / SURVEYORS

Trusted Engineers. Experienced Surveyors. Innovative Results.

510 S. VARDAMAN ST.
WIGGINS, MS 39577
PHONE: 601.928.4121
FAX: 601.928.4131

1290 SEVENTH ST.
SLIDELL, LA 70458
PHONE: 985.242.0601
FAX: 601.928.4131

PROJECT NUMBER : S13-123.021 OF 1