

---

STATE OF LOUISIANA  
COASTAL PROTECTION AND RESTORATION  
AUTHORITY




---

MISSISSIPPI RIVER DELTA  
DELTA-WIDE CREVASSES (MR-0009)  
ON PASS-A-LOUTRE WILDLIFE MANAGEMENT AREA (PALWMA)  
AND DELTA NATIONAL WILDLIFE REFUGE (DNWR)  
PLAQUEMINES PARISH, LOUISIANA

FINAL REPORT  
September 18, 2019  
CPRA Contract No. 4400012421

PREPARED BY:

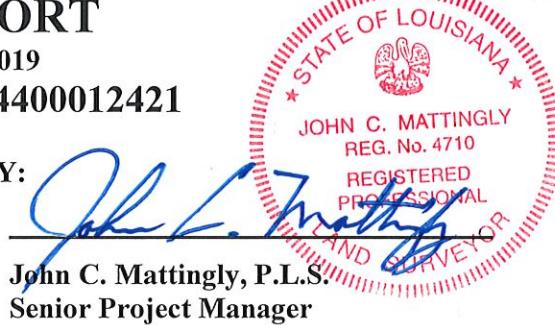

John C. Mattingly, P.L.S.  
Senior Project Manager



116 Venture Boulevard  
P.O. Box 3106  
Houma, Louisiana 70361  
<http://www.mphinc.com>  
(985) 879-2731

---

---

**MISSISSIPPI RIVER DELTA  
DELTA-WIDE CREVASSES (MR-0009)  
ON PASS-A-LOUTRE WILDLIFE MANAGEMENT AREA (PALWMA)  
AND DELTA NATIONAL WILDLIFE REFUGE (DNWR)  
PLAQUEMINES PARISH, LOUISIANA**

Survey Report

Table of Contents

|             |   |          |
|-------------|---|----------|
| <b>1.0</b>  | <b>INTRODUCTION.....</b>                                      | <b>1</b> |
| <b>2.0</b>  | <b>PROJECT OVERVIEW .....</b>                                 | <b>1</b> |
| <b>3.0</b>  | <b>DATA COLLECTION SUMMARY .....</b>                          | <b>2</b> |
| <b>3.1</b>  | <b>GPS Control Survey.....</b>                                | <b>2</b> |
| <b>3.2</b>  | <b>Topographic, Bathymetric and Magnetometer Survey .....</b> | <b>2</b> |
| <b>4.0</b>  | <b>METHODOLOGY.....</b>                                       | <b>3</b> |
| <b>4.1</b>  | <b>Static GPS Network Planning .....</b>                      | <b>3</b> |
| <b>4.2</b>  | <b>GPS Static Survey .....</b>                                | <b>3</b> |
| <b>4.3</b>  | <b>Data Processing and Network Adjustment.....</b>            | <b>3</b> |
| <b>5.0</b>  | <b>SURVEY CONTROL .....</b>                                   | <b>4</b> |
| <b>6.0</b>  | <b>QA/QC PROCEDURES .....</b>                                 | <b>4</b> |
| <b>7.0</b>  | <b>HORIZONTAL AND VERTICAL CONTROL .....</b>                  | <b>4</b> |
| <b>8.0</b>  | <b>ALIGNMENT &amp; BATHYMETRIC SURVEY .....</b>               | <b>5</b> |
| <b>9.0</b>  | <b>MAGNETOMETER HAZARD SURVEY .....</b>                       | <b>5</b> |
| <b>9.1</b>  | <b>Hazard Investigation Survey.....</b>                       | <b>5</b> |
| <b>10.0</b> | <b>CHRONOLOGICAL SUMMARY OF WORK .....</b>                    | <b>6</b> |
| <b>11.0</b> | <b>DELIVERABLES .....</b>                                     | <b>6</b> |
| <b>12.0</b> | <b>CERTIFICATION .....</b>                                    | <b>7</b> |

## LIST OF APPENDICES

| <u>DESCRIPTION</u>   | <u>PAGE</u> |
|--|-------------|
| <b>Network Adjustment Report.....</b>                          | <b>A-1</b>  |
| <b>GPS Session Schedule .....</b>                              | <b>A-2</b>  |
| <b>Original Contract Drawings.....</b>                         | <b>A-3</b>  |
| Title Sheet – State & Local Vicinity Map .....                 | 1           |
| Vicinity Map – Crevasses OP-6, OP-7, RP-8, RP-9, & FP-10 ..... | 2           |
| Vicinity Map – Crevasses SP-11, SP-12, LP-13 .....             | 3           |
| Delta Wide Crevasses Overview .....                            | 4-11        |
| Delta Wide Crevasses Transects .....                           | 12-16       |
| <b>Field Survey Data.....</b>                                  | <b>A-4</b>  |
| <b>Bathymetry Survey Data .....</b>                            | <b>A-5</b>  |
| <b>Magnetometer Survey Data .....</b>                          | <b>A-6</b>  |
| <b>Field Note Records .....</b>                                | <b>A-7</b>  |
| <b>Key Personnel.....</b>                                      | <b>A-8</b>  |
| <b>Existing Benchmark Data Sheets.....</b>                     | <b>A-9</b>  |

## DIGITAL APPENDIX

**Project Drawings (PDF & DWG Format)**

**Survey Point Data (CSV Format)**

**Survey Field Notes (PDF Format)**

---

**MISSISSIPPI RIVER DELTA  
DELTA-WIDE CREVASSES (MR-0009)  
ON PASS-A-LOUTRE WILDLIFE MANAGEMENT AREA (PALWMA)  
AND DELTA NATIONAL WILDLIFE REFUGE (DNWR)  
PLAQUEMINES PARISH, LOUISIANA**

**September 18, 2019**

## **1.0 INTRODUCTION**

The project area is located in Plaquemines Parish, to the southeast of Venice, Louisiana on the active Mississippi River Delta (Figure 1). The project consists of maintaining existing crevasse-splays, the construction of new crevasse-splays, and future maintenance of selected crevasse-splays in both the Pass-A-Loutre Wildlife Management Area (PALWMA) and the Delta National Wildlife Refuge (DNWR). Crevasses are breaks in the levee that allow overbank deposition of sediments to occur in adjacent inter-distributary receiving bays. The PALWMA covers 115,000 acres between Pass-A-Loutre and Southwest Pass and is owned and managed by the Louisiana Department of Wildlife and Fisheries (LDWF). The DNWR covers 48,000 acres from just north of Main Pass southward to Pass- A-Loutre and is owned and managed by the U.S. Fish and Wildlife Service (USFWS).

## **2.0 PROJECT OVERVIEW**

Eight (8) crevasses – six (6) are new, one (1) is a clean-out, and one (1) is reopening of an old crevasse – will be dredged along Octave Pass, Raphael Pass, Flatboat Pass, South Pass, and Loomis Pass. New crevasses will be dredged in South Pass, Loomis Pass, Octave Pass, Flatboat Pass, and Raphael Pass. The crevasse “cleanout” will occur along South Pass and the reopening of an old crevasse will occur along Raphael Pass. Surveying services are needed for the following:

### **Topographic Survey**

- Two continuous, parallel transects on the total length of sub-aerial, natural ground along 6 new crevasse alignments in South Pass, Loomis Pass, Octave Pass, Flatboat Pass and Raphael Pass as well as along the old crevasse to be reopened in Raphael Pass.

### **Bathymetric Survey**

- Two continuous, parallel transects along each new crevasse alignment, excluding the sub-aerial natural ground
- Centerline profile of crevasse listed as “Cleanout”
- Ten cross-sections at the proposed cleanout

### **Magnetometer survey**

- Survey proposed alignment for the new and reopened crevasses, and for the cleanout crevasse.

## **3.0 DATA COLLECTION SUMMARY**

### **3.1 GPS Control Survey**

During the period of May 7<sup>th</sup>, 2019 through May 13<sup>th</sup>, 2019 MPH performed a static survey of MR09-SM-31, MR09-SM-38 and MR09-SM06 to verify the horizontal and vertical control on the monuments. For the purpose of this project, the elevation of the monuments are referenced to Geoid12B.

### **3.2 Topographic, Bathymetric and Magnetometer Survey**

During the period of April 23<sup>rd</sup>, 2019 through August 30<sup>th</sup>, 2019, MPH collected field data throughout the MR-0009 project. All field work on the Topographic, Bathymetric, and Magnetometer Survey was completed on Auguts 30<sup>th</sup>, 2019. The office work began in advance of the fieldwork. A total of eight (8) crevasses were surveyed at the locations provided. The transects were spaced at intervals with varying lengths as provided by CPRA. Survey transects were laid out in the open water and broken marsh. Position, elevation, and water depth were recorded at a minimum of every 25-ft or where elevations changes of greater than 0.5-ft occurred along each transect, where possible. An appropriate topo shoe was attached to the bottom of the survey rod to prevent the rod from sinking. The Conventional Survey Crews utilized an airboat and a Trimble RTK/GPS base and rover setup for positioning and real-time corrections.

A bathymetry survey was performed along the proposed crevasse alignments where water depths were greater than 2-ft. The bathymetry survey overlapped the topographic survey a minimum of 50-ft. The bathymetric survey points were collected utilizing Trimble SPS 461 DGPS rover and Odom HydroTrac Echo sounder in conjunction with the Hypack software. A sampling rate of 5 Hz (5 points/second) was used during data collection. The Hydrographic Survey Crew used a 16' boat with outboard marine engine.

MPH performed a magnetometer hazard survey along the same transects established during the topographic and bathymetric survey. The magnetometer lines were run during the same time frame as the bathymetry survey lines where possible. In the upland areas within the project, the magnetometer survey was performed utilizing an airboat. The magnetometer survey was completed utilizing a Trimble RTK/GPS and Geometrics G-882 Cesium Magnetometer. All data was collected and processed with Hypack software.

---

## 4.0 METHODOLOGY

### 4.1 Static GPS Network Planning

The Static GPS Network was designed to incorporate two (2) CORS “Continuously Operating Reference Stations” from the Center for GeoInformatics at LSU. The two CORS used for this survey were “GRIS” and “BVHS”. They are located in Grand Isle and Boothville, respectively. Since these stations are continuously collecting data, simultaneous data was collected for the two CORS during the time of the static survey of each of the three monuments “MR09-SM-31”, “MR09-SM-38” and “MR09-SM06”. A Static GPS Survey was run on one monument each day during the RTK Survey on a rotational basis throughout the job. On that day a three (3) minute observed control point was measured utilizing a bipod/tripod on the other monument at the beginning and ending of each day. [This process was repeated each day rotating the GPS Base for the ten (10) day project duration with the same static and RTK survey procedure described above used to measure the other monument at the beginning and ending each day.] This yielded sufficient data to correlate the 3 monuments to one another. Due to the project length being 10 days, we were able capture different site and atmospheric conditions in order to generate independent and redundant observations. The static surveys were performed concurrently with the field topographic cross sections. All data collected is referenced to the Lambert Conformal Conic Projection, Louisiana State Plane Coordinate System (South Zone), the North American Datum of 1983 (NAD83) and the North American Vertical Datum of 1988 (NAVD88), Geoid12B.

### 4.2 GPS Static Survey

The GPS Static Survey was performed using Trimble R10/R10 GPS receivers equipped with fixed height tripods. The GPS receivers were set to collect L1 and L2 data at a 15 second epoch rate with a 10-degree elevation mask. Static GPS data was collected at the benchmark for a minimum of 3 hours per session. Data collection sessions were performed on different days during the RTK Topographic Surveys as shown on the GPS Session Schedule in Appendix 2.

### 4.3 Data Processing and Network Adjustment

The static GPS data was downloaded from the receiver and imported into Trimble Business Center (TBC) for processing and QA/QC. Each setup was checked to verify that the antenna height and station name matched the corresponding field log sheet.

Each baseline was processed using a 15-degree elevation mask and all baselines achieved a fixed solution with no editing. This adjustment used Geoid12B as the basis for determining orthometric heights of adjusted ellipsoid heights. The network was found to fit existing control within acceptable limits, and all primary control was found to be consistent with respect to differences in published and computed elevation values. The Fully Constrained Network Adjustment report and final adjusted positions can be seen in Appendix 1.

---

## 5.0 SURVEY CONTROL

Benchmarks used as a control are tied into the CPRA – Louisiana Coastal Zone (LCZ) GPS Network. MPH conducted all surveying activities using the “MR09-SM-31” (Secondary LCZ control monument) and “MR09-SM-38” (Secondary LCZ control monument), and “MR09-SM-06” (Secondary LCZ control monument) which were updated by performing a GPS Network Adjustment into the LCZ GPS network using the Geoid12B model. These benchmarks are identified by the Louisiana State Plane Coordinate System (South Zone), the North American Horizontal Datum of 1983 (NAD 83), and the North American Vertical Datum of 1988 (NAVD88) geoid 12B. The information for the three monuments was gathered from CPRA’s CIMS website and existing LCZ GPS Network.

## 6.0 QA/QC Procedures

MPH conducted topographic, bathymetric, and magnetometer surveys for the Delta-Wide Crevasses (MR-0009) project as per the practices set forth in CPRA’s January 2016 version of “A Contractors Guide to the Standards of Practice”. MPH furnished the necessary equipment, software, supplies, labor and transportation, including fuel, needed to complete the work as outlined in the Reconnaissance Field Data Collection plan provided to CPRA prior to the commencement of the surveying activities within the fill area. All fieldwork associated with these surveys were conducted under the direct supervision of a Professional Land Surveyor.

All field and office work performed was completed utilizing the in-house developed Operating Procedures and Quality Control/Quality Assurance Manual. This manual was developed to define appropriate standards of practice and accepted operating procedures and performance criteria to be used to provide consistency, accuracy, and reliability of services and products. These practices included: checking into secondary monumentation at the beginning and ending of each day to ensure GPS quality assurance, performing bar checks and sound velocity checks at the beginning and ending of each day for the bathymetry surveys, performing a calibration line with the magnetometer to ensure proper functionality and offset values, etc. All equipment used on the project checked for proper calibration prior to the start of the project. Field survey data was also analyzed in the office on a daily basis to ensure accuracy and quality.

---

## 7.0 HORIZONTAL AND VERTICAL CONTROL

MPH performed a GPS survey utilizing RTK OTF methods. The GPS Total Station survey equipment included the use of a Trimble R10 Dual Frequency receiver as a rover and a Trimble R10 Dual Frequency receiver as a base. The base station occupied one of the three survey control monuments “MR09-SM-31” (Secondary LCZ control monument) and “MR09-SM-38” (Secondary LCZ control monument), and “MR09-

SM-06" (Secondary LCZ control monument) and rover units were used to collect horizontal and vertical data along the transects. [For quality control, the GPS Base Receiver was set up on an existing project control point with an established horizontal position and elevation while the Rover Receiver was used to observe the other existing project control point checking. This observed position was checked against the newly established position of the control points to verify that it was within an accepted tolerance. This QA/QC process was performed daily throughout the duration of the project.] Survey data was downloaded and processed utilizing Trimble Business Center. The complete RTK Total Station survey method yields nominal accuracies of 1 cm horizontal and 2 cm vertical. The monuments which were used for control, are referenced to the Lambert Conformal Conic Projection, Louisiana State Plane Coordinate System (South Zone), the North American Datum of 1983 (NAD83) and the North American Vertical Datum of 1988 (NAVD88).

## **8.0 ALIGNMENT SURVEY**

MPH performed topographic and bathymetric surveys along proposed crevasse alignments. The survey transects for the alignment and bathymetric survey that were performed and developed based on the information provided by CPRA. A total of (15) transects, were surveyed (Two at each proposed crevasse location and one at SP-12 with additional cross-sections) during this phase of the project. The transects were spaced at varying intervals and lengths as provided by CPRA. Survey transects were laid out in the open water, broken marsh, and across natural bayous. Position, elevation, and water depth were recorded at a minimum of every 25 ft. along each transect, where possible. The topographic survey was completed utilizing a Trimble RTK/GPS base and rover setup. A 6-inch diameter topo shoe was attached to the bottom of the survey rod to prevent the GPS antenna rod from sinking. In areas, where water depths were too deep for the use of the GPS antenna rod a level rod was used to take soundings.

## **9.0 MAGNETOMETER HAZARD SURVEY**

MPH performed a magnetometer hazard survey along the same transects established during the alignment and bathymetric survey. The magnetometer survey was performed utilizing a Trimble SPS 461 DGPS and Geometrics G-882 Cesium Magnetometer. All data was collected and processed in Hypack software. At the start and end of each day a calibration line was performed in opposite directions to ensure proper functionality and offset values.

### **9.1 Hazard Investigation Survey**

Once field data collection was completed, magnetic anomalies were determined from processing magnetometer data and interpretation. The magnetometer gamma baseline during the field geohazard survey was 46400 gammas. The Geometrics model G-882 last certified manufacturer (dated 3/13/18) depth calibration =

0.016483 (salt water) and bias = -1.65. The altimeter calibration scale = 0.01016 and bias = -1.27.

The magnetometer dataset was processed using the Single Beam Editor in HYPACK®. Magnetic anomalies were evaluated on the basis of one hundred (100) gammas or higher. There were Seven (7) magnetometer anomalies selected within the areas of the 8 crevasses surveyed. Six were on the Pass-A-Loutre Wildlife Management Area and one on Delta National Wildlife Refuge. A conventional survey crew investigated the six on the Pass-A-Loutre Wildlife Management Area being they were in areas of concern. Of the six located on Pass-A-Loutre Wildlife Management Area three were located on South Pass (SP-11), one was located on South Pass (SP-12), and two were located on Loomis Pass (LP-13) crevasse locations. The one anomaly in the Delta National Wildlife Refuge was not of concern because of the location being on the opposite bank northwest of the proposed Flat Boat Pass (FP-10) crevasse location.

For each magnetic anomaly the conventional survey crew ran a closed loop path with a gradiometer. The path completely enclosed the original finding location, while maintaining a distance of approximately 25 feet from the anomaly location. A 25 foot circular path was used around each of the anomaly locations with no other readings encountered.

## **10.0 Chronological Summary of Work**

| Project #      | Group                                    | Date                     |
|----------------|--|--------------------------|
| <b>MR-0009</b> | <b>ALIGNMENT SURVEY</b>                  | <b>4/23-5/14/2019</b>    |
| <b>MR-0009</b> | <b>CROSS SECTION SURVEY</b>              | <b>5/14/2019</b>         |
| <b>MR-0009</b> | <b>BATHYMETRY SURVEY</b>                 | <b>8/26/2019</b>         |
| <b>MR-0009</b> | <b>MAGNETOMETER SURVEY</b>               | <b>07/02- 08-27/2019</b> |
| <b>MR-0009</b> | <b>MAGNETOMETER INVESTIGATION SURVEY</b> | <b>8/30/2019</b>         |

## **11.0 Deliverables**

As requested in the CPRA of Louisiana Scope of Services the following deliverables are being submitted:


- 11.1** A report describing the survey methodology employed in the field.
- 11.2** Two sets of 11" x 17" size plan view drawings showing an overlay of the Lambert Conformal Conic Projection Louisiana State Plane Coordinate System South Zone NAD 83 and drawings showing all survey control points utilized in the survey. Two sets of 11" x 17" size plan and profile drawings, depicting the results of the topographic and bathymetric surveys.
- 11.3** Two digital copies of drawing files on separate CD disks or jump drives in AutoCAD (\*.dwg) format.

- 
- 11.4** A copy of the XYZ survey data will be provided in a comma-delimited ASCII format. The data is referenced to the Louisiana Coordinate System (South Zone) and North American Datum of 1983 (NAD 83) in U.S. Survey Feet. Elevations are referenced to the North American Vertical Datum of 1988 (NAVD 88) in feet.
  - 11.5** Two printed copies of the survey data.
  - 11.6** Two printed copies of the field notebook records.

## **12.0 CERTIFICATION**

I hereby certify that the report, data and drawings referenced herein were prepared from a field survey conducted on the ground by me or under my direct supervision and control and that the report, data and drawings accurately depict the result of said survey.

Morris P. Hebert, Inc.  
283 Corporate Drive  
Houma, LA 70360

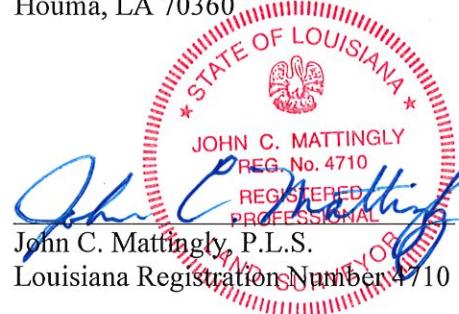

## **APPENDIX 1**

### **Network Adjustment Report**

**CPRA/Coastal Protection and Restoration Authority**  
“MR09-SM-31”, “MR09-SM-38”, “MR09-SM-06, & “3/4” Iron Rod w/MPH Cap”  
*Survey Control For*  
*Delta-Wide Crevasses (MR-0009)*  
*On Pass-A-Loutre Wildlife Management Area (PALWMA)*  
*and Delta National Wildlife Refuge (DNWR)*  
*Plaquemines Parish, Louisiana*



| POINT | NORTHING   | EASTING     | ELEVATION | DESCRIPTION                 |
|-------|------------|-------------|-----------|-----------------------------|
| 1000  | 267445.484 | 3945645.4   | 5.494     | MR09-SM-31                  |
| 1001  | 276368.213 | 3947242.724 | 1.973     | MR09-SM-38                  |
| 1002  | 238749.078 | 3953567.719 | 2.716     | MR09-SM-06                  |
| 1004  | 234136.261 | 3959208.644 | 5.237     | SET 3/4" IRON ROD w/MPH Cap |

| <b>Project File Data</b> |   | <b>Coordinate System</b>         |
|--------------------------|---|----------------------------------|
| Name:                    | C:\Users\ldrennan\Documents\Trimble Business Center\13000-04 Static.vce | Name: US State Plane 1983        |
| Size:                    | 457 KB  | Datum: NAD 1983 (Conus)          |
| Modified:                | 5/14/2019 3:37:05 PM (UTC:-5)   | Zone: Louisiana South 1702       |
| Time zone:               |   | Geoid: GEOID12B (Conus)          |
| Reference number:        |   | Vertical datum: Calibrated site: |
| Description:             |   |                                  |
| Comment 1:               |   |                                  |
| Comment 2:               |   |                                  |
| Comment 3:               |   |                                  |

## Additional Coordinate System Details

| <b>Local Site Settings</b> |          |                        |          |
|----------------------------|----------|------------------------|----------|
| Project latitude:          | ?        | Ground scale factor:   | 1        |
| Project longitude:         | ?        | False northing offset: | 0.000 ft |
| Project height:            | 0.000 ft | False easting offset:  | 0.000 ft |

# Network Adjustment Report

## Adjustment Settings

### Set-Up Errors

#### GNSS

**Error in Height of Antenna:** 0.006 ft

**Centering Error:** 0.018 ft

### Covariance Display

#### Horizontal:

**Propagated Linear Error [E]:** U.S.

**Constant Term [C]:** 0.000 ft

**Scale on Linear Error [S]:** 1.960

#### Three-Dimensional

**Propagated Linear Error [E]:** U.S.

**Constant Term [C]:** 0.000 ft

**Scale on Linear Error [S]:** 1.960

---

## Adjustment Statistics

**Number of Iterations for Successful Adjustment:** 2

**Network Reference Factor:** 1.00

**Chi Square Test (95%):** Passed

**Precision Confidence Level:** 95%

**Degrees of Freedom:** 52

### Post Processed Vector Statistics

**Reference Factor:** 0.95

**Redundancy Number:** 14.67

**A Priori Scalar:** 1.00

### RTK Vector Statistics

**Reference Factor:** 1.01

**Redundancy Number:** 37.33

**A Priori Scalar:** 1.29

---

## Control Point Constraints

| Point ID | Type  | North $\sigma$<br>(US survey foot) | East $\sigma$<br>(US survey foot) | Height $\sigma$<br>(US survey foot) | Elevation $\sigma$<br>(US survey foot) |
|----------|-------|------------------------------------|-----------------------------------|-------------------------------------|--|
| BVHS     | Local | Fixed                              | Fixed                             | Fixed                               |  |
| GRIS     | Local | Fixed                              | Fixed                             | Fixed                               |  |

Fixed = 0.000003(US survey foot)

## Adjusted Grid Coordinates

| Point ID | Northing<br>(US survey foot) | Northing Error<br>(US survey foot) | Easting<br>(US survey foot) | Easting Error<br>(US survey foot) | Elevation<br>(US survey foot) | Elevation Error<br>(US survey foot) | Constraint |
|----------|------------------------------|------------------------------------|-----------------------------|-----------------------------------|-------------------------------|-------------------------------------|------------|
| 1000     | 267445.484                   | 0.042                              | 3945645.400                 | 0.042                             | 5.494                         | 0.059                               |            |
| 1001     | 276368.213                   | 0.042                              | 3947242.724                 | 0.042                             | 1.973                         | 0.057                               |            |

|                      |            |       |             |       |        |       |     |
|----------------------|------------|-------|-------------|-------|--------|-------|-----|
| <a href="#">1002</a> | 238749.078 | 0.045 | 3953567.719 | 0.046 | 2.716  | 0.056 |     |
| <a href="#">1004</a> | 234136.261 | 0.046 | 3959208.644 | 0.046 | 5.237  | 0.057 |     |
| <a href="#">BVHS</a> | 309482.269 | ?     | 3894798.478 | ?     | 31.546 | ?     | LLh |
| <a href="#">GRIS</a> | 281033.474 | ?     | 3719590.183 | ?     | 27.375 | ?     | LLh |

## Adjusted Geodetic Coordinates

| Point ID             | Latitude         | Longitude        | Height<br>(US survey foot) | Height Error<br>(US survey foot) | Constraint |
|----------------------|------------------|------------------|----------------------------|----------------------------------|------------|
| <a href="#">1000</a> | N29°13'07.59606" | W89°14'57.26701" | -72.002                    | 0.059                            |            |
| <a href="#">1001</a> | N29°14'35.62473" | W89°14'37.40832" | -75.682                    | 0.057                            |            |
| <a href="#">1002</a> | N29°08'22.12829" | W89°13'33.83471" | -74.446                    | 0.056                            |            |
| <a href="#">1004</a> | N29°07'35.44046" | W89°12'31.20307" | -71.917                    | 0.057                            |            |
| <a href="#">BVHS</a> | N29°20'12.48974" | W89°24'23.01021" | -46.745                    | ?                                | LLh        |
| <a href="#">GRIS</a> | N29°15'55.88300" | W89°57'26.26226" | -51.286                    | ?                                | LLh        |

## Adjusted ECEF Coordinates

| Point ID             | X<br>(US survey foot) | X Error<br>(US survey foot) | Y<br>(US survey foot) | Y Error<br>(US survey foot) | Z<br>(US survey foot) | Z Error<br>(US survey foot) | 3D Error<br>(US survey foot) | Constraint |
|----------------------|-----------------------|-----------------------------|-----------------------|-----------------------------|-----------------------|-----------------------------|------------------------------|------------|
| <a href="#">1000</a> | 239488.504            | 0.042                       | -18276027.568         | 0.056                       | 10154429.697          | 0.046                       | 0.084                        |            |
| <a href="#">1001</a> | 241190.720            | 0.042                       | -18271659.348         | 0.054                       | 10162187.569          | 0.046                       | 0.082                        |            |
| <a href="#">1002</a> | 247070.840            | 0.046                       | -18289984.332         | 0.054                       | 10129252.167          | 0.048                       | 0.085                        |            |
| <a href="#">1004</a> | 252656.263            | 0.046                       | -18292206.379         | 0.055                       | 10125134.023          | 0.049                       | 0.087                        |            |
| <a href="#">BVHS</a> | 189142.939            | ?                           | -18255649.118         | ?                           | 10191879.302          | ?                           | ?                            | LLh        |
| <a href="#">GRIS</a> | 13616.876             | ?                           | -18269305.528         | ?                           | 10169272.618          | ?                           | ?                            | LLh        |

## Error Ellipse Components

| Point ID | Semi-major axis<br>(US survey foot) | Semi-minor axis<br>(US survey foot) | Azimuth |
|----------|-------------------------------------|-------------------------------------|---------|
| 1000     | 0.053                               | 0.052                               | 101°    |
| 1001     | 0.053                               | 0.052                               | 83°     |
| 1002     | 0.057                               | 0.056                               | 86°     |
| 1004     | 0.058                               | 0.057                               | 115°    |

## Adjusted GNSS Observations

### Transformation Parameters

Azimuth Rotation: -0.010 sec (95%) 0.043 sec

Scale Factor: 1.000000012 (95%) 0.000000022

| Observation ID      |             | Observation  | A-posteriori Error | Residual   | Standardized Residual |
|---------------------|-------------|--------------|--------------------|------------|-----------------------|
| 1000-1001 (V13)     | Az.         | 11°11'30"    | 0.565 sec          | -1.640 sec | -2.104                |
|                     | ΔHt.        | -3.680 ft    | 0.038 ft           | -0.063 ft  | -1.589                |
|                     | Ellip Dist. | 9064.437 ft  | 0.025 ft           | 0.023 ft   | 0.663                 |
| 1001-1000 (V210)    | Az.         | 191°11'39"   | 0.565 sec          | 1.476 sec  | 1.761                 |
|                     | ΔHt.        | 3.680 ft     | 0.038 ft           | 0.096 ft   | 1.946                 |
|                     | Ellip Dist. | 9064.437 ft  | 0.025 ft           | 0.043 ft   | 1.110                 |
| BVHS --> 1001 (PV2) | Az.         | 123°14'00"   | 0.116 sec          | -0.045 sec | -0.672                |
|                     | ΔHt.        | -28.937 ft   | 0.057 ft           | 0.057 ft   | 1.603                 |
|                     | Ellip Dist. | 62023.556 ft | 0.035 ft           | 0.038 ft   | 1.901                 |
| 1004-1002 (V843)    | Az.         | 310°20'11"   | 0.853 sec          | -1.816 sec | -1.744                |
|                     | ΔHt.        | -2.529 ft    | 0.045 ft           | 0.005 ft   | 0.089                 |
|                     | Ellip Dist. | 7286.556 ft  | 0.030 ft           | -0.014 ft  | -0.360                |
| 1004-1002 (V842)    | Az.         | 310°20'11"   | 0.853 sec          | -1.601 sec | -1.710                |
|                     | ΔHt.        | -2.529 ft    | 0.045 ft           | -0.016 ft  | -0.430                |
|                     | Ellip Dist. | 7286.556 ft  | 0.030 ft           | -0.010 ft  | -0.289                |

|   |                    |               |           |            |        |
|---|--------------------|---------------|-----------|------------|--------|
| <a href="#">1000-1001 (V356)</a>        | <b>Az.</b>         | 11°11'30"     | 0.565 sec | -1.504 sec | -1.692 |
|   | <b>ΔHt.</b>        | -3.680 ft     | 0.038 ft  | 0.030 ft   | 0.502  |
|   | <b>Ellip Dist.</b> | 9064.437 ft   | 0.025 ft  | -0.031 ft  | -0.726 |
| <a href="#">BVHS --&gt; 1002 (PV3)</a>  | <b>Az.</b>         | 141°14'34"    | 0.082 sec | -0.001 sec | -0.027 |
|   | <b>ΔHt.</b>        | -27.700 ft    | 0.056 ft  | 0.064 ft   | 1.566  |
|   | <b>Ellip Dist.</b> | 91960.680 ft  | 0.035 ft  | -0.015 ft  | -0.749 |
| <a href="#">1002-1004 (V513)</a>        | <b>Az.</b>         | 130°19'41"    | 0.853 sec | 1.099 sec  | 0.950  |
|   | <b>ΔHt.</b>        | 2.529 ft      | 0.045 ft  | 0.025 ft   | 0.410  |
|   | <b>Ellip Dist.</b> | 7286.556 ft   | 0.030 ft  | 0.062 ft   | 1.519  |
| <a href="#">1001-1000 (V101)</a>        | <b>Az.</b>         | 191°11'39"    | 0.565 sec | 0.273 sec  | 0.285  |
|   | <b>ΔHt.</b>        | 3.680 ft      | 0.038 ft  | 0.002 ft   | 0.036  |
|   | <b>Ellip Dist.</b> | 9064.437 ft   | 0.025 ft  | -0.064 ft  | -1.510 |
| <a href="#">GRIS --&gt; 1000 (PV6)</a>  | <b>Az.</b>         | 94°07'55"     | 0.032 sec | -0.012 sec | -0.649 |
|   | <b>ΔHt.</b>        | -20.716 ft    | 0.059 ft  | -0.066 ft  | -1.162 |
|   | <b>Ellip Dist.</b> | 226460.327 ft | 0.038 ft  | -0.034 ft  | -1.480 |
| <a href="#">1000-1001 (V100)</a>        | <b>Az.</b>         | 11°11'30"     | 0.565 sec | -1.206 sec | -1.435 |
|   | <b>ΔHt.</b>        | -3.680 ft     | 0.038 ft  | 0.041 ft   | 0.860  |
|   | <b>Ellip Dist.</b> | 9064.437 ft   | 0.025 ft  | 0.044 ft   | 1.242  |
| <a href="#">1004-1002 (V646)</a>        | <b>Az.</b>         | 310°20'11"    | 0.853 sec | 1.489 sec  | 1.362  |
|   | <b>ΔHt.</b>        | -2.529 ft     | 0.045 ft  | -0.013 ft  | -0.233 |
|   | <b>Ellip Dist.</b> | 7286.556 ft   | 0.030 ft  | -0.043 ft  | -1.191 |
| <a href="#">BVHS --&gt; 1000 (PV1)</a>  | <b>Az.</b>         | 130°32'45"    | 0.109 sec | 0.002 sec  | 0.032  |
|   | <b>ΔHt.</b>        | -25.257 ft    | 0.059 ft  | 0.003 ft   | 0.055  |
|   | <b>Ellip Dist.</b> | 65973.151 ft  | 0.035 ft  | -0.027 ft  | -1.320 |
| <a href="#">GRIS --&gt; 1002 (PV10)</a> | <b>Az.</b>         | 100°56'11"    | 0.031 sec | -0.021 sec | -1.208 |
|   | <b>ΔHt.</b>        | -23.160 ft    | 0.056 ft  | -0.033 ft  | -0.745 |
|   | <b>Ellip Dist.</b> | 237762.352 ft | 0.039 ft  | 0.020 ft   | 0.824  |
| <a href="#">1000-1001 (V895)</a>        | <b>Az.</b>         | 11°11'30"     | 0.565 sec | 0.870 sec  | 0.929  |
|   | <b>ΔHt.</b>        | -3.680 ft     | 0.038 ft  | 0.074 ft   | 0.993  |
|   | <b>Ellip Dist.</b> | 9064.437 ft   | 0.025 ft  | 0.047 ft   | 1.178  |
| <a href="#">GRIS --&gt; 1001 (PV8)</a>  | <b>Az.</b>         | 91°51'58"     | 0.032 sec | 0.020 sec  | 1.031  |
|   | <b>ΔHt.</b>        | -24.397 ft    | 0.057 ft  | -0.042 ft  | -0.774 |
|   | <b>Ellip Dist.</b> | 227698.057 ft | 0.039 ft  | 0.016 ft   | 0.621  |
| <a href="#">BVHS --&gt; 1004 (PV4)</a>  | <b>Az.</b>         | 140°26'20"    | 0.074 sec | 0.031 sec  | 0.794  |

|   |                    |               |           |            |        |
|---|--------------------|---------------|-----------|------------|--------|
|   | <b>ΔHt.</b>        | -25.172 ft    | 0.057 ft  | -0.019 ft  | -0.491 |
|   | <b>Ellip Dist.</b> | 99123.051 ft  | 0.035 ft  | 0.008 ft   | 0.434  |
| <a href="#">GRIS --&gt; 1004 (PV12)</a> | <b>Az.</b>         | 101°45'58"    | 0.030 sec | 0.012 sec  | 0.706  |
|   | <b>ΔHt.</b>        | -20.631 ft    | 0.057 ft  | -0.020 ft  | -0.339 |
|   | <b>Ellip Dist.</b> | 244158.770 ft | 0.038 ft  | 0.004 ft   | 0.199  |
| <a href="#">1000-1001 (V441)</a>        | <b>Az.</b>         | 11°11'30"     | 0.565 sec | -0.648 sec | -0.646 |
|   | <b>ΔHt.</b>        | -3.680 ft     | 0.038 ft  | 0.020 ft   | 0.273  |
|   | <b>Ellip Dist.</b> | 9064.437 ft   | 0.025 ft  | -0.028 ft  | -0.698 |
| <a href="#">1001-1000 (V355)</a>        | <b>Az.</b>         | 191°11'39"    | 0.565 sec | 0.358 sec  | 0.263  |
|   | <b>ΔHt.</b>        | 3.680 ft      | 0.038 ft  | -0.036 ft  | -0.289 |
|   | <b>Ellip Dist.</b> | 9064.437 ft   | 0.025 ft  | -0.028 ft  | -0.524 |
| <a href="#">1001-1000 (V211)</a>        | <b>Az.</b>         | 191°11'39"    | 0.565 sec | 0.270 sec  | 0.276  |
|   | <b>ΔHt.</b>        | 3.680 ft      | 0.038 ft  | -0.019 ft  | -0.236 |
|   | <b>Ellip Dist.</b> | 9064.437 ft   | 0.025 ft  | 0.021 ft   | 0.429  |
| <a href="#">1004-1002 (V894)</a>        | <b>Az.</b>         | 310°20'11"    | 0.853 sec | -0.510 sec | -0.351 |
|   | <b>ΔHt.</b>        | -2.529 ft     | 0.045 ft  | 0.012 ft   | 0.118  |
|   | <b>Ellip Dist.</b> | 7286.556 ft   | 0.030 ft  | -0.016 ft  | -0.355 |

## Covariance Terms

| From Point           | To Point             |                    | Components   | A-posteriori Error | Horiz. Precision (Ratio) | 3D Precision (Ratio) |
|----------------------|----------------------|--------------------|--------------|--------------------|--------------------------|----------------------|
| <a href="#">1000</a> | <a href="#">1001</a> | <b>Az.</b>         | 11°11'30"    | 0.565 sec          | 1 : 366416               | 1 : 366436           |
|                      |                      | <b>ΔHt.</b>        | -3.680 ft    | 0.038 ft           |                          |                      |
|                      |                      | <b>ΔElev.</b>      | -3.521 ft    | 0.038 ft           |                          |                      |
|                      |                      | <b>Ellip Dist.</b> | 9064.438 ft  | 0.025 ft           |                          |                      |
| <a href="#">1002</a> | <a href="#">1004</a> | <b>Az.</b>         | 130°19'41"   | 0.855 sec          | 1 : 244270               | 1 : 244403           |
|                      |                      | <b>ΔHt.</b>        | 2.529 ft     | 0.045 ft           |                          |                      |
|                      |                      | <b>ΔElev.</b>      | 2.521 ft     | 0.045 ft           |                          |                      |
|                      |                      | <b>Ellip Dist.</b> | 7286.557 ft  | 0.030 ft           |                          |                      |
| <a href="#">BVHS</a> | <a href="#">1000</a> | <b>Az.</b>         | 130°32'45"   | 0.131 sec          | 1 : 1570571              | 1 : 1570742          |
|                      |                      | <b>ΔHt.</b>        | -25.257 ft   | 0.059 ft           |                          |                      |
|                      |                      | <b>ΔElev.</b>      | -26.052 ft   | 0.059 ft           |                          |                      |
|                      |                      | <b>Ellip Dist.</b> | 65973.159 ft | 0.042 ft           |                          |                      |

|             |             |                    |               |           |             |             |
|-------------|-------------|--------------------|---------------|-----------|-------------|-------------|
| <u>BVHS</u> | <u>1001</u> | <b>Az.</b>         | 123°14'00"    | 0.139 sec | 1 : 1478579 | 1 : 1478901 |
|             |             | <b>ΔHt.</b>        | -28.937 ft    | 0.057 ft  |             |             |
|             |             | <b>ΔElev.</b>      | -29.573 ft    | 0.057 ft  |             |             |
|             |             | <b>Ellip Dist.</b> | 62023.563 ft  | 0.042 ft  |             |             |
| <u>BVHS</u> | <u>1002</u> | <b>Az.</b>         | 141°14'34"    | 0.102 sec | 1 : 2033560 | 1 : 2034067 |
|             |             | <b>ΔHt.</b>        | -27.700 ft    | 0.056 ft  |             |             |
|             |             | <b>ΔElev.</b>      | -28.830 ft    | 0.056 ft  |             |             |
|             |             | <b>Ellip Dist.</b> | 91960.691 ft  | 0.045 ft  |             |             |
| <u>BVHS</u> | <u>1004</u> | <b>Az.</b>         | 140°26'20"    | 0.096 sec | 1 : 2134535 | 1 : 2134881 |
|             |             | <b>ΔHt.</b>        | -25.172 ft    | 0.057 ft  |             |             |
|             |             | <b>ΔElev.</b>      | -26.309 ft    | 0.057 ft  |             |             |
|             |             | <b>Ellip Dist.</b> | 99123.062 ft  | 0.046 ft  |             |             |
| <u>GRIS</u> | <u>1000</u> | <b>Az.</b>         | 94°07'55"     | 0.038 sec | 1 : 5380005 | 1 : 5379866 |
|             |             | <b>ΔHt.</b>        | -20.716 ft    | 0.059 ft  |             |             |
|             |             | <b>ΔElev.</b>      | -21.881 ft    | 0.059 ft  |             |             |
|             |             | <b>Ellip Dist.</b> | 226460.353 ft | 0.042 ft  |             |             |
| <u>GRIS</u> | <u>1001</u> | <b>Az.</b>         | 91°51'58"     | 0.038 sec | 1 : 5397521 | 1 : 5397780 |
|             |             | <b>ΔHt.</b>        | -24.396 ft    | 0.057 ft  |             |             |
|             |             | <b>ΔElev.</b>      | -25.402 ft    | 0.057 ft  |             |             |
|             |             | <b>Ellip Dist.</b> | 227698.083 ft | 0.042 ft  |             |             |
| <u>GRIS</u> | <u>1002</u> | <b>Az.</b>         | 100°56'11"    | 0.039 sec | 1 : 5206157 | 1 : 5206658 |
|             |             | <b>ΔHt.</b>        | -23.160 ft    | 0.056 ft  |             |             |
|             |             | <b>ΔElev.</b>      | -24.658 ft    | 0.056 ft  |             |             |
|             |             | <b>Ellip Dist.</b> | 237762.380 ft | 0.046 ft  |             |             |
| <u>GRIS</u> | <u>1004</u> | <b>Az.</b>         | 101°45'58"    | 0.039 sec | 1 : 5250812 | 1 : 5250336 |
|             |             | <b>ΔHt.</b>        | -20.631 ft    | 0.057 ft  |             |             |
|             |             | <b>ΔElev.</b>      | -22.138 ft    | 0.057 ft  |             |             |
|             |             | <b>Ellip Dist.</b> | 244158.798 ft | 0.046 ft  |             |             |

|                            |  |                         |
|----------------------------|--|-------------------------|
| Date: 5/14/2019 3:57:30 PM | Project:<br>C:\Users\ldrennan\Documents\Trimble<br>Business Center\13000-04 Static.vce | Trimble Business Center |
|----------------------------|--|-------------------------|

---

## **APPENDIX 2**

### **GPS Session Schedule**

**CPRA/Coastal Protection and Restoration Authority**  
*GPS Network Adjustment*  
 “MR09-SM-31”, “MR09-SM-38”, & “MR-SM-06”  
*For*  
*Delta-Wide Crevasses (MR-0009)*  
*On Pass-A-Loutre Wildlife Management Area (PALWMA)*  
*and Delta National Wildlife Refuge (DNWR)*  
*Plaquemines Parish, Louisiana*



### **GPS SESSION SCHEDULE**

| Date      | Monument        | Operator/Crew | Session # | Start Time | End Time | Length  |
|-----------|-----------------|---------------|-----------|------------|----------|---------|
| 4/23/2019 | MR09-SM-31      | James Rowe    | 1         | 13:05:27   | 15:45:57 | 2:40:30 |
| 4/24/2019 | MR09-SM-38      | James Rowe    | 2         | 8:33:27    | 13:46:27 | 5:13:00 |
| 5/7/2019  | MR09-SM-06      | James Rowe    | 3         | 9:49:57    | 12:54:42 | 3:04:45 |
| 5/13/2019 | Rebar w/MPH Cap | James Rowe    | 4         | 12:11:27   | 16:09:42 | 3:58:15 |

---

## **APPENDIX 3**

### **Original Contract Drawings**

| M.P.H. JOB NO. | DATE          | SHEET NO. |
|----------------|---------------|-----------|
| 13000-04       | AUG. 28, 2019 | 1         |

Office of Coastal Protection and Restoration Authority of Louisiana

# DELTA WIDE CREVASSES SURVEYING SERVICES

MR-0009


PLAQUEMINES PARISH, LOUISIANA




INDEX TO SHEETS

SHEET NO. DESCRIPTION

- 1 TITLE SHEET - STATE & LOCAL VICINITY MAP
- 2 VICINITY MAP - CREVASSES OP-6 (N), OP-7 ALT. (N), RP-8 (N), RP-9 ALT. (R), & FP-10 (N)
- 3 VICINITY MAP - CREVASSES SP-11 (N), SP-12 (C), & LP-13 (N)
- 4 DELTA WIDE CREVASSES - CREVASSE OP-6 (N) OVERVIEW
- 5 DELTA WIDE CREVASSES - CREVASSE OP-7 ALT. (N) OVERVIEW
- 6 DELTA WIDE CREVASSES - CREVASSE RP-8 (N) OVERVIEW
- 7 DELTA WIDE CREVASSES - CREVASSE RP-9 ALT. (R) OVERVIEW
- 8 DELTA WIDE CREVASSES - CREVASSE FP-10 (N) OVERVIEW
- 9 DELTA WIDE CREVASSES - CREVASSE SP-11 (N) OVERVIEW
- 10 DELTA WIDE CREVASSES - CREVASSE SP-12 (C) OVERVIEW
- 11 DELTA WIDE CREVASSES - CREVASSE LP-13 (N) OVERVIEW
- 12 DELTA WIDE CREVASSES - OP-6 (N) TRANSECTS 1-2 & OP-7 ALT. (N) TRANSECTS 1 - 2
- 13 DELTA WIDE CREVASSES - RP-8 (N) TRANSECTS 1-2 & RP-9 ALT. (R) TRANSECTS 1 - 2
- 14 DELTA WIDE CREVASSES - FP-10 (N) TRANSECTS 1-2, & SP-11 (N) TRANSECT 1 - 2
- 15 DELTA WIDE CREVASSES - SP-12 (C) TRANSECTS 1 THRU 12
- 16 DELTA WIDE CREVASSES - LP-13 (N) TRANSECTS 1-2

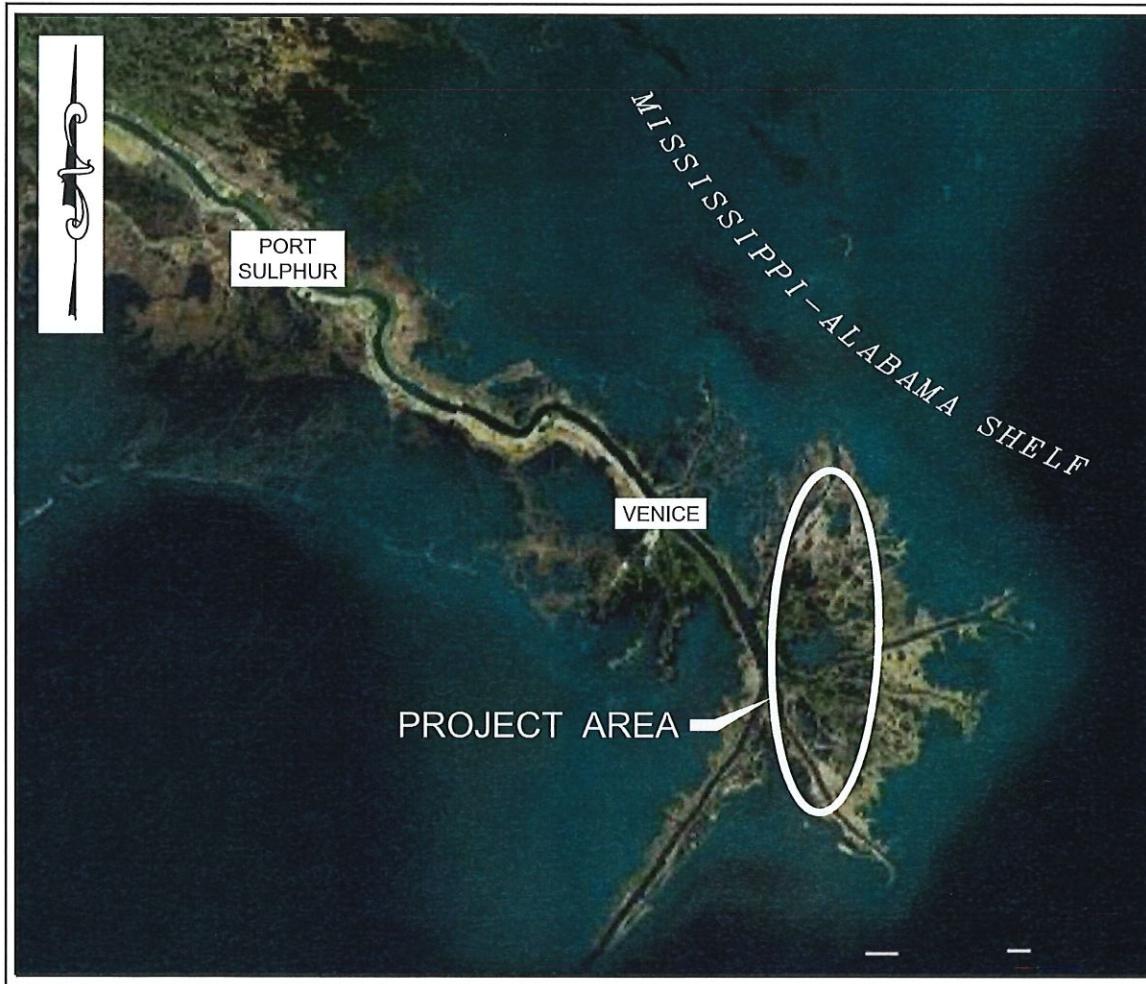

PROJECT LOCATION MAP  
NOT TO SCALE

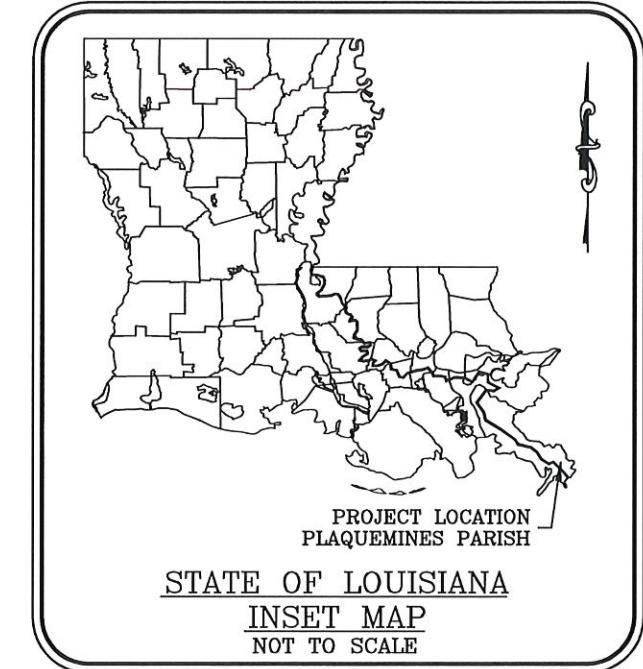

STATE OF LOUISIANA  
INSET MAP  
NOT TO SCALE




APPROVED: *[Signature]*  
JOHN C. MATTINLY, P.L.S., L.A. LICENSE NO. 4710

THIS DOCUMENT VALID ONLY WHEN EITHER AN  
ORIGINAL CERTIFICATION STAMP OR AN EMBOSSED  
SEAL IS IMPRESSED OVER AN ORIGINAL SIGNATURE.



SET NO. \_\_\_\_\_

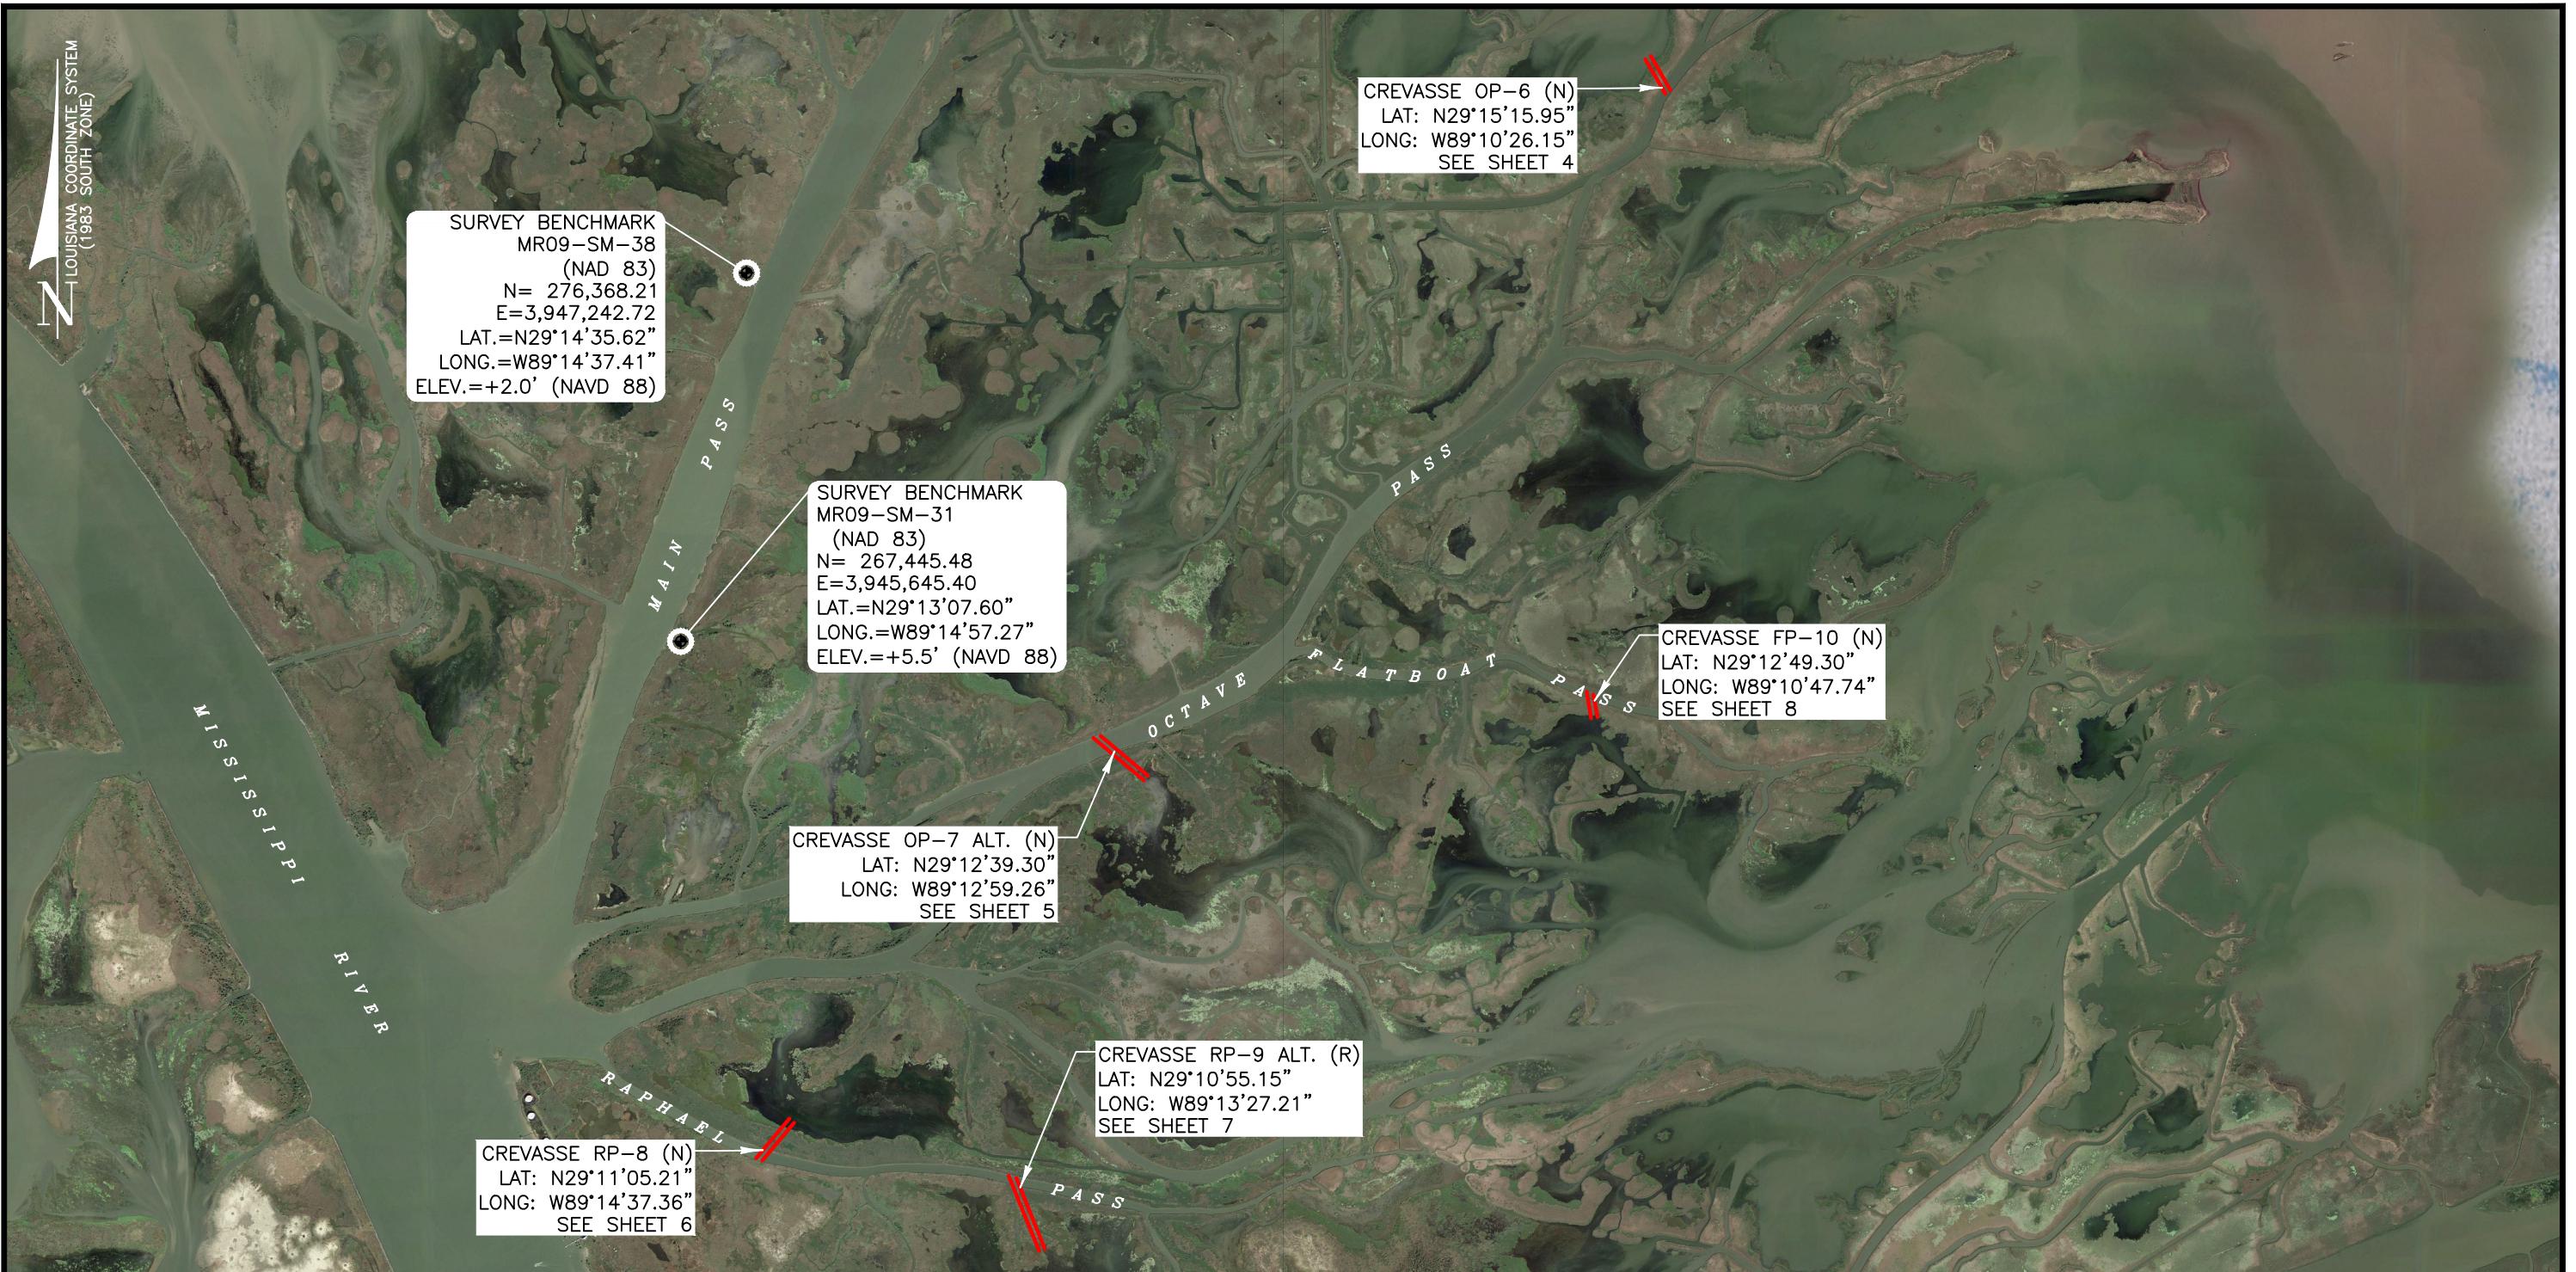

AN ON-THE-GROUND EFFORT WAS MADE TO LOCATE AND INDICATE ALL BELOW GROUND FERROUS METAL CABLES, PIPELINES AND UTILITIES IN THE AREAS DESCRIBED ABOVE; HOWEVER, DUE TO THE INHERENT LIMITATIONS OF ELECTRONIC MAGNETIC LOCATING EQUIPMENT, MORRIS P. HEBERT, INC. IS NOT RESPONSIBLE FOR ANY CABLES, PIPELINES, UTILITIES OR ANY OTHER BELOW GROUND STRUCTURES (INCLUDING PVC) NOT LOCATED DURING THE COURSE OF THE SURVEY. MPH'S EFFORTS DO NOT RELIEVE THE LA ONE CALL RESPONSIBILITY PRIOR TO MOBILIZATION OF EQUIPMENT AND OR EXCAVATION.

#### GRAPHIC SCALE

0 2000' 4000' 8000'

©2019 Google LLC, used with permission. Google and the Google logo are registered trademarks of Google LLC  
(Imagery Date: 11/20/16)

IMAGERY OBTAINED FROM GOOGLE EARTH PRO USING PLEX.EARTH AND WAS NOT MODIFIED OR ALTERED BY MORRIS P. HEBERT, INC., OTHER THAN TO IMPROVE VISIBILITY. MORRIS P. HEBERT, INC. MAKES NO WARRANTIES OR REPRESENTATIONS AS TO THE ACCURACY OF THE IMAGERY, AND RELIANCE ON THE ACCURACY OF THE IMAGES IS AT THE USER'S RISK.




#### OFFICE OF COASTAL PROTECTION RESTORATION AUTHORITY OF LOUISIANA

VICINITY MAP - CREVASSES OP-6 (N), OP-7 ALT. (N), RP-8 (N), RP-9 ALT. (R), & FP-10 (N)  
DELTA WIDE CREVASSES SURVEYING SERVICES

MR-0009

PLAQUEMINES PARISH, LOUISIANA

|                 |                         |         |            |
|-----------------|-------------------------|---------|------------|
| DRAWN BY:       | TJW & TPC               | SHEET:  | 2 OF 16    |
| CHKD./APPD. BY: | JCM                     | SCALE:  | 1" = 4000' |
| UPDATED BY:     |                         | DATE:   | 08/28/2019 |
| DATA BASE:      | 13000-04                | JOB NO. | 13000-04   |
| MPH CAD FILE:   | 13000-04-TRANS002A0.DWG |         |            |

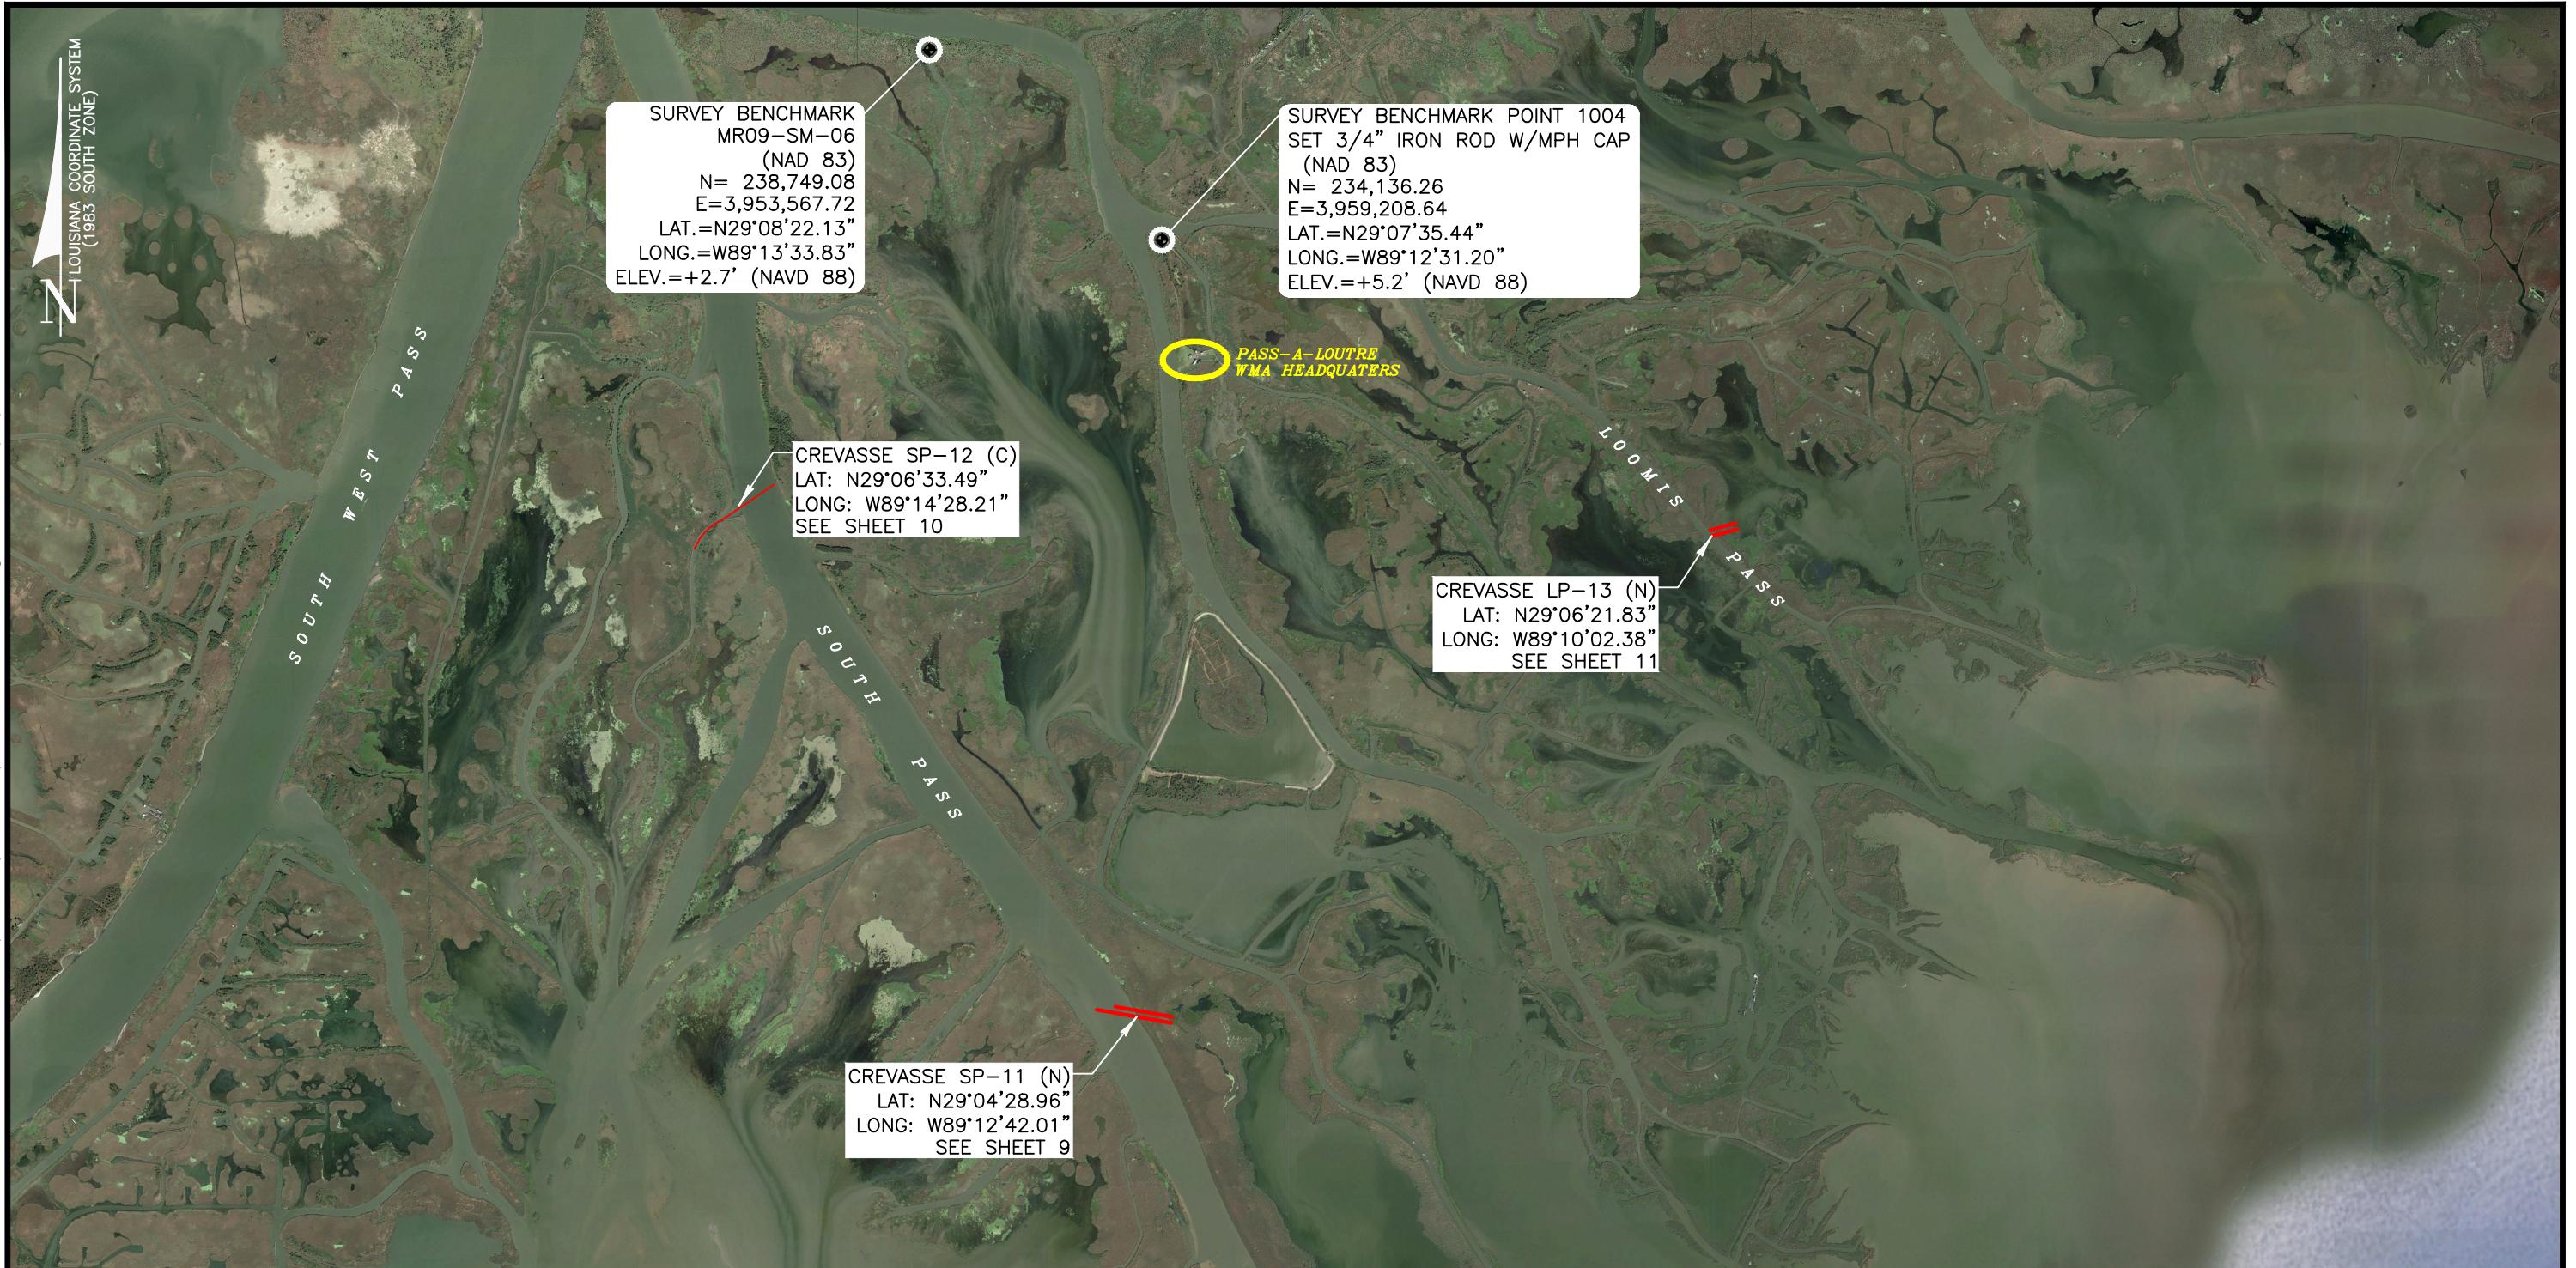

AN ON-THE-GROUND EFFORT WAS MADE TO LOCATE AND INDICATE ALL BELOW GROUND FERROUS METAL CABLES, PIPELINES AND UTILITIES IN THE AREAS DESCRIBED ABOVE; HOWEVER, DUE TO THE INHERENT LIMITATIONS OF ELECTRONIC MAGNETIC LOCATING EQUIPMENT, MORRIS P. HEBERT, INC. IS NOT RESPONSIBLE FOR ANY CABLES, PIPELINES, UTILITIES OR ANY OTHER BELOW GROUND STRUCTURES (INCLUDING PVC) NOT LOCATED DURING THE COURSE OF THE SURVEY. MPH'S EFFORTS DO NOT RELIEVE THE LA ONE CALL RESPONSIBILITY PRIOR TO MOBILIZATION OF EQUIPMENT AND OR EXCAVATION.

GRAPHIC SCALE  
0 2000' 4000' 8000'

©2019 Google LLC, used with permission. Google and the Google logo are registered trademarks of Google LLC  
(Imagery Date: 11/20/16)

IMAGERY OBTAINED FROM GOOGLE EARTH PRO USING PLEX.EARTH AND WAS NOT MODIFIED OR ALTERED BY MORRIS P. HEBERT, INC., OTHER THAN TO IMPROVE VISIBILITY. MORRIS P. HEBERT, INC. MAKES NO WARRANTIES OR REPRESENTATIONS AS TO THE ACCURACY OF THE IMAGERY, AND RELIANCE ON THE ACCURACY OF THE IMAGES IS AT THE USER'S RISK.



## OFFICE OF COASTAL PROTECTION RESTORATION AUTHORITY OF LOUISIANA

VICINITY MAP - CREVASSES SP-11 (N), SP-12 (C), & LP-13 (N)  
DELTA WIDE CREVASSES SURVEYING SERVICES

MR-0009

PLAQUEMINES PARISH, LOUISIANA

|                 |                         |         |            |
|-----------------|-------------------------|---------|------------|
| DRAWN BY:       | TJW & TPC               | SHEET:  | 3 OF 16    |
| CHKD./APPD. BY: | JCM                     | SCALE:  | 1" = 4000' |
| UPDATED BY:     |                         | DATE:   | 08/28/2019 |
| DATA BASE:      | 13000-04                | JOB NO. | 13000-04   |
| MPH CAD FILE:   | 13000-04-TRANS003A0.DWG |         |            |



CREVASSE OP-6 (N) TRANSECTS 1 & 2 LOCATED ON SHEET 12

MAGNETOMETER NOTE: There were no magnetic anomalies at this crevasse location that were above 100 gammas found by the MPH survey dated August 27, 2019.

AN ON-THE-GROUND EFFORT WAS MADE TO LOCATE AND INDICATE ALL BELOW GROUND FERROUS METAL CABLES, PIPELINES AND UTILITIES IN THE AREAS DESCRIBED ABOVE; HOWEVER, DUE TO THE INHERENT LIMITATIONS OF ELECTRONIC MAGNETIC LOCATING EQUIPMENT, MORRIS P. HEBERT, INC. IS NOT RESPONSIBLE FOR ANY CABLES, PIPELINES, UTILITIES OR ANY OTHER BELOW GROUND STRUCTURES (INCLUDING PVC) NOT LOCATED DURING THE COURSE OF THE SURVEY. MPH'S EFFORTS DO NOT RELIEVE THE LA ONE CALL RESPONSIBILITY PRIOR TO MOBILIZATION OF EQUIPMENT AND OR EXCAVATION.



©2019 Google LLC, used with permission. Google and the Google logo are registered trademarks of Google LLC  
(Imagery Date: 11/20/16)


IMAGERY OBTAINED FROM GOOGLE EARTH PRO USING PLEX.EARTH AND WAS NOT MODIFIED OR ALTERED BY MORRIS P. HEBERT, INC., OTHER THAN TO IMPROVE VISIBILITY. MORRIS P. HEBERT, INC. MAKES NO WARRANTIES OR REPRESENTATIONS AS TO THE ACCURACY OF THE IMAGERY, AND RELIANCE ON THE ACCURACY OF THE IMAGES IS AT THE USER'S RISK.



## OFFICE OF COASTAL PROTECTION RESTORATION AUTHORITY OF LOUISIANA

DELTA WIDE CREVASSES – CREVASSE OP-6 (N) OVERVIEW  
DELTA WIDE CREVASSES SURVEYING SERVICES  
MR-0009  
PLAQUEMINES PARISH, LOUISIANA

|                 |                         |         |            |
|-----------------|-------------------------|---------|------------|
| DRAWN BY:       | TJW & TPC               | SHEET:  | 4 OF 16    |
| CHKD./APPD. BY: | JCM                     | SCALE:  | 1" = 100'  |
| UPDATED BY:     |                         | DATE:   | 08/28/2019 |
| DATA BASE:      | 13000-04                | JOB NO. | 13000-04   |
| MPH CAD FILE:   | 13000-04-TRANS004A0.DWG |         |            |

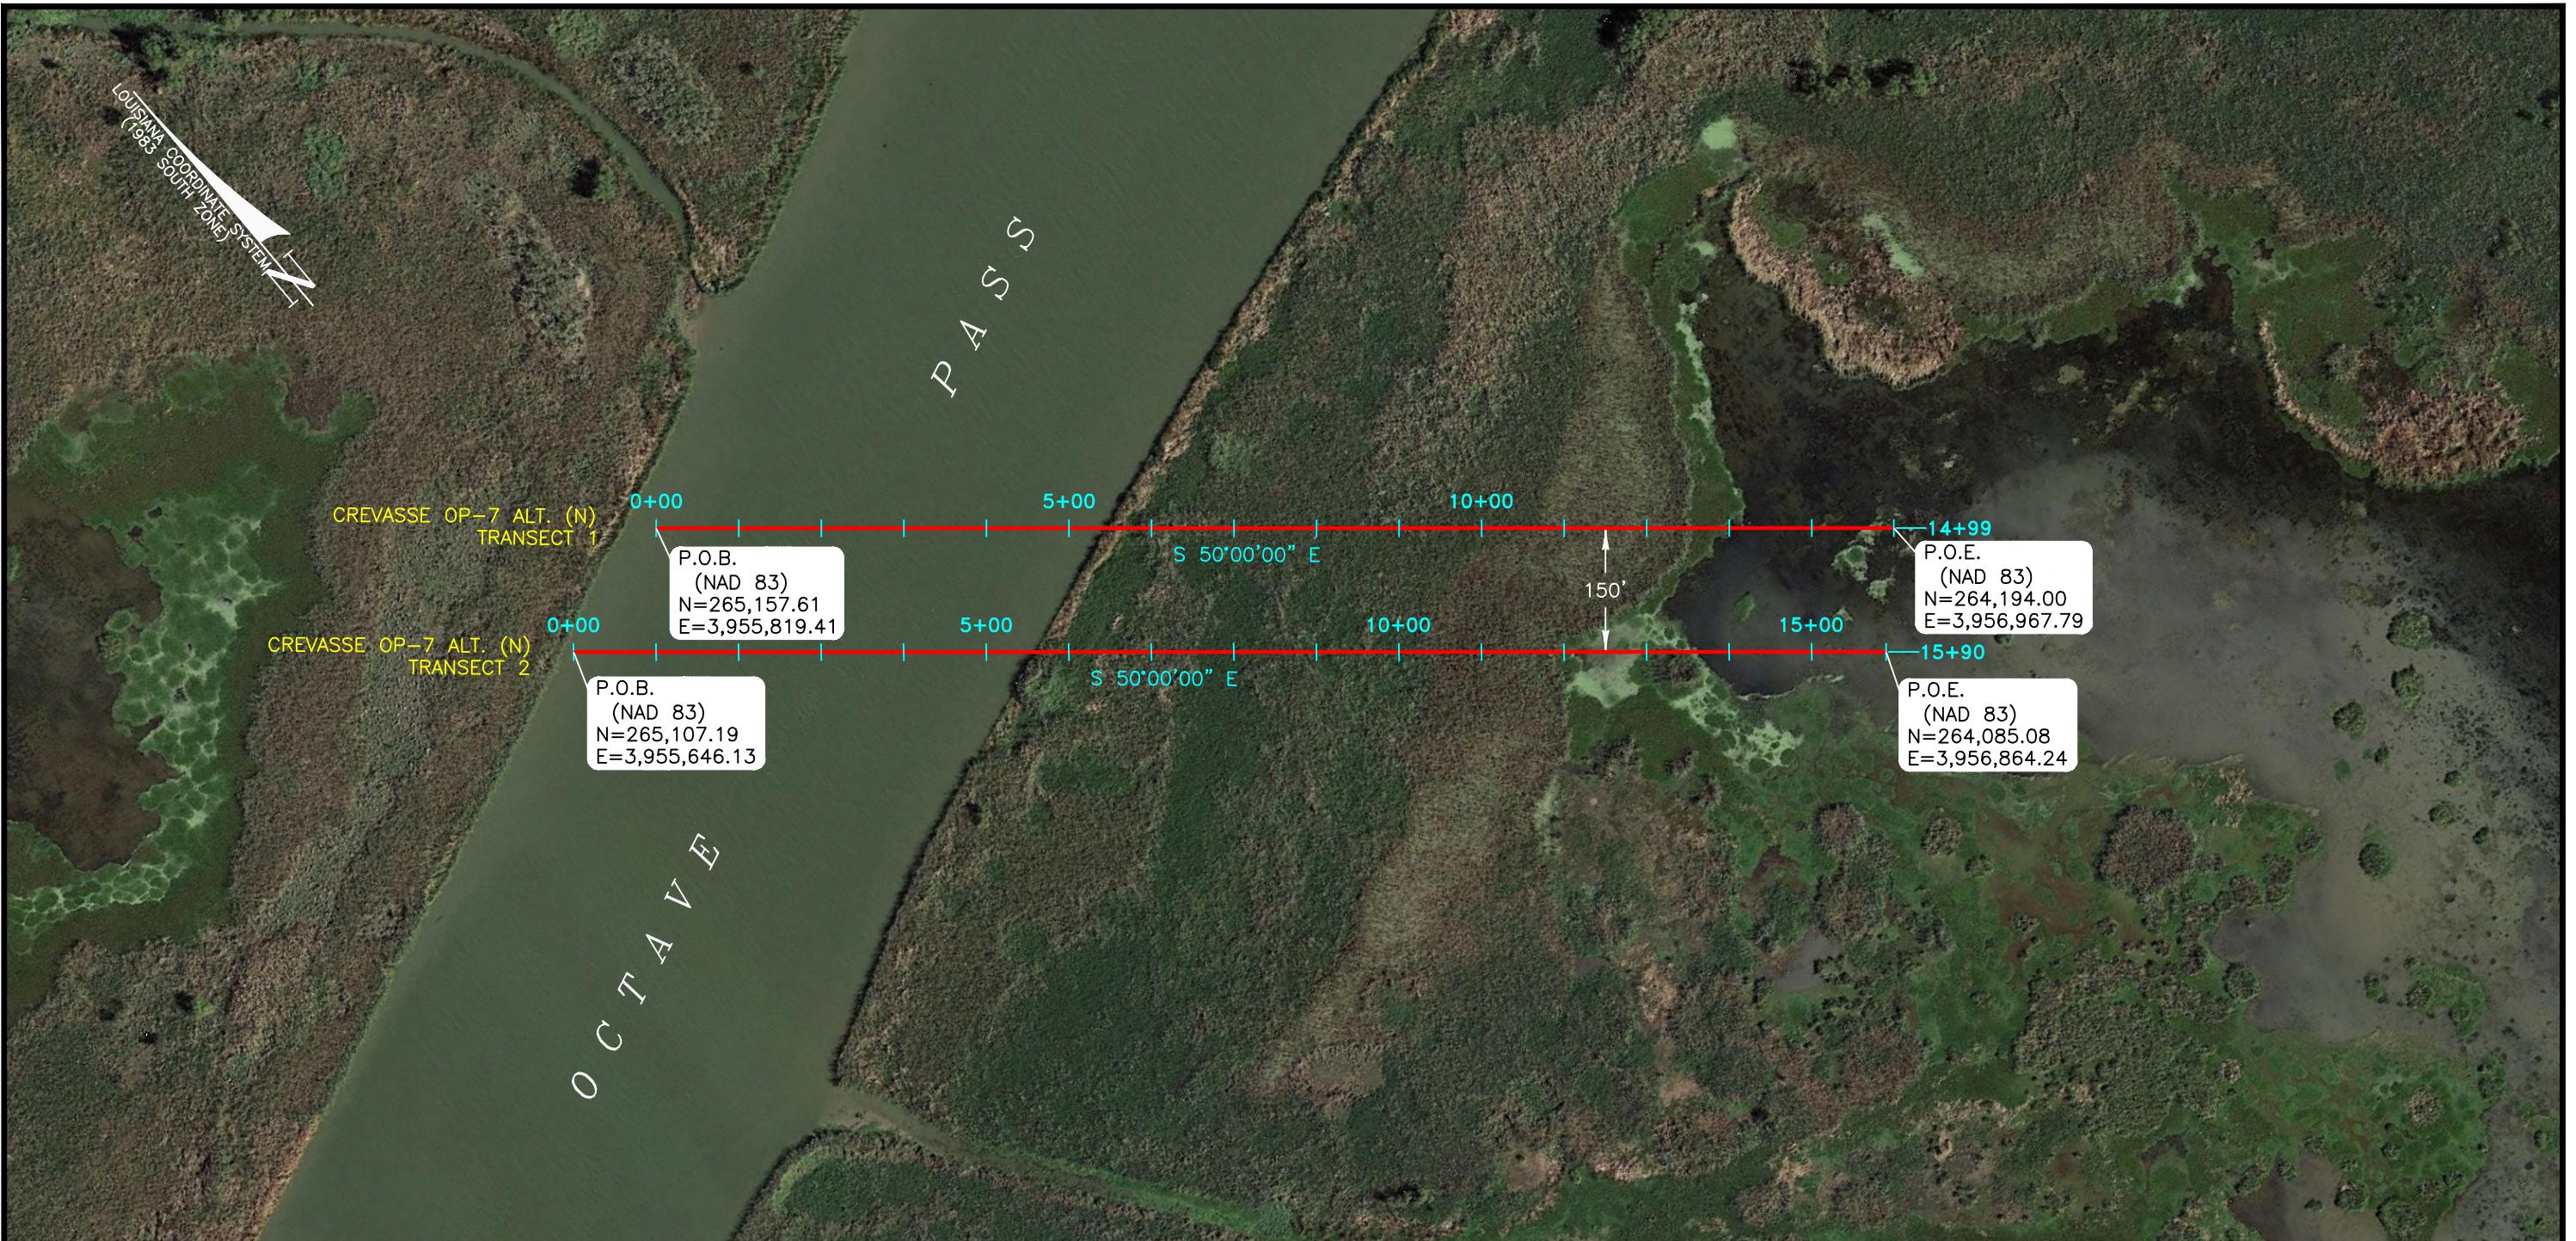

CREVASSSE OP-7 ALT. (N) TRANSECTS 1 & 2 LOCATED ON SHEET 12

MAGNETOMETER NOTE: There were no magnetic anomalies at this crevassse location that were above 100 gammas found by the MPH survey dated August 27, 2019.

AN ON-THE-GROUND EFFORT WILL BE MADE TO LOCATE AND INDICATE ALL BELOW GROUND FERROUS METAL CABLES, PIPELINES AND UTILITIES IN THE AREAS DESCRIBED ABOVE; HOWEVER, DUE TO THE INHERENT LIMITATIONS OF ELECTRONIC MAGNETIC LOCATING EQUIPMENT, MORRIS P. HEBERT, INC. IS NOT RESPONSIBLE FOR ANY CABLES, PIPELINES, UTILITIES OR ANY OTHER BELOW GROUND STRUCTURES (INCLUDING PVC) NOT LOCATED DURING THE COURSE OF THE SURVEY. MPH'S EFFORTS DO NOT RELIEVE THE LA ONE CALL RESPONSIBILITY PRIOR TO MOBILIZATION OF EQUIPMENT AND OR EXCAVATION.



©2019 Google LLC, used with permission. Google and the Google logo are registered trademarks of Google LLC  
(Imagery Date: 11/20/16)


IMAGERY OBTAINED FROM GOOGLE EARTH PRO USING PLEX.EARTH AND WAS NOT MODIFIED OR ALTERED BY MORRIS P. HEBERT, INC., OTHER THAN TO IMPROVE VISIBILITY. MORRIS P. HEBERT, INC. MAKES NO WARRANTIES OR REPRESENTATIONS AS TO THE ACCURACY OF THE IMAGERY, AND RELIANCE ON THE ACCURACY OF THE IMAGES IS AT THE USER'S RISK.




## OFFICE OF COASTAL PROTECTION RESTORATION AUTHORITY OF LOUISIANA

DELTA WIDE CREVASSES – CREVASSSE OP-7 ALT. (N) OVERVIEW  
DELTA WIDE CREVASSES SURVEYING SERVICES  
MR-0009  
PLAQUEMINES PARISH, LOUISIANA

|                 |                         |         |            |
|-----------------|-------------------------|---------|------------|
| DRAWN BY:       | TJW & TPC               | SHEET:  | 5 OF 16    |
| CHKD./APPD. BY: | JCM                     | SCALE:  | 1" = 100'  |
| UPDATED BY:     |                         | DATE:   | 08/28/2019 |
| DATA BASE:      | 13000-04                | JOB NO. | 13000-04   |
| MPH CAD FILE:   | 13000-04-TRANS005A0.DWG |         |            |

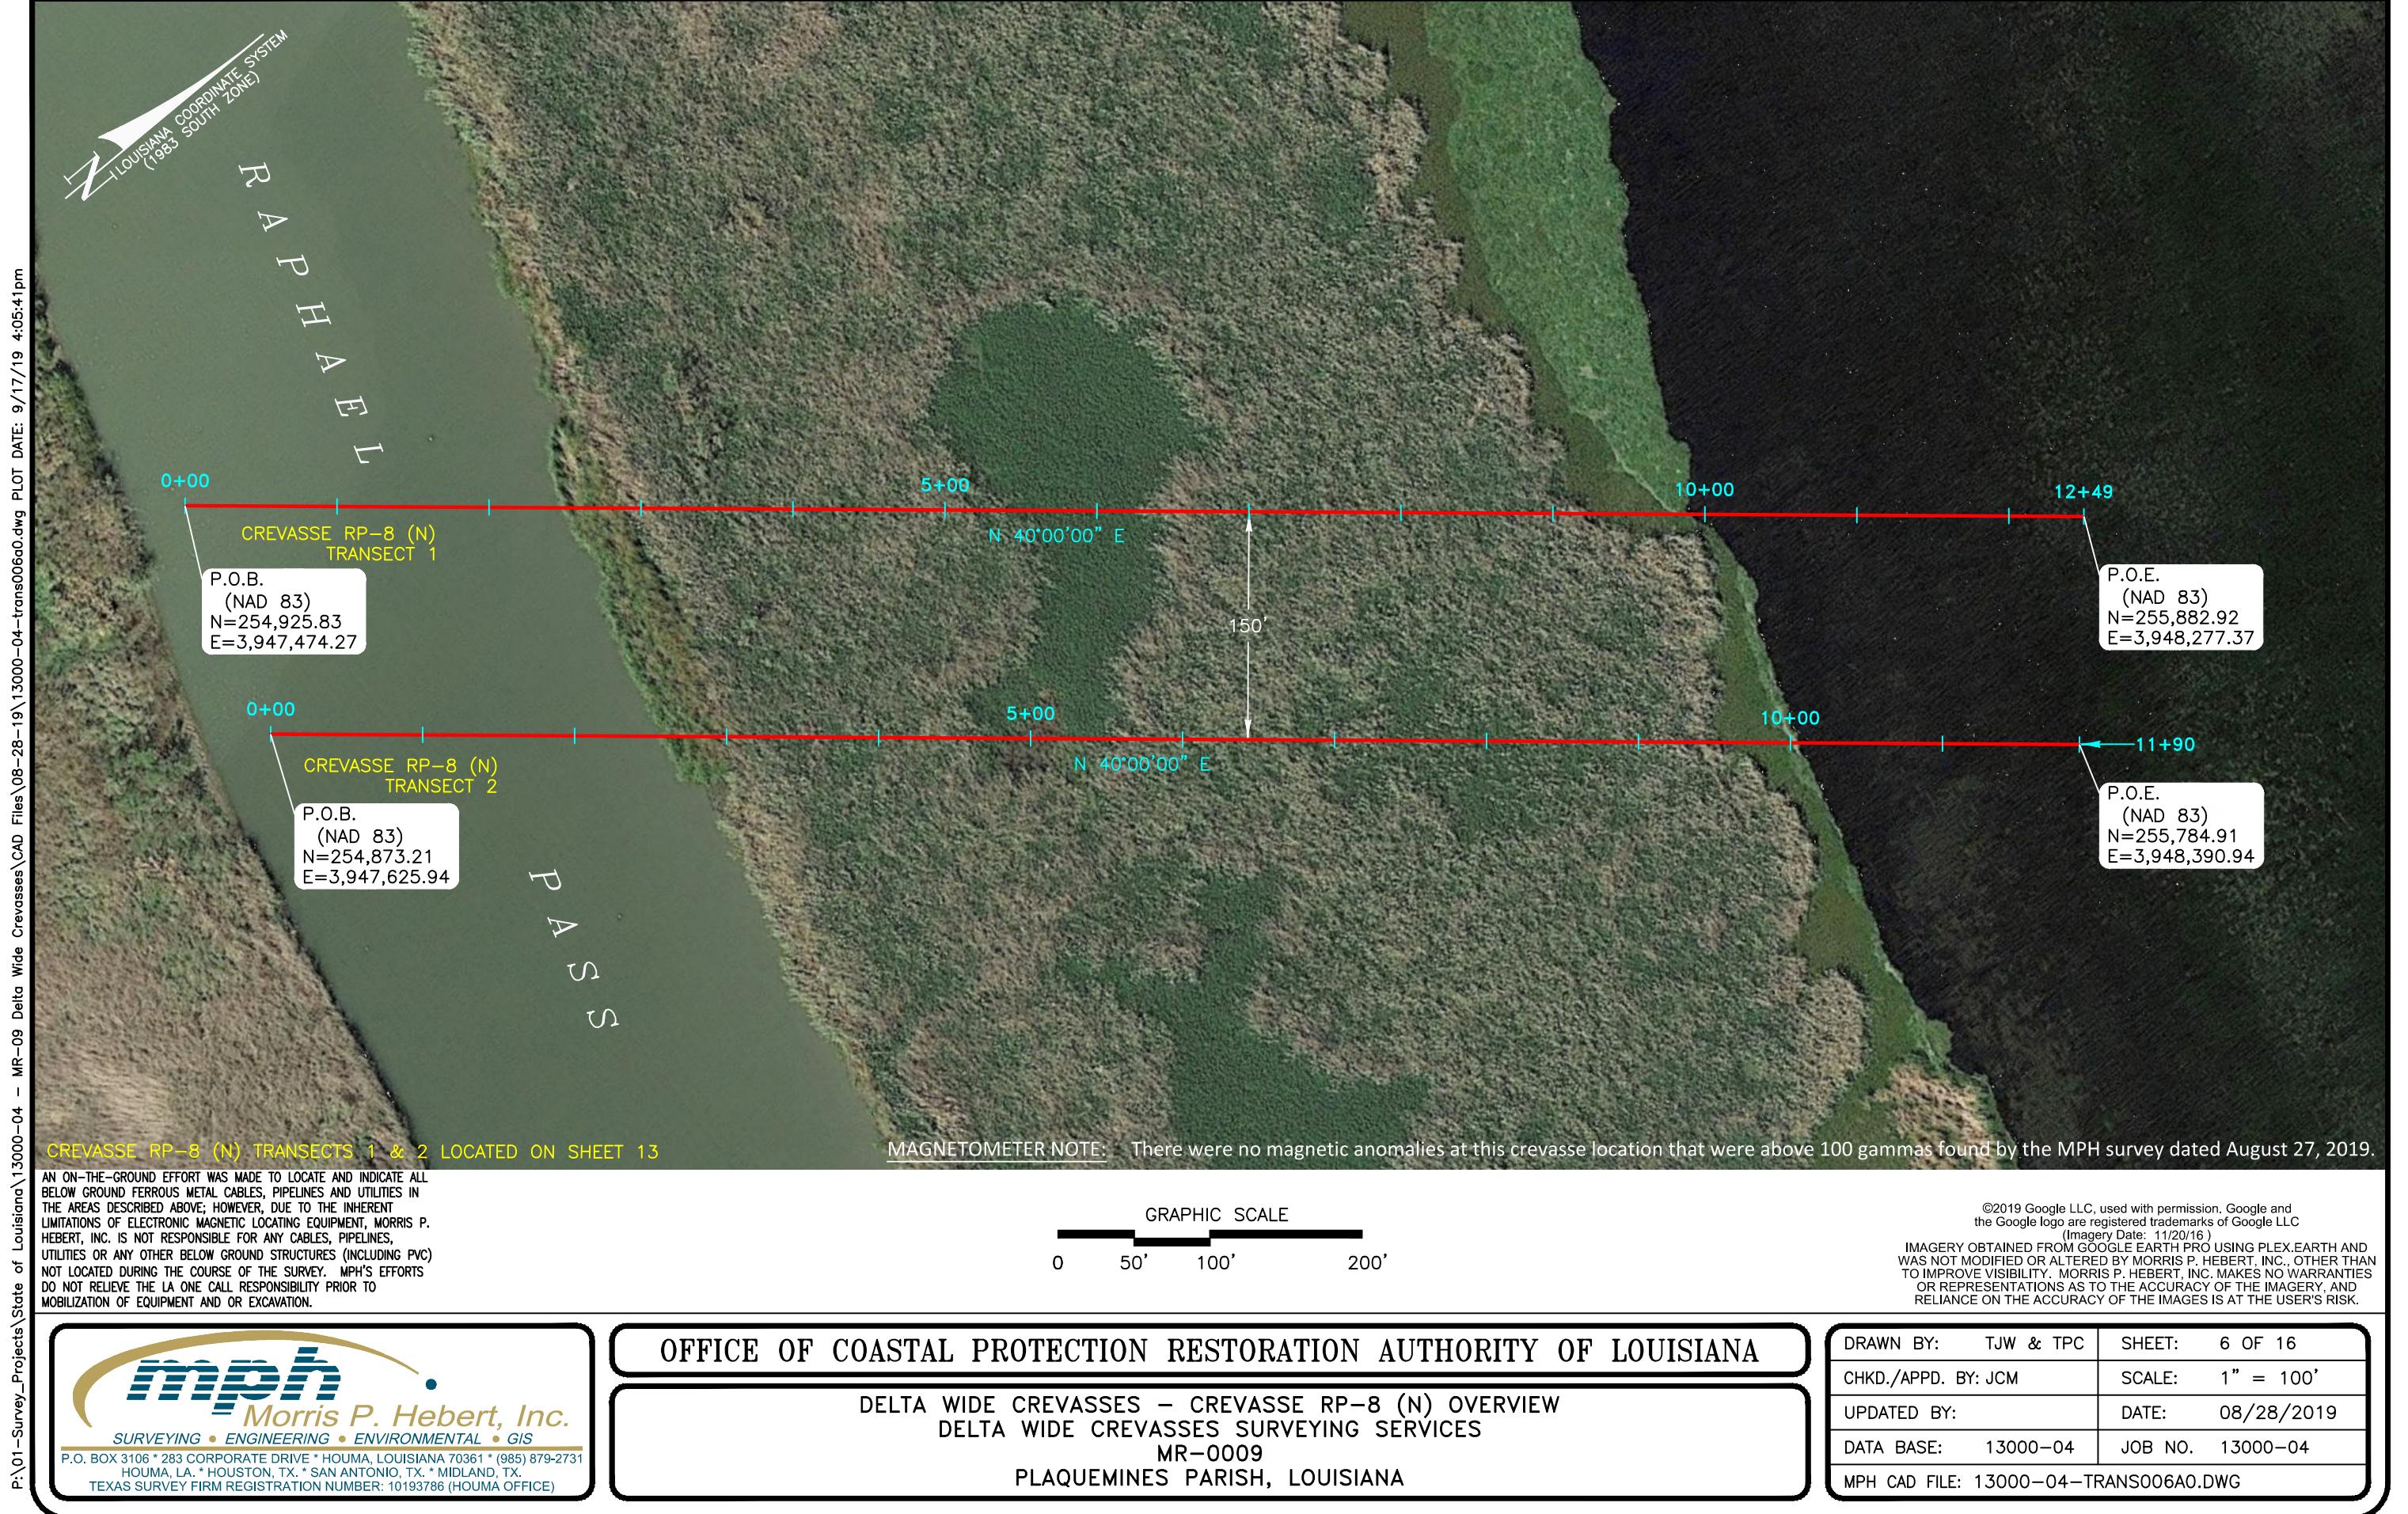

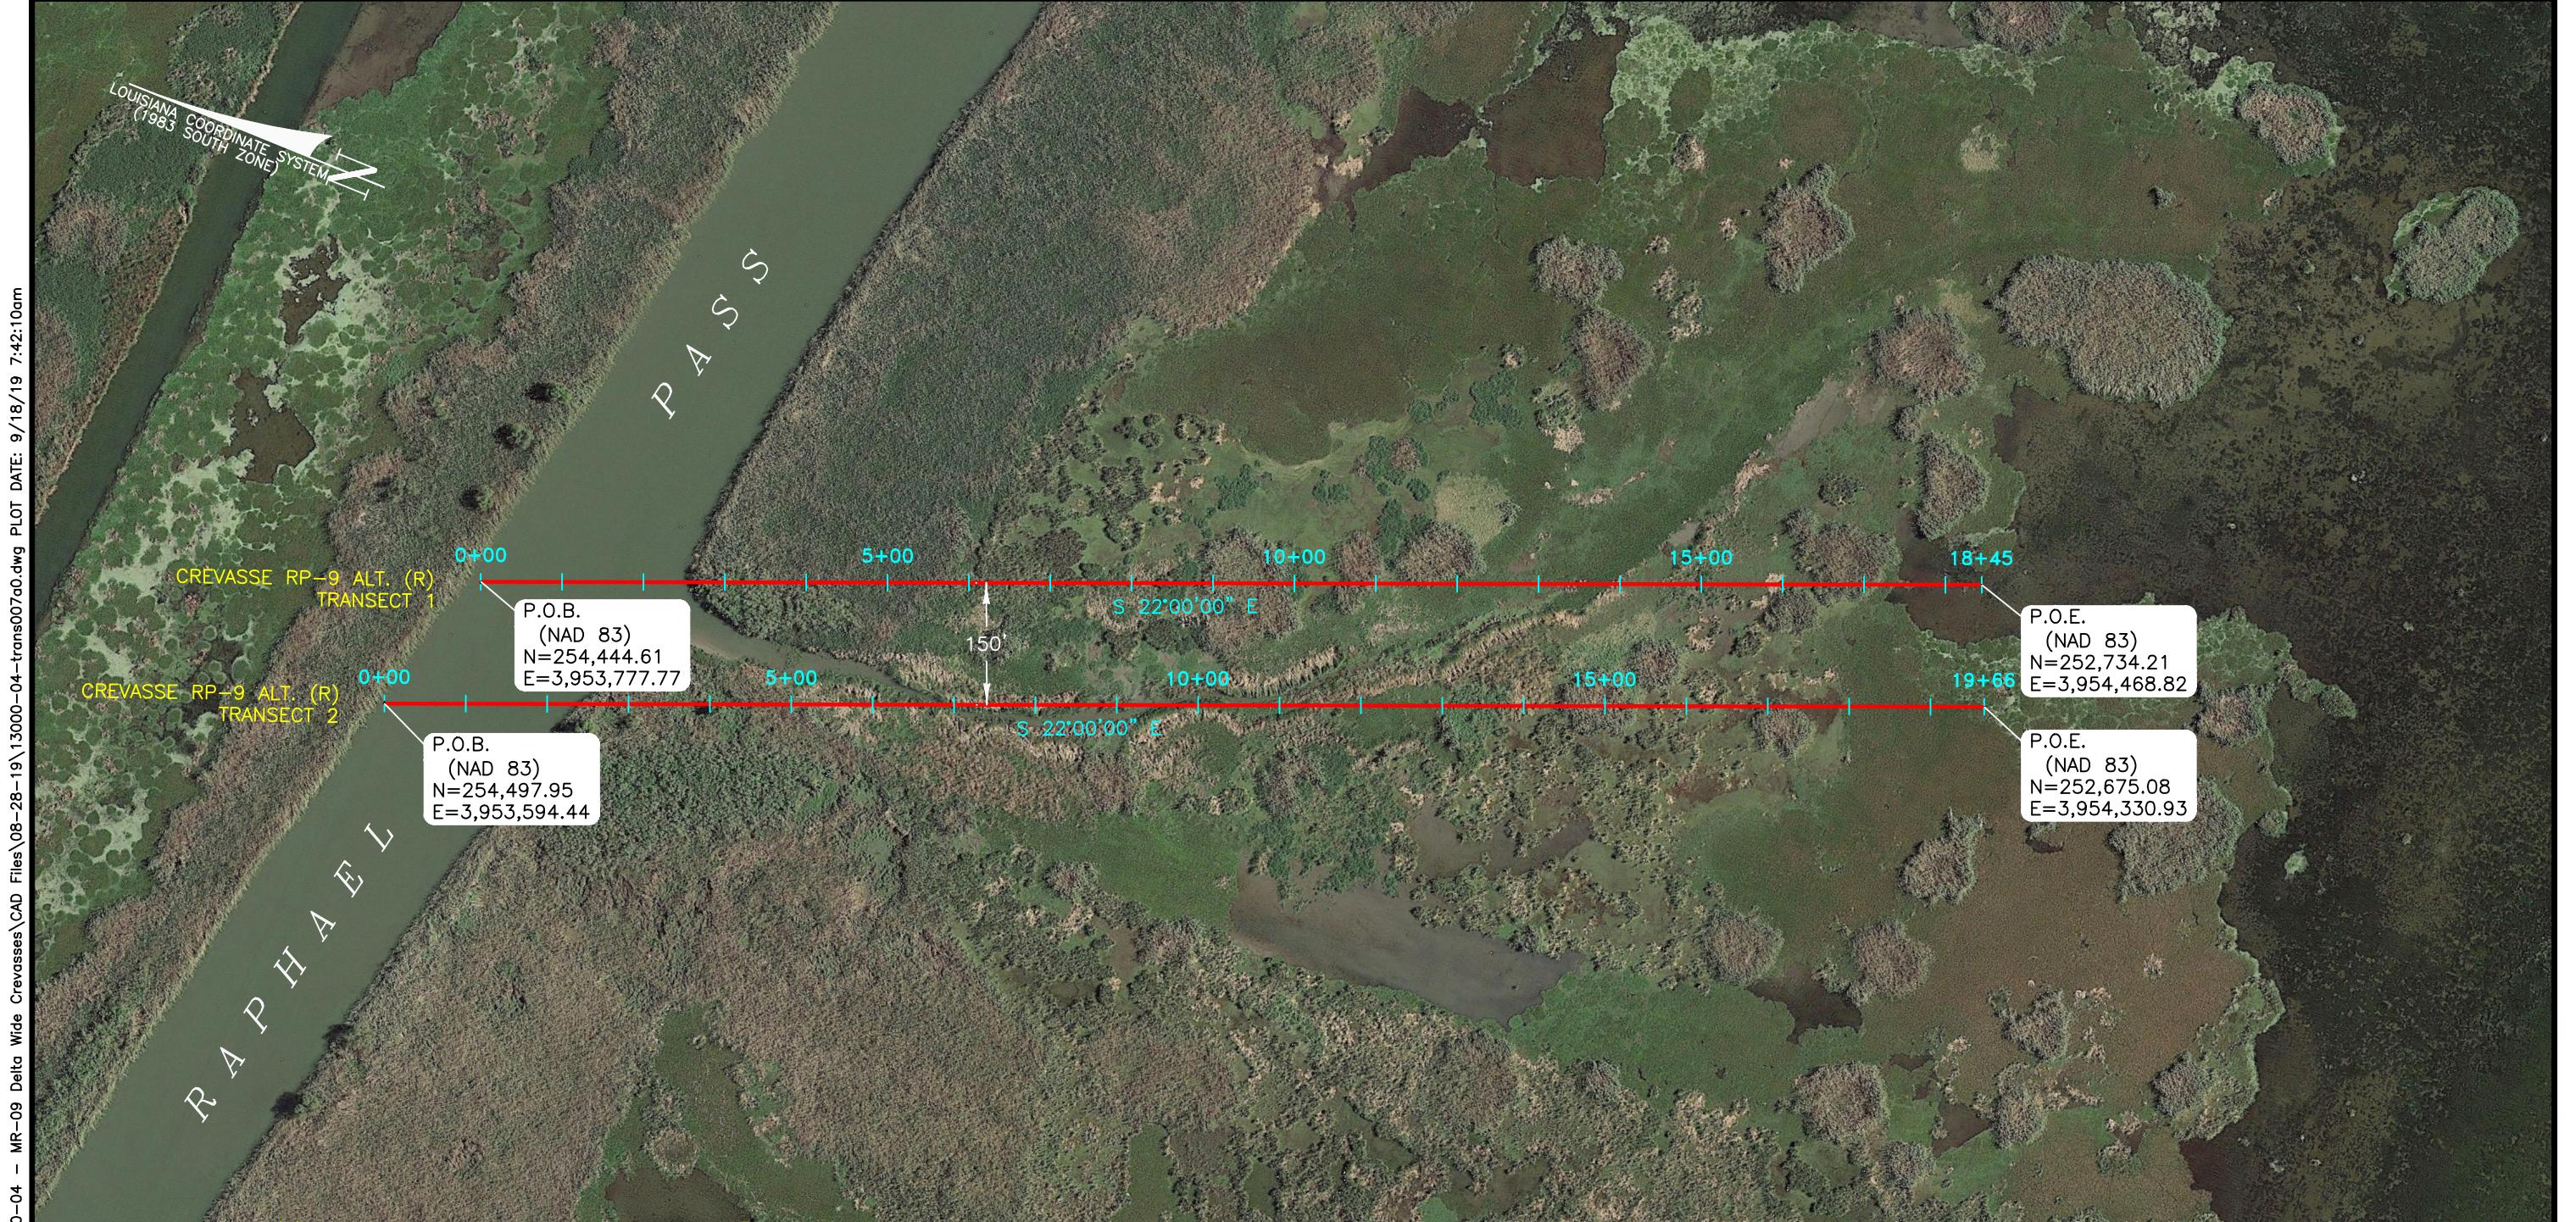

CREVASSSE RP-9 ALT. (R) TRANSECTS 1 & 2 LOCATED ON SHEET 13

MAGNETOMETER NOTE: There were no magnetic anomalies at this crevasse location that were above 100 gammas found by the MPH survey dated August 27, 2019.

AN ON-THE-GROUND EFFORT WAS MADE TO LOCATE AND INDICATE ALL BELOW GROUND FERROUS METAL CABLES, PIPELINES AND UTILITIES IN THE AREAS DESCRIBED ABOVE; HOWEVER, DUE TO THE INHERENT LIMITATIONS OF ELECTRONIC MAGNETIC LOCATING EQUIPMENT, MORRIS P. HEBERT, INC. IS NOT RESPONSIBLE FOR ANY CABLES, PIPELINES, UTILITIES OR ANY OTHER BELOW GROUND STRUCTURES (INCLUDING PVC) NOT LOCATED DURING THE COURSE OF THE SURVEY. MPH'S EFFORTS DO NOT RELIEVE THE LA ONE CALL RESPONSIBILITY PRIOR TO MOBILIZATION OF EQUIPMENT AND OR EXCAVATION.

©2019 Google LLC, used with permission. Google and the Google logo are registered trademarks of Google LLC.  
(Imagery Date: 11/20/16)


IMAGERY OBTAINED FROM GOOGLE EARTH PRO USING PLEX.EARTH AND WAS NOT MODIFIED OR ALTERED BY MORRIS P. HEBERT, INC., OTHER THAN TO IMPROVE VISIBILITY. MORRIS P. HEBERT, INC. MAKES NO WARRANTIES OR REPRESENTATIONS AS TO THE ACCURACY OF THE IMAGERY, AND RELIANCE ON THE ACCURACY OF THE IMAGES IS AT THE USER'S RISK.




## OFFICE OF COASTAL PROTECTION RESTORATION AUTHORITY OF LOUISIANA

DELTA WIDE CREVASSES – CREVASSSE RP-9 ALT. (R) OVERVIEW  
DELTA WIDE CREVASSES SURVEYING SERVICES  
MR-0009  
PLAQUEMINES PARISH, LOUISIANA

|                 |                         |         |            |
|-----------------|-------------------------|---------|------------|
| DRAWN BY:       | TJW & TPC               | SHEET:  | 7 OF 16    |
| CHKD./APPD. BY: | JCM                     | SCALE:  | 1" = 200'  |
| UPDATED BY:     |                         | DATE:   | 08/28/2019 |
| DATA BASE:      | 13000-04                | JOB NO. | 13000-04   |
| MPH CAD FILE:   | 13000-04-TRANS007A0.DWG |         |            |

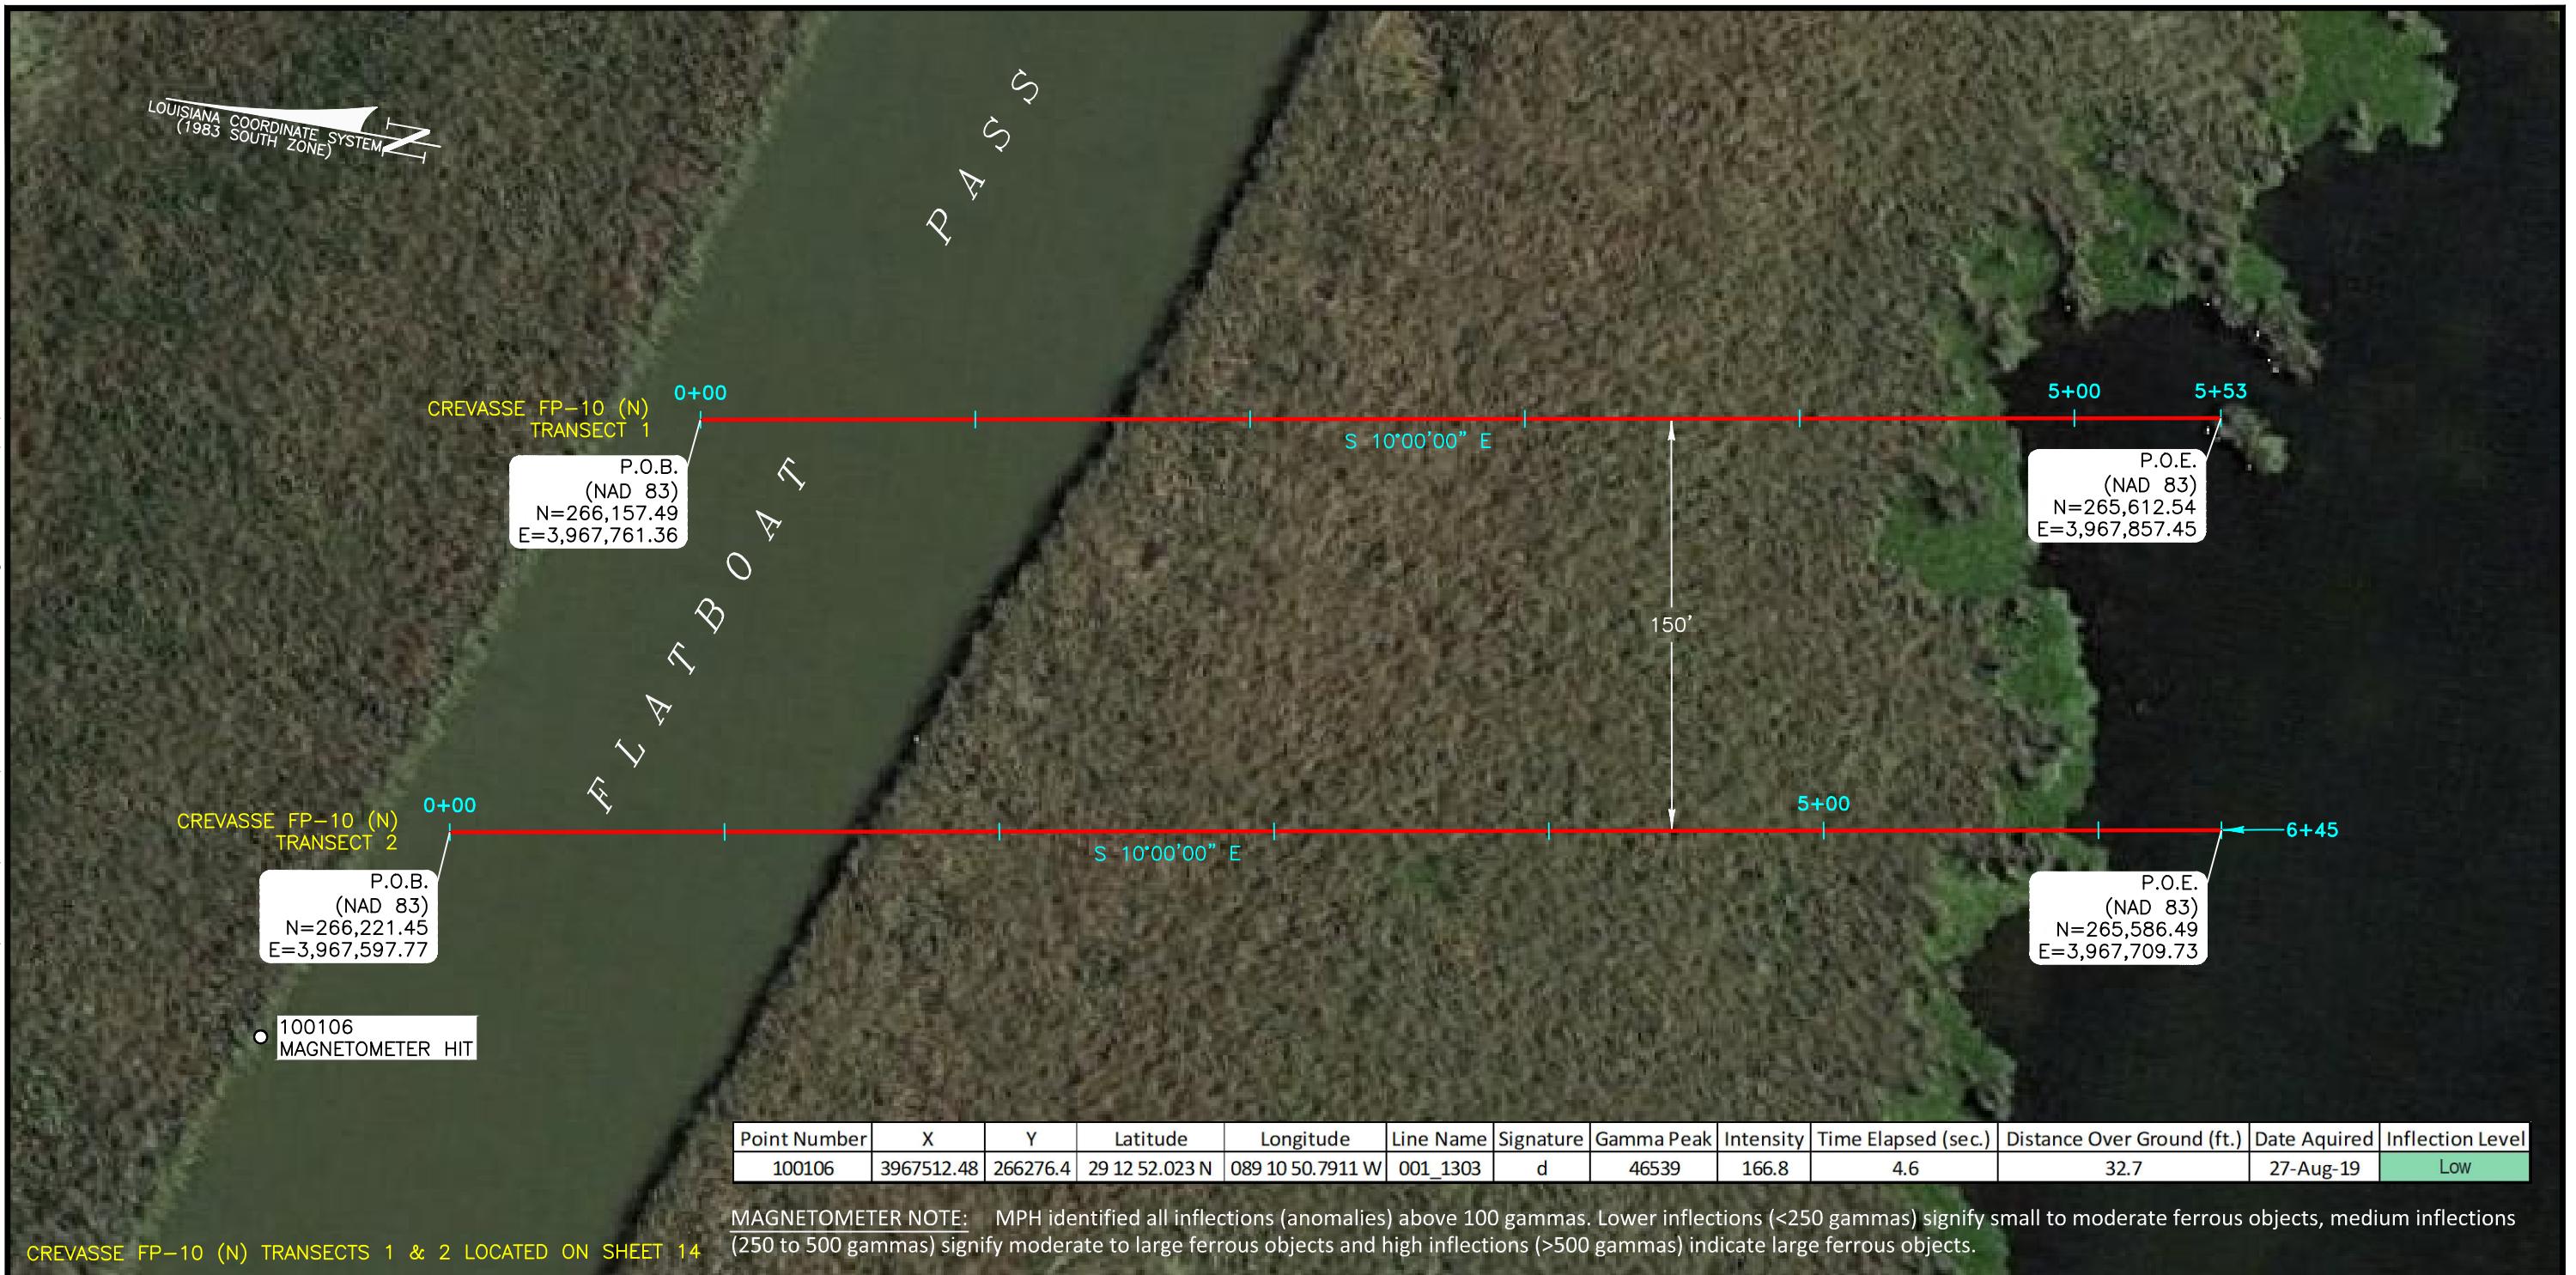

AN ON-THE-GROUND EFFORT WAS MADE TO LOCATE AND INDICATE ALL BELOW GROUND FERROUS METAL CABLES, PIPELINES AND UTILITIES IN THE AREAS DESCRIBED ABOVE; HOWEVER, DUE TO THE INHERENT LIMITATIONS OF ELECTRONIC MAGNETIC LOCATING EQUIPMENT, MORRIS P. HEBERT, INC. IS NOT RESPONSIBLE FOR ANY CABLES, PIPELINES, UTILITIES OR ANY OTHER BELOW GROUND STRUCTURES (INCLUDING PVC) NOT LOCATED DURING THE COURSE OF THE SURVEY. MPH'S EFFORTS DO NOT RELIEVE THE LA ONE CALL RESPONSIBILITY PRIOR TO MOBILIZATION OF EQUIPMENT AND OR EXCAVATION.

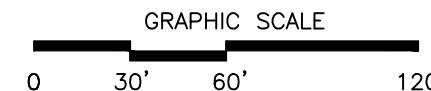

©2019 Google LLC, used with permission. Google and the Google logo are registered trademarks of Google LLC.  
(Imagery Date: 11/20/16)

IMAGERY OBTAINED FROM GOOGLE EARTH PRO USING PLEX.EARTH AND WAS NOT MODIFIED OR ALTERED BY MORRIS P. HEBERT, INC. OTHER THAN TO IMPROVE VISIBILITY. MORRIS P. HEBERT, INC. MAKES NO WARRANTIES OR REPRESENTATIONS AS TO THE ACCURACY OF THE IMAGERY, AND RELIANCE ON THE ACCURACY OF THE IMAGES IS AT THE USER'S RISK.



## OFFICE OF COASTAL PROTECTION RESTORATION AUTHORITY OF LOUISIANA

DELTA WIDE CREVASSES – CREVASSÉ FP-10 (N) OVERVIEW  
DELTA WIDE CREVASSES SURVEYING SERVICES  
MR-0009  
PLAQUEMINES PARISH, LOUISIANA

|                 |                         |         |            |
|-----------------|-------------------------|---------|------------|
| DRAWN BY:       | TJW & TPC               | SHEET:  | 8 OF 16    |
| CHKD./APPD. BY: | JCM                     | SCALE:  | 1" = 60'   |
| UPDATED BY:     |                         | DATE:   | 08/28/2019 |
| DATA BASE:      | 13000-04                | JOB NO. | 13000-04   |
| MPH CAD FILE:   | 13000-04-TRANS008A0.DWG |         |            |

LOUISIANA COORDINATE SYSTEM  
(NAD 83)

S O U T H

100102  
MAGNETOMETER HIT

CREVASSE SP-11 (N)  
TRANSECT 1

P.O.B.  
(NAD 83)  
N=215,455.54  
E=3,957,627.74

CREVASSE SP-11 (N)  
TRANSECT 2

P.O.B.  
(NAD 83)  
N=215,527.21  
E=3,958,085.05

0+00  
S 80°00'00" E

5+00  
100101  
MAGNETOMETER HIT

10+00

10+00  
100100  
MAGNETOMETER HIT

15+00

13+98  
P.O.E.  
(NAD 83)  
N=215,284.39  
E=3,959,462.18

18+36  
P.O.E.  
(NAD 83)  
N=215,136.67  
E=3,959,436.13

P  
A  
S  
S

| Point Number | X          | Y         | Latitude        | Longitude        | Line Name | Signature | Gamma Peak | Intensity | Time Elapsed (sec.) | Distance Over Ground (ft.) | Date Aquired | Inflection Level |
|--------------|------------|-----------|-----------------|------------------|-----------|-----------|------------|-----------|---------------------|----------------------------|--------------|------------------|
| 100100       | 3959289.48 | 215291.25 | 29 04 28.9025 N | 089 12 34.2296 W | 002_0936  | m-        | 46730      | 316.1     | 8.7                 | 65.8                       | 27-Aug-19    | Medium           |
| 100101       | 3958707.65 | 215416.8  | 29 04 30.2518 N | 089 12 40.7587 W | 002_0936  | m+        | 46426      | 100       | 2.8                 | 26.5                       | 27-Aug-19    | Low              |
| 100102       | 3957459.67 | 215646.42 | 29 04 32.7531 N | 089 12 54.7717 W | 001A1001  | m+        | 46396      | 254.1     | 17.9                | 147.6                      | 27-Aug-19    | Medium           |

MAGNETOMETER NOTE: MPH identified all inflections (anomalies) above 100 gammas. Lower inflections (<250 gammas) signify small to moderate ferrous objects, medium inflections (250 to 500 gammas) signify moderate to large ferrous objects and high inflections (>500 gammas) indicate large ferrous objects.

CREVASSE SP-11 (N) TRANSECTS 1 & 2 LOCATED ON SHEET 14

AN ON-THE-GROUND EFFORT WAS MADE TO LOCATE AND INDICATE ALL BELOW GROUND FERROUS METAL CABLES, PIPELINES AND UTILITIES IN THE AREAS DESCRIBED ABOVE; HOWEVER, DUE TO THE INHERENT LIMITATIONS OF ELECTRONIC MAGNETIC LOCATING EQUIPMENT, MORRIS P. HEBERT, INC. IS NOT RESPONSIBLE FOR ANY CABLES, PIPELINES, UTILITIES OR ANY OTHER BELOW GROUND STRUCTURES (INCLUDING PVC) NOT LOCATED DURING THE COURSE OF THE SURVEY. MPH'S EFFORTS DO NOT RELIEVE THE LA ONE CALL RESPONSIBILITY PRIOR TO MOBILIZATION OF EQUIPMENT AND OR EXCAVATION.

#### GRAPHIC SCALE

0 100' 200' 400'

©2019 Google LLC, used with permission. Google and the Google logo are registered trademarks of Google LLC  
(Imagery Date: 11/20/16)

IMAGERY OBTAINED FROM GOOGLE EARTH PRO USING PLEX.EARTH AND WAS NOT MODIFIED OR ALTERED BY MORRIS P. HEBERT, INC., OTHER THAN TO IMPROVE VISIBILITY. MORRIS P. HEBERT, INC. MAKES NO WARRANTIES OR REPRESENTATIONS AS TO THE ACCURACY OF THE IMAGERY, AND RELIANCE ON THE ACCURACY OF THE IMAGES IS AT THE USER'S RISK.




#### OFFICE OF COASTAL PROTECTION RESTORATION AUTHORITY OF LOUISIANA


DELTA WIDE CREVASSES – CREVASSE SP-11 (N) OVERVIEW  
DELTA WIDE CREVASSES SURVEYING SERVICES

MR-0009

PLAQUEMINES PARISH, LOUISIANA

|                 |                         |         |            |
|-----------------|-------------------------|---------|------------|
| DRAWN BY:       | TJW & TPC               | SHEET:  | 9 OF 16    |
| CHKD./APPD. BY: | JCM                     | SCALE:  | 1" = 200'  |
| UPDATED BY:     |                         | DATE:   | 08/28/2019 |
| DATA BASE:      | 13000-04                | JOB NO. | 13000-04   |
| MPH CAD FILE:   | 13000-04-TRANS009A0.DWG |         |            |

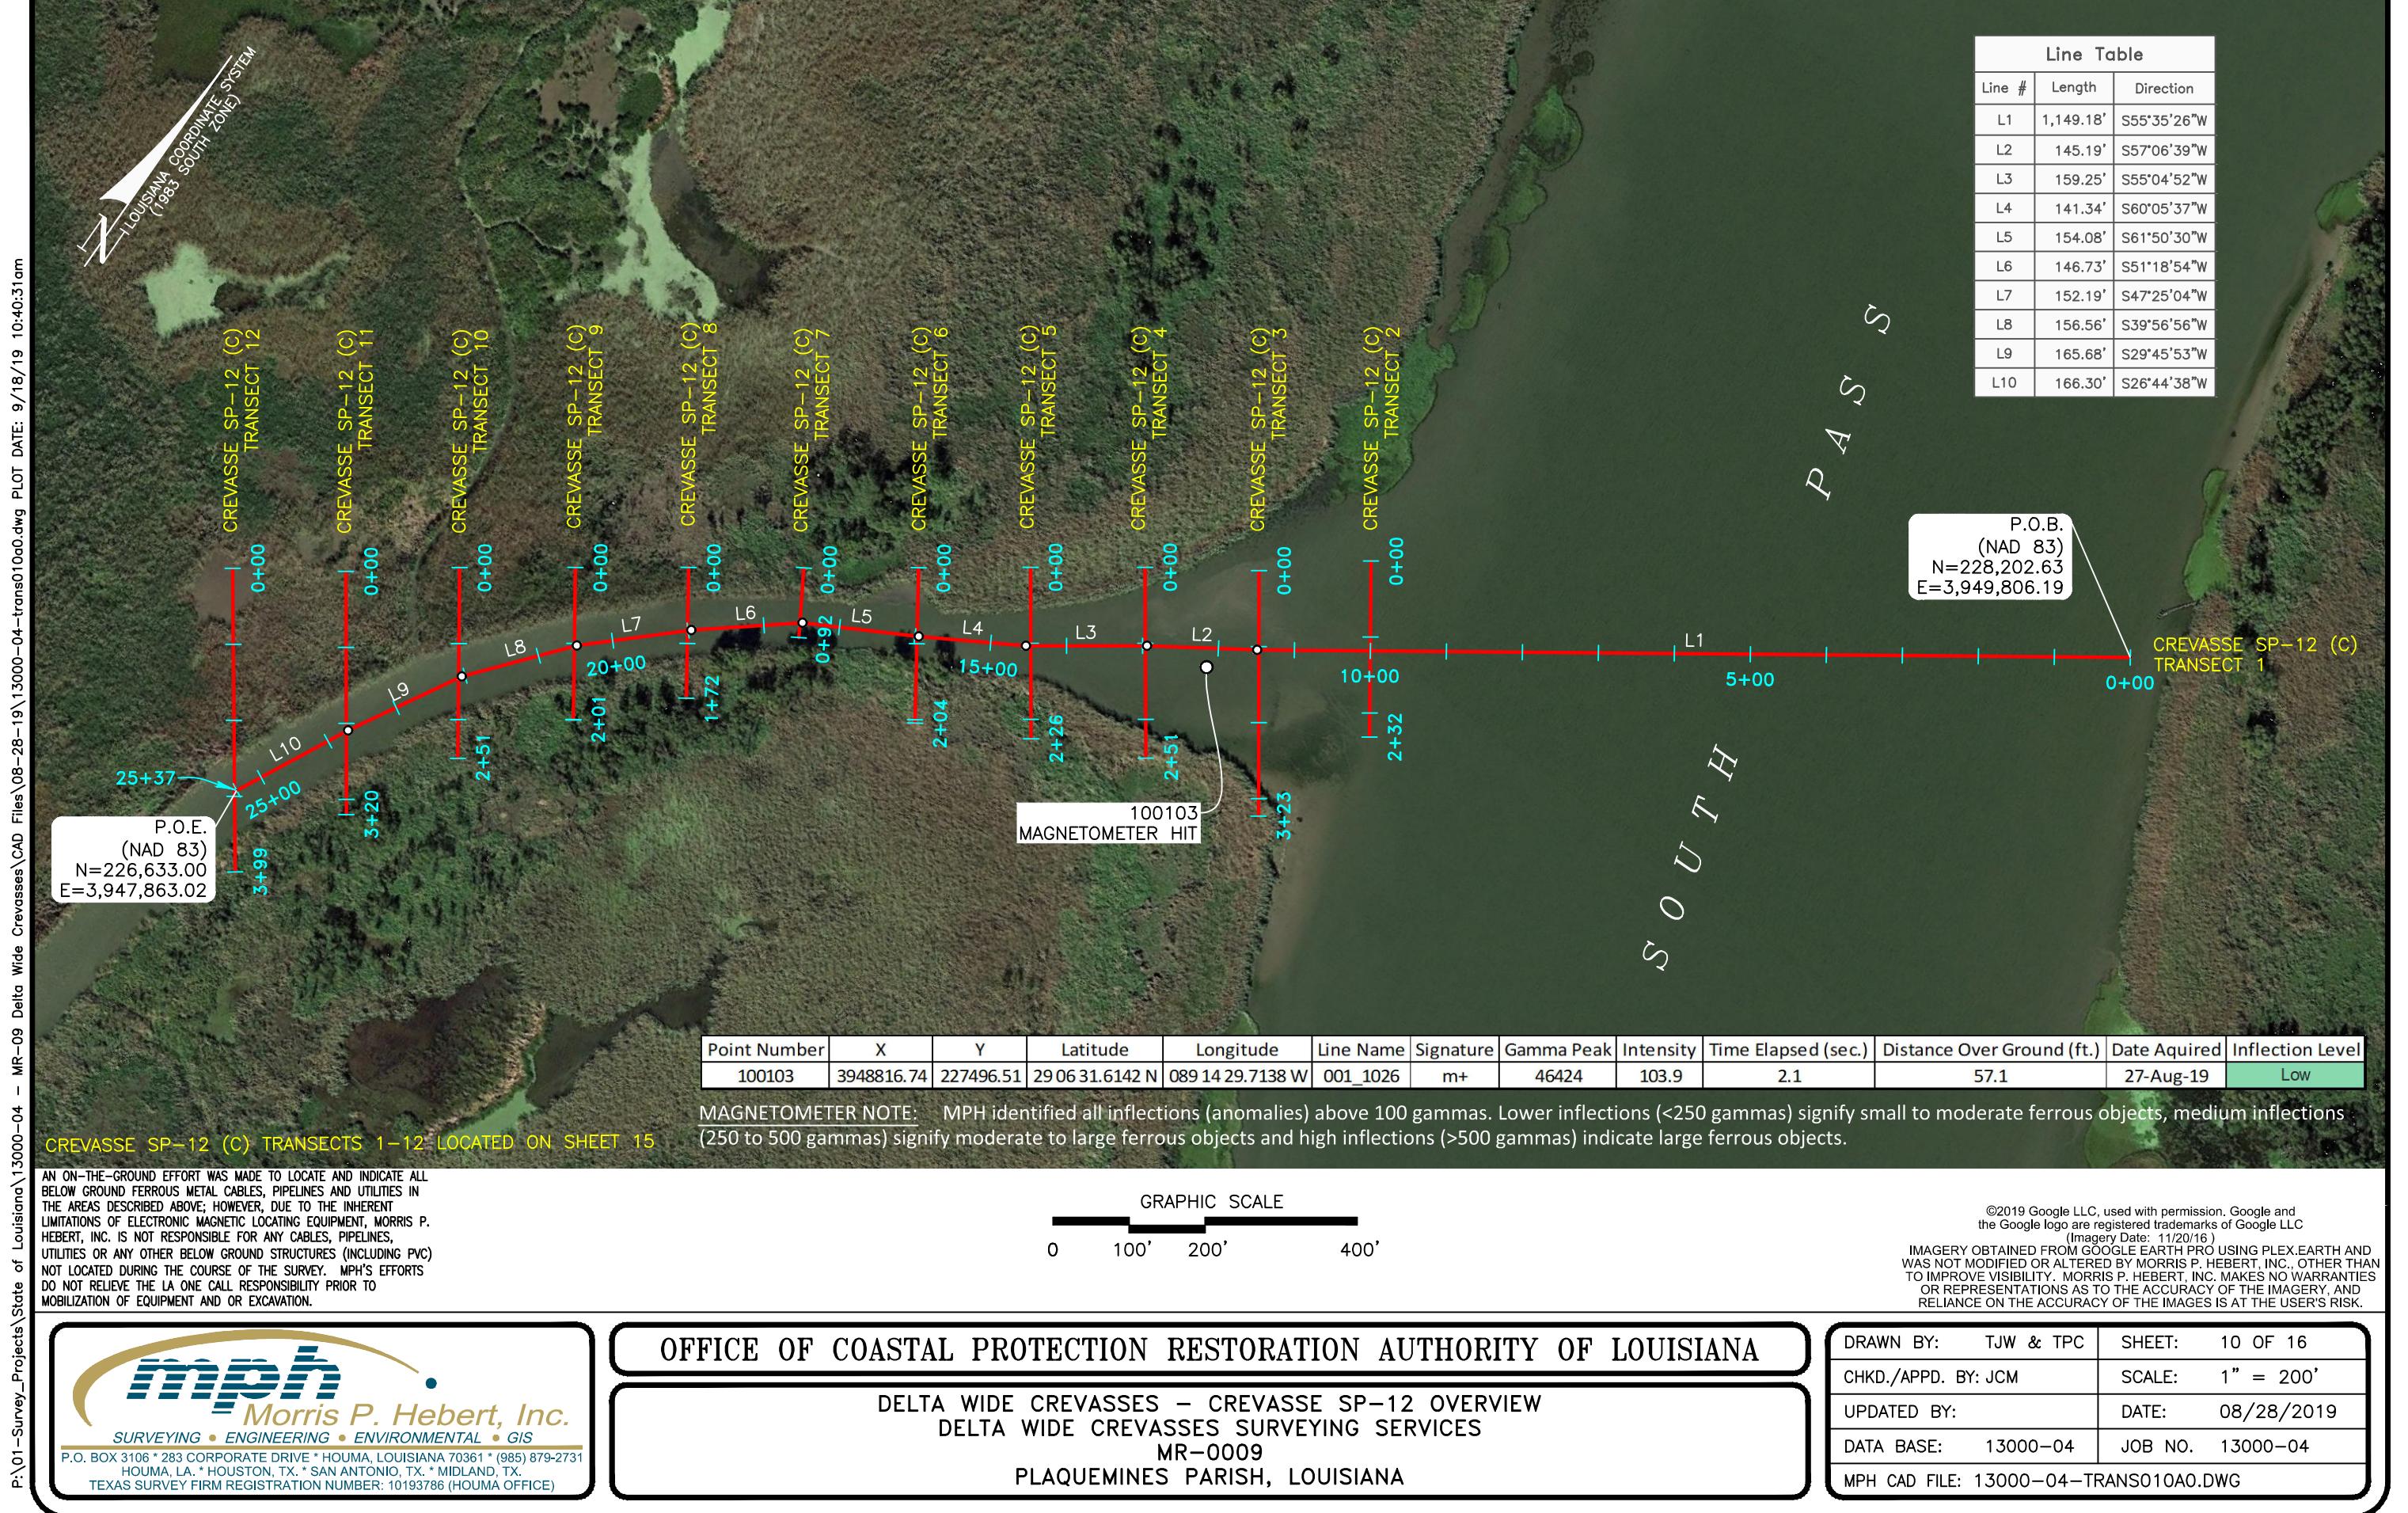

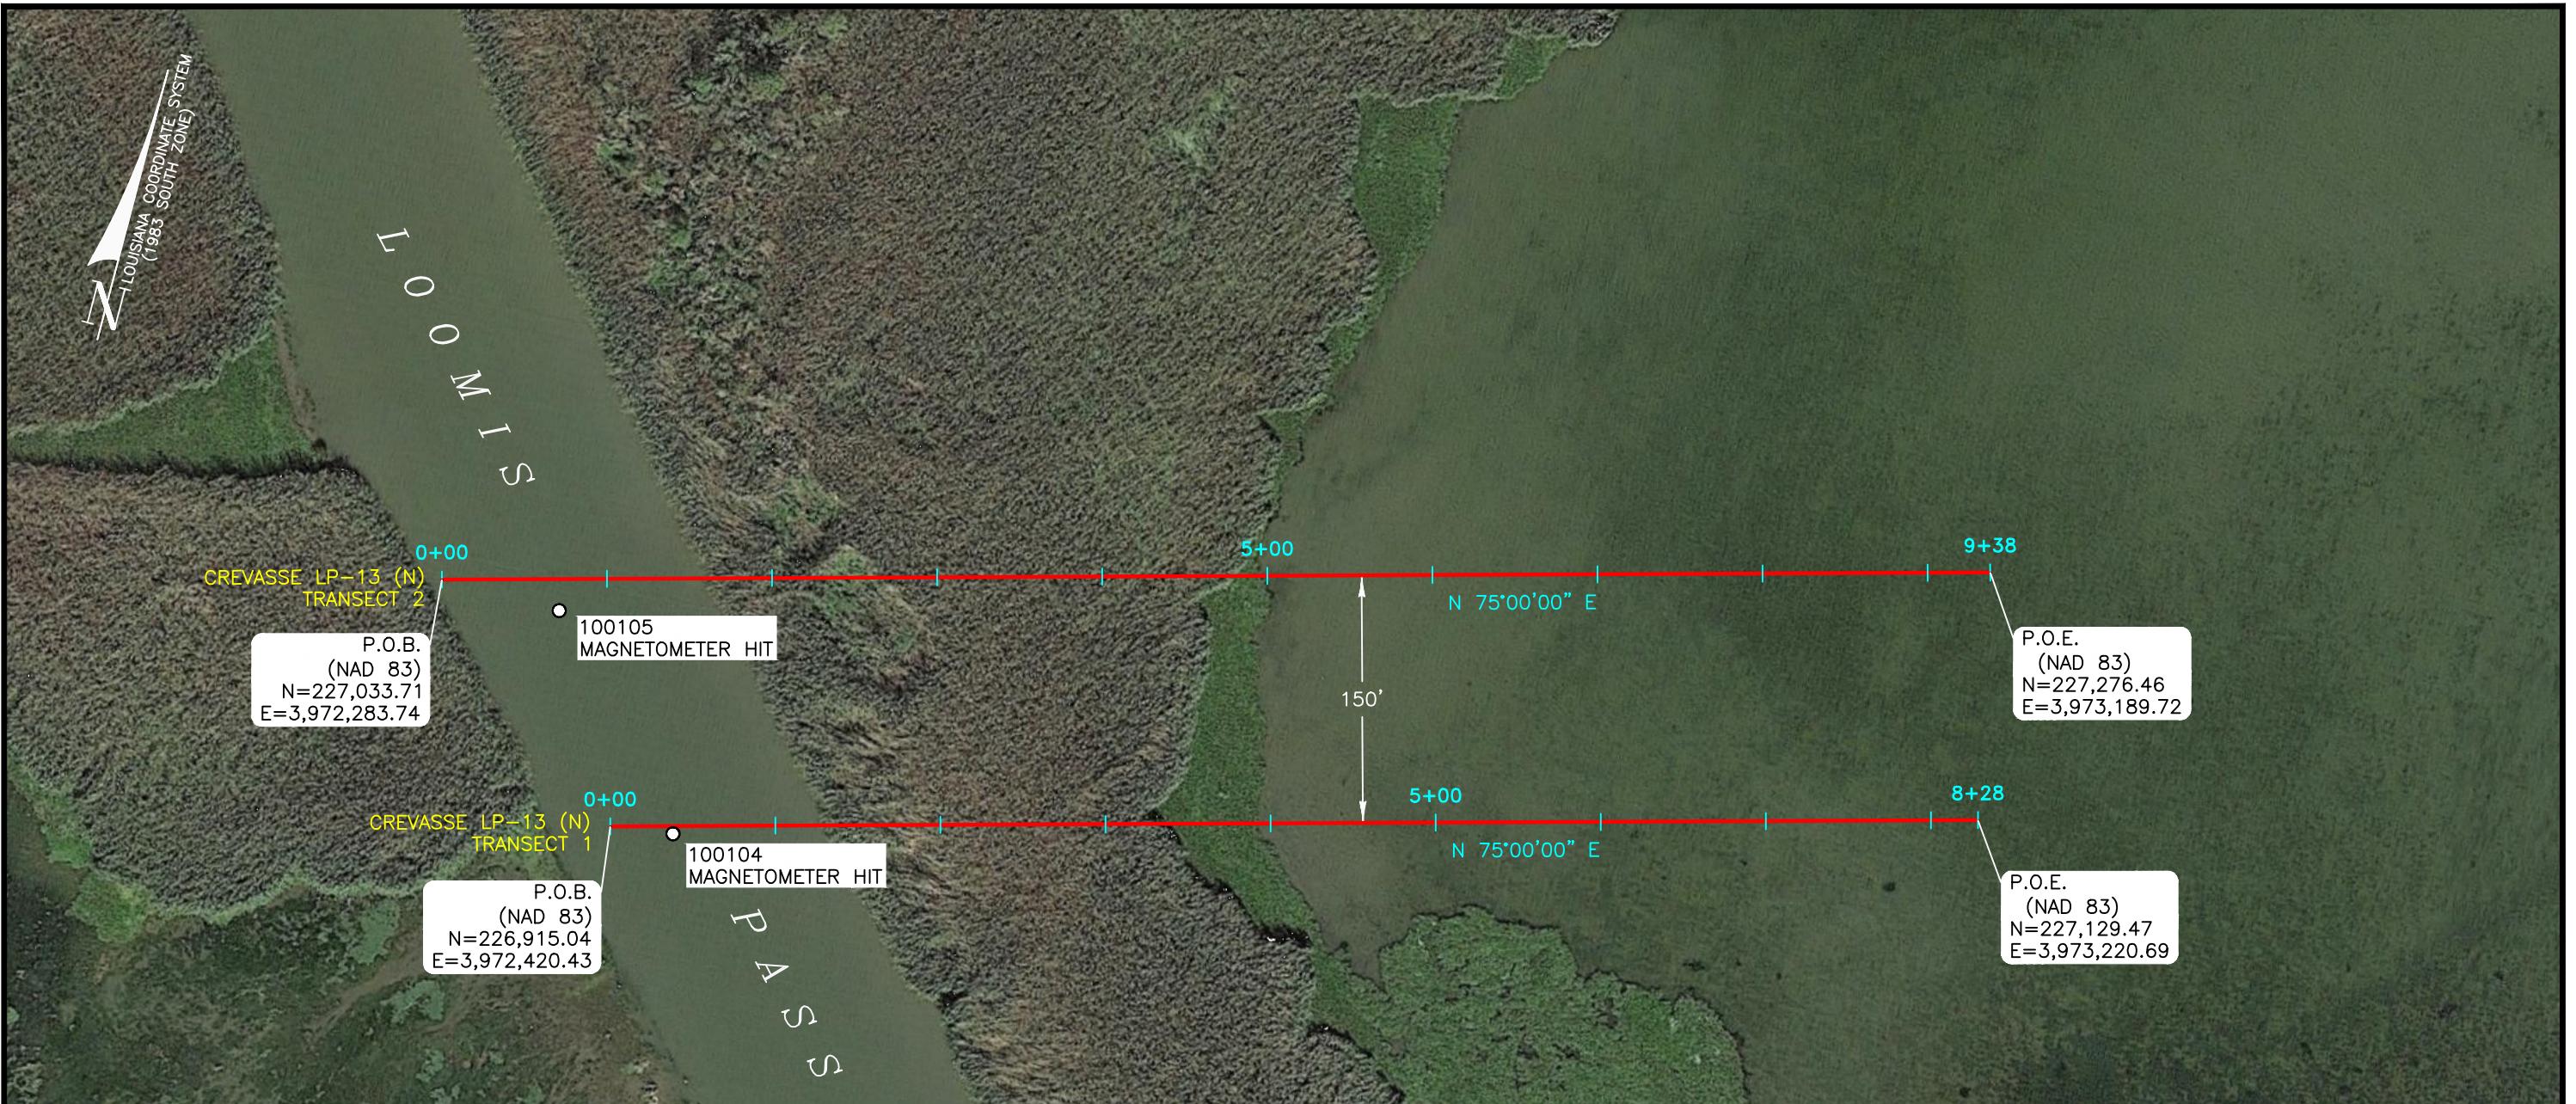

| Point Number | X          | Y         | Latitude        | Longitude       | Line Name | Signature | Gamma Peak | Intensity | Time Elapsed (sec.) | Distance Over Ground (ft.) | Date Acquired | Inflection Level |
|--------------|------------|-----------|-----------------|-----------------|-----------|-----------|------------|-----------|---------------------|----------------------------|---------------|------------------|
| 100104       | 3972458.26 | 226920.31 | 29 06 21.5635 N | 089 10 3.3842 W | 001_1026  | m+        | 46370      | 112.3     | 11.2                | 52.8                       | 27-Aug-19     | Low              |
| 100105       | 3972357.27 | 227033.52 | 29 06 22.703 N  | 089 10 4.4982 W | 002_1028  | m-        | 46737      | 319.3     | 6.1                 | 55.7                       | 27-Aug-19     | Medium           |

MAGNETOMETER NOTE: MPH identified all inflections (anomalies) above 100 gammas. Lower inflections (<250 gammas) signify small to moderate ferrous objects, medium inflections (250 to 500 gammas) signify moderate to large ferrous objects and high inflections (>500 gammas) indicate large ferrous objects.

CREVASSSE LP-13 (N) TRANSECTS 1 & 2 LOCATED ON SHEET 16

AN ON-THE-GROUND EFFORT WAS MADE TO LOCATE AND INDICATE ALL BELOW GROUND FERROUS METAL CABLES, PIPELINES AND UTILITIES IN THE AREAS DESCRIBED ABOVE; HOWEVER, DUE TO THE INHERENT LIMITATIONS OF ELECTRONIC MAGNETIC LOCATING EQUIPMENT, MORRIS P. HEBERT, INC. IS NOT RESPONSIBLE FOR ANY CABLES, PIPELINES, UTILITIES OR ANY OTHER BELOW GROUND STRUCTURES (INCLUDING PVC) NOT LOCATED DURING THE COURSE OF THE SURVEY. MPH'S EFFORTS DO NOT RELIEVE THE LA ONE CALL RESPONSIBILITY PRIOR TO MOBILIZATION OF EQUIPMENT AND OR EXCAVATION.

GRAPHIC SCALE

0 50' 100' 200'

©2019 Google LLC, used with permission. Google and the Google logo are registered trademarks of Google LLC (Imagery Date: 11/20/16)





IMAGERY OBTAINED FROM GOOGLE EARTH PRO USING PLEX.EARTH AND WAS NOT MODIFIED OR ALTERED BY MORRIS P. HEBERT, INC., OTHER THAN TO IMPROVE VISIBILITY. MORRIS P. HEBERT, INC. MAKES NO WARRANTIES OR REPRESENTATIONS AS TO THE ACCURACY OF THE IMAGERY, AND RELIANCE ON THE ACCURACY OF THE IMAGES IS AT THE USER'S RISK.



OFFICE OF COASTAL PROTECTION RESTORATION AUTHORITY OF LOUISIANA

DELTA WIDE CREVASSES – CREVASSSE LP-13 (N) OVERVIEW  
DELTA WIDE CREVASSES SURVEYING SERVICES  
MR-0009  
PLAQUEMINES PARISH, LOUISIANA

|                 |                         |         |            |
|-----------------|-------------------------|---------|------------|
| DRAWN BY:       | TJW & TPC               | SHEET:  | 11 OF 16   |
| CHKD./APPD. BY: | JCM                     | SCALE:  | 1" = 100'  |
| UPDATED BY:     |                         | DATE:   | 08/28/2019 |
| DATA BASE:      | 13000-04                | JOB NO. | 13000-04   |
| MPH CAD FILE:   | 13000-04-TRANS011A0.DWG |         |            |

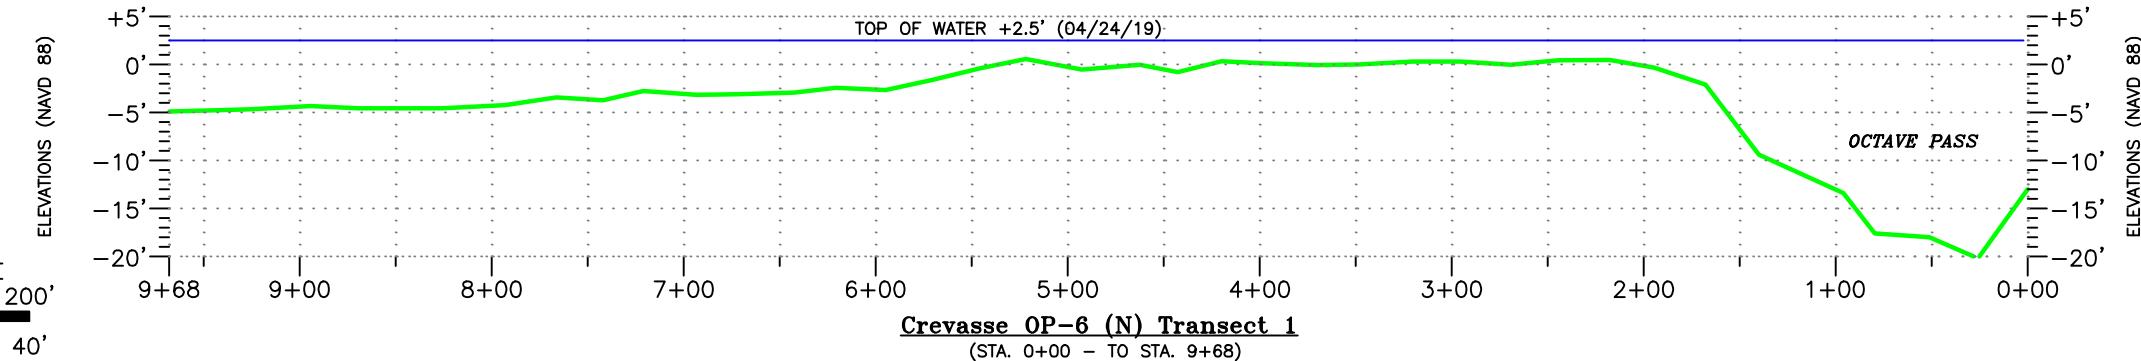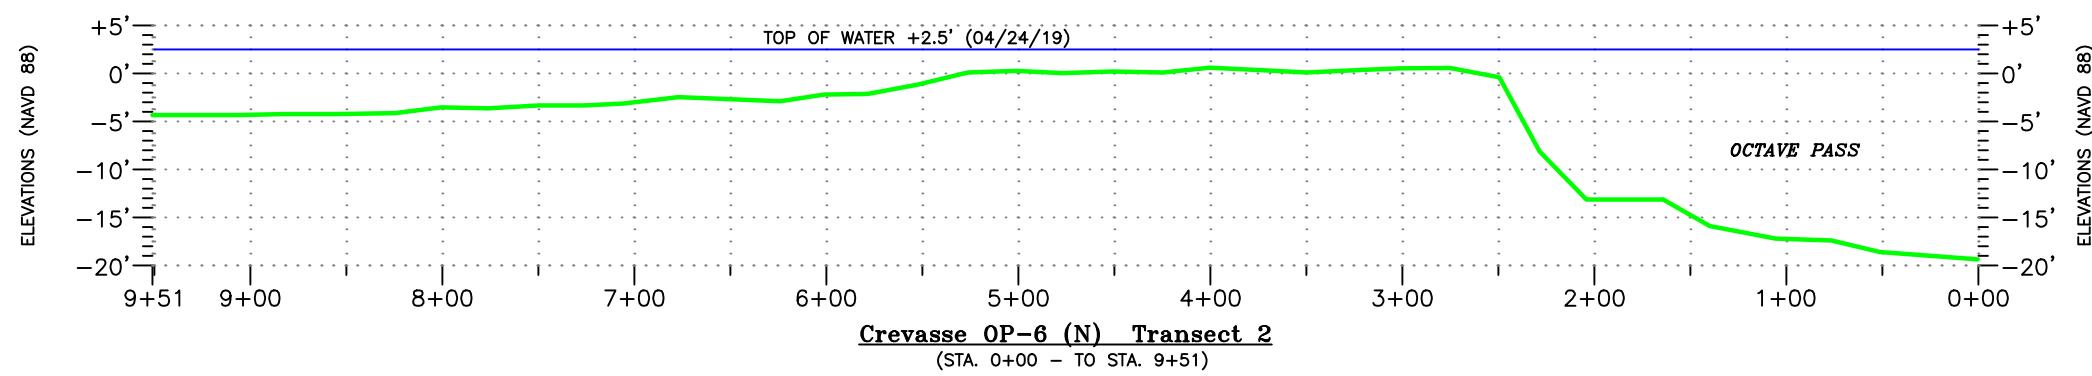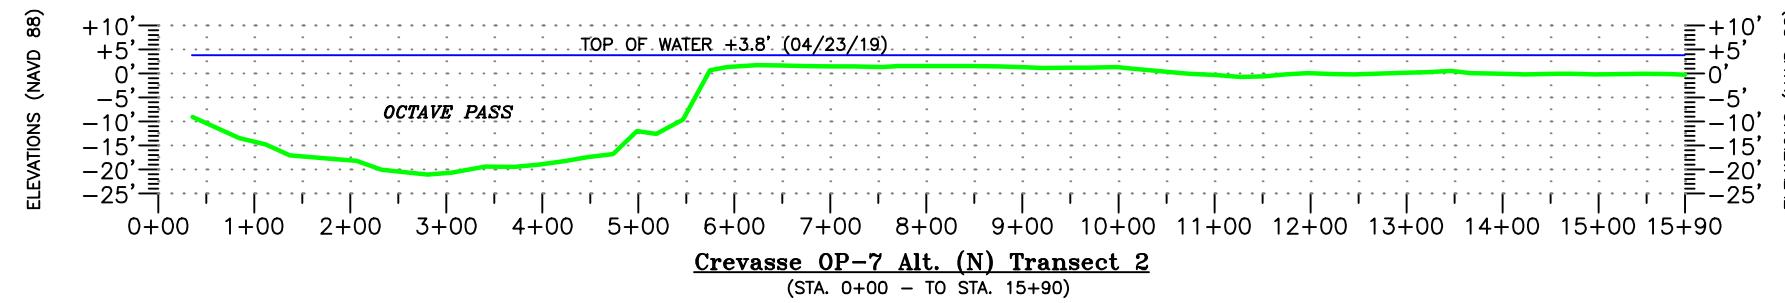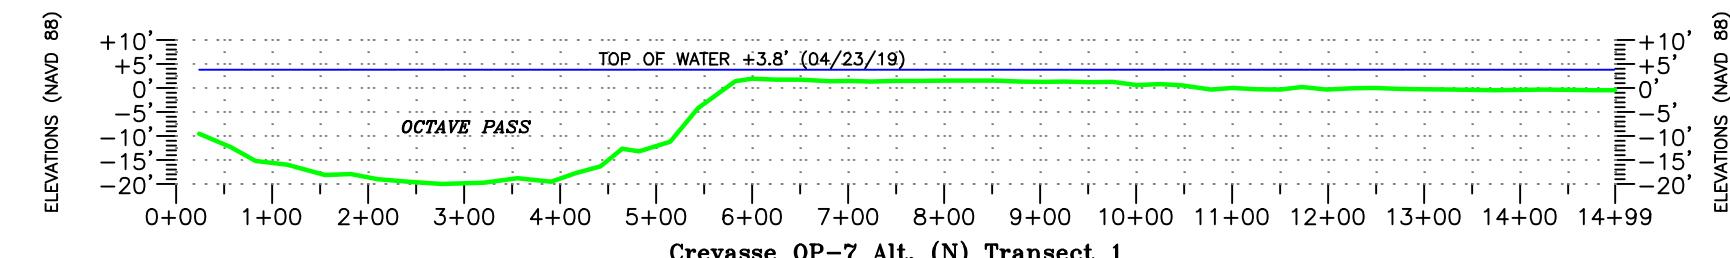



**OFFICE OF COASTAL PROTECTION RESTORATION AUTHORITY OF LOUISIANA**

**DELTA WIDE CREVASSES – OP-6 (N) TRANSECTS 1-2 & OP-7 ALT. (N) TRANSECTS 1-2**  
**DELTA WIDE CREVASSES SURVEYING SERVICES**

**MR-0009**


**PLAQUEMINES PARISH, LOUISIANA**

|                 |                         |         |            |
|-----------------|-------------------------|---------|------------|
| DRAWN BY:       | TJW & TPC               | SHEET:  | 12 OF 16   |
| CHKD./APPD. BY: | JCM                     | SCALE:  | AS SHOWN   |
| UPDATED BY:     |                         | DATE:   | 08/28/2019 |
| DATA BASE:      | 13000-04                | JOB NO. | 13000-04   |
| MPH CAD FILE:   | 13000-04-TRANS012A0.DWG |         |            |

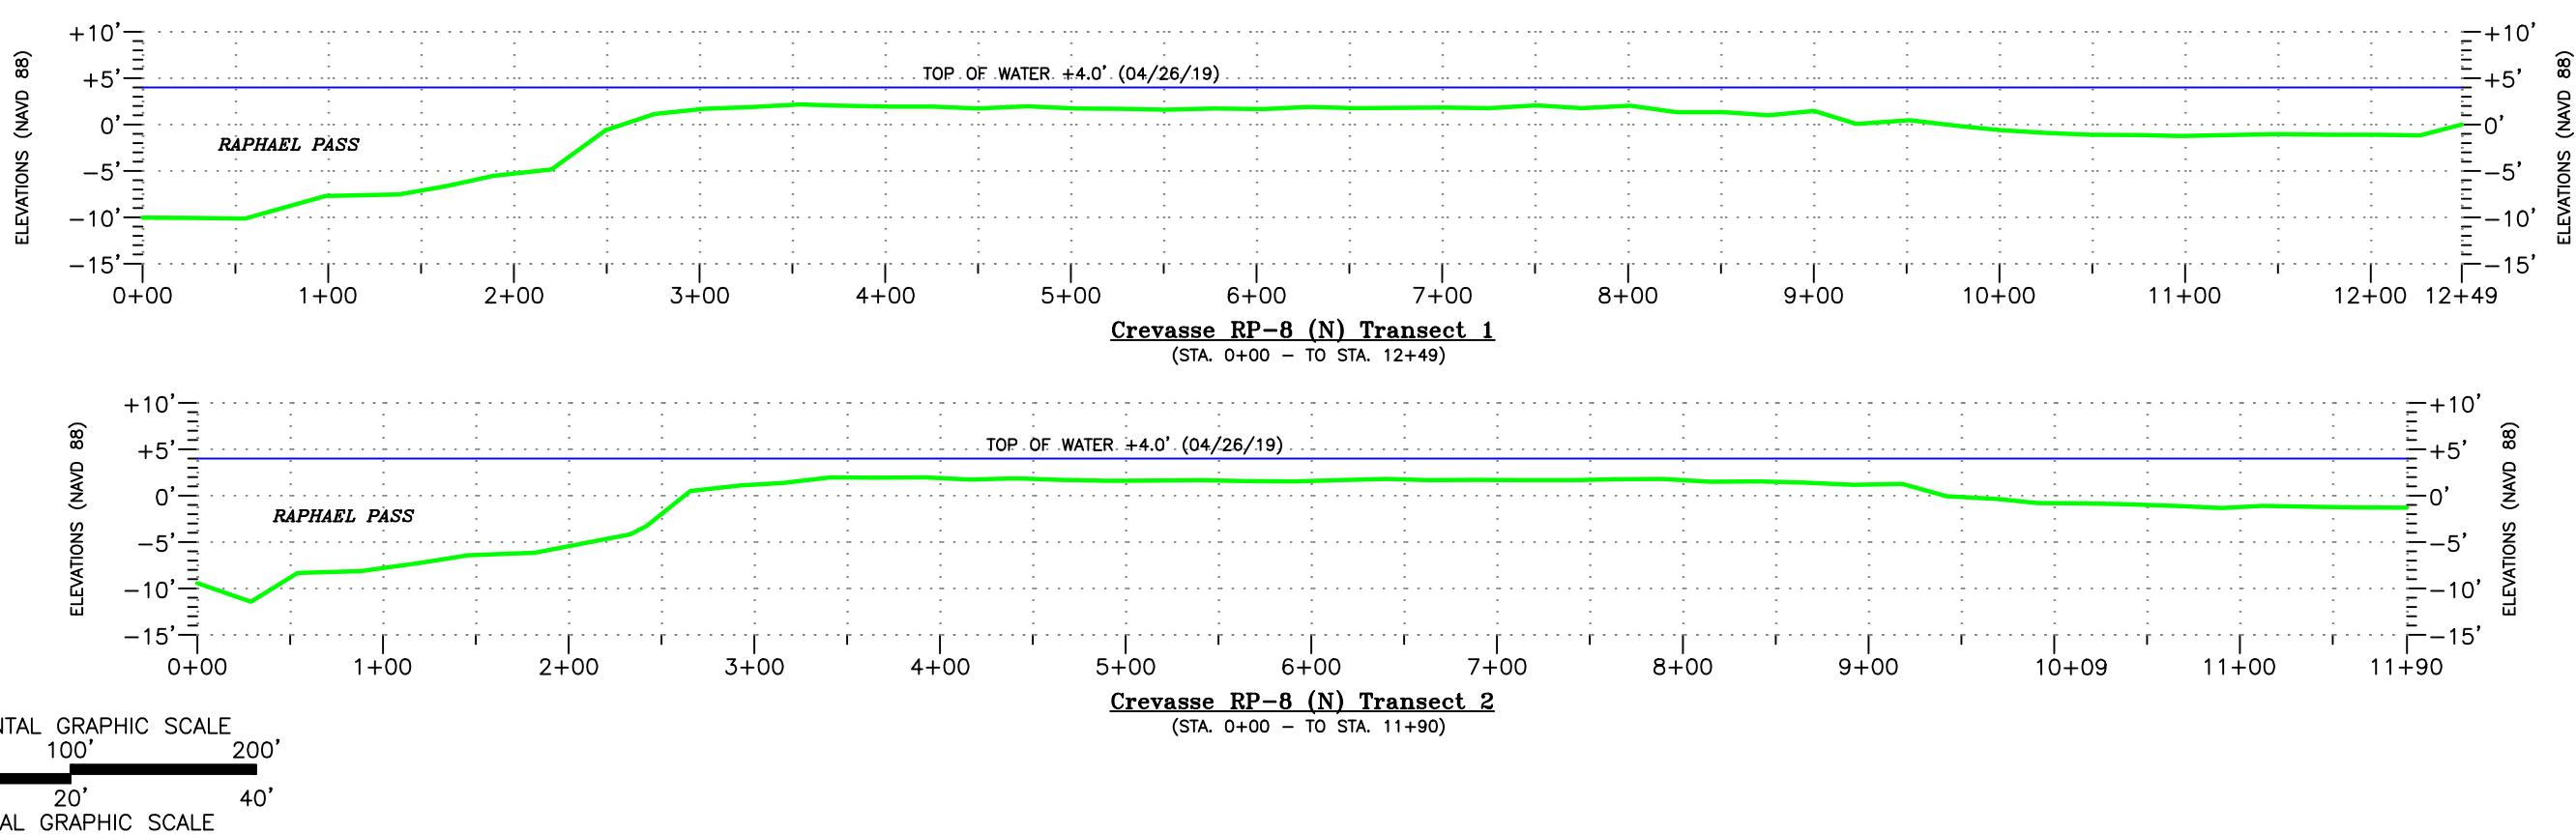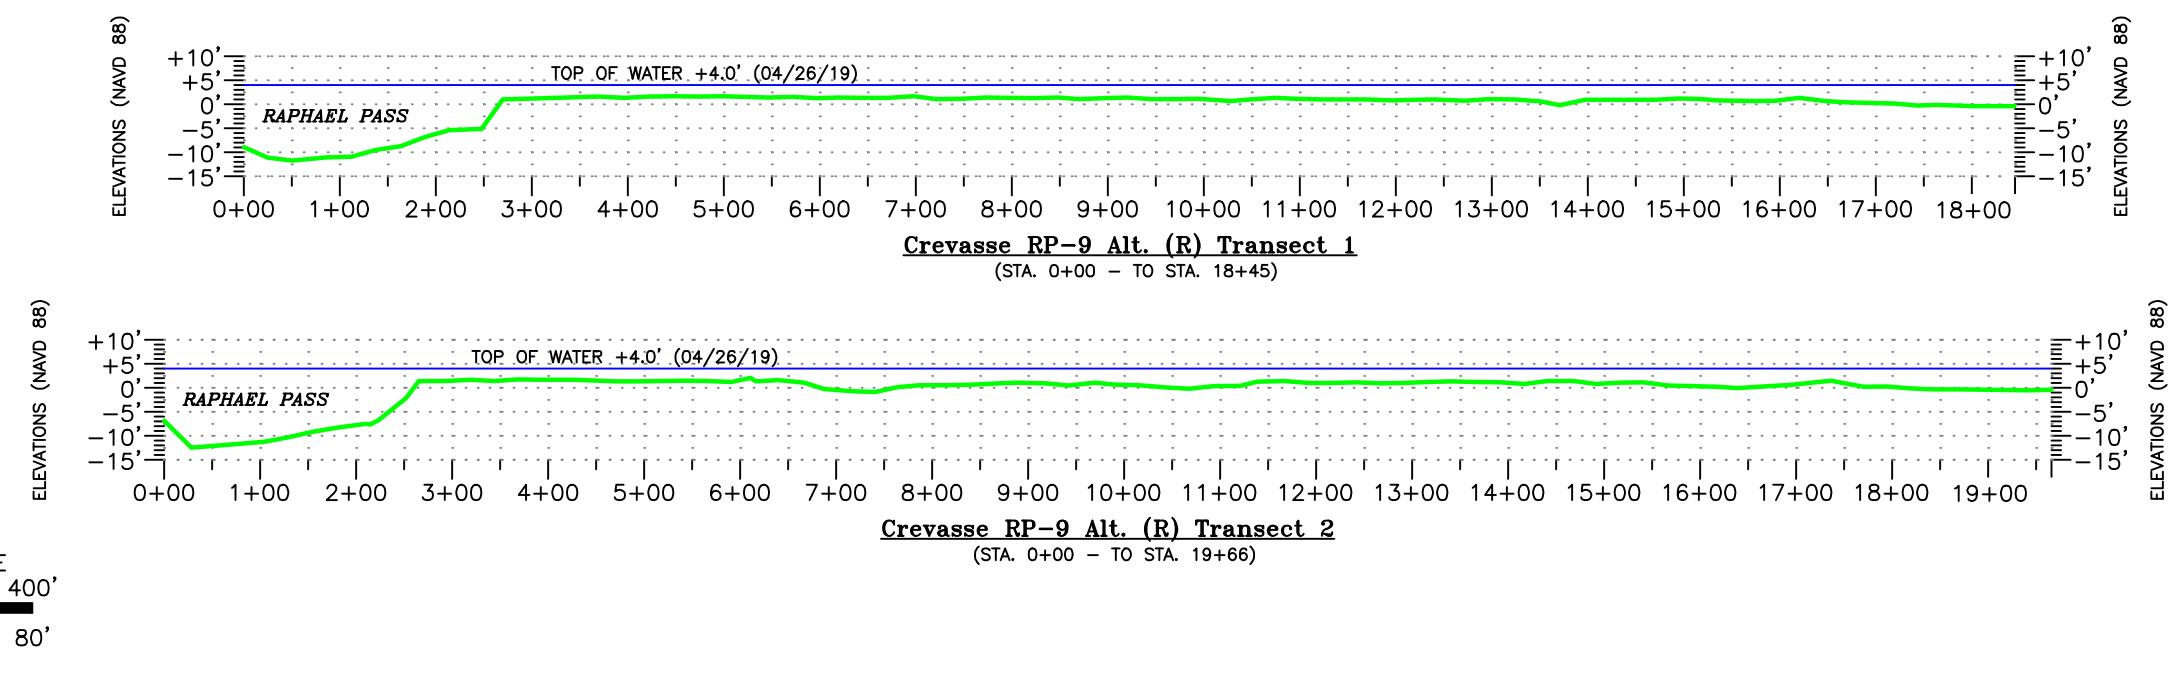


**OFFICE OF COASTAL PROTECTION RESTORATION AUTHORITY OF LOUISIANA**  
**DELTA WIDE CREVASSES – RP-8 (N) TRANSECTS 1-2 & RP-9 ALT. (R) TRANSECTS 1-2**  
**DELTA WIDE CREVASSES SURVEYING SERVICES**  
**MR-0009**  
**PLAQUEMINES PARISH, LOUISIANA**

|                                       |                  |
|---------------------------------------|------------------|
| DRAWN BY: TJW & TPC                   | SHEET: 13 OF 16  |
| CHKD./APPD. BY: JCM                   | SCALE: AS SHOWN  |
| UPDATED BY:                           | DATE: 05/03/2019 |
| DATA BASE: 13000-04                   | JOB NO. 13000-04 |
| MPH CAD FILE: 13000-04-TRANS013A0.DWG |                  |

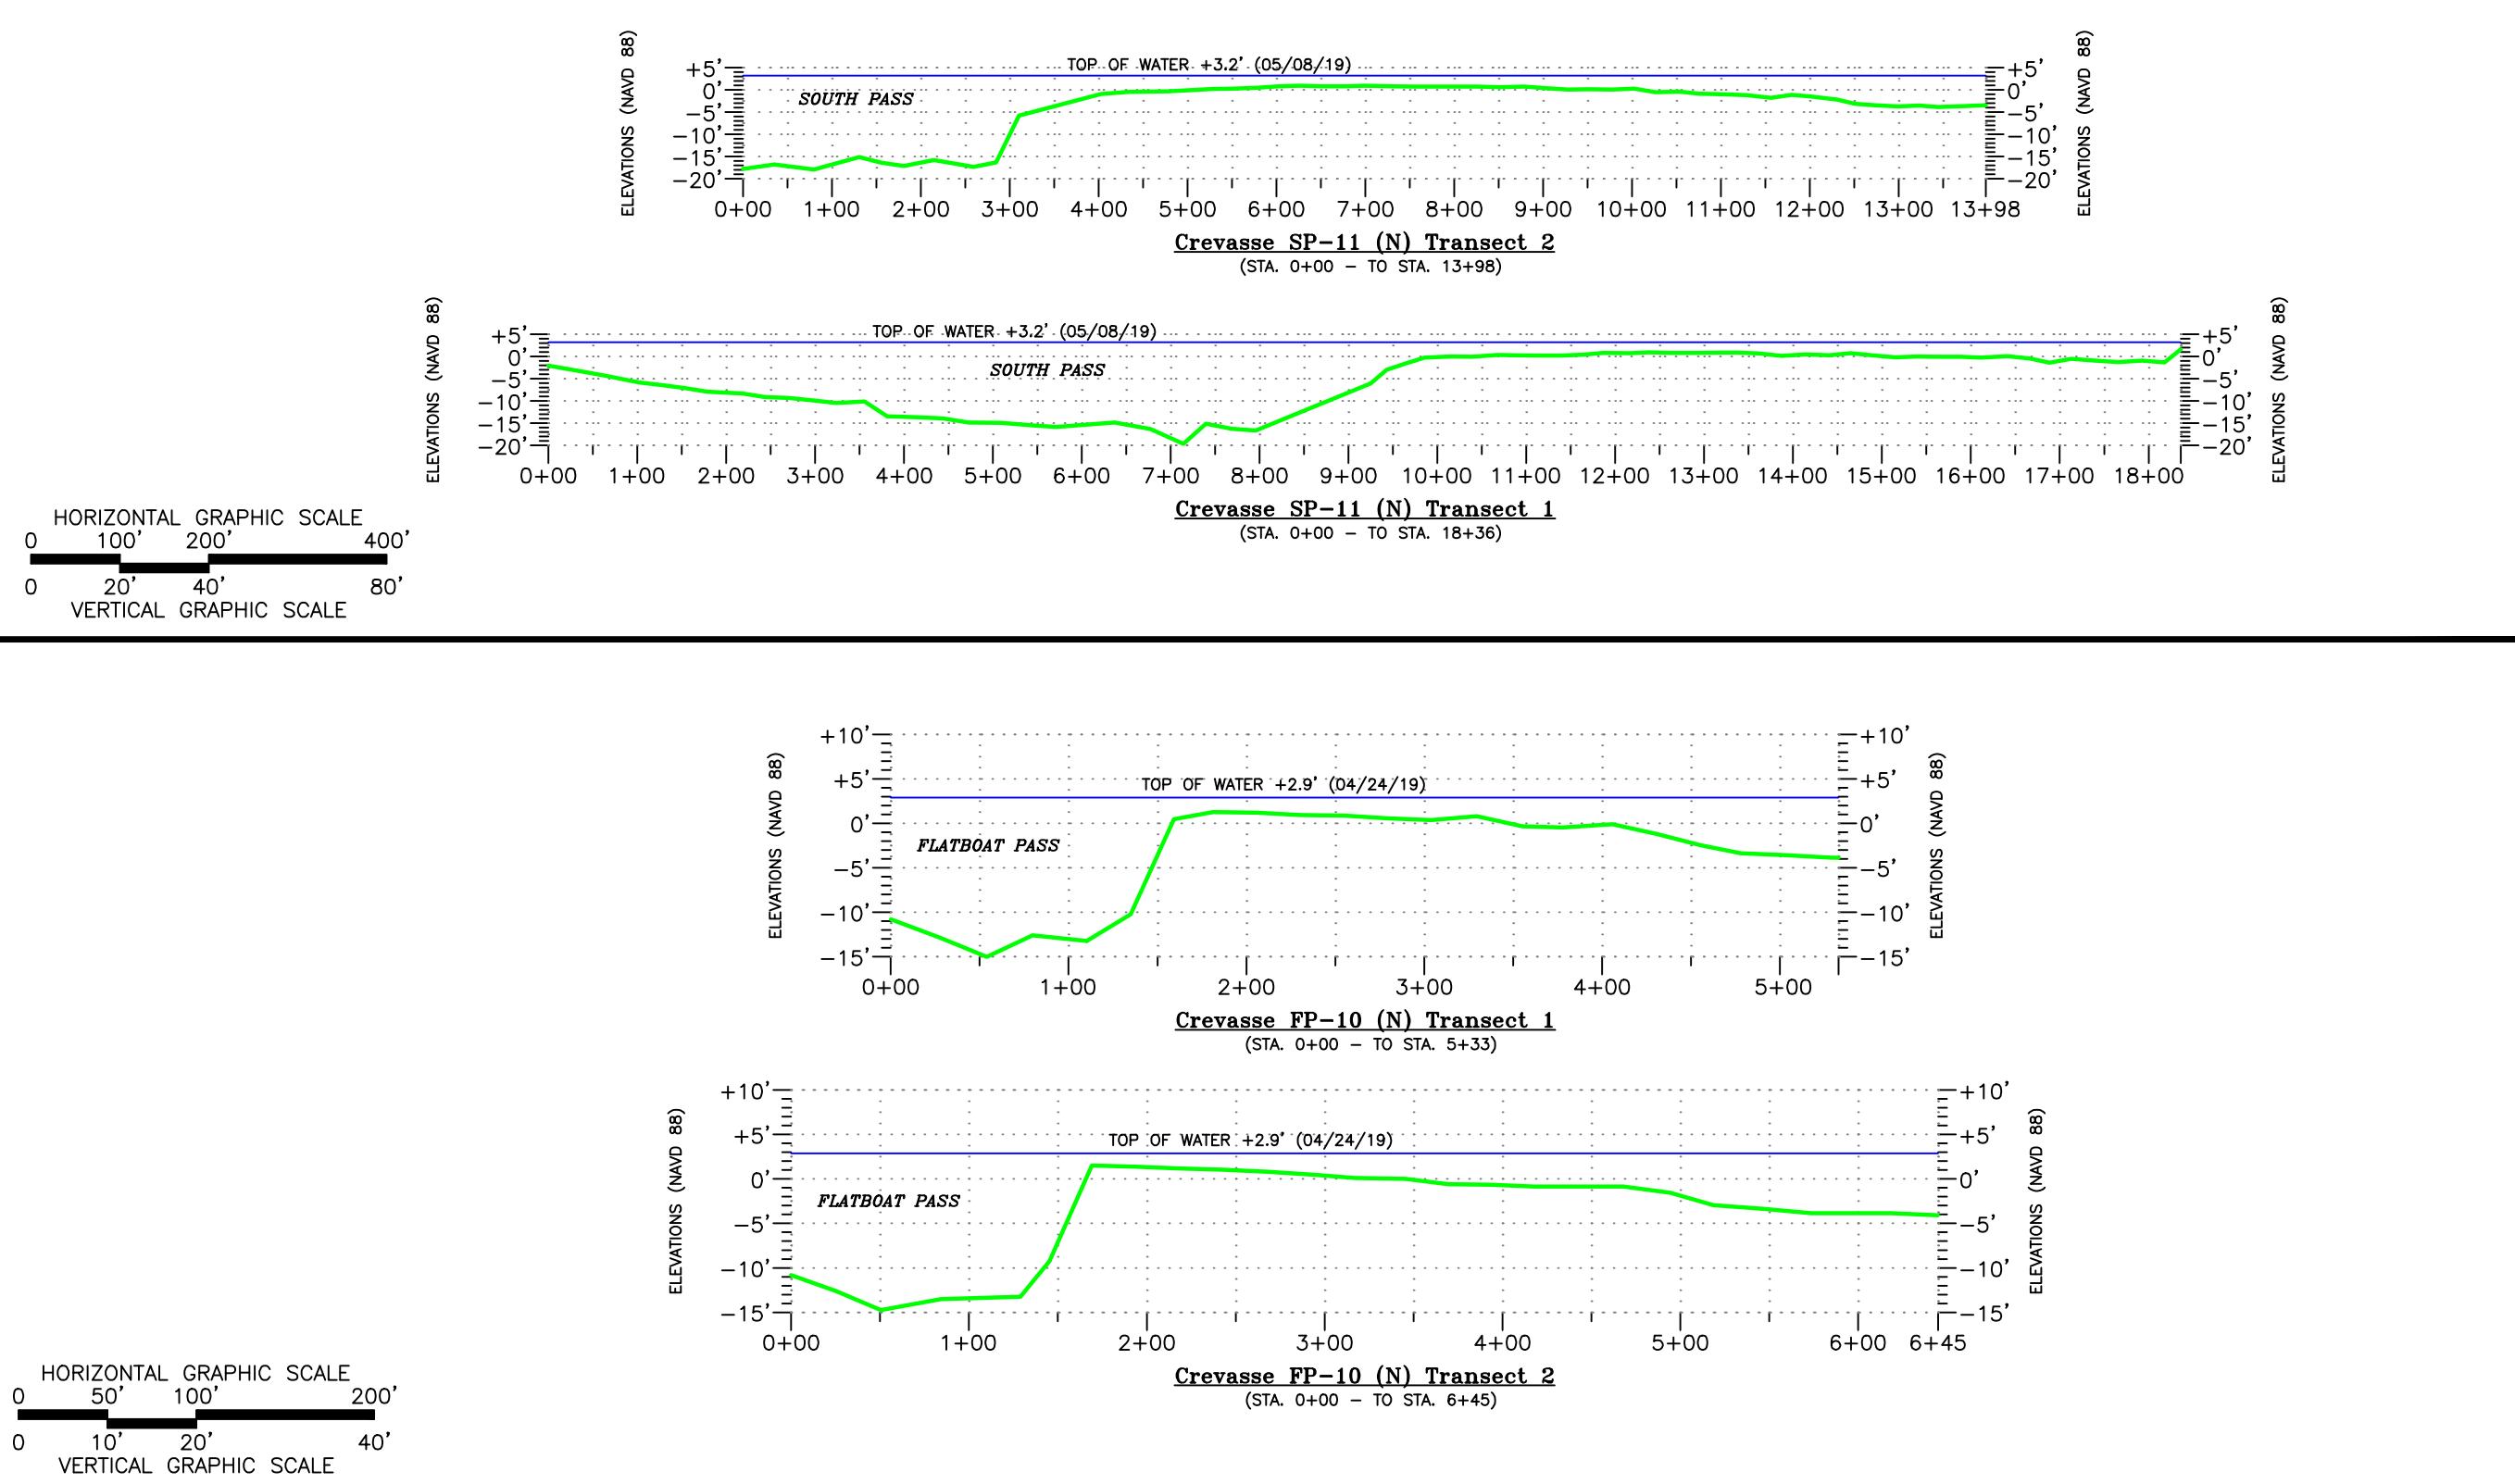

**OFFICE OF COASTAL PROTECTION RESTORATION AUTHORITY OF LOUISIANA**  
**DELTA WIDE CREVASSES FP-10 (N) TRANSECTS 1-2, & SP-11 (N) TRANSECTS 1-2**  
**DELTA WIDE CREVASSES SURVEYING SERVICES**  
**MR-0009**  
**PLAQUEMINES PARISH, LOUISIANA**




|                 |                         |         |            |
|-----------------|-------------------------|---------|------------|
| DRAWN BY:       | TJW & TPC               | SHEET:  | 14 OF 16   |
| CHKD./APPD. BY: | JCM                     | SCALE:  | AS SHOWN   |
| UPDATED BY:     |                         | DATE:   | 08/28/2019 |
| DATA BASE:      | 13000-04                | JOB NO. | 13000-04   |
| MPH CAD FILE:   | 13000-04-TRANS014A0.DWG |         |            |

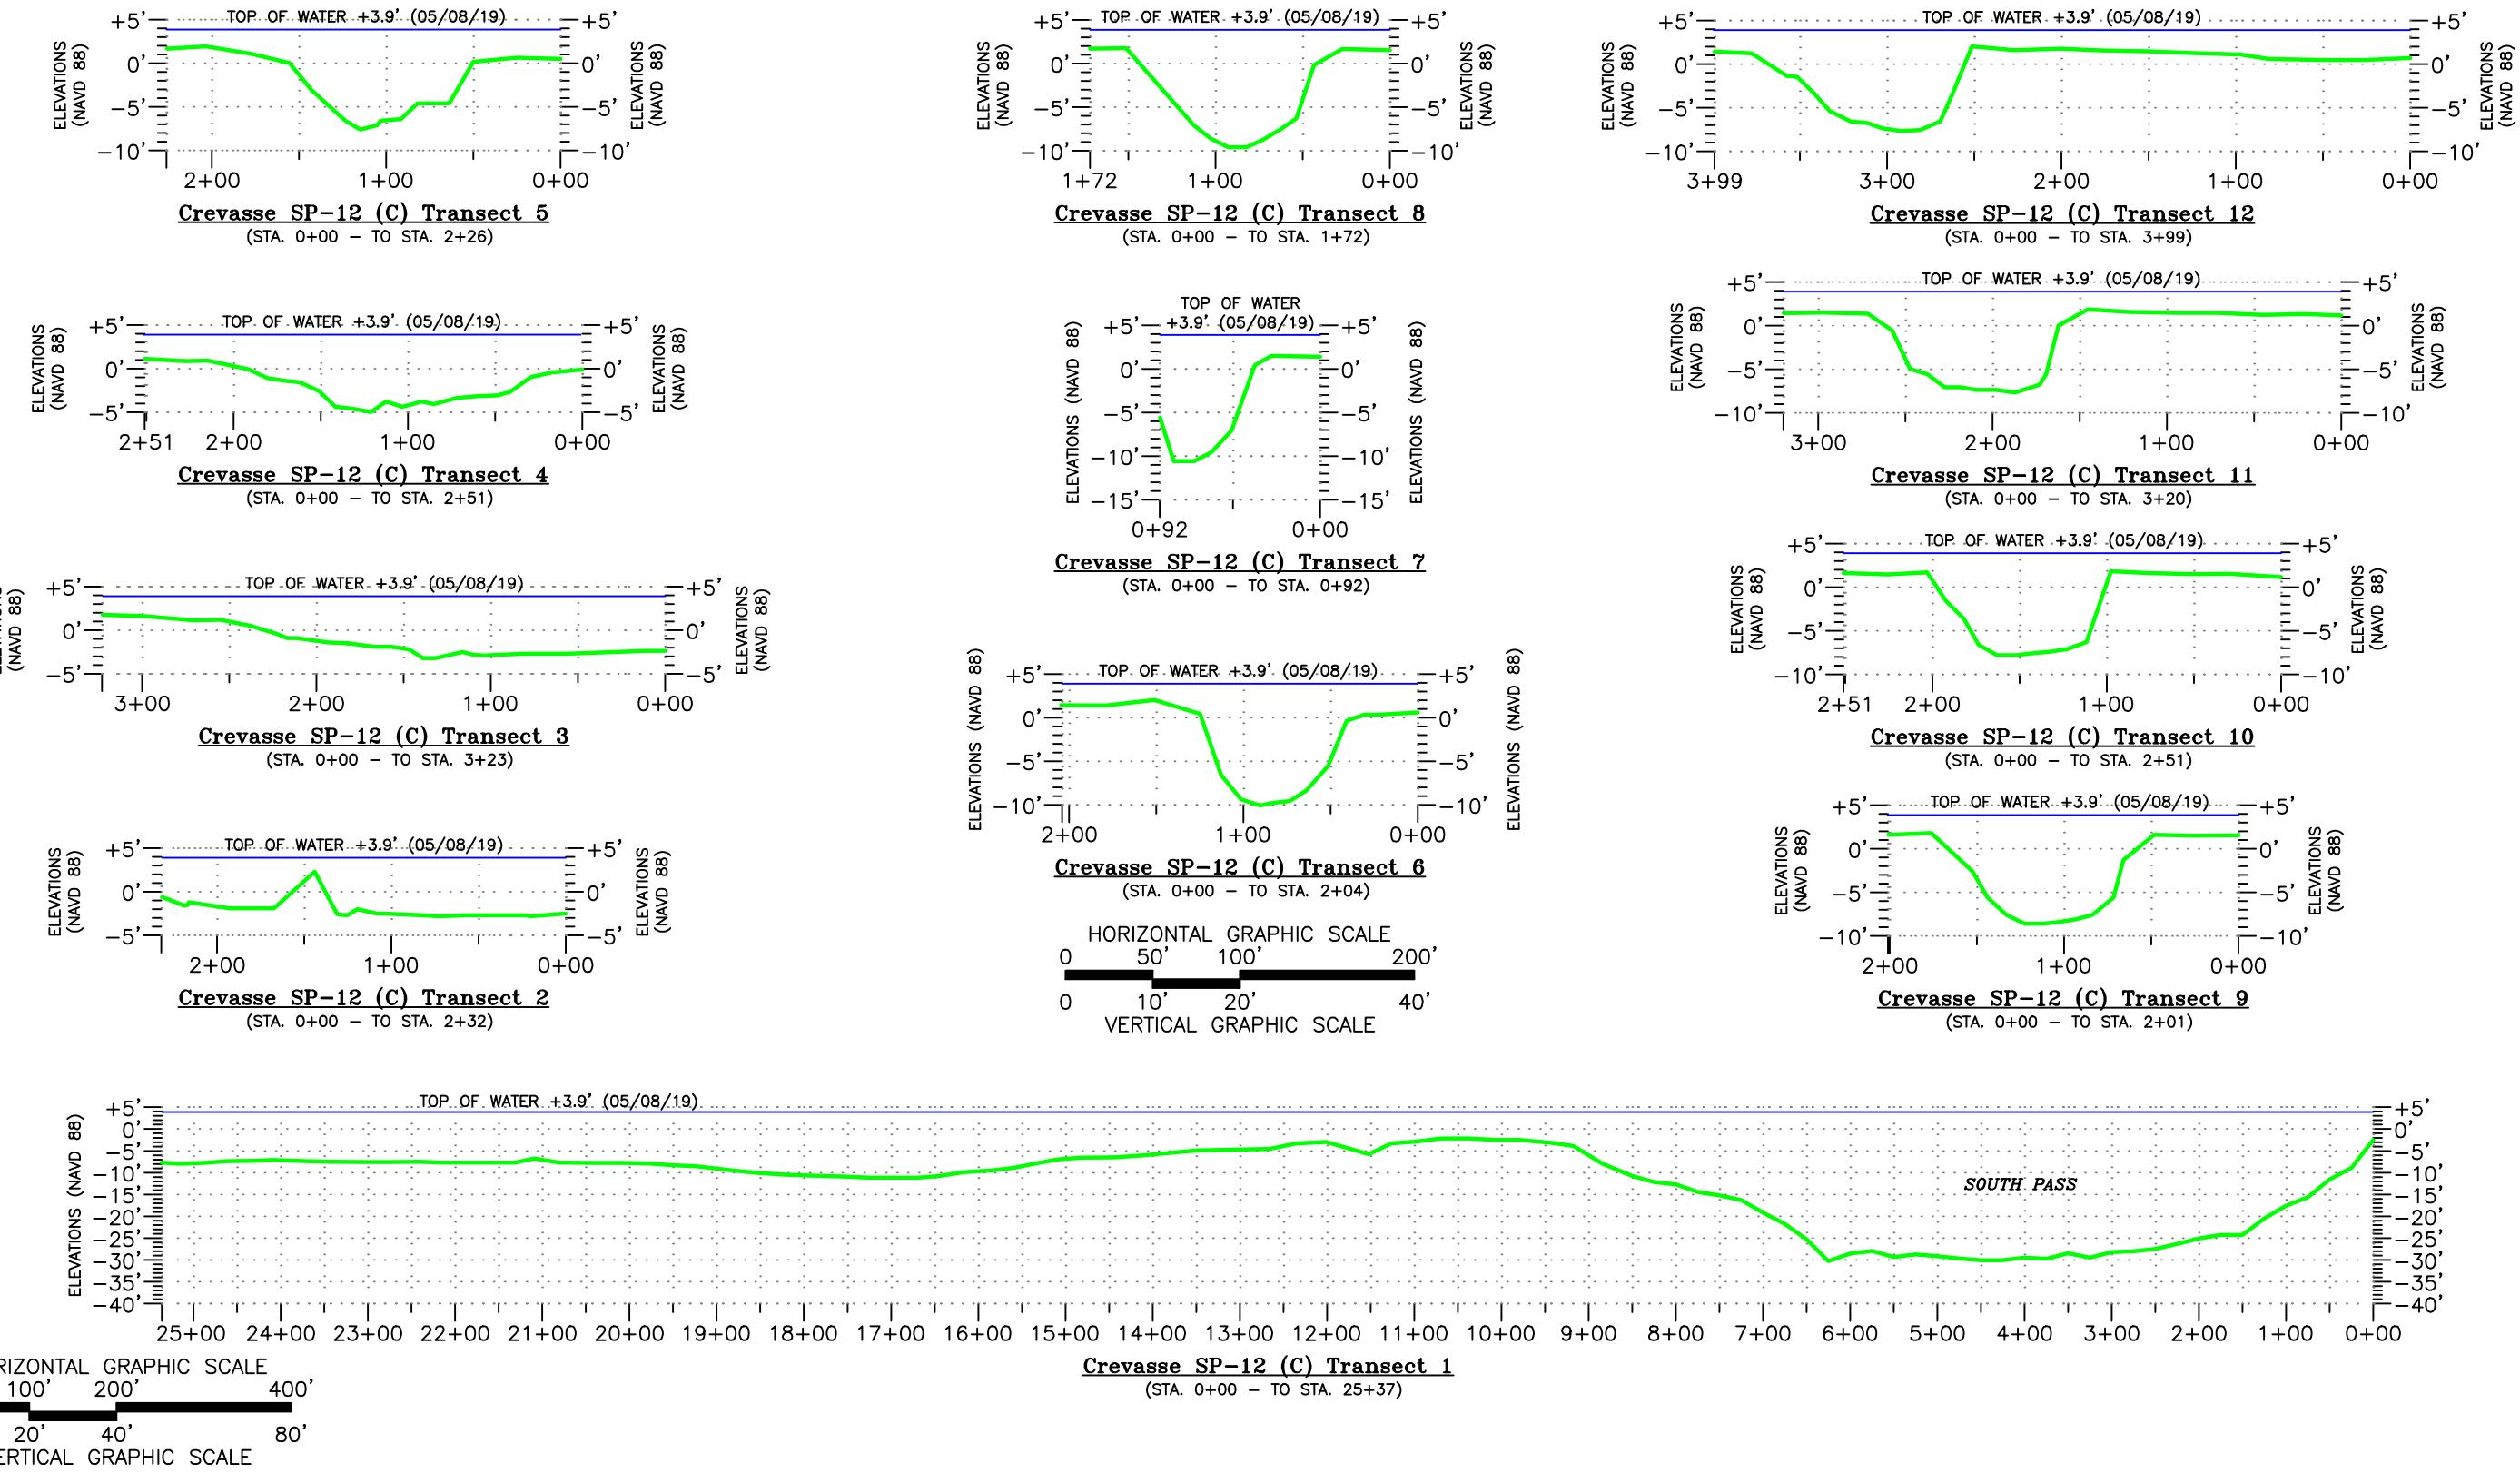

OFFICE OF COASTAL PROTECTION RESTORATION AUTHORITY OF LOUISIANA

DELTA WIDE CREVASSES - SP-12 (C) TRANSECTS 1 THRU 12  
DELTA WIDE CREVASSES SURVEYING SERVICES  
MR-0009  
PLAQUEMINES PARISH, LOUISIANA

|                 |                         |         |            |
|-----------------|-------------------------|---------|------------|
| DRAWN BY:       | TJW & TPC               | SHEET:  | 15 OF 16   |
| CHKD./APPD. BY: | JCM                     | SCALE:  | AS SHOWN   |
| UPDATED BY:     |                         | DATE:   | 08/28/2019 |
| DATA BASE:      | 13000-04                | JOB NO. | 13000-04   |
| MPH CAD FILE:   | 13000-04-TRANS015A0.DWG |         |            |

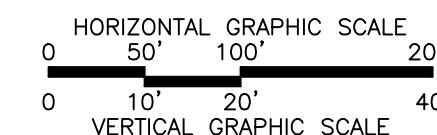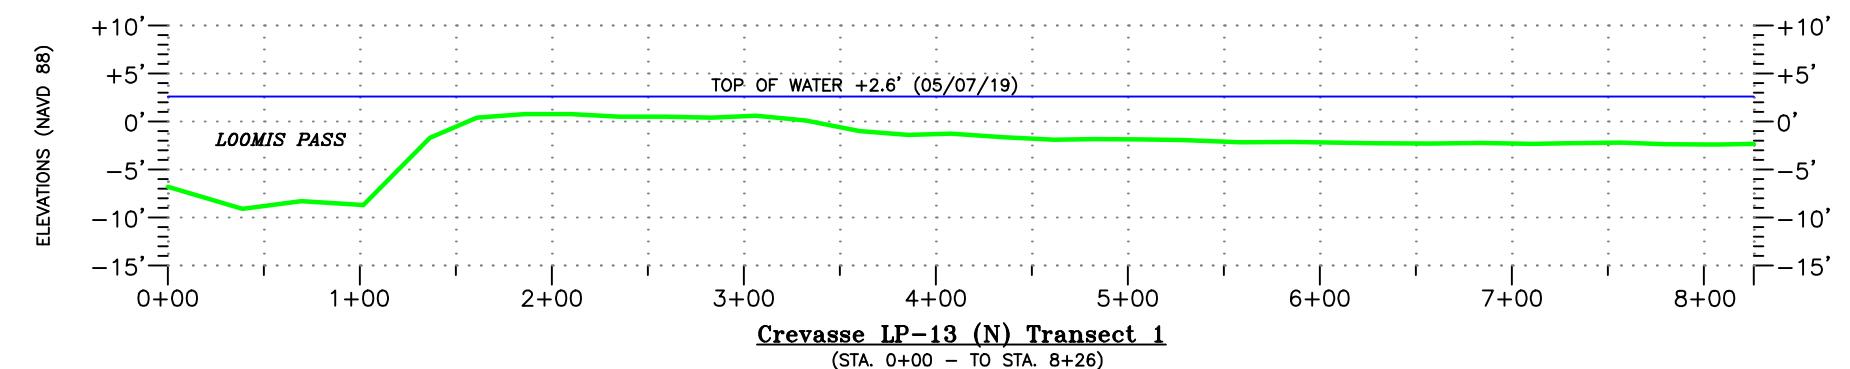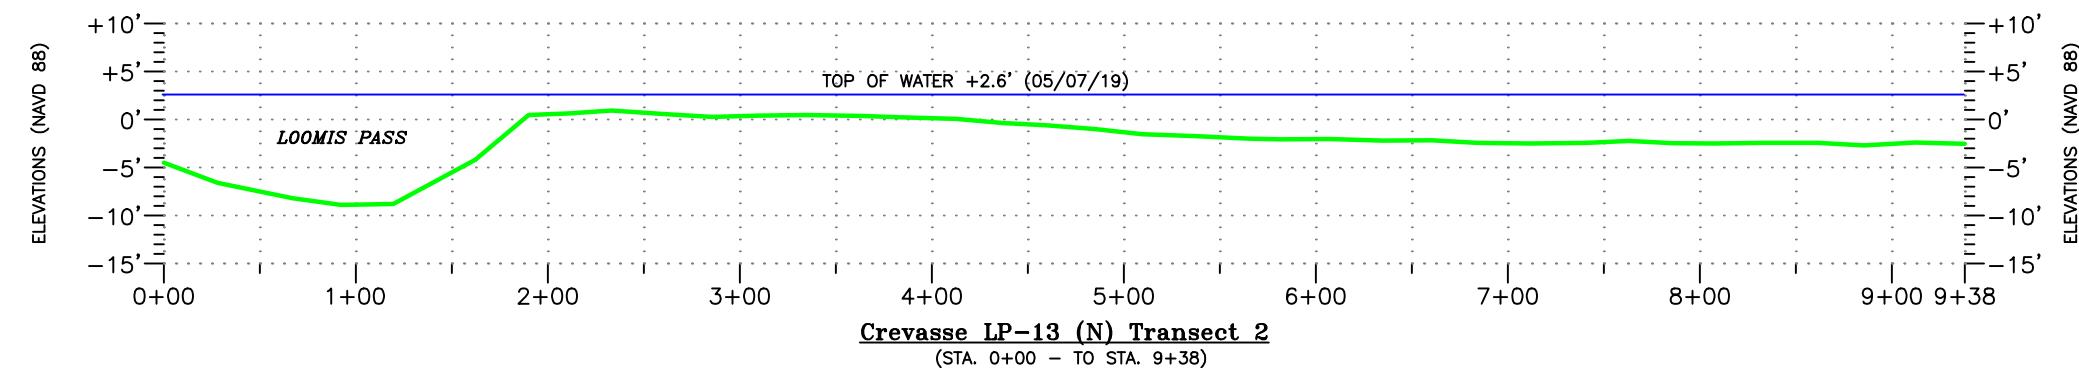

OFFICE OF COASTAL PROTECTION RESTORATION AUTHORITY OF LOUISIANA

DELTA WIDE CREVASSES – LP-13 (N) TRANSECTS 1-2  
DELTA WIDE CREVASSES SURVEYING SERVICES  
MR-0009  
PLAQUEMINES PARISH, LOUISIANA

|                 |                         |         |            |
|-----------------|-------------------------|---------|------------|
| DRAWN BY:       | TJW & TPC               | SHEET:  | 16 OF 16   |
| CHKD./APPD. BY: | JCM                     | SCALE:  | AS SHOWN   |
| UPDATED BY:     |                         | DATE:   | 08/28/2019 |
| DATA BASE:      | 13000-04                | JOB NO. | 13000-04   |
| MPH CAD FILE:   | 13000-04-TRANS016A0.DWG |         |            |

---

## **APPENDIX 4**

### **Field Survey Data**

| Point_No | Northing   | Easting     | Elevation | Description        |
|----------|------------|-------------|-----------|--------------------|
| 1000     | 267445.484 | 3945645.4   | 5.494     | MR09-SM-31 CHK     |
| 1001     | 276368.213 | 3947242.724 | 1.973     | MR09-SM-38 CHK MON |
| 1002     | 238749.078 | 3953567.719 | 2.716     | MR09-SM0-06 CHK    |
| 1004     | 234136.261 | 3959208.644 | 5.237     | MON                |
| 1014     | 264804.106 | 3956270.399 | 2.054     | TOW                |
| 2000     | 276368.203 | 3947243.321 | 4.053     | MON                |
| 2002     | 264846.279 | 3956188.122 | -13.161   | SND                |
| 2003     | 264821.66  | 3956209.627 | -11.161   | SND                |
| 2004     | 264801.31  | 3956230.035 | -4.161    | SND                |
| 2005     | 264783.046 | 3956265.475 | 1.408     | WBY                |
| 2006     | 264772.199 | 3956278.717 | 1.977     | WBY                |
| 2007     | 264755.684 | 3956297.982 | 1.779     | WBY                |
| 2008     | 264738.932 | 3956317.317 | 1.778     | NG                 |
| 2009     | 264719.008 | 3956340.446 | 1.427     | WBY                |
| 2010     | 264707.156 | 3956355.85  | 1.454     | WBY                |
| 2011     | 264691.754 | 3956373.885 | 1.331     | WBY                |
| 2012     | 264676.386 | 3956392.78  | 1.489     | WBY                |
| 2013     | 264657.441 | 3956413.942 | 1.5       | WBY                |
| 2014     | 264643.382 | 3956431.803 | 1.562     | WBY                |
| 2015     | 264627.061 | 3956450.91  | 1.578     | WBY                |
| 2016     | 264609.232 | 3956472.248 | 1.56      | WBY                |
| 2017     | 264591.577 | 3956492.466 | 1.382     | WBY                |
| 2018     | 264576.51  | 3956511.234 | 1.296     | WBY                |
| 2019     | 264562.873 | 3956527.856 | 1.328     | WBY                |
| 2020     | 264546.06  | 3956547.495 | 1.245     | WBY                |
| 2021     | 264530.144 | 3956566.481 | 1.312     | WBY                |
| 2022     | 264514.206 | 3956585.768 | 0.603     | WBY                |
| 2023     | 264498.881 | 3956604.819 | 0.849     | WBY                |
| 2024     | 264483.339 | 3956621.914 | 0.562     | WBY                |
| 2025     | 264463.762 | 3956644.433 | -0.299    | WBY                |
| 2026     | 264450.244 | 3956661.92  | 0.018     | WBY                |
| 2027     | 264433.899 | 3956681.474 | -0.267    | WBY                |
| 2028     | 264418.203 | 3956700.168 | -0.31     | WBY                |
| 2029     | 264403.79  | 3956717.47  | 0.198     | WBY                |
| 2030     | 264386.378 | 3956736.893 | -0.337    | WBY                |
| 2031     | 264369.919 | 3956758.01  | -0.058    | WBY                |
| 2032     | 264355.141 | 3956774.95  | 0.024     | WBY                |
| 2033     | 264338.152 | 3956797.267 | -0.192    | WBY                |
| 2034     | 264324.646 | 3956814.296 | -0.258    | WBY                |
| 2035     | 264302.693 | 3956838.042 | -0.282    | WBY                |
| 2036     | 264288.385 | 3956855.034 | -0.409    | WBY                |
| 2037     | 264274.622 | 3956870.964 | -0.423    | WBY                |
| 2038     | 264257.161 | 3956892.632 | -0.364    | WBY                |
| 2039     | 264241.04  | 3956909.7   | -0.29     | WBY                |
| 2040     | 264223.275 | 3956931.957 | -0.355    | WBY                |
| 2041     | 264207.619 | 3956950.852 | -0.457    | WBY                |

| Point_No | Northing   | Easting     | Elevation | Description |
|----------|------------|-------------|-----------|-------------|
| 2042     | 264191.965 | 3956968.435 | -0.461    | WBY         |
| 2043     | 264191.877 | 3956964.567 | 1.624     | TOW         |
| 2044     | 264083.152 | 3956862.341 | 1.571     | TOW         |
| 2045     | 264084.836 | 3956863.763 | -0.27     | WBY         |
| 2046     | 264094.65  | 3956852.483 | -0.143    | WBY         |
| 2047     | 264111.529 | 3956831.05  | -0.112    | WBY         |
| 2048     | 264125.529 | 3956814.436 | -0.146    | WBY         |
| 2049     | 264144.797 | 3956791.818 | -0.26     | WBY         |
| 2050     | 264160.192 | 3956774.007 | -0.112    | WBY         |
| 2051     | 264170.563 | 3956761.867 | -0.079    | WBY         |
| 2052     | 264191.946 | 3956737.323 | -0.215    | WBY         |
| 2053     | 264207.883 | 3956717.969 | -0.112    | WBY         |
| 2054     | 264228.355 | 3956692.853 | 0.015     | WBY         |
| 2055     | 264241.658 | 3956677.026 | 0.478     | WBY         |
| 2056     | 264256.223 | 3956658.481 | 0.24      | WBY         |
| 2057     | 264273.913 | 3956639.363 | 0.093     | WBY         |
| 2058     | 264292.716 | 3956616.351 | -0.074    | WBY         |
| 2059     | 264306.175 | 3956600.196 | -0.221    | WBY         |
| 2060     | 264320.071 | 3956582.939 | -0.181    | WBY         |
| 2061     | 264337.214 | 3956563     | 0.02      | WBY         |
| 2062     | 264352.453 | 3956545.259 | -0.25     | WBY         |
| 2063     | 264366.116 | 3956528.172 | -0.661    | WBY         |
| 2064     | 264382.344 | 3956509.096 | -0.774    | WBY         |
| 2065     | 264398.064 | 3956489.914 | -0.389    | WBY         |
| 2066     | 264416.787 | 3956468.256 | -0.102    | WBY         |
| 2067     | 264434.146 | 3956448.432 | 0.39      | WBY         |
| 2068     | 264454.799 | 3956422.672 | 0.996     | WBY         |
| 2069     | 264464.863 | 3956409.969 | 1.304     | WBY         |
| 2070     | 264483.334 | 3956388.525 | 1.193     | WBY         |
| 2071     | 264497.367 | 3956371.97  | 1.198     | WBY         |
| 2072     | 264514.983 | 3956352.361 | 1.136     | WBY         |
| 2073     | 264529.736 | 3956332.96  | 1.316     | WBY         |
| 2074     | 264545.101 | 3956315.968 | 1.407     | WBY         |
| 2075     | 264562.373 | 3956294.601 | 1.494     | WBY         |
| 2076     | 264578.685 | 3956275.201 | 1.532     | WBY         |
| 2077     | 264593.515 | 3956258.318 | 1.486     | WBY         |
| 2078     | 264611.963 | 3956236.095 | 1.51      | WBY         |
| 2079     | 264622.81  | 3956224.011 | 1.314     | WBY         |
| 2080     | 264641.264 | 3956200.745 | 1.416     | WBY         |
| 2081     | 264656.13  | 3956182.801 | 1.434     | WBY         |
| 2082     | 264674.672 | 3956162.155 | 1.537     | WBY         |
| 2083     | 264691.437 | 3956141.425 | 1.609     | WBY         |
| 2084     | 264706.422 | 3956124.086 | 1.734     | WBY         |
| 2085     | 264726.168 | 3956100.097 | 1.3       | WBY         |
| 2086     | 264727.69  | 3956110.664 | 2.016     | TOW         |
| 2087     | 276368.185 | 3947243.298 | 3.949     | CHK         |

| Point_No | Northing   | Easting     | Elevation | Description |
|----------|------------|-------------|-----------|-------------|
| 2088     | 267445.237 | 3945645.637 | 7.208     | CHK         |
| 2089     | 280862.493 | 3969412.1   | 0.721     | TOW         |
| 2090     | 280853.697 | 3969421.709 | -2.103    | WBY         |
| 2091     | 280876.791 | 3969408.612 | -0.331    | WBY         |
| 2092     | 280896.991 | 3969397.101 | 0.482     | WBY         |
| 2093     | 280919.42  | 3969382.143 | 0.44      | WBY         |
| 2094     | 280940.885 | 3969370.095 | -0.019    | WBY         |
| 2095     | 280963.919 | 3969357.826 | 0.318     | WBY         |
| 2096     | 280985.319 | 3969344.483 | 0.297     | WBY         |
| 2097     | 281009.496 | 3969331.661 | 0.023     | WBY         |
| 2098     | 281028.396 | 3969321.057 | -0.067    | WBY         |
| 2099     | 281054.249 | 3969306.252 | 0.146     | WBY         |
| 2100     | 281071.999 | 3969296.079 | 0.357     | WBY         |
| 2101     | 281091.879 | 3969284.757 | -0.776    | WBY         |
| 2102     | 281109.072 | 3969274.774 | -0.032    | WBY         |
| 2103     | 281134.781 | 3969259.228 | -0.531    | WBY         |
| 2104     | 281160.777 | 3969245.883 | 0.569     | WBY         |
| 2105     | 281182.137 | 3969236.916 | -0.356    | WBY         |
| 2106     | 281204.952 | 3969224.06  | -1.616    | WBY         |
| 2107     | 281222.07  | 3969205.787 | -2.651    | WBY         |
| 2108     | 281245.887 | 3969195.059 | -2.427    | WBY         |
| 2109     | 281264.255 | 3969183.768 | -2.914    | WBY         |
| 2110     | 281289.425 | 3969170.065 | -3.085    | WBY         |
| 2111     | 281307.875 | 3969157.962 | -3.159    | WBY         |
| 2112     | 281332.539 | 3969144.876 | -2.752    | WBY         |
| 2113     | 281350.793 | 3969134.712 | -3.7405   | SND         |
| 2114     | 281370.944 | 3969120.697 | -3.4405   | SND         |
| 2115     | 281394.938 | 3969109.497 | -4.2405   | SND         |
| 2116     | 281427.061 | 3969098.981 | -4.5405   | SND         |
| 2117     | 281462.186 | 3969072.529 | -4.5405   | SND         |
| 2118     | 281482.678 | 3969058.321 | -4.3405   | SND         |
| 2119     | 281508.684 | 3969041.333 | -4.6405   | SND         |
| 2120     | 281524.18  | 3969034.8   | -4.7405   | SND         |
| 2121     | 281550.022 | 3969015.031 | -4.9405   | SND         |
| 2122     | 281555.931 | 3969009.972 | 0.798     | TOW         |
| 2123     | 281651.645 | 3969126.907 | 0.725     | TOW         |
| 2124     | 281648.594 | 3969133.671 | -4.443    | SND         |
| 2125     | 281643.096 | 3969139.478 | -4.343    | SND         |
| 2126     | 281626.546 | 3969149.606 | -4.543    | SND         |
| 2127     | 281600.731 | 3969163.844 | -4.343    | SND         |
| 2128     | 281582.327 | 3969174.395 | -4.343    | SND         |
| 2129     | 281562.285 | 3969185.982 | -4.243    | SND         |
| 2130     | 281539.001 | 3969201.471 | -4.243    | SND         |
| 2131     | 281511.368 | 3969214.062 | -4.143    | SND         |
| 2132     | 281490.849 | 3969226.492 | -3.543    | SND         |
| 2133     | 281469.79  | 3969239.597 | -3.643    | SND         |

| Point_No | Northing   | Easting     | Elevation | Description |
|----------|------------|-------------|-----------|-------------|
| 2134     | 281447.378 | 3969252.864 | -3.343    | SND         |
| 2135     | 281426.733 | 3969263.85  | -3.343    | SND         |
| 2136     | 281408.646 | 3969274.166 | -3.143    | SND         |
| 2137     | 281384.256 | 3969289.194 | -2.488    | WBY         |
| 2138     | 281362.879 | 3969302.064 | -2.687    | WBY         |
| 2139     | 281338.365 | 3969315.558 | -2.892    | WBY         |
| 2140     | 281318.069 | 3969326.413 | -2.212    | WBY         |
| 2141     | 281298.554 | 3969337.843 | -2.151    | WBY         |
| 2142     | 281275.852 | 3969350.648 | -1.186    | WBY         |
| 2143     | 281253.372 | 3969363.858 | 0.101     | WBY         |
| 2144     | 281231.582 | 3969376.926 | 0.266     | WBY         |
| 2145     | 281210.713 | 3969388.006 | 0.038     | WBY         |
| 2146     | 281188.35  | 3969401.846 | 0.203     | WBY         |
| 2147     | 281165.443 | 3969415.057 | 0.104     | WBY         |
| 2148     | 281144.304 | 3969427.098 | 0.588     | WBY         |
| 2149     | 281123.406 | 3969439.356 | 0.368     | WBY         |
| 2150     | 281100.889 | 3969452.745 | 0.08      | WBY         |
| 2151     | 281079.3   | 3969465.201 | 0.325     | WBY         |
| 2152     | 281057.938 | 3969476.467 | 0.522     | WBY         |
| 2153     | 281035.768 | 3969489.45  | 0.545     | WBY         |
| 2154     | 281013.764 | 3969502.379 | -0.393    | WBY         |
| 2155     | 281000.884 | 3969522.109 | -8.143    | SND         |
| 2156     | 280984.164 | 3969541.939 | -13.143   | SND         |
| 2157     | 280938.897 | 3969543.561 | -13.143   | SND         |
| 2158     | 281009.645 | 3969496.163 | 0.989     | TOW         |
| 2159     | 266003.668 | 3967775.113 | 1.344     | TOW         |
| 2160     | 266000.694 | 3967788.961 | 0.459     | WBY         |
| 2161     | 265978.006 | 3967787.112 | 1.274     | WBY         |
| 2162     | 265954.31  | 3967794.421 | 1.182     | WBY         |
| 2163     | 265930.651 | 3967800.355 | 0.935     | WBY         |
| 2164     | 265906.187 | 3967805.66  | 0.864     | WBY         |
| 2165     | 265882.486 | 3967809.372 | 0.573     | WBY         |
| 2166     | 265858.079 | 3967813.36  | 0.366     | WBY         |
| 2167     | 265833.087 | 3967818.995 | 0.797     | WBY         |
| 2168     | 265807.912 | 3967823.801 | -0.328    | WBY         |
| 2169     | 265785.46  | 3967827.124 | -0.469    | WBY         |
| 2170     | 265757.721 | 3967831.589 | -0.101    | WBY         |
| 2171     | 265733.131 | 3967835.982 | -1.204    | WBY         |
| 2172     | 265708.884 | 3967839.835 | -2.469    | WBY         |
| 2173     | 265686.875 | 3967844.637 | -3.3845   | SND         |
| 2174     | 265663.232 | 3967847.691 | -3.5845   | SND         |
| 2175     | 265636.109 | 3967852.949 | -3.8845   | SND         |
| 2176     | 265611.945 | 3967856.643 | -3.8845   | SND         |
| 2177     | 265619.806 | 3967858.664 | 1.087     | TOW         |
| 2178     | 265585.68  | 3967708.806 | 1.047     | TOW         |
| 2179     | 265586.04  | 3967708.734 | -4.0675   | SND         |

| Point_No | Northing   | Easting     | Elevation | Description |
|----------|------------|-------------|-----------|-------------|
| 2180     | 265612.132 | 3967704.943 | -3.8675   | SND         |
| 2181     | 265637.785 | 3967702.23  | -3.8675   | SND         |
| 2182     | 265657.148 | 3967700.628 | -3.8675   | SND         |
| 2183     | 265683.808 | 3967693.825 | -3.3675   | SND         |
| 2184     | 265710.731 | 3967687.816 | -2.9675   | SND         |
| 2185     | 265734.621 | 3967683.625 | -1.566    | WBY         |
| 2186     | 265760.672 | 3967679.33  | -0.851    | WBY         |
| 2187     | 265782.208 | 3967675.514 | -0.846    | WBY         |
| 2188     | 265809.947 | 3967669.279 | -0.859    | WBY         |
| 2189     | 265833.392 | 3967666.286 | -0.667    | WBY         |
| 2190     | 265857.562 | 3967661.278 | -0.603    | WBY         |
| 2191     | 265881.343 | 3967657.28  | 0.004     | WBY         |
| 2192     | 265909.725 | 3967652.8   | 0.097     | WBY         |
| 2193     | 265932.379 | 3967649.274 | 0.463     | WBY         |
| 2194     | 265957.79  | 3967643.682 | 0.816     | WBY         |
| 2195     | 265983.014 | 3967639.6   | 1.061     | WBY         |
| 2196     | 265978.928 | 3967641.737 | 1.218     | TOW         |
| 2197     | 267445.333 | 3945645.708 | 7.115     | CHK         |
| 2198     | 267445.321 | 3945645.652 | 7.23      | CHK         |
| 2199     | 255140.083 | 3947640.914 | 2.364     | TOW         |
| 2200     | 255116.895 | 3947634.3   | -0.613    | WBY         |
| 2201     | 255137.395 | 3947651.025 | 1.117     | WBY         |
| 2202     | 255157.625 | 3947668.332 | 1.679     | WBY         |
| 2203     | 255175.731 | 3947683.273 | 1.853     | WBY         |
| 2204     | 255197.321 | 3947701.468 | 2.166     | WBY         |
| 2205     | 255214.066 | 3947715.718 | 2.023     | WBY         |
| 2206     | 255233.935 | 3947732.887 | 1.913     | WBY         |
| 2207     | 255251.964 | 3947747.299 | 1.912     | WBY         |
| 2208     | 255270.521 | 3947763.387 | 1.726     | WBY         |
| 2209     | 255290.874 | 3947780.571 | 1.943     | WBY         |
| 2210     | 255310.96  | 3947797.033 | 1.721     | WBY         |
| 2211     | 255328.898 | 3947812.134 | 1.689     | WBY         |
| 2212     | 255347.536 | 3947828.177 | 1.588     | WBY         |
| 2213     | 255367.927 | 3947845.292 | 1.74      | WBY         |
| 2214     | 255388.183 | 3947861.69  | 1.66      | WBY         |
| 2215     | 255406.881 | 3947878.27  | 1.882     | WBY         |
| 2216     | 255425.957 | 3947893.346 | 1.747     | WBY         |
| 2217     | 255443.691 | 3947907.992 | 1.799     | WBY         |
| 2218     | 255463.226 | 3947924.251 | 1.834     | WBY         |
| 2219     | 255481.114 | 3947940.629 | 1.751     | WBY         |
| 2220     | 255500.813 | 3947957.018 | 2.07      | WBY         |
| 2221     | 255519.623 | 3947972.82  | 1.766     | WBY         |
| 2222     | 255540     | 3947988.783 | 2.008     | WBY         |
| 2223     | 255558.929 | 3948004.877 | 1.337     | WBY         |
| 2224     | 255578.066 | 3948021.513 | 1.324     | WBY         |
| 2225     | 255596.954 | 3948037.074 | 1.007     | WBY         |

| Point_No | Northing   | Easting     | Elevation | Description |
|----------|------------|-------------|-----------|-------------|
| 2226     | 255615.305 | 3948053.089 | 1.454     | WBY         |
| 2227     | 255632.876 | 3948067.607 | 0.05      | WBY         |
| 2228     | 255654.542 | 3948086.221 | 0.466     | WBY         |
| 2229     | 255675.953 | 3948102.992 | -0.18     | WBY         |
| 2230     | 255692.496 | 3948117.05  | -0.62     | WBY         |
| 2231     | 255710.699 | 3948133.434 | -0.897    | WBY         |
| 2232     | 255728.732 | 3948149.971 | -1.124    | WBY         |
| 2233     | 255750.995 | 3948166.006 | -1.144    | WBY         |
| 2234     | 255766.267 | 3948180.133 | -1.227    | WBY         |
| 2235     | 255786.232 | 3948195.759 | -1.146    | WBY         |
| 2236     | 255806.401 | 3948212.797 | -1.051    | WBY         |
| 2237     | 255828.478 | 3948231.27  | -1.111    | WBY         |
| 2238     | 255848.285 | 3948247.455 | -1.112    | WBY         |
| 2239     | 255865.652 | 3948262.367 | -1.162    | WBY         |
| 2240     | 255885.416 | 3948277.671 | -1.277    | WBY         |
| 2241     | 255882.534 | 3948278.867 | 2.241     | TOW         |
| 2242     | 255784.909 | 3948397.472 | 2.22      | TOW         |
| 2243     | 255785.138 | 3948390.028 | -1.28     | WBY         |
| 2244     | 255763.97  | 3948372.768 | -1.252    | WBY         |
| 2245     | 255745.996 | 3948358.141 | -1.185    | WBY         |
| 2246     | 255725.419 | 3948340.269 | -1.092    | WBY         |
| 2247     | 255708.169 | 3948327.256 | -1.329    | WBY         |
| 2248     | 255692.244 | 3948312.435 | -1.127    | WBY         |
| 2249     | 255671.62  | 3948293.218 | -0.919    | WBY         |
| 2250     | 255652.394 | 3948279.505 | -0.817    | WBY         |
| 2251     | 255632.772 | 3948262.198 | -0.79     | WBY         |
| 2252     | 255616.218 | 3948249.345 | -0.363    | WBY         |
| 2253     | 255595.071 | 3948231.273 | -0.047    | WBY         |
| 2254     | 255577.202 | 3948215.415 | 1.273     | WBY         |
| 2255     | 255556.526 | 3948199.689 | 1.167     | WBY         |
| 2256     | 255536.771 | 3948182.202 | 1.414     | WBY         |
| 2257     | 255518.403 | 3948166.462 | 1.554     | WBY         |
| 2258     | 255497.434 | 3948149.655 | 1.513     | WBY         |
| 2259     | 255477.689 | 3948132.556 | 1.816     | WBY         |
| 2260     | 255458.814 | 3948116.714 | 1.77      | WBY         |
| 2261     | 255440.771 | 3948101.132 | 1.678     | WBY         |
| 2262     | 255420.805 | 3948085.038 | 1.679     | WBY         |
| 2263     | 255400.851 | 3948067.606 | 1.71      | WBY         |
| 2264     | 255382.5   | 3948052.727 | 1.668     | WBY         |
| 2265     | 255363.765 | 3948037.606 | 1.797     | WBY         |
| 2266     | 255343.275 | 3948019.833 | 1.675     | WBY         |
| 2267     | 255326.395 | 3948006.368 | 1.539     | WBY         |
| 2268     | 255306.299 | 3947988.681 | 1.576     | WBY         |
| 2269     | 255288.247 | 3947973.07  | 1.686     | WBY         |
| 2270     | 255268.671 | 3947957.742 | 1.645     | WBY         |
| 2271     | 255250.112 | 3947941.688 | 1.605     | WBY         |

| Point_No | Northing   | Easting     | Elevation | Description |
|----------|------------|-------------|-----------|-------------|
| 2272     | 255229.464 | 3947924.64  | 1.716     | WBY         |
| 2273     | 255211.234 | 3947908.978 | 1.874     | WBY         |
| 2274     | 255192.321 | 3947893.175 | 1.73      | WBY         |
| 2275     | 255173.892 | 3947877.676 | 1.977     | WBY         |
| 2276     | 255152.995 | 3947859.969 | 1.935     | WBY         |
| 2277     | 255134.71  | 3947844.869 | 1.991     | WBY         |
| 2278     | 255115.45  | 3947827.832 | 1.374     | WBY         |
| 2279     | 255098.077 | 3947813.002 | 1.093     | WBY         |
| 2280     | 255076.619 | 3947796.424 | 0.52      | WBY         |
| 2281     | 255058.995 | 3947780.935 | -3.249    | SND         |
| 2282     | 255046.307 | 3947782.334 | -4.149    | SND         |
| 2283     | 254982.929 | 3947778.467 | -6.149    | SND         |
| 2284     | 255068.584 | 3947792.756 | 2.338     | TOW         |
| 2285     | 254162.927 | 3953729.01  | 1.526     | WBY         |
| 2286     | 254132.444 | 3953741.861 | 1.709     | WBY         |
| 2287     | 254102.396 | 3953754.162 | 1.676     | WBY         |
| 2288     | 254086.232 | 3953762.602 | 1.547     | WBY         |
| 2289     | 254059.87  | 3953771.886 | 1.373     | WBY         |
| 2290     | 254039.986 | 3953778.442 | 1.327     | WBY         |
| 2291     | 254019.283 | 3953788.213 | 1.411     | WBY         |
| 2292     | 253995.442 | 3953796.648 | 1.489     | WBY         |
| 2293     | 253971.949 | 3953807.114 | 1.414     | WBY         |
| 2294     | 253949.952 | 3953815.531 | 1.222     | WBY         |
| 2295     | 253926.216 | 3953825.241 | 1.337     | WBY         |
| 2296     | 253932.483 | 3953826.458 | 2.071     | TOW         |
| 2297     | 253905.184 | 3953834.405 | 1.58      | WBY         |
| 2298     | 253879.736 | 3953844.057 | 1.074     | WBY         |
| 2299     | 253860.339 | 3953852.023 | -0.236    | WBY         |
| 2300     | 253832.267 | 3953862.841 | -0.709    | WBY         |
| 2301     | 253810.903 | 3953872.059 | -0.879    | WBY         |
| 2302     | 253789.615 | 3953880.822 | 0.114     | WBY         |
| 2303     | 253767.614 | 3953889.742 | 0.55      | WBY         |
| 2304     | 253739.376 | 3953899.658 | 0.549     | WBY         |
| 2305     | 253716.116 | 3953911.385 | 0.687     | WBY         |
| 2306     | 253690.191 | 3953920.281 | 0.953     | WBY         |
| 2307     | 253673.108 | 3953927.773 | 1.09      | WBY         |
| 2308     | 253662.873 | 3953931.585 | 1.001     | WBY         |
| 2309     | 253647.161 | 3953938.696 | 0.915     | WBY         |
| 2310     | 253624.444 | 3953947.113 | 0.484     | WBY         |
| 2311     | 253598.934 | 3953957.982 | 1.092     | WBY         |
| 2312     | 253580.317 | 3953964.741 | 0.708     | WBY         |
| 2313     | 253557.176 | 3953974.63  | 0.574     | WBY         |
| 2314     | 253530.391 | 3953985.845 | 0.084     | WBY         |
| 2315     | 253507.536 | 3953994.246 | -0.208    | WBY         |
| 2316     | 253484.425 | 3954003.485 | 0.335     | WBY         |
| 2317     | 253458.505 | 3954014.773 | 0.405     | WBY         |

| Point_No | Northing   | Easting     | Elevation | Description |
|----------|------------|-------------|-----------|-------------|
| 2318     | 253441.894 | 3954020.389 | 1.249     | WBY         |
| 2319     | 253415.698 | 3954031.935 | 1.4       | WBY         |
| 2320     | 253392.088 | 3954041.38  | 0.987     | WBY         |
| 2321     | 253368.758 | 3954050.543 | 1.013     | WBY         |
| 2322     | 253346.643 | 3954059.021 | 1.119     | WBY         |
| 2323     | 253323.923 | 3954068.516 | 0.975     | WBY         |
| 2324     | 253300.821 | 3954078.156 | 1.024     | WBY         |
| 2325     | 253278.341 | 3954087.47  | 1.227     | WBY         |
| 2326     | 253254.494 | 3954096.309 | 1.347     | WBY         |
| 2327     | 253230.156 | 3954106.693 | 1.187     | WBY         |
| 2328     | 253206.905 | 3954116.247 | 1.13      | WBY         |
| 2329     | 253184.334 | 3954125.795 | 0.826     | WBY         |
| 2330     | 253161.531 | 3954133.965 | 1.409     | WBY         |
| 2331     | 253136.349 | 3954144.432 | 1.395     | WBY         |
| 2332     | 253115.017 | 3954153.089 | 0.794     | WBY         |
| 2333     | 253091.555 | 3954162.336 | 1.103     | WBY         |
| 2334     | 253068.872 | 3954171.58  | 1.149     | WBY         |
| 2335     | 253044.982 | 3954181.557 | 0.507     | WBY         |
| 2336     | 253019.758 | 3954191.503 | 0.327     | WBY         |
| 2337     | 252997.767 | 3954201.52  | 0.239     | WBY         |
| 2338     | 252977.545 | 3954207.831 | -0.068    | WBY         |
| 2339     | 252952.33  | 3954216.565 | 0.292     | WBY         |
| 2340     | 252926.291 | 3954227.053 | 0.63      | WBY         |
| 2341     | 267445.272 | 3945645.647 | 7.247     | CHK         |
| 2342     | 276368.257 | 3947243.324 | 3.959     | CHK         |
| 2343     | 254257.565 | 3953699.628 | 2.452     | TOW         |
| 2344     | 254306.77  | 3953696.2   | -7.5885   | SND         |
| 2345     | 254291.213 | 3953678.672 | -6.7885   | SND         |
| 2346     | 254266.672 | 3953694.934 | -2.0885   | SND         |
| 2347     | 254251.153 | 3953692.296 | 1.402     | WBY         |
| 2348     | 254226.083 | 3953704.053 | 1.39      | WBY         |
| 2349     | 254201.946 | 3953713.455 | 1.711     | WBY         |
| 2350     | 254178.739 | 3953722.854 | 1.44      | WBY         |
| 2351     | 254156.459 | 3953731.937 | 1.737     | WBY         |
| 2352     | 252887.745 | 3954244.856 | 1.494     | WBY         |
| 2353     | 252856.705 | 3954258.036 | 0.231     | WBY         |
| 2354     | 252834.356 | 3954266.134 | 0.264     | WBY         |
| 2355     | 252810.971 | 3954276.409 | -0.109    | WBY         |
| 2356     | 252790.742 | 3954288.449 | -0.288    | WBY         |
| 2357     | 252763.56  | 3954295.45  | -0.324    | WBY         |
| 2358     | 252742.039 | 3954303.466 | -0.382    | WBY         |
| 2359     | 252715.842 | 3954314.63  | -0.429    | WBY         |
| 2360     | 252696.669 | 3954322.538 | -0.519    | WBY         |
| 2361     | 252669.511 | 3954332.548 | -0.328    | WBY         |
| 2362     | 252669.803 | 3954333.198 | 2.371     | TOW         |
| 2363     | 252735.11  | 3954480.348 | 2.388     | TOW         |

| Point_No | Northing   | Easting     | Elevation | Description |
|----------|------------|-------------|-----------|-------------|
| 2364     | 252734.165 | 3954468.32  | -0.38     | WBY         |
| 2365     | 252772.602 | 3954453.355 | -0.404    | WBY         |
| 2366     | 252811.898 | 3954445.062 | -0.123    | WBY         |
| 2367     | 252828.478 | 3954430.902 | -0.292    | WBY         |
| 2368     | 252849.428 | 3954421.192 | 0.134     | WBY         |
| 2369     | 252870.968 | 3954413.712 | 0.303     | WBY         |
| 2370     | 252896.7   | 3954404.002 | 0.418     | WBY         |
| 2371     | 252917.674 | 3954395.203 | 0.704     | WBY         |
| 2372     | 252942.296 | 3954384.279 | 1.364     | WBY         |
| 2373     | 252964.561 | 3954375.144 | 0.754     | WBY         |
| 2374     | 252986.207 | 3954367.124 | 0.679     | WBY         |
| 2375     | 253021.499 | 3954353.105 | 0.793     | WBY         |
| 2376     | 253036.047 | 3954346.655 | 1.102     | WBY         |
| 2377     | 253057.298 | 3954338.027 | 1.188     | WBY         |
| 2378     | 253080.443 | 3954328.241 | 0.916     | WBY         |
| 2379     | 253106.05  | 3954318.724 | 0.957     | WBY         |
| 2380     | 253122.277 | 3954312.025 | 0.924     | WBY         |
| 2381     | 253149.054 | 3954301.234 | 0.969     | WBY         |
| 2382     | 253173.201 | 3954290.324 | -0.175    | WBY         |
| 2383     | 253191.952 | 3954282.82  | 0.61      | WBY         |
| 2384     | 253217.149 | 3954273.499 | 0.972     | WBY         |
| 2385     | 253242.03  | 3954263.425 | 1.061     | WBY         |
| 2386     | 253264.435 | 3954252.408 | 0.723     | WBY         |
| 2387     | 253294.423 | 3954239.686 | 1.015     | WBY         |
| 2388     | 253312.775 | 3954234.43  | 0.912     | WBY         |
| 2389     | 253334.239 | 3954224.952 | 0.785     | WBY         |
| 2390     | 253360.171 | 3954215.041 | 1.011     | WBY         |
| 2391     | 253381.843 | 3954206.281 | 1.018     | WBY         |
| 2392     | 253404.269 | 3954197.978 | 1.01      | WBY         |
| 2393     | 253428.045 | 3954188.072 | 1.119     | WBY         |
| 2394     | 253447.152 | 3954179.735 | 1.335     | WBY         |
| 2395     | 253472.342 | 3954170.524 | 0.99      | WBY         |
| 2396     | 253491.28  | 3954163.002 | 0.64      | WBY         |
| 2397     | 253522.025 | 3954149.856 | 1.144     | WBY         |
| 2398     | 253543.569 | 3954140.861 | 1.102     | WBY         |
| 2399     | 253568     | 3954132.194 | 1.104     | WBY         |
| 2400     | 253590.492 | 3954121.897 | 1.421     | WBY         |
| 2401     | 253612.988 | 3954112.225 | 1.246     | WBY         |
| 2402     | 253637.187 | 3954103.867 | 1.105     | WBY         |
| 2403     | 253658.245 | 3954095.9   | 1.379     | WBY         |
| 2404     | 253683.86  | 3954084.697 | 1.302     | WBY         |
| 2405     | 253705.061 | 3954076.393 | 1.307     | WBY         |
| 2406     | 253727.332 | 3954067.206 | 1.399     | WBY         |
| 2407     | 253751.416 | 3954056.945 | 1.139     | WBY         |
| 2408     | 253775.557 | 3954048.521 | 1.079     | WBY         |
| 2409     | 253796.816 | 3954038.344 | 1.673     | WBY         |

| Point_No | Northing   | Easting     | Elevation | Description |
|----------|------------|-------------|-----------|-------------|
| 2410     | 253822.008 | 3954028.26  | 1.313     | WBY         |
| 2411     | 253844.999 | 3954019.608 | 1.332     | WBY         |
| 2412     | 253870.879 | 3954009.305 | 1.388     | WBY         |
| 2413     | 253890.372 | 3954001.526 | 1.283     | WBY         |
| 2414     | 253914.216 | 3953992.183 | 1.522     | WBY         |
| 2415     | 253937.604 | 3953981.313 | 1.424     | WBY         |
| 2416     | 253960.331 | 3953972.683 | 1.57      | WBY         |
| 2417     | 253981.982 | 3953964.203 | 1.662     | WBY         |
| 2418     | 254006.854 | 3953953.622 | 1.624     | WBY         |
| 2419     | 254029.45  | 3953944.612 | 1.643     | WBY         |
| 2420     | 254052.638 | 3953935.499 | 1.623     | WBY         |
| 2421     | 254076.217 | 3953925.461 | 1.366     | WBY         |
| 2422     | 254101.917 | 3953916.109 | 1.632     | WBY         |
| 2423     | 254194.391 | 3953878.896 | 1.019     | WBY         |
| 2424     | 254216.505 | 3953870.255 | -5.605    | SND         |
| 2425     | 254205.219 | 3953876.123 | 2.402     | TOW         |
| 2426     | 276368.26  | 3947243.286 | 3.97      | CHK         |
| 2429     | 227081.94  | 3972438.759 | -4.196    | SND         |
| 2430     | 227081.215 | 3972467.796 | 0.468     | WBY         |
| 2431     | 227087.192 | 3972488.133 | 0.613     | WBY         |
| 2432     | 227093.331 | 3972509.148 | 0.94      | WBY         |
| 2433     | 227100.925 | 3972535.464 | 0.546     | WBY         |
| 2434     | 227106.179 | 3972559.955 | 0.265     | WBY         |
| 2435     | 227109.093 | 3972583.981 | 0.376     | WBY         |
| 2436     | 227117.557 | 3972607.305 | 0.445     | WBY         |
| 2437     | 227126.991 | 3972635.575 | 0.347     | WBY         |
| 2438     | 227131.686 | 3972653.472 | 0.218     | WBY         |
| 2439     | 227140.077 | 3972682.263 | 0.044     | WBY         |
| 2440     | 227146.324 | 3972705.848 | -0.389    | WBY         |
| 2441     | 227151.893 | 3972727.59  | -0.623    | WBY         |
| 2442     | 227158.098 | 3972752.57  | -1.015    | WBY         |
| 2443     | 227164.513 | 3972776.254 | -1.531    | WBY         |
| 2444     | 227171.917 | 3972803.041 | -1.738    | WBY         |
| 2445     | 227180.416 | 3972829.959 | -2.003    | WBY         |
| 2446     | 227185.534 | 3972844.901 | -2.061    | WBY         |
| 2447     | 227189.994 | 3972870.421 | -2.049    | WBY         |
| 2448     | 227196.295 | 3972897.028 | -2.224    | WBY         |
| 2449     | 227203.432 | 3972921.939 | -2.175    | WBY         |
| 2450     | 227210.558 | 3972944.278 | -2.452    | WBY         |
| 2451     | 227216.847 | 3972971.59  | -2.504    | WBY         |
| 2452     | 227224.205 | 3973000.163 | -2.441    | WBY         |
| 2453     | 227233.541 | 3973020.15  | -2.241    | WBY         |
| 2454     | 227236.57  | 3973042.761 | -2.488    | WBY         |
| 2455     | 227241.223 | 3973063.867 | -2.51     | WBY         |
| 2456     | 227247.767 | 3973088.565 | -2.457    | WBY         |
| 2457     | 227255.796 | 3973115.892 | -2.426    | WBY         |

| Point_No | Northing   | Easting     | Elevation | Description |
|----------|------------|-------------|-----------|-------------|
| 2458     | 227259.203 | 3973140.06  | -2.723    | WBY         |
| 2459     | 227269.442 | 3973164.934 | -2.414    | WBY         |
| 2460     | 227274.506 | 3973190.086 | -2.551    | WBY         |
| 2461     | 227273.361 | 3973188.521 | 1.352     | TOW         |
| 2462     | 227130.904 | 3973228.608 | 1.312     | TOW         |
| 2464     | 226940.155 | 3972519.104 | -8.6825   | SND         |
| 2465     | 226927.593 | 3972522.62  | -8.4825   | SND         |
| 2466     | 226951.915 | 3972551.936 | -1.6825   | SND         |
| 2467     | 226955.157 | 3972576.409 | 0.418     | WBY         |
| 2468     | 226963.022 | 3972599.831 | 0.787     | WBY         |
| 2469     | 226969.083 | 3972623.482 | 0.78      | WBY         |
| 2470     | 226975.985 | 3972647.595 | 0.5       | WBY         |
| 2471     | 226981.358 | 3972670.767 | 0.52      | WBY         |
| 2472     | 226987.716 | 3972694.146 | 0.41      | WBY         |
| 2473     | 226993.693 | 3972716.502 | 0.608     | WBY         |
| 2474     | 227000.281 | 3972741.601 | 0.096     | WBY         |
| 2475     | 227007.388 | 3972768.758 | -1.001    | WBY         |
| 2476     | 227013.58  | 3972793.271 | -1.381    | WBY         |
| 2477     | 227019.578 | 3972814.597 | -1.251    | WBY         |
| 2478     | 227025.819 | 3972840.837 | -1.616    | WBY         |
| 2479     | 227033.484 | 3972866.548 | -1.881    | WBY         |
| 2480     | 227039.064 | 3972886.715 | -1.835    | WBY         |
| 2481     | 227045.109 | 3972910.42  | -1.847    | WBY         |
| 2482     | 227050.847 | 3972931.157 | -1.923    | WBY         |
| 2483     | 227061.113 | 3972959.708 | -2.176    | WBY         |
| 2484     | 227065.421 | 3972986.615 | -2.126    | WBY         |
| 2485     | 227076.696 | 3973028.352 | -2.268    | WBY         |
| 2486     | 227084.95  | 3973055.017 | -2.296    | WBY         |
| 2487     | 227092.071 | 3973081.13  | -2.238    | WBY         |
| 2488     | 227097.079 | 3973107.546 | -2.333    | WBY         |
| 2489     | 227102.223 | 3973125.058 | -2.271    | WBY         |
| 2490     | 227108.94  | 3973151.917 | -2.202    | WBY         |
| 2491     | 227113.303 | 3973174.824 | -2.35     | WBY         |
| 2492     | 227122.916 | 3973199.6   | -2.391    | WBY         |
| 2493     | 227127.727 | 3973221.04  | -2.33     | WBY         |
| 2494     | 227126.509 | 3973218.695 | 1.323     | TOW         |
| 2495     | 215471.273 | 3958529.205 | 2.274     | TOW         |
| 2496     | 215456.294 | 3958481.446 | -0.9625   | SND         |
| 2497     | 215453.176 | 3958512.069 | -0.4625   | SND         |
| 2499     | 215443.978 | 3958555.916 | -0.35     | WBY         |
| 2500     | 215440.051 | 3958581.025 | -0.096    | WBY         |
| 2501     | 215434.996 | 3958605.645 | 0.221     | WBY         |
| 2502     | 215431.993 | 3958627.128 | 0.291     | WBY         |
| 2503     | 215426.252 | 3958654.056 | 0.477     | WBY         |
| 2504     | 215422.965 | 3958678.789 | 0.766     | WBY         |
| 2505     | 215418.144 | 3958701.435 | 0.916     | WBY         |

| Point_No | Northing   | Easting     | Elevation | Description |
|----------|------------|-------------|-----------|-------------|
| 2506     | 215414.077 | 3958725.904 | 0.815     | WBY         |
| 2507     | 215408.85  | 3958752.808 | 0.787     | WBY         |
| 2508     | 215405.024 | 3958773.679 | 0.964     | WBY         |
| 2509     | 215400.283 | 3958802.501 | 0.829     | WBY         |
| 2510     | 215396.309 | 3958827.075 | 0.734     | WBY         |
| 2511     | 215392.348 | 3958849.411 | 0.713     | WBY         |
| 2512     | 215387.702 | 3958875.974 | 0.71      | WBY         |
| 2513     | 215384.279 | 3958897.893 | 0.736     | WBY         |
| 2514     | 215379.279 | 3958922.94  | 0.618     | WBY         |
| 2515     | 215374.473 | 3958950.344 | 0.737     | WBY         |
| 2516     | 215369.905 | 3958972.067 | 0.385     | WBY         |
| 2517     | 215365.815 | 3958998.579 | 0.089     | WBY         |
| 2518     | 215361.521 | 3959021.63  | 0.118     | WBY         |
| 2519     | 215357.288 | 3959047.015 | 0.042     | WBY         |
| 2520     | 215352.773 | 3959072.404 | 0.296     | WBY         |
| 2521     | 215348.672 | 3959095.477 | -0.502    | WBY         |
| 2522     | 215343.887 | 3959122.234 | -0.384    | WBY         |
| 2523     | 215339.591 | 3959143.993 | -0.875    | WBY         |
| 2524     | 215335.435 | 3959172.072 | -0.982    | WBY         |
| 2525     | 215331.601 | 3959197.001 | -1.177    | WBY         |
| 2526     | 215328.509 | 3959224.122 | -1.79     | WBY         |
| 2527     | 215323.482 | 3959246.82  | -1.104    | WBY         |
| 2528     | 215318.06  | 3959266.056 | -1.453    | WBY         |
| 2529     | 215313.579 | 3959297.226 | -2.215    | WBY         |
| 2530     | 215312.331 | 3959317.148 | -3.1625   | SND         |
| 2531     | 215308.691 | 3959339.066 | -3.4625   | SND         |
| 2532     | 215303.374 | 3959364.671 | -3.7625   | SND         |
| 2533     | 215296.995 | 3959387.824 | -3.5625   | SND         |
| 2534     | 215293.852 | 3959408.333 | -3.8625   | SND         |
| 2535     | 215290.113 | 3959437.626 | -3.6625   | SND         |
| 2536     | 215286.446 | 3959466.985 | -3.4625   | SND         |
| 2537     | 215294.211 | 3959467.608 | 1.801     | TOW         |
| 2538     | 215279.774 | 3958600.572 | 2.201     | TOW         |
| 2539     | 215301.414 | 3958539.65  | -6.026    | SND         |
| 2540     | 215293.578 | 3958556.542 | -3.026    | SND         |
| 2541     | 215286.307 | 3958577.616 | -1.526    | SND         |
| 2542     | 215284.419 | 3958598.441 | -0.227    | WBY         |
| 2543     | 215279.489 | 3958627.127 | 0.022     | WBY         |
| 2544     | 215274.358 | 3958650.507 | -0.044    | WBY         |
| 2545     | 215270.184 | 3958679.002 | 0.336     | WBY         |
| 2546     | 215266.514 | 3958698.559 | 0.263     | WBY         |
| 2547     | 215262.204 | 3958724.527 | 0.219     | WBY         |
| 2548     | 215257.498 | 3958749.077 | 0.202     | WBY         |
| 2549     | 215253.033 | 3958774.18  | 0.44      | WBY         |
| 2550     | 215250.068 | 3958796.506 | 0.823     | WBY         |
| 2551     | 215244.062 | 3958825.862 | 0.736     | WBY         |

| Point_No | Northing   | Easting     | Elevation | Description |
|----------|------------|-------------|-----------|-------------|
| 2552     | 215240.133 | 3958846.491 | 0.967     | WBY         |
| 2553     | 215236.004 | 3958870.478 | 0.826     | WBY         |
| 2554     | 215230.881 | 3958898.677 | 0.836     | WBY         |
| 2555     | 215226.949 | 3958924.867 | 0.89      | WBY         |
| 2556     | 215222.323 | 3958945.705 | 0.863     | WBY         |
| 2557     | 215219.093 | 3958968.962 | 0.661     | WBY         |
| 2558     | 215214.715 | 3958993.983 | 0.155     | WBY         |
| 2559     | 215210.488 | 3959020.298 | 0.5       | WBY         |
| 2560     | 215205.149 | 3959045.945 | 0.291     | WBY         |
| 2561     | 215200.417 | 3959070.237 | 0.762     | WBY         |
| 2562     | 215197.038 | 3959093.749 | 0.306     | WBY         |
| 2563     | 215192.962 | 3959120.158 | -0.192    | WBY         |
| 2564     | 215188.079 | 3959144.643 | 0.018     | WBY         |
| 2565     | 215184.736 | 3959166.758 | -0.052    | WBY         |
| 2566     | 215179.371 | 3959192.217 | -0.03     | WBY         |
| 2567     | 215174.778 | 3959214.312 | -0.241    | WBY         |
| 2568     | 215170.174 | 3959243.784 | 0.043     | WBY         |
| 2569     | 215165.96  | 3959268.879 | -0.491    | WBY         |
| 2570     | 215162.67  | 3959290.664 | -1.369    | WBY         |
| 2571     | 215160.718 | 3959315.01  | -0.497    | WBY         |
| 2572     | 215154.432 | 3959340.971 | -0.944    | WBY         |
| 2573     | 215148.389 | 3959367.152 | -1.229    | WBY         |
| 2574     | 215144.827 | 3959393.08  | -0.919    | WBY         |
| 2575     | 215139.468 | 3959417.945 | -1.307    | WBY         |
| 2576     | 215135.839 | 3959443.555 | -1.795    | WBY         |
| 2577     | 215133.657 | 3959445.079 | 1.747     | TOW         |
| 2578     | 227724.727 | 3948823.097 | 2.669     | TOW         |
| 2579     | 226829.651 | 3947718.429 | 0.426     | WBY         |
| 2580     | 226843.789 | 3947742.475 | 0.335     | WBY         |
| 2581     | 226855.494 | 3947760.839 | 1.031     | WBY         |
| 2582     | 226870.468 | 3947780.314 | 1.024     | WBY         |
| 2583     | 226885.115 | 3947801.197 | 1.07      | WBY         |
| 2584     | 226901.066 | 3947825.576 | 1.232     | WBY         |
| 2585     | 226914.847 | 3947843.577 | 1.242     | WBY         |
| 2586     | 226928.603 | 3947863.959 | 1.515     | WBY         |
| 2587     | 226943.098 | 3947884.237 | 1.634     | WBY         |
| 2588     | 226957.946 | 3947905.946 | 1.744     | WBY         |
| 2589     | 226973.599 | 3947927.411 | 1.463     | WBY         |
| 2590     | 226987.521 | 3947948.561 | 1.449     | WBY         |
| 2591     | 226999.696 | 3947965.218 | 1.429     | WBY         |
| 2592     | 227014.788 | 3947987     | 1.523     | WBY         |
| 2593     | 227028.29  | 3948005.552 | 1.754     | WBY         |
| 2594     | 227043.278 | 3948026.579 | 1.534     | WBY         |
| 2595     | 227071.218 | 3948069.221 | 1.668     | WBY         |
| 2596     | 227085.543 | 3948088.255 | 1.756     | WBY         |
| 2597     | 227100.34  | 3948109.786 | 1.955     | WBY         |

| Point_No | Northing   | Easting     | Elevation | Description |
|----------|------------|-------------|-----------|-------------|
| 2598     | 227116.077 | 3948130.612 | 1.567     | WBY         |
| 2599     | 227131.19  | 3948154.039 | -0.371    | WBY         |
| 2601     | 227155.101 | 3948190.647 | -4.0425   | SND         |
| 2602     | 227171.24  | 3948213.547 | -3.9425   | SND         |
| 2603     | 227189.601 | 3948233.56  | -3.5425   | SND         |
| 2604     | 227202.698 | 3948255.13  | -4.5425   | SND         |
| 2605     | 227218.548 | 3948275.391 | -4.6425   | SND         |
| 2606     | 227231.644 | 3948294.554 | -4.5425   | SND         |
| 2607     | 227247.114 | 3948316.521 | -4.6425   | SND         |
| 2608     | 227258.077 | 3948334.694 | -4.7425   | SND         |
| 2609     | 227272.013 | 3948353.082 | -4.6425   | SND         |
| 2610     | 227286.299 | 3948376.301 | -4.8425   | SND         |
| 2611     | 227300.052 | 3948394.522 | -4.0425   | SND         |
| 2612     | 227315.161 | 3948415.241 | -2.5425   | SND         |
| 2613     | 227331.352 | 3948439.631 | -1.8425   | SND         |
| 2614     | 227343.904 | 3948456.739 | 0.4575    | SND         |
| 2615     | 227361.427 | 3948481.562 | 0.09      | WBY         |
| 2616     | 227371.602 | 3948498.535 | -0.185    | WBY         |
| 2617     | 227385.758 | 3948517.34  | 0.652     | WBY         |
| 2618     | 227401.002 | 3948539.323 | 0.241     | WBY         |
| 2619     | 227417.026 | 3948561.3   | 0.525     | WBY         |
| 2620     | 227428.843 | 3948579.007 | 0.185     | WBY         |
| 2621     | 227445.086 | 3948600.598 | -0.77     | WBY         |
| 2622     | 227461.511 | 3948624.046 | -2.2425   | SND         |
| 2623     | 227477.466 | 3948646.536 | -3.2425   | SND         |
| 2624     | 227486.102 | 3948662.701 | -2.9425   | SND         |
| 2625     | 238749.516 | 3953565.96  | 3.928     | CHK         |
| 2626     | 227475.883 | 3948623.485 | 2.246     | TOW         |
| 2627     | 227498.221 | 3948677.974 | -2.6425   | SND         |
| 2628     | 227514.822 | 3948700.79  | -2.5425   | SND         |
| 2629     | 227529.995 | 3948719.628 | -2.5425   | SND         |
| 2630     | 227544.459 | 3948740.95  | -2.3425   | SND         |
| 2631     | 227558.713 | 3948759.899 | -2.2425   | SND         |
| 2632     | 227571.733 | 3948785.597 | -2.5425   | SND         |
| 2633     | 227587.36  | 3948803.925 | -2.4425   | SND         |
| 2634     | 227599.136 | 3948822.428 | -2.4425   | SND         |
| 2635     | 227615.091 | 3948846.893 | -2.2425   | SND         |
| 2636     | 227625.879 | 3948862.089 | -3.5425   | SND         |
| 2637     | 227643.833 | 3948886.645 | -2.3425   | SND         |
| 2638     | 227659.718 | 3948906.513 | -2.6425   | SND         |
| 2639     | 227671.155 | 3948924.834 | -2.4425   | SND         |
| 2640     | 227690.901 | 3948946.695 | -2.5425   | SND         |
| 2641     | 227694.482 | 3948937.335 | 2.375     | TOW         |
| 2642     | 226869.608 | 3947691.471 | 0.678     | WBY         |
| 2643     | 226846.885 | 3947706.1   | 0.462     | WBY         |
| 2644     | 226828.632 | 3947720.754 | 0.458     | WBY         |

| Point_No | Northing   | Easting     | Elevation | Description |
|----------|------------|-------------|-----------|-------------|
| 2645     | 226803.789 | 3947739.478 | 0.579     | WBY         |
| 2646     | 226791.943 | 3947750.079 | 1.097     | WBY         |
| 2647     | 226766.563 | 3947762.698 | 1.252     | WBY         |
| 2648     | 226745.748 | 3947777.18  | 1.44      | WBY         |
| 2649     | 226723.511 | 3947791.669 | 1.563     | WBY         |
| 2650     | 226704.806 | 3947806.051 | 1.739     | WBY         |
| 2651     | 226682.906 | 3947821.203 | 1.581     | WBY         |
| 2652     | 226663.081 | 3947834.579 | 2.031     | WBY         |
| 2653     | 226653.329 | 3947840.903 | -3.582    | SND         |
| 2654     | 226651.221 | 3947849.332 | -6.582    | SND         |
| 2655     | 226642.821 | 3947857.655 | -7.582    | SND         |
| 2656     | 226632.997 | 3947863.017 | -7.682    | SND         |
| 2657     | 226622.644 | 3947866.463 | -7.382    | SND         |
| 2658     | 226616.635 | 3947872.468 | -6.782    | SND         |
| 2659     | 226610.181 | 3947880.502 | -6.582    | SND         |
| 2660     | 226599.16  | 3947885.755 | -5.382    | SND         |
| 2661     | 226590.719 | 3947889.099 | -3.382    | SND         |
| 2662     | 226583.299 | 3947895.318 | -1.482    | SND         |
| 2663     | 226581.422 | 3947903.38  | -1.361    | WBY         |
| 2664     | 226562.91  | 3947911.987 | 1.208     | WBY         |
| 2665     | 226543.895 | 3947922.727 | 1.442     | WBY         |
| 2666     | 226951.662 | 3947816.037 | 1.17      | WBY         |
| 2667     | 226934.714 | 3947828.203 | 1.315     | WBY         |
| 2668     | 226915.013 | 3947842.078 | 1.214     | WBY         |
| 2669     | 226893.136 | 3947857.133 | 1.45      | WBY         |
| 2670     | 226874.314 | 3947870.002 | 1.464     | WBY         |
| 2671     | 226852.237 | 3947885.356 | 1.573     | WBY         |
| 2672     | 226832.999 | 3947899.835 | 1.86      | WBY         |
| 2673     | 226815.573 | 3947904.285 | 0.032     | WBY         |
| 2674     | 226813.19  | 3947913.481 | -5.582    | SND         |
| 2675     | 226810.698 | 3947916.435 | -6.782    | SND         |
| 2676     | 226802.438 | 3947929.058 | -7.682    | SND         |
| 2677     | 226791.296 | 3947932.585 | -7.382    | SND         |
| 2678     | 226781.506 | 3947937.852 | -7.382    | SND         |
| 2679     | 226773.491 | 3947942.627 | -7.082    | SND         |
| 2680     | 226766.976 | 3947949.03  | -7.082    | SND         |
| 2681     | 226760.124 | 3947956.145 | -5.582    | SND         |
| 2682     | 226751.267 | 3947960.979 | -4.982    | SND         |
| 2683     | 226743.859 | 3947968.165 | -0.582    | SND         |
| 2684     | 226730.858 | 3947974.054 | 1.366     | WBY         |
| 2685     | 226708.678 | 3947987.023 | 1.481     | WBY         |
| 2686     | 226689.741 | 3947999.6   | 1.421     | WBY         |
| 2687     | 227041.39  | 3947935.705 | 1.181     | WBY         |
| 2688     | 227018.391 | 3947953.68  | 1.519     | WBY         |
| 2689     | 227000.091 | 3947965.903 | 1.487     | WBY         |
| 2690     | 226977.404 | 3947979.594 | 1.643     | WBY         |

| Point_No | Northing   | Easting     | Elevation | Description |
|----------|------------|-------------|-----------|-------------|
| 2691     | 226961.534 | 3947991.881 | 1.847     | WBY         |
| 2692     | 226950.515 | 3948000.614 | -6.282    | SND         |
| 2693     | 226943.405 | 3948009.675 | -7.082    | SND         |
| 2694     | 226934.549 | 3948014.683 | -7.382    | SND         |
| 2695     | 226925.328 | 3948020.102 | -7.582    | SND         |
| 2696     | 226916.886 | 3948022.671 | -7.782    | SND         |
| 2697     | 226905.955 | 3948026.353 | -7.782    | SND         |
| 2698     | 226900.447 | 3948036.844 | -6.582    | SND         |
| 2699     | 226894.885 | 3948043.983 | -3.582    | SND         |
| 2700     | 226886.154 | 3948049.223 | -1.582    | SND         |
| 2701     | 226878.014 | 3948056.425 | 1.689     | WBY         |
| 2702     | 226856.417 | 3948065.066 | 1.465     | WBY         |
| 2703     | 226834.121 | 3948077.461 | 1.642     | WBY         |
| 2704     | 227128.846 | 3948060.59  | 1.555     | WBY         |
| 2705     | 227105.953 | 3948074.607 | 1.513     | WBY         |
| 2706     | 227088.969 | 3948087.845 | 1.602     | WBY         |
| 2707     | 227073.303 | 3948096.3   | -1.303    | WBY         |
| 2708     | 227070.428 | 3948102.22  | -5.582    | SND         |
| 2709     | 227062.21  | 3948111.788 | -7.582    | SND         |
| 2710     | 227054.052 | 3948117.025 | -8.082    | SND         |
| 2711     | 227045.348 | 3948120.628 | -8.382    | SND         |
| 2712     | 227037.473 | 3948125.324 | -8.582    | SND         |
| 2713     | 227030.639 | 3948133.962 | -8.582    | SND         |
| 2714     | 227017.769 | 3948133.699 | -7.582    | SND         |
| 2715     | 227007.872 | 3948138.496 | -5.582    | SND         |
| 2716     | 227002.901 | 3948146.704 | -2.582    | SND         |
| 2717     | 226984.244 | 3948161.094 | 1.819     | WBY         |
| 2718     | 226962.681 | 3948173.16  | 1.601     | WBY         |
| 2719     | 227214.034 | 3948182.766 | 1.551     | WBY         |
| 2720     | 227191.353 | 3948197.883 | 1.668     | WBY         |
| 2721     | 227177.094 | 3948205.855 | -0.142    | WBY         |
| 2722     | 227171.182 | 3948215.213 | -6.282    | SND         |
| 2723     | 227164.657 | 3948222.43  | -7.582    | SND         |
| 2724     | 227156.883 | 3948229.22  | -8.782    | SND         |
| 2725     | 227148.328 | 3948232.688 | -9.582    | SND         |
| 2726     | 227137.434 | 3948235.012 | -9.582    | SND         |
| 2727     | 227127.119 | 3948237.926 | -8.582    | SND         |
| 2728     | 227116.83  | 3948239.612 | -7.082    | SND         |
| 2729     | 227089.453 | 3948268.673 | 1.774     | WBY         |
| 2730     | 227071.363 | 3948278.805 | 1.697     | WBY         |
| 2731     | 227300.249 | 3948307.405 | 1.379     | WBY         |
| 2732     | 227276.223 | 3948321.962 | 1.48      | WBY         |
| 2733     | 227267.906 | 3948326.294 | 0.418     | SND         |
| 2734     | 227254.006 | 3948329.078 | -7.082    | SND         |
| 2735     | 227248.102 | 3948342.11  | -9.582    | SND         |
| 2736     | 227240.043 | 3948347.228 | -10.582   | SND         |

| Point_No | Northing   | Easting     | Elevation | Description |
|----------|------------|-------------|-----------|-------------|
| 2737     | 227230.534 | 3948352.063 | -10.582   | SND         |
| 2738     | 227229.276 | 3948352.552 | -10.582   | SND         |
| 2739     | 227221.458 | 3948354.462 | -5.582    | SND         |
| 2740     | 227387.031 | 3948431.204 | 0.59      | WBY         |
| 2741     | 227364.997 | 3948440.845 | 0.315     | WBY         |
| 2742     | 227359.255 | 3948444.128 | 0.365     | WBY         |
| 2743     | 227348.864 | 3948447.634 | -0.382    | SND         |
| 2744     | 227340.511 | 3948454.146 | -5.582    | SND         |
| 2745     | 227332.873 | 3948465.309 | -8.382    | SND         |
| 2746     | 227326.947 | 3948473.734 | -9.582    | SND         |
| 2747     | 227320.422 | 3948480.774 | -9.782    | SND         |
| 2748     | 227312.756 | 3948483.074 | -10.082   | SND         |
| 2749     | 227299.936 | 3948483.272 | -9.382    | SND         |
| 2750     | 227290.854 | 3948490.294 | -6.582    | SND         |
| 2751     | 227286.035 | 3948504.647 | 0.418     | SND         |
| 2752     | 227260.831 | 3948514.268 | 2.024     | WBY         |
| 2753     | 227239.293 | 3948532.24  | 1.379     | WBY         |
| 2754     | 227216.646 | 3948544.29  | 1.419     | WBY         |
| 2755     | 227471.587 | 3948551.631 | 0.505     | WBY         |
| 2756     | 227451.914 | 3948567.32  | 0.637     | WBY         |
| 2757     | 227429.554 | 3948578.993 | 0.192     | WBY         |
| 2758     | 227419.646 | 3948588.691 | -4.582    | SND         |
| 2759     | 227412.982 | 3948596.711 | -4.582    | SND         |
| 2760     | 227406.208 | 3948601.323 | -4.582    | SND         |
| 2761     | 227395.336 | 3948602.295 | -6.382    | SND         |
| 2762     | 227383.228 | 3948605.597 | -6.582    | SND         |
| 2763     | 227381.71  | 3948606.541 | -7.082    | SND         |
| 2764     | 227374.22  | 3948612.891 | -7.582    | SND         |
| 2765     | 227370.178 | 3948621.799 | -6.582    | SND         |
| 2766     | 227353.237 | 3948631.391 | -3.082    | SND         |
| 2767     | 227345.16  | 3948642.222 | 0.033     | WBY         |
| 2768     | 227325.283 | 3948651.599 | 1.09      | WBY         |
| 2769     | 227304.848 | 3948668.066 | 1.937     | WBY         |
| 2770     | 227286.887 | 3948681.275 | 1.682     | WBY         |
| 2771     | 227555.587 | 3948675.604 | -0.09     | WBY         |
| 2772     | 227534.35  | 3948689.499 | -0.833    | WBY         |
| 2773     | 227531.719 | 3948693.957 | 2.418     | SND         |
| 2774     | 227522.417 | 3948695.955 | 2.418     | SND         |
| 2775     | 227520.098 | 3948705.063 | 2.418     | SND         |
| 2776     | 227512.135 | 3948722.134 | 2.418     | SND         |
| 2777     | 227501.506 | 3948723.459 | 2.418     | SND         |
| 2778     | 227488.982 | 3948722.136 | 2.418     | SND         |
| 2779     | 227474.412 | 3948719.591 | 2.418     | SND         |
| 2780     | 227475.969 | 3948733.306 | 2.418     | SND         |
| 2781     | 227468.941 | 3948742.954 | 2.418     | SND         |
| 2782     | 227458.175 | 3948744.566 | 2.418     | SND         |

| Point_No | Northing   | Easting     | Elevation | Description |
|----------|------------|-------------|-----------|-------------|
| 2783     | 227443.77  | 3948741.951 | 2.418     | SND         |
| 2784     | 227446.307 | 3948754.081 | 2.418     | SND         |
| 2785     | 227436.799 | 3948767.058 | 2.418     | SND         |
| 2786     | 227424.69  | 3948766.721 | 2.418     | SND         |
| 2787     | 227418.459 | 3948775.504 | 2.418     | SND         |
| 2788     | 227409.979 | 3948780.421 | 2.418     | SND         |
| 2789     | 227403.345 | 3948788.356 | 2.418     | SND         |
| 2790     | 227557.906 | 3948675.211 | -0.117    | WBY         |
| 2791     | 227544.409 | 3948685.872 | -0.461    | WBY         |
| 2792     | 227533.909 | 3948692.581 | -0.986    | WBY         |
| 2793     | 227523.774 | 3948699.023 | -2.682    | SND         |
| 2794     | 227514.231 | 3948698.137 | -3.082    | SND         |
| 2795     | 227511.866 | 3948716.292 | -3.182    | SND         |
| 2796     | 227500.39  | 3948718.824 | -3.382    | SND         |
| 2797     | 227484.035 | 3948718.308 | -4.082    | SND         |
| 2798     | 227468.469 | 3948717.262 | -4.082    | SND         |
| 2799     | 227483.18  | 3948729.609 | -3.782    | SND         |
| 2800     | 227474.383 | 3948736.173 | -4.382    | SND         |
| 2801     | 227466.863 | 3948741.498 | -3.782    | SND         |
| 2802     | 227458.482 | 3948744.568 | -4.982    | SND         |
| 2803     | 227450.593 | 3948753.419 | -4.582    | SND         |
| 2804     | 227439.514 | 3948753.361 | -4.382    | SND         |
| 2805     | 227428.852 | 3948754.3   | -2.582    | SND         |
| 2806     | 227426.883 | 3948770.728 | -1.582    | SND         |
| 2807     | 227418.492 | 3948774.975 | -1.382    | SND         |
| 2808     | 227412.879 | 3948783.504 | -1.082    | SND         |
| 2809     | 227405.787 | 3948791.754 | -0.082    | SND         |
| 2810     | 227381.919 | 3948798.725 | 0.905     | WBY         |
| 2811     | 227371.108 | 3948804.678 | 0.842     | WBY         |
| 2812     | 227352.613 | 3948819.85  | 1.121     | WBY         |
| 2813     | 227640.119 | 3948800.656 | -2.382    | SND         |
| 2814     | 227634.949 | 3948809.943 | -2.382    | SND         |
| 2815     | 227630.583 | 3948806.031 | -2.382    | SND         |
| 2816     | 227670.033 | 3948740.5   | 2.461     | TOW         |
| 2817     | 238749.579 | 3953566.055 | 3.931     | CHK         |
| 2819     | 227681.899 | 3948769.967 | 2.262     | TOW         |
| 2820     | 227611.455 | 3948810.557 | -2.492    | SND         |
| 2821     | 227593.49  | 3948833.609 | -2.692    | SND         |
| 2822     | 227589.373 | 3948838.573 | -2.692    | SND         |
| 2823     | 227580.915 | 3948844.714 | -2.692    | SND         |
| 2824     | 227569.334 | 3948842.604 | -2.692    | SND         |
| 2825     | 227553.225 | 3948858.095 | -2.892    | SND         |
| 2826     | 227552.728 | 3948868.251 | -2.792    | SND         |
| 2827     | 227546.114 | 3948868.943 | -2.492    | SND         |
| 2828     | 227525.007 | 3948865.797 | -3.192    | SND         |
| 2829     | 227525.746 | 3948879.87  | -3.192    | SND         |

| Point_No | Northing   | Easting     | Elevation | Description |
|----------|------------|-------------|-----------|-------------|
| 2830     | 227522.604 | 3948888.992 | -2.192    | SND         |
| 2831     | 227512.902 | 3948892.607 | -1.892    | SND         |
| 2832     | 227504.215 | 3948897.178 | -1.892    | SND         |
| 2833     | 227490.289 | 3948903.825 | -1.492    | SND         |
| 2834     | 227488.393 | 3948900.763 | -1.492    | SND         |
| 2835     | 227485.259 | 3948916.251 | -1.392    | SND         |
| 2836     | 227465.401 | 3948919.969 | -0.892    | SND         |
| 2837     | 227463.565 | 3948926.532 | -0.892    | SND         |
| 2838     | 227456.34  | 3948927.196 | -0.392    | SND         |
| 2839     | 227442.777 | 3948933.352 | 0.508     | SND         |
| 2840     | 227431.633 | 3948947.882 | 1.208     | SND         |
| 2841     | 227416.613 | 3948952.328 | 1.127     | WBY         |
| 2842     | 227392.952 | 3948971.14  | 1.618     | WBY         |
| 2843     | 227375.195 | 3948985.034 | 1.766     | WBY         |
| 2844     | 227735.009 | 3948914.376 | -2.492    | SND         |
| 2845     | 227712.911 | 3948916.893 | -2.792    | SND         |
| 2846     | 227716.433 | 3948928.606 | -2.692    | SND         |
| 2847     | 227701.257 | 3948937.735 | -2.692    | SND         |
| 2848     | 227687.456 | 3948947.282 | -2.692    | SND         |
| 2849     | 227680.909 | 3948961.166 | -2.792    | SND         |
| 2850     | 227673.849 | 3948955.235 | -2.792    | SND         |
| 2851     | 227673.048 | 3948969.055 | -2.692    | SND         |
| 2852     | 227644.011 | 3948967.031 | -2.492    | SND         |
| 2853     | 227650.585 | 3948983.19  | -2.492    | SND         |
| 2854     | 227641.212 | 3948989.131 | -1.992    | SND         |
| 2855     | 227638.722 | 3948995.77  | -2.692    | SND         |
| 2856     | 227631.984 | 3948995.95  | -2.592    | SND         |
| 2857     | 227623.512 | 3949006.525 | 2.308     | SND         |
| 2858     | 227595.615 | 3949007.2   | -1.892    | SND         |
| 2859     | 227591.538 | 3949010.09  | -1.892    | SND         |
| 2860     | 227592.094 | 3949013.294 | -1.892    | SND         |
| 2861     | 227581.388 | 3949019.798 | -1.892    | SND         |
| 2862     | 227584.87  | 3949036.423 | -1.892    | SND         |
| 2863     | 227555.502 | 3949034.778 | -1.192    | SND         |
| 2864     | 227560.673 | 3949043.443 | -1.492    | SND         |
| 2865     | 227558.462 | 3949043.625 | -1.592    | SND         |
| 2866     | 227543.969 | 3949045.234 | -0.592    | SND         |
| 2867     | 227404.581 | 3949042.887 | 2.354     | TOW         |
| 2870     | 264724.333 | 3956106.884 | 2.347     | TOW         |
| 2871     | 264737.968 | 3956086.503 | 0.641     | WBY         |
| 2872     | 264757.201 | 3956065.959 | -9.649    | SND         |
| 2873     | 264778.915 | 3956047.948 | -12.649   | SND         |
| 2874     | 264871.976 | 3956186.921 | -12.649   | SND         |
| 2875     | 264780.001 | 3956259.266 | 2.355     | TOW         |
| 2876     | 266047.67  | 3967619.332 | 1.775     | TOW         |
| 2877     | 266005.931 | 3967635.514 | 1.178     | WBY         |

| Point_No | Northing    | Easting     | Elevation | Description |
|----------|-------------|-------------|-----------|-------------|
| 2878     | 266030.573  | 3967631.236 | 1.372     | WBY         |
| 2879     | 266054.767  | 3967626.305 | 1.499     | WBY         |
| 2880     | 266079.094  | 3967627.127 | -9.235    | SND         |
| 2881     | 266093.887  | 3967617.172 | -13.235   | SND         |
| 2882     | 266024.621  | 3967784.978 | -10.235   | SND         |
| 2883     | 266049.437  | 3967783.19  | -13.235   | SND         |
| 2884     | 265996.161  | 3967784.871 | 1.755     | TOW         |
| 2885     | 280835.096  | 3969367.566 | 1.592     | TOW         |
| 2886     | 280831.12   | 3969438.463 | -9.402    | SND         |
| 2887     | 280788.631  | 3969453.201 | -13.402   | SND         |
| 2888     | 280835.054  | 3969402.214 | 1.604     | TOW         |
| 9000     | 281621.4133 | 3969151.684 | -4.34     | SND         |
| 9001     | 280791.4363 | 3969457.666 | -13.38    | SND         |
| 9002     | 281546.4133 | 3969021.78  | -4.9      | SND         |
| 9003     | 264858.8083 | 3956175.505 | -12.65    | SND         |
| 9004     | 264193.9987 | 3956967.795 | -0.46     | WBY         |
| 9005     | 264773.7971 | 3956043.459 | -12.65    | SND         |
| 9006     | 255116.88   | 3947634.586 | -0.6      | WBY         |
| 9007     | 255882.9244 | 3948277.374 | 0         | WBY         |
| 9008     | 255012.259  | 3947742.61  | -6.15     | SND         |
| 9009     | 254214.763  | 3953870.633 | -5.11     | SND         |
| 9010     | 254298.5037 | 3953675.019 | -7.59     | SND         |
| 9011     | 252675.0778 | 3954330.926 | -0.37     | WBY         |
| 9012     | 265612.5409 | 3967857.446 | -3.88     | SND         |
| 9013     | 265586.4937 | 3967709.725 | -4.07     | SND         |
| 9014     | 215136.669  | 3959436.134 | 1.65      | WBY         |
| 9015     | 215284.3902 | 3959462.181 | -3.49     | SND         |
| 9016     | 226828.9224 | 3947719.195 | 0.426     | WBY         |

---

## **APPENDIX 5**

### **Bathymetry Survey Data**

|          |            |              |        |             |
|----------|------------|--------------|--------|-------------|
| 20190001 | 227,722.32 | 3,949,104.88 | -10.75 | Bathymetric |
| 20190002 | 227,736.45 | 3,949,125.58 | -12.17 | Bathymetric |
| 20190003 | 227,750.54 | 3,949,146.16 | -12.67 | Bathymetric |
| 20190004 | 227,764.65 | 3,949,166.80 | -14.44 | Bathymetric |
| 20190005 | 227,778.80 | 3,949,187.37 | -15.2  | Bathymetric |
| 20190006 | 227,793.01 | 3,949,207.99 | -16.26 | Bathymetric |
| 20190007 | 227,807.05 | 3,949,228.58 | -19.18 | Bathymetric |
| 20190008 | 227,821.17 | 3,949,249.27 | -21.78 | Bathymetric |
| 20190009 | 227,835.35 | 3,949,269.75 | -25.27 | Bathymetric |
| 20190010 | 227,863.65 | 3,949,311.09 | -28.57 | Bathymetric |
| 20190011 | 227,849.48 | 3,949,290.43 | -30.29 | Bathymetric |
| 20190012 | 227,877.69 | 3,949,331.79 | -27.97 | Bathymetric |
| 20190013 | 227,891.87 | 3,949,352.33 | -29.34 | Bathymetric |
| 20190014 | 227,905.98 | 3,949,373.03 | -28.75 | Bathymetric |
| 20190015 | 227,919.85 | 3,949,393.46 | -29.11 | Bathymetric |
| 20190016 | 227,934.21 | 3,949,414.38 | -29.67 | Bathymetric |
| 20190017 | 227,948.49 | 3,949,434.90 | -30.04 | Bathymetric |
| 20190018 | 227,976.76 | 3,949,476.15 | -29.45 | Bathymetric |
| 20190019 | 227,990.81 | 3,949,496.74 | -29.75 | Bathymetric |
| 20190020 | 227,961.94 | 3,949,454.52 | -30.06 | Bathymetric |
| 20190021 | 228,033.01 | 3,949,558.55 | -28.19 | Bathymetric |
| 20190022 | 228,004.80 | 3,949,517.41 | -28.45 | Bathymetric |
| 20190023 | 228,018.96 | 3,949,538.00 | -29.46 | Bathymetric |
| 20190024 | 228,061.30 | 3,949,599.81 | -27.46 | Bathymetric |
| 20190025 | 228,047.21 | 3,949,579.24 | -27.99 | Bathymetric |
| 20190026 | 228,103.66 | 3,949,661.60 | -24.28 | Bathymetric |
| 20190027 | 228,089.51 | 3,949,641.04 | -25.08 | Bathymetric |
| 20190028 | 228,075.47 | 3,949,620.48 | -26.32 | Bathymetric |
| 20190029 | 228,131.94 | 3,949,702.94 | -20.48 | Bathymetric |
| 20190030 | 228,117.81 | 3,949,682.30 | -24.3  | Bathymetric |
| 20190031 | 228,174.38 | 3,949,764.91 | -11.59 | Bathymetric |
| 20190032 | 228,160.20 | 3,949,744.22 | -15.62 | Bathymetric |
| 20190033 | 228,146.02 | 3,949,723.49 | -17.65 | Bathymetric |
| 20190034 | 228,188.48 | 3,949,785.53 | -8.87  | Bathymetric |
| 20190035 | 228,202.63 | 3,949,806.19 | -2.53  | Bathymetric |
| 20190036 | 280,800.09 | 3,969,630.60 | -19.36 | Bathymetric |
| 20190037 | 254,947.00 | 3,947,492.36 | -10.07 | Bathymetric |
| 20190038 | 254,968.01 | 3,947,509.79 | -10.13 | Bathymetric |
| 20190039 | 254,925.58 | 3,947,474.58 | -10.03 | Bathymetric |
| 20190040 | 255,001.37 | 3,947,537.49 | -7.7   | Bathymetric |
| 20190041 | 255,031.91 | 3,947,562.83 | -7.53  | Bathymetric |
| 20190042 | 254,895.27 | 3,947,644.49 | -11.43 | Bathymetric |
| 20190043 | 254,873.25 | 3,947,626.01 | -9.43  | Bathymetric |
| 20190044 | 254,914.55 | 3,947,660.67 | -8.33  | Bathymetric |
| 20190045 | 254,940.71 | 3,947,682.63 | -8.13  | Bathymetric |
| 20190046 | 255,051.48 | 3,947,579.07 | -6.63  | Bathymetric |
| 20190047 | 255,070.88 | 3,947,595.18 | -5.53  | Bathymetric |

|          |            |              |        |             |
|----------|------------|--------------|--------|-------------|
| 20190048 | 255,095.12 | 3,947,615.30 | -4.83  | Bathymetric |
| 20190049 | 254,965.53 | 3,947,703.46 | -7.23  | Bathymetric |
| 20190050 | 254,984.75 | 3,947,719.60 | -6.43  | Bathymetric |
| 20190051 | 255,004.05 | 3,947,735.79 | -6.21  | Bathymetric |
| 20190052 | 226,656.90 | 3,947,860.52 | -7.98  | Bathymetric |
| 20190053 | 226,676.45 | 3,947,883.24 | -7.78  | Bathymetric |
| 20190054 | 226,811.05 | 3,947,939.51 | -7.48  | Bathymetric |
| 20190055 | 226,708.41 | 3,947,881.93 | -7.38  | Bathymetric |
| 20190056 | 226,786.36 | 3,947,928.29 | -7.38  | Bathymetric |
| 20190057 | 226,728.13 | 3,947,901.33 | -7.28  | Bathymetric |
| 20190058 | 226,754.76 | 3,947,904.60 | -7.08  | Bathymetric |
| 20190059 | 226,920.76 | 3,948,007.48 | -7.68  | Bathymetric |
| 20190060 | 226,987.19 | 3,948,059.83 | -7.68  | Bathymetric |
| 20190061 | 226,965.76 | 3,948,041.87 | -7.68  | Bathymetric |
| 20190062 | 226,944.78 | 3,948,024.62 | -7.68  | Bathymetric |
| 20190063 | 226,872.92 | 3,947,974.42 | -7.58  | Bathymetric |
| 20190064 | 226,849.03 | 3,947,958.93 | -7.58  | Bathymetric |
| 20190065 | 226,899.31 | 3,947,993.06 | -7.48  | Bathymetric |
| 20190066 | 227,011.67 | 3,948,064.91 | -6.78  | Bathymetric |
| 20190067 | 227,116.08 | 3,948,188.62 | -8.28  | Bathymetric |
| 20190068 | 227,098.05 | 3,948,166.16 | -7.88  | Bathymetric |
| 20190069 | 227,081.50 | 3,948,143.53 | -7.78  | Bathymetric |
| 20190070 | 227,058.34 | 3,948,118.78 | -7.78  | Bathymetric |
| 20190071 | 227,026.94 | 3,948,092.59 | -7.68  | Bathymetric |
| 20190072 | 227,192.78 | 3,948,296.29 | -10.48 | Bathymetric |
| 20190073 | 227,175.24 | 3,948,268.26 | -10.08 | Bathymetric |
| 20190074 | 227,160.58 | 3,948,240.81 | -9.48  | Bathymetric |
| 20190075 | 227,135.31 | 3,948,208.93 | -8.58  | Bathymetric |
| 20190076 | 227,266.54 | 3,948,393.18 | -11.18 | Bathymetric |
| 20190077 | 227,250.70 | 3,948,368.88 | -11.18 | Bathymetric |
| 20190078 | 227,280.39 | 3,948,416.30 | -11.18 | Bathymetric |
| 20190079 | 227,233.23 | 3,948,345.89 | -10.88 | Bathymetric |
| 20190080 | 227,294.54 | 3,948,436.98 | -10.78 | Bathymetric |
| 20190081 | 227,210.80 | 3,948,318.91 | -10.68 | Bathymetric |
| 20190082 | 227,310.95 | 3,948,459.03 | -9.88  | Bathymetric |
| 20190083 | 227,327.65 | 3,948,486.54 | -9.48  | Bathymetric |
| 20190084 | 227,338.33 | 3,948,509.66 | -8.88  | Bathymetric |
| 20190085 | 227,348.37 | 3,948,532.88 | -7.88  | Bathymetric |
| 20190086 | 227,359.25 | 3,948,556.22 | -6.98  | Bathymetric |
| 20190087 | 227,371.85 | 3,948,579.04 | -6.58  | Bathymetric |
| 20190088 | 227,391.94 | 3,948,610.41 | -6.48  | Bathymetric |
| 20190089 | 227,407.27 | 3,948,636.43 | -6.08  | Bathymetric |
| 20190090 | 227,422.38 | 3,948,665.27 | -5.48  | Bathymetric |
| 20190091 | 227,440.40 | 3,948,694.23 | -4.88  | Bathymetric |
| 20190092 | 227,470.52 | 3,948,731.74 | -4.67  | Bathymetric |
| 20190093 | 227,489.86 | 3,948,759.66 | -4.57  | Bathymetric |
| 20190094 | 227,509.49 | 3,948,783.86 | -3.27  | Bathymetric |

|          |            |              |        |             |
|----------|------------|--------------|--------|-------------|
| 20190095 | 227,529.32 | 3,948,812.09 | -2.97  | Bathymetric |
| 20190096 | 227,552.93 | 3,948,854.69 | -5.77  | Bathymetric |
| 20190097 | 227,565.55 | 3,948,877.64 | -3.27  | Bathymetric |
| 20190098 | 227,579.83 | 3,948,900.62 | -2.87  | Bathymetric |
| 20190099 | 227,596.61 | 3,948,925.02 | -2.17  | Bathymetric |
| 20190100 | 227,691.46 | 3,949,044.50 | -3.87  | Bathymetric |
| 20190101 | 227,678.51 | 3,949,022.55 | -3.17  | Bathymetric |
| 20190102 | 227,637.48 | 3,948,973.35 | -2.47  | Bathymetric |
| 20190103 | 227,656.89 | 3,948,993.49 | -2.47  | Bathymetric |
| 20190104 | 227,616.58 | 3,948,950.87 | -2.17  | Bathymetric |
| 20190105 | 227,706.36 | 3,949,074.72 | -7.97  | Bathymetric |
| 20190106 | 254,472.59 | 3,953,607.31 | -12.41 | Bathymetric |
| 20190107 | 254,498.85 | 3,953,596.73 | -6.88  | Bathymetric |
| 20190108 | 254,440.37 | 3,953,620.28 | -11.91 | Bathymetric |
| 20190109 | 254,402.43 | 3,953,635.56 | -11.27 | Bathymetric |
| 20190110 | 254,379.07 | 3,953,644.97 | -10.33 | Bathymetric |
| 20190111 | 254,355.78 | 3,953,654.36 | -9.18  | Bathymetric |
| 20190112 | 254,332.51 | 3,953,663.73 | -8.31  | Bathymetric |
| 20190113 | 254,304.94 | 3,953,674.83 | -7.53  | Bathymetric |
| 20190114 | 254,396.57 | 3,953,794.90 | -11.75 | Bathymetric |
| 20190115 | 254,364.07 | 3,953,808.08 | -11.03 | Bathymetric |
| 20190116 | 254,420.38 | 3,953,785.25 | -11.12 | Bathymetric |
| 20190117 | 254,443.75 | 3,953,775.78 | -8.92  | Bathymetric |
| 20190118 | 254,339.96 | 3,953,817.85 | -10.92 | Bathymetric |
| 20190119 | 254,316.35 | 3,953,827.42 | -9.52  | Bathymetric |
| 20190120 | 254,291.88 | 3,953,837.34 | -8.72  | Bathymetric |
| 20190121 | 254,268.52 | 3,953,846.81 | -6.82  | Bathymetric |
| 20190122 | 254,245.28 | 3,953,856.23 | -5.42  | Bathymetric |
| 20190123 | 265,082.74 | 3,955,672.30 | -9.07  | Bathymetric |
| 20190124 | 265,106.53 | 3,955,643.86 | -6.47  | Bathymetric |
| 20190125 | 264,973.24 | 3,955,803.19 | -18.2  | Bathymetric |
| 20190126 | 264,989.48 | 3,955,783.78 | -17.8  | Bathymetric |
| 20190127 | 265,017.74 | 3,955,750.00 | -17.1  | Bathymetric |
| 20190128 | 265,033.92 | 3,955,730.65 | -14.85 | Bathymetric |
| 20190129 | 265,051.58 | 3,955,709.55 | -13.48 | Bathymetric |
| 20190130 | 264,925.93 | 3,955,859.74 | -21.1  | Bathymetric |
| 20190131 | 264,909.70 | 3,955,879.14 | -20.7  | Bathymetric |
| 20190132 | 264,956.35 | 3,955,823.38 | -20.1  | Bathymetric |
| 20190133 | 264,887.23 | 3,955,906.00 | -19.45 | Bathymetric |
| 20190134 | 264,867.92 | 3,955,929.08 | -19.5  | Bathymetric |
| 20190135 | 265,057.30 | 3,955,937.66 | -18.1  | Bathymetric |
| 20190136 | 265,082.24 | 3,955,907.73 | -16    | Bathymetric |
| 20190137 | 265,103.60 | 3,955,882.09 | -15.2  | Bathymetric |
| 20190138 | 265,119.94 | 3,955,862.49 | -12.3  | Bathymetric |
| 20190139 | 265,141.14 | 3,955,837.05 | -9.52  | Bathymetric |
| 20190140 | 265,157.15 | 3,955,817.84 | -8.91  | Bathymetric |
| 20190141 | 264,979.41 | 3,956,031.13 | -20    | Bathymetric |

|          |            |              |        |             |
|----------|------------|--------------|--------|-------------|
| 20190142 | 264,951.32 | 3,956,064.85 | -19.7  | Bathymetric |
| 20190143 | 265,001.89 | 3,956,004.16 | -19.5  | Bathymetric |
| 20190144 | 264,851.53 | 3,955,948.67 | -19    | Bathymetric |
| 20190145 | 265,022.17 | 3,955,979.82 | -19    | Bathymetric |
| 20190146 | 264,834.23 | 3,955,969.35 | -18.3  | Bathymetric |
| 20190147 | 265,039.94 | 3,955,958.50 | -17.9  | Bathymetric |
| 20190148 | 264,818.12 | 3,955,988.61 | -17.4  | Bathymetric |
| 20190149 | 264,801.78 | 3,956,008.14 | -16.8  | Bathymetric |
| 20190150 | 264,785.67 | 3,956,027.40 | -12    | Bathymetric |
| 20190151 | 264,906.39 | 3,956,118.76 | -19.51 | Bathymetric |
| 20190152 | 264,928.79 | 3,956,091.88 | -18.79 | Bathymetric |
| 20190153 | 264,889.92 | 3,956,138.53 | -17.69 | Bathymetric |
| 20190154 | 264,873.62 | 3,956,158.09 | -16.3  | Bathymetric |
| 20190155 | 215,447.73 | 3,957,689.59 | -4.23  | Bathymetric |
| 20190156 | 215,452.20 | 3,957,664.20 | -3.33  | Bathymetric |
| 20190157 | 215,458.53 | 3,957,628.27 | -2.03  | Bathymetric |
| 20190158 | 215,427.48 | 3,957,804.52 | -7.93  | Bathymetric |
| 20190159 | 215,431.83 | 3,957,779.81 | -7.13  | Bathymetric |
| 20190160 | 215,436.21 | 3,957,755.00 | -6.43  | Bathymetric |
| 20190161 | 215,440.70 | 3,957,729.50 | -5.83  | Bathymetric |
| 20190162 | 215,407.04 | 3,957,920.55 | -9.83  | Bathymetric |
| 20190163 | 215,411.72 | 3,957,894.00 | -9.33  | Bathymetric |
| 20190164 | 215,416.30 | 3,957,868.02 | -9.13  | Bathymetric |
| 20190165 | 215,420.66 | 3,957,843.27 | -8.33  | Bathymetric |
| 20190166 | 215,381.64 | 3,958,064.75 | -13.93 | Bathymetric |
| 20190167 | 215,386.85 | 3,958,035.16 | -13.63 | Bathymetric |
| 20190168 | 215,392.46 | 3,958,003.35 | -13.43 | Bathymetric |
| 20190169 | 215,402.39 | 3,957,946.94 | -10.43 | Bathymetric |
| 20190170 | 215,396.85 | 3,957,978.43 | -10.13 | Bathymetric |
| 20190171 | 215,517.12 | 3,958,164.06 | -17.92 | Bathymetric |
| 20190172 | 215,531.08 | 3,958,085.75 | -17.82 | Bathymetric |
| 20190173 | 215,524.88 | 3,958,120.58 | -16.82 | Bathymetric |
| 20190174 | 215,512.69 | 3,958,188.93 | -16.52 | Bathymetric |
| 20190175 | 215,363.80 | 3,958,166.04 | -15.53 | Bathymetric |
| 20190176 | 215,370.29 | 3,958,129.19 | -14.93 | Bathymetric |
| 20190177 | 215,376.52 | 3,958,093.80 | -14.83 | Bathymetric |
| 20190178 | 215,499.34 | 3,958,263.79 | -17.12 | Bathymetric |
| 20190179 | 215,359.38 | 3,958,191.12 | -15.85 | Bathymetric |
| 20190180 | 215,503.75 | 3,958,239.09 | -16.42 | Bathymetric |
| 20190181 | 215,341.04 | 3,958,295.24 | -16.33 | Bathymetric |
| 20190182 | 215,493.42 | 3,958,297.02 | -15.82 | Bathymetric |
| 20190183 | 215,354.94 | 3,958,216.30 | -15.43 | Bathymetric |
| 20190184 | 215,508.15 | 3,958,214.39 | -15.12 | Bathymetric |
| 20190185 | 215,348.02 | 3,958,255.60 | -14.83 | Bathymetric |
| 20190186 | 215,334.60 | 3,958,331.79 | -19.63 | Bathymetric |
| 20190187 | 215,485.55 | 3,958,341.13 | -17.33 | Bathymetric |
| 20190188 | 215,320.48 | 3,958,411.94 | -16.63 | Bathymetric |

|          |            |              |        |             |
|----------|------------|--------------|--------|-------------|
| 20190189 | 215,325.24 | 3,958,384.90 | -16.23 | Bathymetric |
| 20190190 | 215,330.25 | 3,958,356.50 | -15.13 | Bathymetric |
| 20190191 | 215,481.12 | 3,958,366.02 | -16.3  | Bathymetric |
| 20190192 | 215,476.63 | 3,958,391.18 | -5.83  | Bathymetric |
| 20190193 | 266,221.43 | 3,967,597.75 | -10.83 | Bathymetric |
| 20190194 | 266,196.55 | 3,967,602.10 | -12.6  | Bathymetric |
| 20190195 | 266,138.45 | 3,967,612.28 | -13.5  | Bathymetric |
| 20190196 | 266,171.69 | 3,967,606.46 | -14.76 | Bathymetric |
| 20190197 | 266,130.14 | 3,967,768.36 | -12.9  | Bathymetric |
| 20190198 | 266,104.60 | 3,967,772.89 | -15.02 | Bathymetric |
| 20190199 | 266,157.69 | 3,967,763.47 | -10.8  | Bathymetric |
| 20190200 | 266,079.34 | 3,967,777.37 | -12.6  | Bathymetric |
| 20190201 | 280,730.92 | 3,969,492.93 | -20.2  | Bathymetric |
| 20190202 | 280,752.87 | 3,969,480.37 | -18    | Bathymetric |
| 20190203 | 280,777.49 | 3,969,466.28 | -17.6  | Bathymetric |
| 20190204 | 280,919.28 | 3,969,558.33 | -15.9  | Bathymetric |
| 20190205 | 280,708.36 | 3,969,505.83 | -13    | Bathymetric |
| 20190206 | 280,842.81 | 3,969,602.64 | -18.6  | Bathymetric |
| 20190207 | 280,864.54 | 3,969,590.05 | -17.4  | Bathymetric |
| 20190208 | 280,889.83 | 3,969,575.39 | -17.2  | Bathymetric |
| 20190209 | 227,041.29 | 3,972,310.73 | -6.62  | Bathymetric |
| 20190210 | 227,033.95 | 3,972,283.69 | -4.51  | Bathymetric |
| 20190211 | 226,919.03 | 3,972,419.45 | -6.8   | Bathymetric |
| 20190212 | 227,058.18 | 3,972,372.91 | -8.89  | Bathymetric |
| 20190213 | 227,065.28 | 3,972,399.01 | -8.79  | Bathymetric |
| 20190214 | 227,051.52 | 3,972,348.37 | -8.19  | Bathymetric |
| 20190215 | 226,929.03 | 3,972,456.96 | -9.09  | Bathymetric |
| 20190216 | 226,936.92 | 3,972,486.54 | -8.29  | Bathymetric |

---

## **APPENDIX 6**

### **Magnetometer Survey Data**

| Name   | X          | Y          | Latitude        | Longitude           | Line Name                  |
|--------|------------|------------|-----------------|---------------------|----------------------------|
| 100100 | 3959289.48 | 215291.25  | 29 04 28.9025 N | 089 12 34.2296 W    | 002_0936                   |
| 100101 | 3958707.65 | 215416.8   | 29 04 30.2518 N | 089 12 40.7587 W    | 002_0936                   |
| 100102 | 3957459.67 | 215646.42  | 29 04 32.7531 N | 089 12 54.7717 W    | 001A1001                   |
| 100103 | 3948816.74 | 227496.51  | 29 06 31.6142 N | 089 14 29.7138 W    | 001_1026                   |
| 100104 | 3972458.26 | 226920.31  | 29 06 21.5635 N | 089 10 3.3842 W     | 001_1026                   |
| 100105 | 3972357.27 | 227033.52  | 29 06 22.703 N  | 089 10 4.4982 W     | 002_1028                   |
| 100106 | 3967512.48 | 266276.4   | 29 12 52.023 N  | 089 10 50.7911 W    | 001_1303                   |
|        |            |            |                 |                     |                            |
|        |            |            |                 |                     |                            |
| Name   | Signature  | Gamma Peak | Intensity       | Time Elapsed (sec.) | Distance Over Ground (ft.) |
| 100100 | m-         | 46730      | 316.1           | 8.7                 | 65.8                       |
| 100101 | m+         | 46426      | 100             | 2.8                 | 26.5                       |
| 100102 | m+         | 46396      | 254.1           | 17.9                | 147.6                      |
| 100103 | m+         | 46424      | 103.9           | 2.1                 | 57.1                       |
| 100104 | m+         | 46370      | 112.3           | 11.2                | 52.8                       |
| 100105 | m-         | 46737      | 319.3           | 6.1                 | 55.7                       |
| 100106 | d          | 46539      | 166.8           | 4.6                 | 32.7                       |

---

## **APPENDIX 7**

### **Field Note Records**

Joloff

4-23-19

COASTAL PROTECTION / RESTORATION AUTHORITY

VEHICLE, LA

BASE ON MR09-SH-31 (PT 1000)

CHK - MR09-SH-38 (PT 1001)

H-0.400 V-0.363 PT 2000

OPNS ON CP 1000 STARTED @ 11:05PM

END @ 3:46 PM

CREVASSE OP-7

PT DESCRIPTION WAT

2001 1:20PM TOW

2002 SAND 15+

2003 SAND 13.0

2004 SAND 6.0

2005-2042 BOTTOM

2043 TOW @ 2:17 PM

END 104-105

2044 TOW @ 2:28 PM

2045-2085 BOTTOM

2086 TOW @ 3:14

2087 H-0.372 V-0.295

J. ROWE  
C. GLORY  
D. LEGENDRE

2372

C. GLORY  
D. LEGENDRE

17

✓

• 107

✓

✓

✓

✓

✓

✓

• 106

Job#

13000+04

C PRA

VENTICE, A

BASE - ON MR 09. SH - 32

OPUS STARTED @ 8:32 AM

END @ 1:46 pm

CHECK PT 1020 H-0.401 V- 0.302 PT 2028

(102-103)

PT DESCRIPTION

2089 Tow@ 9:18 AM

2080 BOTTOM (BEGIN Rosos)

2091-2103 Bottom

2104 BOTTOM (END Rosos)

2105-2112 Bottom

2113 SND 4.5' WAT

2114 SND 4.2' WAT

2115 SND 5.0' WAT

2116 SND 5.3' WAT

2117 SND 5.3' WAT

2118 SND 5.1' WAT

2119 SND 5.4' WAT

2120 SND 5.5' WAT


2121 SND 5.7' WAT

2122 Tow@ 10:22 AM

18

J. ROSE  
C. GULORY  
D. LEGGENDRE

2372

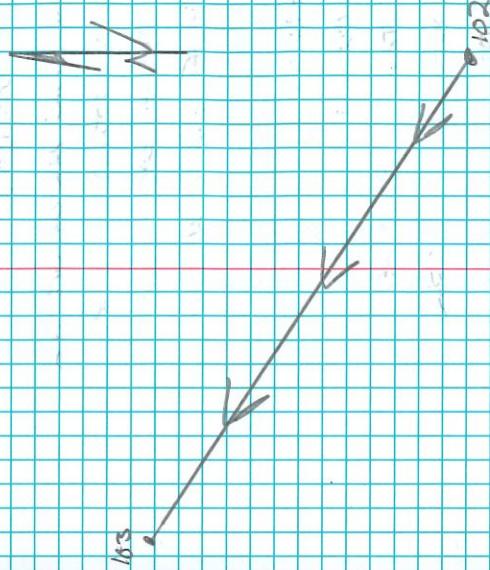

4-24-19

Joloff

1300004

L'PRA

VERNE J.A

4.24-19

L10E 101-100


PT DESCRIPTIONS DAT

|           |                       |          |
|-----------|-----------------------|----------|
| 2123      | Tow C                 | 10:25 AM |
| 2124      | SDD                   | 5.3      |
| 2125      | SDD                   | 5.2      |
| 2126      | SDD                   | 5.4      |
| 2127      | SDD                   | 5.2      |
| 2128      | SDD                   | 5.2      |
| 2129      | SAD                   | 5.1      |
| 2130      | SAD                   | 5.0      |
| 2131      | SAD                   | 4.4      |
| 2132      | SDD                   | 4.5      |
| 2133      | SDD                   | 4.2      |
| 2134      | SAD                   | 4.0      |
| 2135      | SDD                   | 4.2      |
| 2136      | SAD                   | 4.0      |
| 2137-2142 | DATUM                 |          |
| 2143      | BOTTOM (BEGINS ROSES) |          |
| 2144-2153 | BOTTOM                |          |
| 2154      | BOTTOM (END ROSES)    |          |
| 2155      | SDD                   | 9.0      |
| 2156      | SDD                   | 14+      |
| 2157      | SDD                   | 14+      |

S. ROSE  
CIGAR DRY  
D. LEGENDRE

2372

PT RISE TOW @ 11:16 AM

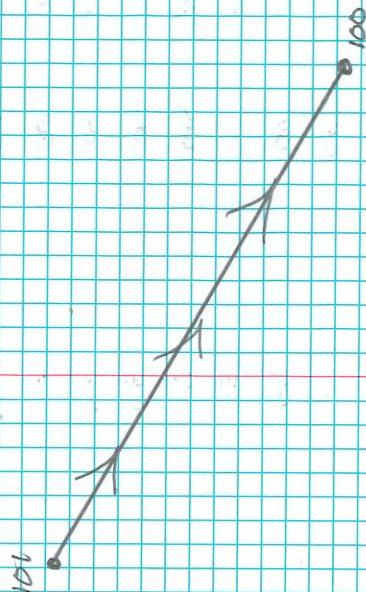

**Job#**

13000-04

1-24-18

CPRA


VENICE, LA

|           |                       |         |
|-----------|-----------------------|---------|
| PT        | DESCRIPTION           | WT      |
| 2159      | Tow @ 12:06 PM        |         |
| 2160      | BOTTOM (BEG/10 Posos) |         |
| 2161-2169 | BOTTOM                |         |
| 2170      | BOTTOM (End Posos)    |         |
| 2171-2172 | BOTTOM                |         |
| 2173      | SOD                   | 4.6     |
| 2174      | SOD                   | 4.8     |
| 2175      | SOD                   | 5.1     |
| 2176      |                       | 5.1     |
| 2177      | Tow @ 12:49 PM        | END     |
|           | LIVE                  | 119-118 |
| 2178      | Tow @ 12:53           |         |
| 2179      | SOD                   | 5.2     |
| 2180      | SOD                   | 5.0     |
| 2181      | SOD                   | 5.0     |
| 2182      | SOD                   | 5.0     |
| 2183      | SOD                   | 4.5     |
| 2184      | SOD                   | 4.1     |
| 2185      | BOTTOM (BEG/10 Posos) |         |
| 2186-2195 | BOTTOM                |         |
| 2196      | Tow                   | 1:12    |
| 2197      | CHK                   | PT 1600 |

20

JIRAKE  
CIGAR DRY  
DILEGENDA

2372

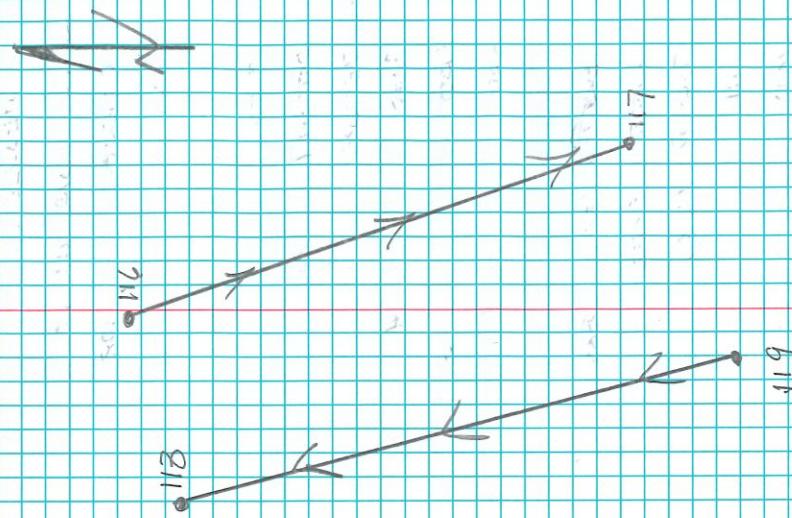

Job#

13000-04

CPR A

VENICE, LA

BASE AND CP 1001

CHK 1000 (PT 2198)

4-26-18

21

J. ROSE  
C. GLOORY  
D. LEEDER

237

LIN# 108-109

WAT

PT DESCRIPTION

2199 Tow @ 8:34 AM

2200 BOTTOM

2201 BOTTOM (BEGIN BOSS)

2202-25 BOTTOM

2226 BOTTOM (END BOSS)

2227-2040 BOTTOM (OPEN WATER)

2241 Tow @ 9:18 AM

LIN# 111 - 110

2242 Tow @ 9:22 AM

2243-2251 BOTTOM (OPEN WATER)

2252 BOTTOM (BEGIN BOSS)

2253-2277 BOTTOM

2278 BOTTOM (END BOSS)

2279-80 BOTTOM

2281 SAD 5.6

2282 SAD 6.5

2283 SAD 8.5

Job#

13000-04

CPIA

VENICE, LA

BASE ON CPI 1000

CHK 1000  
(2008)

4-26-09

4-26-09

LIVE 114-115

P/T DESCRIPTION

2285-95 BOTTOM

2296 TOW @ 10:54 AM

2297 - 2336 BOTTOM

2348 STOED BOTTOM

2341 CHK PT 1000

22

ST. ROWE

23512

Job#

13000-04

CPR4

VEINICE, LA

BASE ON MRD9-SH-31 (Pr 100)


3min. CHK ON PT 1001

H - 0.429 V - 0.269 DT 2342

BASE HT = C.22.

5-6-2019

1372 13  
J. ROSE  
C. GULDRY  
DATE:

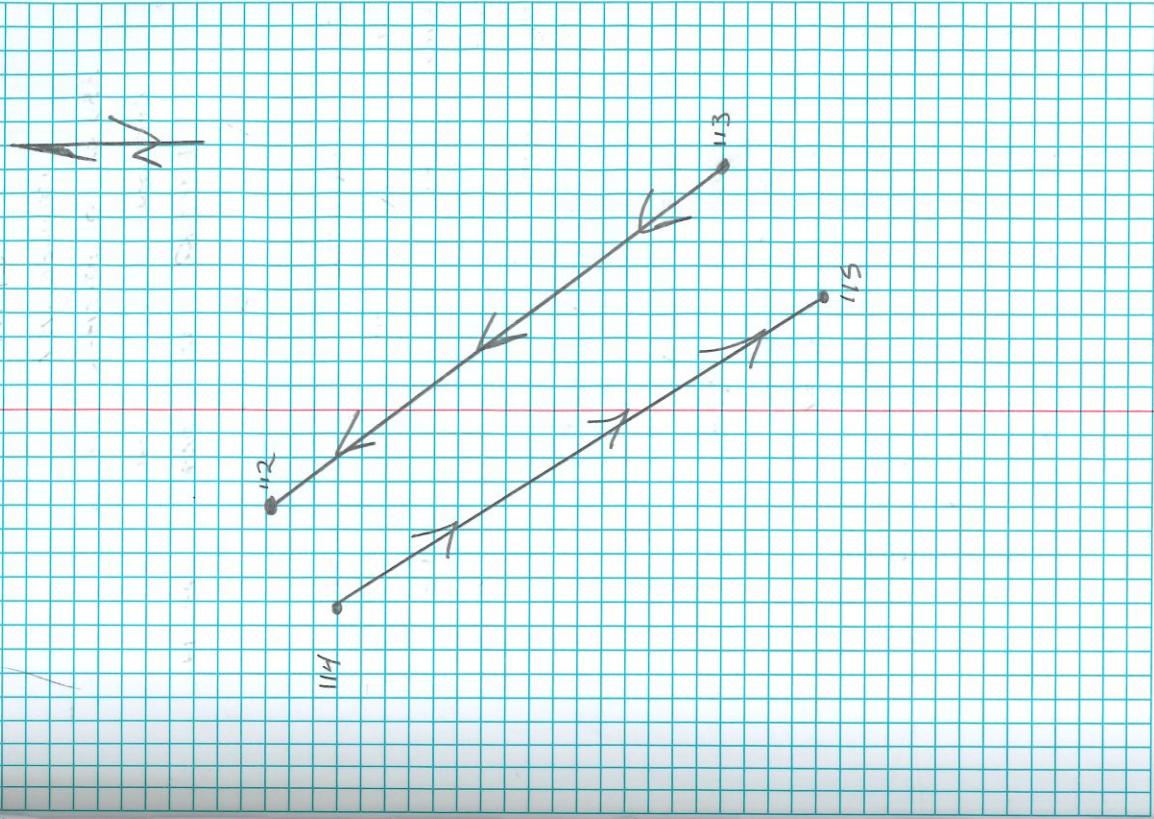

| PT        | DESCRIPTION           | ADJ.             |
|-----------|-----------------------|------------------|
| 2343      | TOW @ 1:21 PM         |                  |
| 2344      | SND                   | 10.0             |
| 2345      | SND                   | 9.2              |
| 2346      | SND                   | 4.5              |
| 2347-2351 | BOTTLED UP TO PT 2285 |                  |
| 2352-61   | BOTTOM                |                  |
| 2362      | TOW @ 1:56 PM         |                  |
|           | END LINE 114-115      |                  |
|           | START 113-112         |                  |
| 2363      | TOW @ 2:01 PM         |                  |
| 2364-2401 | BOTTOM                | START OF TREES ↗ |
| 2422      | BOTTOM                | END OF TREES ↘   |
| 2423      | BOTTOM                |                  |
| 2424      | SND                   | 8.6              |
| 2425      | TOW @ 3:08 PM         |                  |
| 2426      | CHK 1061              |                  |

Job#

13000-04

1PRA

VENICE, LA

BASE 001 CP 1000

14K 1001 ✓ PT

BASE @ C.720'

24

J. ROSE  
C. GLORY  
D. LEGENDRE

2372

5-7-2019

WOTD

**Job#**

13000-04-111

CDA

VENTURE, LA

BASE LINE MR09-SM-06 (PT 1002)

BASE SET 2 C.72C

OPUS START 2 9' SDAM EOD 12:50

**2372**

J. Rose  
C.G. Gandy  
Dilegendo 15



2491 TOW @ 11:48

5-7-2019

| PT          | DESCRIPTION    | DATE        |
|-------------|----------------|-------------|
| 2427        | Tow @ 10:12 AM | 11.         |
| 2428        | SOD            | 11.2        |
| 2429        | SOD            | 5.6         |
| 2430        | BOTTOM         | START ROSOS |
| 2431 - 38   | BOTTOM         | 128         |
| 2439        | BOTTOM         | END ROSOS   |
| 2440 - 2460 | BOTTOM         | 127         |
| 2461        | Tow @ 11:03 AM | 126         |
| 2462        | Tow @ 11:05 AM | 125         |
| 2463        | SOD            | 9.5         |
| 2464        | SOD            | 10.0        |
| 2465        |                | 1.8         |
| 2466        |                | 3.0         |
| 2467        | BOTTOM         | START ROSOS |
| 2468 - 94   | BOTTOM         |             |
| 2469        | BOTTOM         | END ROSOS   |
| 2470 - 93   | BOTTOM         |             |

Job#

13000-04

5-8-2022

C.PDA

VENICE, LA

BASE ON CP 1002

SET CP 1003 w/ 3/4" REBAR w/ CAP

LAT=29°07'35.44S LONG=89°12'31.20E

F1 = -1.45 - C.45

P# DESCRIPTION WAIT

2495 Tow@ 9:27 AM

2496 SOD 3.0

2497 SOD 2.5

2498 -3429 Bottom

2530 SOD 5.2

2531 SOD 5.5

2532 SOD 5.8

2533 SOD 5.6

2534 SOD 5.9


2535 SOD 5.7

2536 SOD 5.5

2537 Tow@ 10:23

J. ROSE  
C. GLORY • 26  
D. LEGENDRE

2372

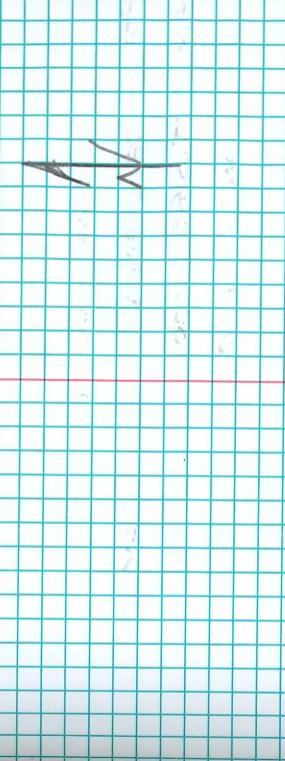

**Job#**

13000-04

5-8-19

CPT2A

LINE 120-121

| PI      | DESCRIPTION | WT  |
|---------|-------------|-----|
| 2538    | Tow@ 10:28  |     |
| 2539    | SOD         | 8.0 |
| 2540    | SOD         | 5.0 |
| 2541    | SOD         | 3.5 |
| 2542-16 | BOTTLED     |     |
| 2527    | Tow@ 11:07  |     |

**1372**

J. ROWE  
C. GLIDRY  
D. LEGENDRE

**27**

| Job#      | 13000-09        | 5-8-19 |
|-----------|-----------------|--------|
| PT        | DESCRIPTION     | WT     |
| 2578      | TOW @ 11.48     |        |
| 2579-93   | BOTTOM          |        |
| 2594      | SEGMENTED TREES |        |
| 2595      | END TREES       |        |
| 2596-2599 | BOTTOM          |        |
| 2600      | SND             | 4.8    |
| 2601      | SND             | 6.5    |
| 2602      | SND             | C.4    |
| 2603      | SND             | C.6    |
| 2604      | SND             | 7.0    |
| 2605      | SND             | 7.1    |
| 2606      | SND             | 7.0    |
| 2607      | SND             | 7.1    |
| 2608      | SND             | 7.2    |
| 2609      | SND             | 7.1    |
| 2610      | SND             | 7.3    |
| 2611      | SND             | 6.5    |
| 2612      | SND             | 5.0    |
| 2613      | SND             | 4.3    |
| 2614      | SND             | 2.6    |

Job# 13000-09  
5-8-19  
2372 SAME 28

NN

Job#

13000-09

5/19

SAMS

129

1372

CBEVASS SP-12  
CP2A

5/19

| PT      | DESCRIPTION | QTY |
|---------|-------------|-----|
| 2C15-21 | BOTTLED     | 4.7 |
| 2C22    | SDO         | 5.7 |
| 2C23    |             | 5.5 |
| 2C24    |             |     |

Joloff

13000-04

CPBA

5-13-19

J. Rose  
Category  
Diagrams

2372

30

VENICE, LA

BASE SET ON CP 1004

OOLS STARTED @ 12:10 PM END 4:30

1 1/4" AND CP 1002

H - O. 10G U - 0.012

P.F DESCRIPTION

2626 Tan C 12:44

2627 SOD 5.1

2628 SOD 5.0

2629 SOD 5.0

2630 SOD 4.8

2631 SOD 4.7

2632 SOD 5.0

2633 SOD 4.9

2634 SOD 4.9

2635 SOD 4.7

2636 SOD 6.0

2637 SOD 4.8

2638 SOD 5.1

2639 SOD 4.9

2640 SOD 5.0

2641 Tan C 1:09

Job#

13000-04

5-13-08

31  
1372

J. ROADE  
L. G. MORTY  
D. LEGENDRE

C PRA

CREVASSÉ SP-12

| PT       | DESCRIPTION           | STA      | LAT |
|----------|-----------------------|----------|-----|
| 2642-262 | BOTTOM X-SECTION DATA |          |     |
| 2653     | SAND                  | 6.0      |     |
| 2654     | SAND                  | 9.0      |     |
| 2655     | SAND                  | 10.0     |     |
| 2656     | SAND                  | 10.1     |     |
| 2657     | SAND                  | 9.8      |     |
| 2658     | SAND                  | 9.2      |     |
| 2659     | SAND                  | 9.0      |     |
| 2660     | SAND                  | 7.8      |     |
| 2661     | SAND                  | 5.8      |     |
| 2662     | SAND                  | 3.9      |     |
| 2663-65  | BOTTOM                | STA 1+50 |     |
| 2664 -73 | BOTTOM                |          |     |
| 2674     | SAND                  | 8.4      |     |
| 2675     | SAND                  | 9.2      |     |
| 2676     | SAND                  | 10.1     |     |
| 2677     | SAND                  | 9.8      |     |
| 2678     | SAND                  | 9.8      |     |
| 2679     | LAD                   | 9.5      |     |

Job#

13000-04

CPR

5-13-19

32  
2372

J. ROSE  
C. GARDNER  
D. LEGENDRE

CREVASSÉ SF-12

| PT       | DESCR.PT.12 | PT       |
|----------|-------------|----------|
| 2680     | SND         | 9.5      |
| 2681     | SND         | 8.0      |
| 2682     | SND         | 7.4      |
| 2683     | SND         | 3.0      |
| 2684-86  | BOTTOM      |          |
|          |             | STA 3+00 |
| 2687-91  | BOTTOM      |          |
| 2682     | SND         | 8.7      |
| 2693     | SND         | 9.5      |
| 2694     | SND         | 9.8      |
| 2695     | SND         | 10.0     |
| 2696     | SND         | 10.2     |
| 2697     | SND         | 10.2     |
| 2698     | SND         | 9.0      |
| 2699     | SND         | 6.0      |
| 2700     | SND         | 4.0      |
| 2701-103 | BOTTOM      |          |
|          |             | STA 4+50 |
| 2704-67  | BOTTOM      |          |
| 2708     | SND         | 8.0      |
| 2709     | SND         | 10.0     |
| 2710     |             | 10.5     |

Job#

13000-04 5-13-19

L PRA

PT DESCRIPTION

2711 SAD

2712 SAD

2713 SAD

2714 SAD

2715 SAD

2716 SAD

2717-18 BOTTOM

SIA C+G

2719-21 BOTTOM

2722 SAD

2723 SAD

2724 SAD

2725 SAD

2726 SAD

2727 SAD

2728 SAD

2729-30 BOTTOM

2730 S-TAF 7750

2731-32 BOTTOM

2733 SAD

2734 SAD

2735 SAD

2736 SAD

33

J. Rane  
C. Chidrey  
D. Leggadon

2372

CREVASSSE SP-12

Job#

13000-04

5-13-19

ZPBA

DECRI.PWD

SOD

WAT

18.0

SOD

13

SOD ~~SOIL~~ ~~TREES~~

SOD

8.0

STA 9400

Bottom

SOD

2.8

SOD

8.0

SOD

10.2

SOD

12.8

SOD

12.2

SOD

12.5

SOD

11.8

SOD

9.6

SOD

2.0

SOD

Bottom

STA 10450

Bottom

SOD

7.0

SOD

7.0

SOD

7.0

SOD

8.8

SOD

9.0

SOD

9.5

34

SAFTE

2372

SAFTE

DREVASSE SP212

Job#

13000-04-  
13000-04-  
13000-04-

| PT      | DESCRIPTION | STA | 10+00 | 12+00 |
|---------|-------------|-----|-------|-------|
| 2704    | SND         | WAT | 10.0  |       |
| 2705    | SND         |     | 9.0   |       |
| 2706    | SND         |     | 5.6   |       |
| 2727-71 | BOTTOM      |     |       |       |
| 2721-72 | BOTTOM      |     |       |       |
| 2722-72 | SND         |     | 4.2   |       |
| 2723-4  | SND         |     | 5.6   |       |
| 2724-5  | SND         |     | 5.0   |       |
| 2725    | SND         |     | 5.5   |       |
| 2726    | SND         |     | 5.0   |       |
| 2727    | SND         |     | 5.5   |       |
| 2728    | SND         |     | 5.0   |       |
| 2729    | SND         |     | 6.3   |       |
| 2730-1  | SR          |     | 7.0   |       |
| 2732    |             |     | 8.0   |       |
| 2733    |             |     | 7.5   |       |
| 2734    |             |     | 7.3   |       |
| 2735    |             |     | 4.5   |       |
| 2736    |             |     | 4.0   |       |
| 2737    |             |     | 3.0   |       |
| 2738    |             |     |       |       |

2372

35

STATE

#

1070

PT'S 2771-2774

Jolt

13000-04

5-13-19

STA 1200  
PT DESCRIPTION

2795-92 BOTTOM

2793 SAB S.0

2794 SAB S.1

2795 SAB S.5

2796 SAB S.6

2797 SAB S.8

2798 SAB C.5

2799 SAB C.5

2800 SAB C.2

2801 SAB C.2

2802 SAB 7.4

2803 SAB 7.0

2804 SAB C.3

2805 SAB S.0

2806 SAB 4.0

2807 SAB 3.8

2808 SAB 3.5

2809 SAB 2.5

2810-12 BOTTOM 13000-04

2372 36

S. ROWE  
C. G. ANDREWS  
D. B. LELAND

CREVASSÉ SP-12

Job#

13000-04

STA 1350

5-13-19

P/T DESCRIPTION

2813

2814

2815

Tow<sup>2</sup> 3:42

2817 C4K SHOT H 0.119 V 0.009

2818

2819

2820

2821

2822

2823

2824

2825

2826

SAWE #31

1372

OVERLASS 6P-17

**Job#**

13000-04

S.14.19

C.PRA

|      |      |    |       |
|------|------|----|-------|
| BASE | DN   | CP | 1004  |
| 44K  | 1002 | H  | 0.127 |

V - 0.038 PT 2818

STA 13+50

| PT   | DESCRIPTION | LAT  |
|------|-------------|------|
| 2819 | TOW C       | 8:31 |
| 2820 | SAD         |      |
| 2821 |             | 4.8  |
| 2822 |             | 5.0  |
| 2823 |             | 5.0  |
| 2824 |             | 5.0  |
| 2825 |             | 5.2  |
| 2826 |             | 5.1  |
| 2827 |             | 4.8  |
| 2828 |             | 5.5  |
| 2829 |             | 5.5  |
| 2830 |             | 4.5  |
| 2831 |             | 4.2  |
| 2832 |             | 4.2  |
| 2833 |             | 3.8  |
| 2834 |             | 3.8  |
| 2835 |             | 3.7  |
| 2836 |             | 3.2  |
| 2837 |             | 3.2  |

**1372**

J. Rose  
C. Country  
D. Legenditt

ANNEAU SP-12

Joff

13000-04

S-14-12

39

J. Rowe  
C. Gandy  
D. Legendre

2372

| PT      | DESCRIPTION | WT  |
|---------|-------------|-----|
| 2838    |             | 2.7 |
| 2839    |             | 1.8 |
| 2840    |             | 1.1 |
| 2841-43 | BOTTOM      |     |
|         | STA 13+50   |     |
| 2844    |             | 4.8 |
| 2845    |             | 5.1 |
| 2846    |             | 5.0 |
| 2847    |             | 5.0 |
| 2848    |             | 5.0 |
| 2849    |             | 5.1 |
| 2850    |             | 5.1 |
| 2851    |             | 5.0 |
| 2852    |             | 4.8 |
| 2853    |             | 4.8 |
| 2854    |             | 4.3 |
| 2855    |             | 5.6 |
| 2856    |             | 4.9 |
| 2857    |             | 4.9 |
| 2858    |             | 4.2 |
| 2859    |             | 4.2 |
| 2860    |             | 4.2 |
| 2861    |             | 4.2 |























Jaff

13000-001

15.00

5-4-19

DATA

DESCRIPTION

PT 2862 S2D 15.00

2863 S2D 4.2

2864 S2D 3.5

2865 S2D 3.8

2866 S2D 3.9

2867 TOW C 2.9

2868 CLK H 0.090 V - 0.037

STROBE

CLOUDY

DLEGENDRE

2372

40

CLUEVAISSE SP-12

Joloff

13000-04

5-14-12

CPIA

VENICE LA

BASE SET ON CP 1000

BASE HT = 2.05 m

144° 64° CP 1000

H = 0.299 V = 0.225 PT 2869

CREVASSÉ FP-7

PT DESCRIPTION LAT

2870 TOW<sup>Q</sup> 11:02 AM (LINE 10C-102)

2871 BOTTOM 12+

2872 SAND 12+

2873 SOIL 15+

2874 L10E 104 - 105 15+

2875 TOW<sup>Q</sup> 11:18 AM

CREVASSÉ FP-10

2876 TOW<sup>Q</sup> 11:30 AM (LINE 11B-119)

2877-79 BOTTOM 12+

2880 SAND 15+

2881 SOIL 12+

2882 SAND 12+

2883 SAND 15+

2884 TOW<sup>Q</sup> 11:43 AM

SAME  
41  
2372

Job#

13000-04

5-14-9

CDPA

CRAVASSÉ - OP-C

PT DESCRIPTION

2885 Tow 12:07 AM

2886 Snd 11.0

2887 Snd 15+

J. BOGE  
C. GARDY  
D. LEGENDRE

42

2372

Jabot

C.P.R.A

13000-04 Delta with Crevasses

(RTK)


Set up GPS TS on CP # 1002

Point + Remarks

13,000 Check into CP # 1004

100,003 mag H.i.t

R. Billiot  
J. Maggard 2372 8/30/19 43

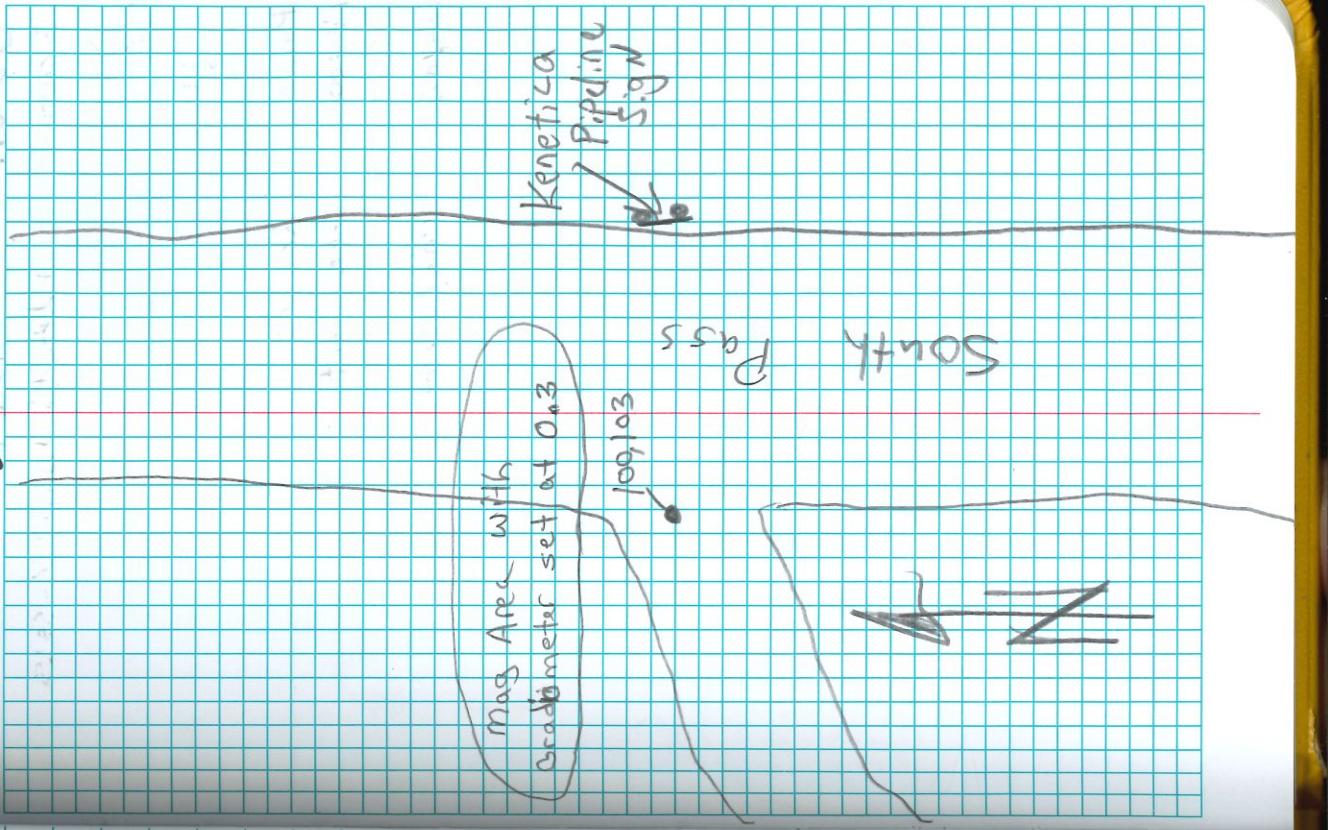

Job#

C.P.R.A


130000.04  
Delta Wide Crosses

(RTK)

Points

| Points  | Remarks   |
|---------|-----------|
| 100,100 | Mag H.i.t |
| 100,101 | Mag H.i.t |
| 100,102 | Mag H.i.t |

R.B.: 11:19  
J. Maynard  
2372 9/30/19 44

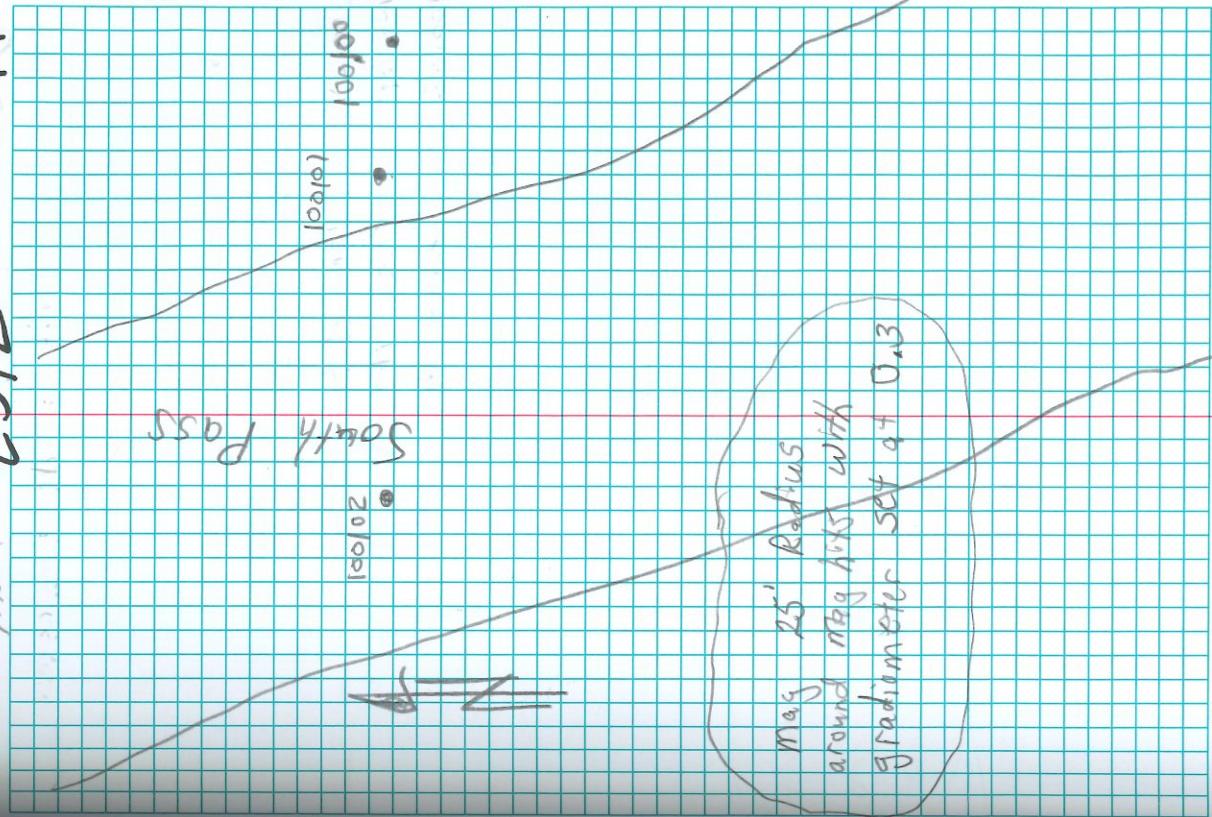

Job#

CPRA

Delta Vide Cressos

R.B. 11.07  
J. magn. rd


8/30/11 45

13000-04

(RTK)

| Points | Remarks |
|--------|---------|
| 100104 | Mag Hit |
| 100105 | Mag Hit |

13,001 Check into CP# 1004

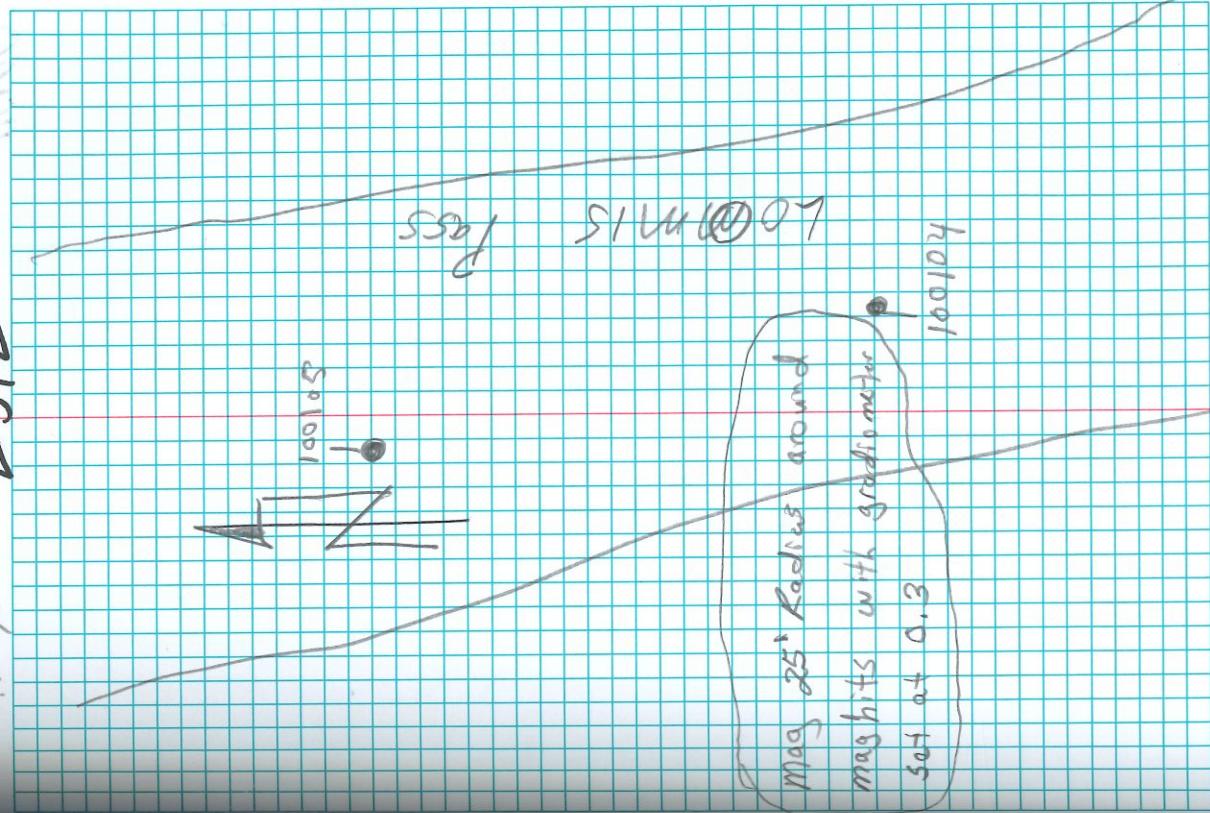

---

## **APPENDIX 8**

### **Key Personnel**

## Key Personnel

### OFFICE PERSONNEL

**Ryan Boudreaux – Senior Technician/Designer**  
**Tim Crosby – CAD III**  
**Lee Drennan – Senior Technician/Designer**  
**John Mattingly – Senior Professional Land Surveyor**  
**Jessie Newton III – CAD III/GIS Technician**

### CONVENTIONAL FIELD PERSONNEL


**James Rowe – Survey Crew Chief**  
**Ricky Billiot – Survey Crew Chief**

### HYDRO PERSONNEL

**Stuart Babin – Hydro Survey Manager/Hydro Survey Technician**  
**Kiley Cressionie – Hydro Survey Technician**  
**Jonathan Morris – Hydro Survey Manager**  
**Cody Pisani – Hydro Survey Technician**

## **APPENDIX 9**

### **Existing Benchmark Data Sheets**

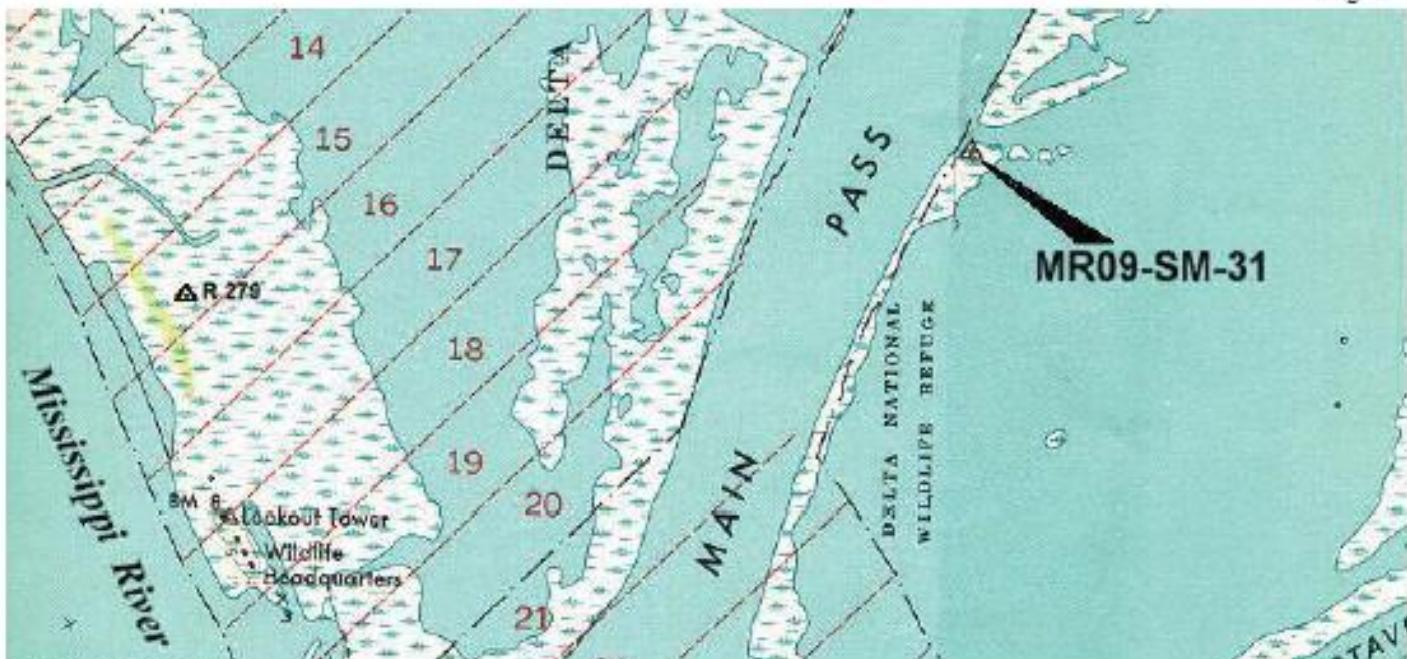

**VICINITY MAP** Scale: 1"=2000' Reproduced from USC&GS "PILOTTOWN & PASS A LOUTRE WEST, LA" Quads

**Station Name:** "MR09-SM-31"

**Monument Location:** By boat from Venice, Louisiana, proceed southeasterly in the Mississippi River for approximately 7.4 miles to Cubits Gap at the left. Turn left and proceed easterly though the north of Cubits Gap into Main Pass and continue for 1.5 miles to the monument on the right.

**Monument Description:** Deep Rod Monument; standard 3" survey disk set on steel rods and driven 52.2 feet to refusal, set in a PVC pipe and is recessed 0.4 feet below top of PVC pipe.

Date: August, 2002

**Monument Established By:** Pybum & Odom, Inc.

For: LA Department of Natural Resources, CRD

**P&O Published NAD 83 Geodetic Position**

Lat.  $29^{\circ} 13.130^{\prime \prime}$ N  
Long.  $89^{\circ} 14.951^{\prime \prime}$ W

**P&O Published NAVD88 (Feet)**

Elevation = 7.51

**Adjusted NAD 83 Geodetic Position**

Lat.  $29^{\circ} 13' 07.59626^{\prime \prime}$ N  
Long.  $89^{\circ} 14' 57.26098^{\prime \prime}$ W

**Adjusted NAD 83 Datum LSZ (1702) Feet**

N= 267,445.51  
E= 3,945,645.93

**Adjusted NAVD88 Height**

Elevation = 7.60 ft



Position determined by using Real-time Kinematic (RTK) survey from Temporary Flypoint "BILL"



**VICINITY MAP** Scale: 1"=2000' Reproduced from USC&GS "PILOTTOWN & PASS A LOUTRE WEST, LA" Quads

### Station Name: "MR09-SM-38"

**Monument Location:** By boat from Venice, Louisiana, proceed southeasterly in the Mississippi River for approximately 7.4 miles to Cubits Gap at the left. Turn left and proceed easterly though the north of Cubits Gap into Main Pass and continue for 3.3 miles to the monument on the left.

**Monument Description:** Deep Rod Monument; standard 3" survey disk set on steel rods and driven 54.3 feet to refusal, set in a PVC pipe and is recessed 0.4 feet below top of PVC pipe.

Date: August 2002

Monument Established By: Pyburn & Odom, Inc.

For: LA Department of Natural Resources, CRD

#### P&O Published NAD 83 Geodetic Position

Lat. 29° 14.592"N  
Long. 89° 14.267"W

#### P&O Published NAVD88 (Feet)

Elevation = 3.69

#### Adjusted NAD 83 Geodetic Position


Lat. 29° 14' 35.62284"N  
Long. 89° 14' 37.40572"W

#### Adjusted NAD 83 Datum LSZ (1702) Feet

N= 276,368.03  
E= 3,947,242.96


#### Adjusted NAVD88 Height

Elevation = 4.00 ft

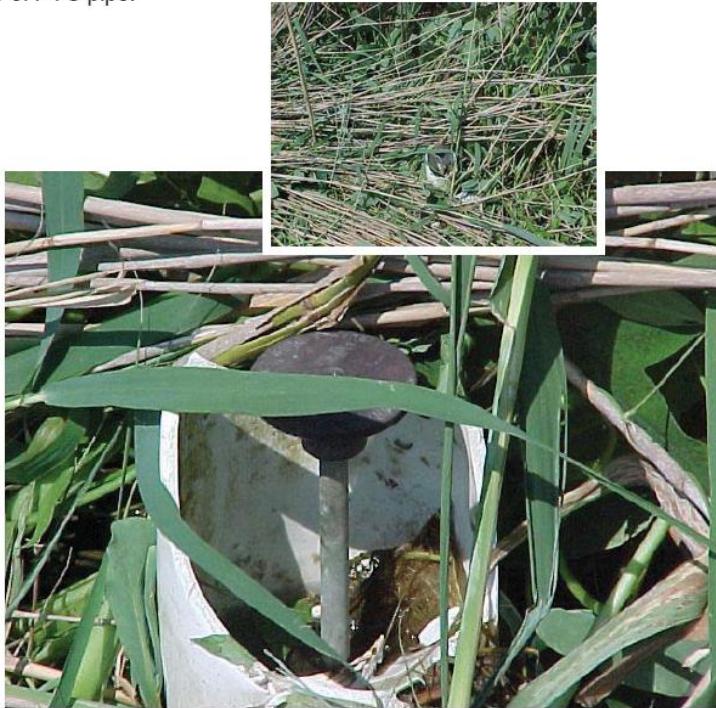

Position determined by using Real-time Kinematic (RTK) survey from Temporary Flypoint "BILL"

Adjusted Position Established by John Chance Land Surveys, Inc. for Louisiana Department of Natural Resources, CRD

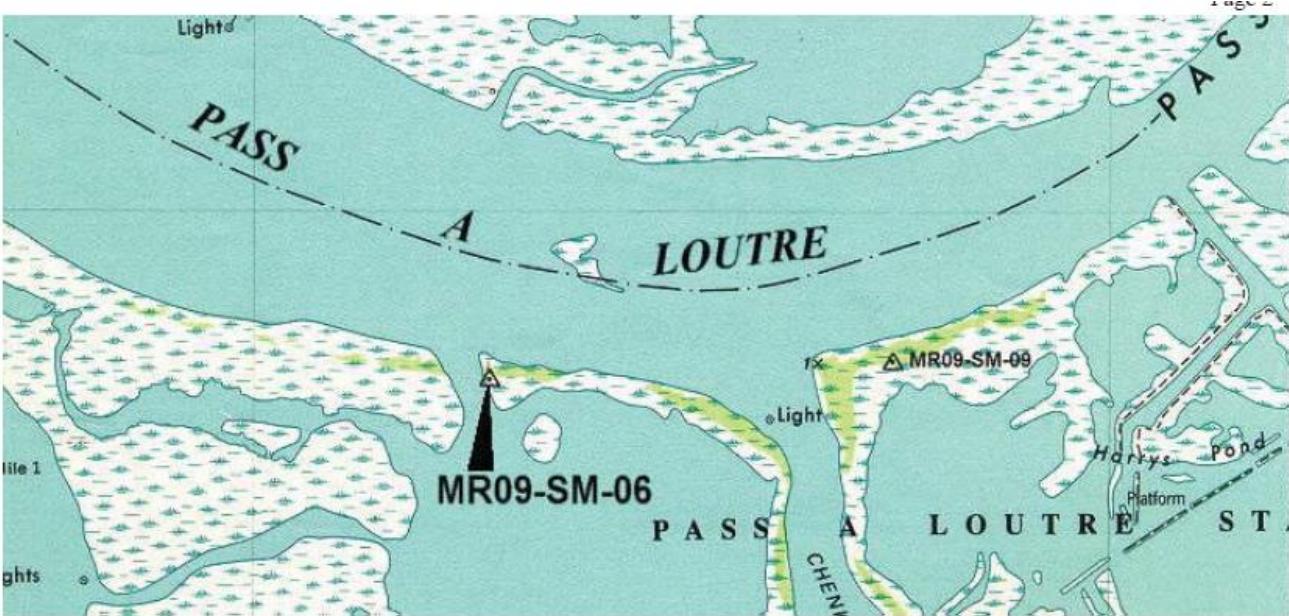

**VICINITY MAP** Scale: 1" = 2000' Reproduced from USC&GS "PASS A LOUTRE WEST, LA" Quadrangle

### Station Name: "MR09-SM-06"

**Monument Location:** By boat from Venice, Louisiana, proceed southeasterly in the Mississippi River for approximately 10 miles to the Head of Passes. Turn left and proceed easterly into Pass a Loutre for approximately 2 miles to the monument on the right.

**Monument Description:** Deep Rod Monument; standard 3" survey disk set on steel rods and driven 54.5 feet to refusal, set in a PVC pipe and is recessed 0.4 feet below top of PVC pipe.

**Date:** August, 2002

**Monument Established By:** Pyburn & Odom, Inc.

**For:** Louisiana Department of Natural Resources, CRD

P&O Published NAD 83 Geodetic Position

Lat. 29°08.371"N  
Long. 89°13.560"W

P&O Published NAVD88 (Feet)

Elevation = 3.94

Adjusted NAD 83 Geodetic Position

Lat. 29° 08' 22.13239"N  
Long. 89° 13' 33.85342"W

Adjusted NAD 83 Datum LSZ (1702) Feet

N= 238,749.46  
E= 3,953,566.05

Adjusted NAVD88 Height

Elevation = 3.89 ft

Position determined by using Real-time Kinematic (RTK) survey from Secondary GPS Monument "MR09-SM-11"

