


STATE OF LOUISIANA  
OFFICE OF COASTAL PROTECTION AND RESTORATION  
ENGINEERING BRANCH

ACCESS CHANNEL, FLOTATION CHANNEL, AND ROCK BREAKWATERS  
MAGNETOMETER SURVEY

GRAND LAKE SHORELINE PROTECTION  
PROJECT (ME-21)  
CAMERON PARISH, LOUISIANA

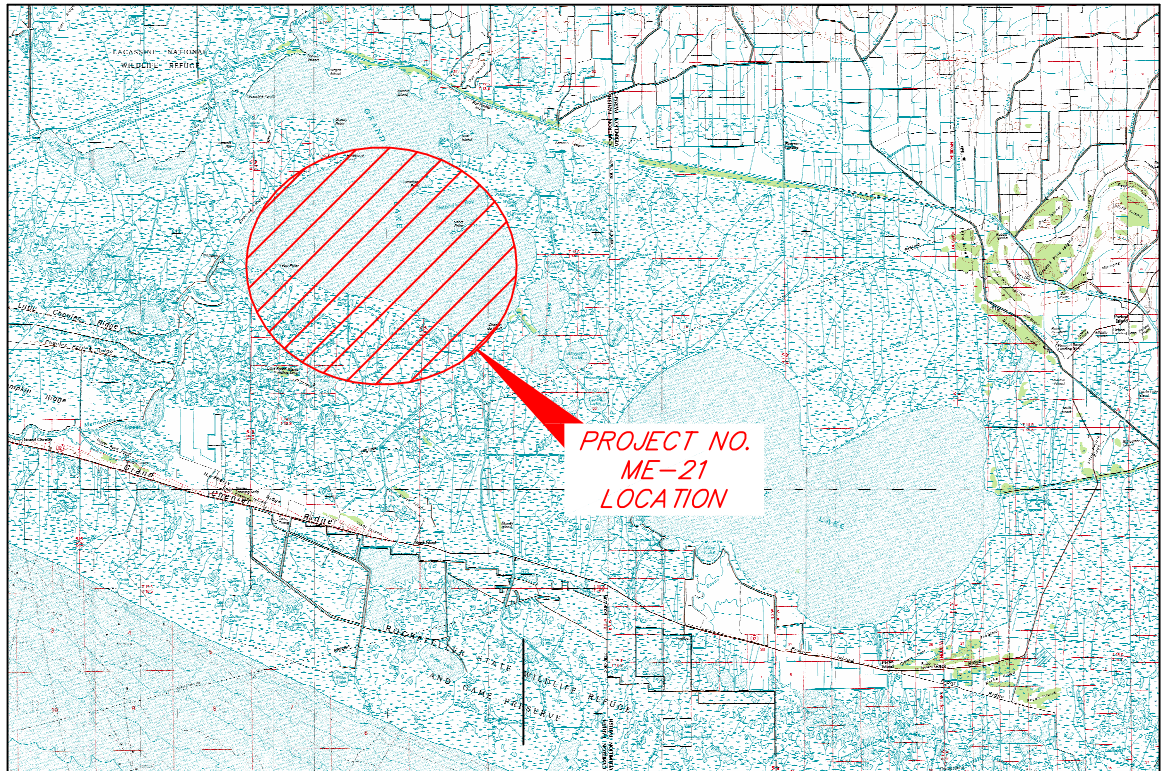

VICINITY MAP (N.T.S.)

INDEX TO SHEETS




<u>SHEET NO.</u>	<u>DESCRIPTION</u>
1	TITLE PAGE
2-7	MAG. SURVEY




THIS MAP REPRESENTS AN ACTUAL FIELD  
SURVEY MADE UNDER DIRECT  
SUPERVISION OF THE UNDERSIGNED.

*Keith J. Roberts*

KEITH J. ROBERTS, PLS # 4780  
1129 HUVAL LANE  
BREAUX BRIDGE, LA. 70517  
(337) 454-6320

REVISED BY:	DATE:	 	<b>GRAND LAKE SHORELINE PROTECTION PROJECT (ME-21) BEFORE DREDGE MAGNETOMETER SURVEY OF ACCESS CHANNELS, FLOTATION CHANNEL, AND ROCK BREAKWATERS (TITLE PAGE) CAMERON PARISH, LA.</b>
<p>PLAN SCALE SCALE: NTS</p> 		PREPARED BY: HYDROTERRA TECHNOLOGIES, LLC. - LAND SURVEY DIVISION - 1129 HUVAL LANE, BREAUX BRIDGE, LA. 70548	
DATE: 08/08/09	JOB# 2091028	FILE: GRAND LAKE MAG SURVEY.DWG	SHEET: 1 OF 7

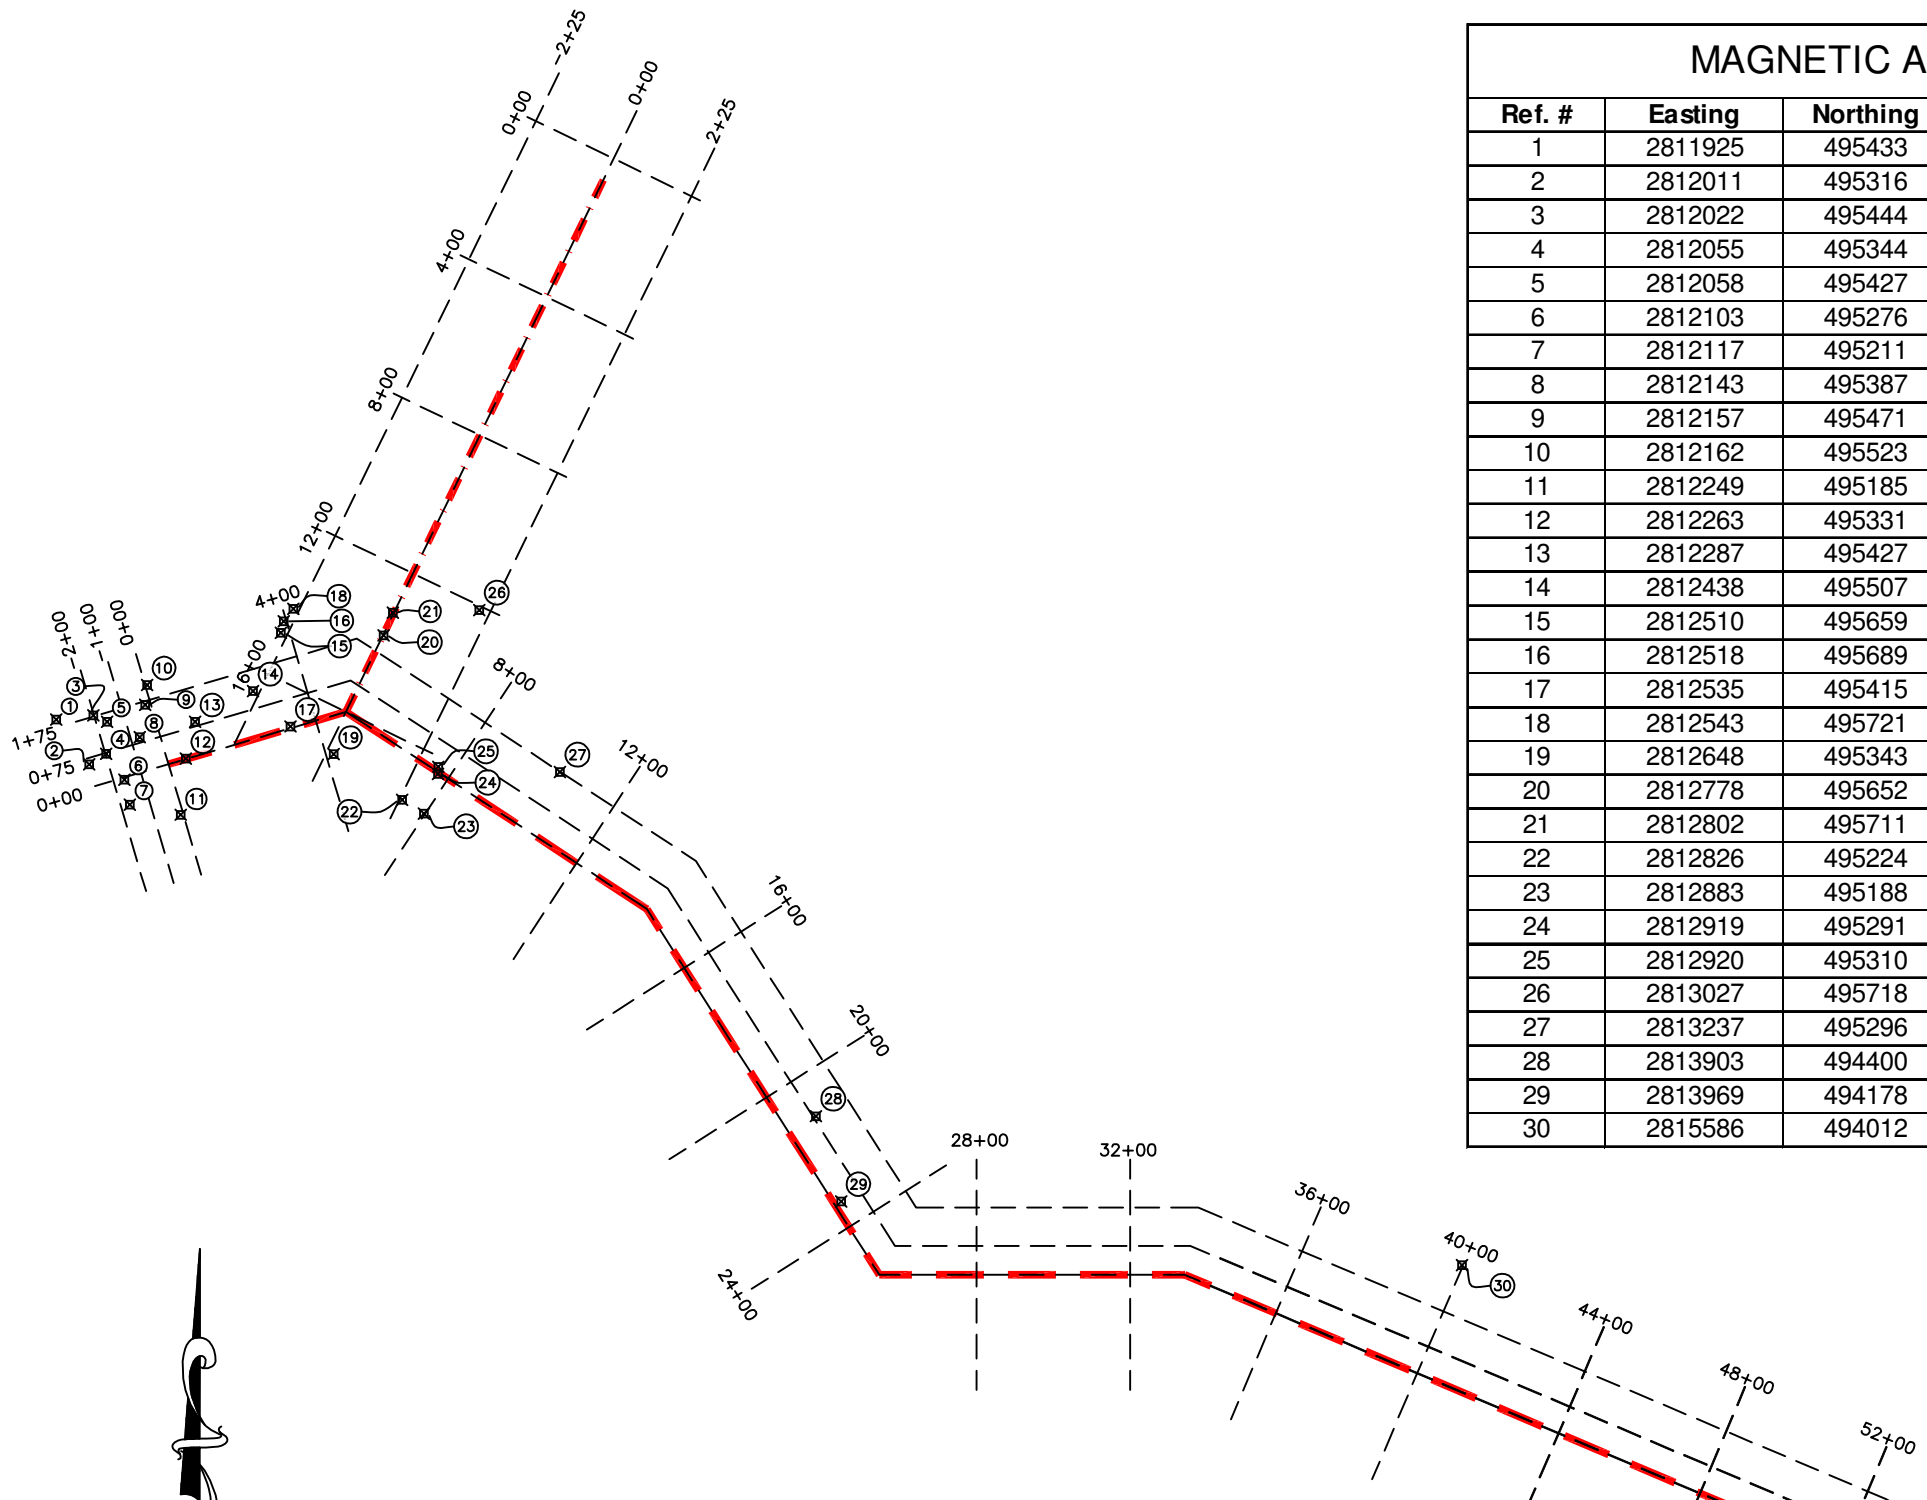

MAGNETIC ANOMALY TABLE


Ref. #	Easting	Northing	Amplitude	Type	Duration (FT)
1	2811925	495433	297	M	1
2	2812011	495316	104	M	4
3	2812022	495444	268	M	5
4	2812055	495344	100	M	6
5	2812058	495427	201	M	4
6	2812103	495276	188	M	4
7	2812117	495211	460	M	6
8	2812143	495387	281	M	10
9	2812157	495471	392	M	6
10	2812162	495523	270	M	9
11	2812249	495185	627	M	10
12	2812263	495331	66	M	8
13	2812287	495427	127	M	5
14	2812438	495507	368	M	4
15	2812510	495659	104	M	25
16	2812518	495689	84	M	16
17	2812535	495415	107	M	8
18	2812543	495721	69	M	4
19	2812648	495343	346	M	7
20	2812778	495652	30	M	5
21	2812802	495711	33	D	3
22	2812826	495224	897	M	3
23	2812883	495188	326	M	5
24	2812919	495291	2131	M	20
25	2812920	495310	107	M	52
26	2813027	495718	74	M	6
27	2813237	495296	488	M	10
28	2813903	494400	70	D	8
29	2813969	494178	183	M	3
30	2815586	494012	223	M	35

LEGEND

- DIGITIZED PIPELINE
- PROPOSED ROCK BREAKWATERS
- PROPOSED ACCESS
- MAG ROUTE
- MAG ANOMALY
- DIGITIZED WELLS

NOTES

- ALL HORIZONTAL COORDINATES ARE BASED ON LOUISIANA SOUTH ZONE - NAD83 HPGN DATUM, US SURVEY FEET, DERIVED FROM KINEMATIC OBSERVATIONS CONSTRAINED TO PROJECT CONTROL (BENCHMARK ME20-SM-01)
- THE PROJECT IS LOCATED IN AN AREA OF HISTORICAL OIL & GAS EXPLORATION ACTIVITY, AND MAY CONTAIN ABANDONED IN PLACE PORTIONS OF PIPELINES THAT WERE UNABLE TO BE VERIFIED DURING THIS SURVEY. EXTREME CAUTION SHOULD BE USED WHEN ESCAVATING.
- THIS DRAWING INDICATES GENERAL CONDITIONS AT THE TIME OF SURVEY.
- MAGNETOMETER SURVEY DATA ACQUISITION WAS PERFORMED AUGUST 4TH, 2009 THROUGH AUGUST 07, 2009. MAGNETIC DATA WAS COLLECTED USING A GEOMETRICS 882 MAGNETOMETER.
- DIGITIZED WELLS AND PIPELINES OBTAINED VIA LADNR SONRIS DATABASE.

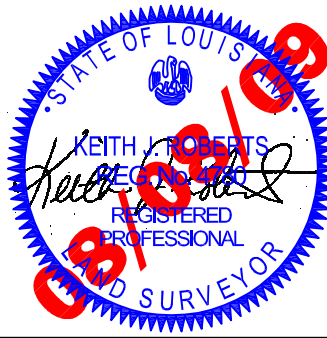

REVISED BY:

DATE:

GRAND LAKE SHORELINE  
PROTECTION PROJECT (ME-21)  
BEFORE DREDGE MAGNETOMETER SURVEY  
OF ACCESS CHANNELS AND FLOTATION  
CHANNEL AND ROCK BREAKWATERS  
(MAGNETOMETER SURVEY RESULTS)  
CAMERON PARISH, LA.


PREPARED BY: HYDROTERRA TECHNOLOGIES, LLC. - LAND SURVEY DIVISION - 1129 HUVAL LANE, BREAUX BRIDGE, LA. 70548


DATE: 08/08/09

JOB# 2091028

FILE: GRAND LAKE MAGNETOMETER SURVEY.DWG

SHEET: 2 OF 7

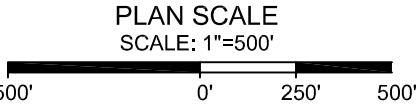

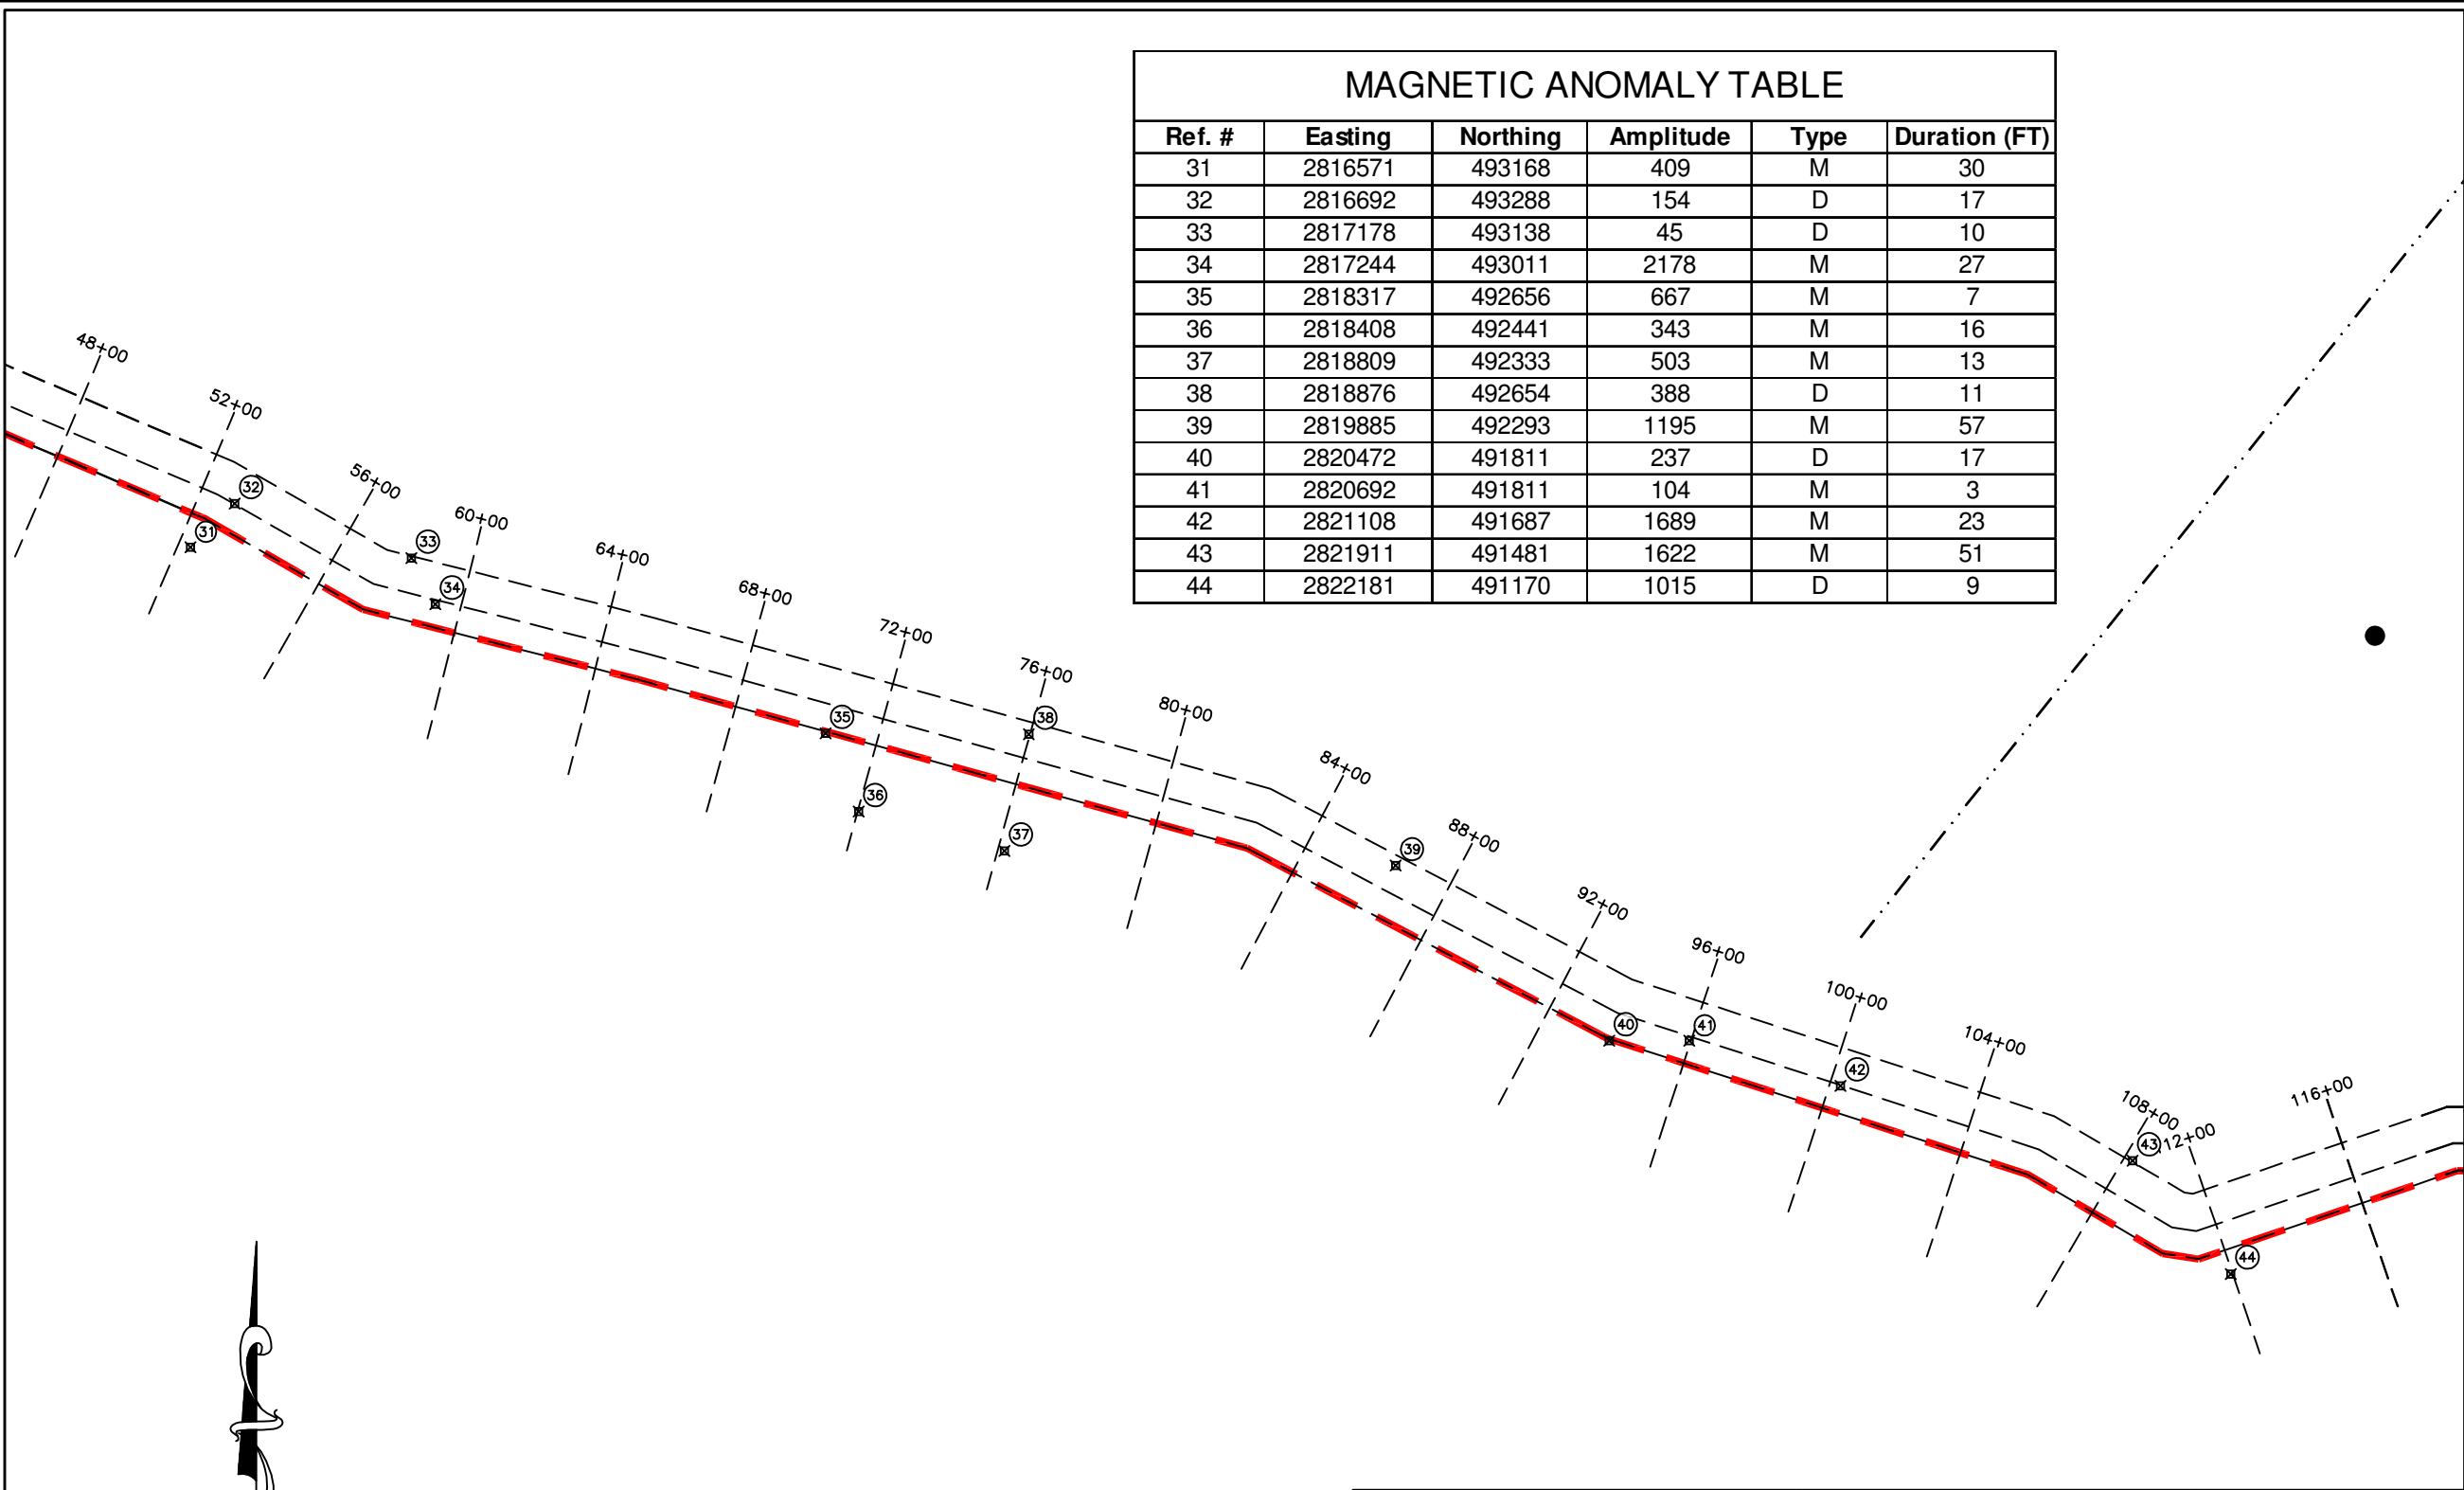

MAGNETIC ANOMALY TABLE					
Ref. #	Easting	Northing	Amplitude	Type	Duration (FT)
31	2816571	493168	409	M	30
32	2816692	493288	154	D	17
33	2817178	493138	45	D	10
34	2817244	493011	2178	M	27
35	2818317	492656	667	M	7
36	2818408	492441	343	M	16
37	2818809	492333	503	M	13
38	2818876	492654	388	D	11
39	2819885	492293	1195	M	57
40	2820472	491811	237	D	17
41	2820692	491811	104	M	3
42	2821108	491687	1689	M	23
43	2821911	491481	1622	M	51
44	2822181	491170	1015	D	9

LEGEND

DIGITIZED PIPELINE

PROPOSED ROCK BREAKWATERS

PROPOSED ACCESS

MAG ROUTE

MAG ANOMALY

DIGITIZED WELLS


- NOTES
1. ALL HORIZONTAL COORDINATES ARE BASED ON LOUISIANA SOUTH ZONE - NAD83 HPGN DATUM, US SURVEY FEET, DERIVED FROM KINEMATIC OBSERVATIONS CONSTRAINED TO PROJECT CONTROL (BENCHMARK ME20-SM-01)

2. THE PROJECT IS LOCATED IN AN AREA OF HISTORICAL OIL & GAS EXPLORATION ACTIVITY, AND MAY CONTAIN ABANDONED IN PLACE PORTIONS OF PIPELINES THAT WERE UNABLE TO BE VERIFIED DURING THIS SURVEY. EXTREME CAUTION SHOULD BE USED WHEN ESCAVATING.

3. THIS DRAWING INDICATES GENERAL CONDITIONS AT THE TIME OF SURVEY.

4. MAGNETOMETER SURVEY DATA ACQUISITION WAS PERFORMED AUGUST 4TH, 2009 THROUGH AUGUST 07, 2009. MAGNETIC DATA WAS COLLECTED USING A GEOMETRICS 882 MAGNETOMETER.

5. DIGITIZED WELLS AND PIPELINES OBTAINED VIA LADNR SONRIS DATABASE.

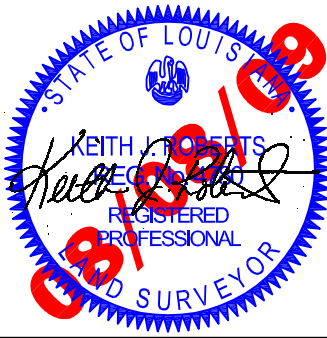

REVISED BY:

DATE:

PLAN SCALE

SCALE: 1"=500'

500'

0'

250'

500'

HYDROTERRA

TECHNOLOGIES, LLC

LAND SURVEY AND HYDROGRAPHIC SOLUTIONS

WEEKS

MARINE

GRAND LAKE SHORELINE PROTECTION PROJECT (ME-21)  
BEFORE DREDGE MAGNETOMETER SURVEY  
OF ACCESS CHANNELS AND FLOTATION CHANNEL AND ROCK BREAKWATERS  
(MAGNETOMETER SURVEY RESULTS)  
CAMERON PARISH, LA.

PREPARED BY: HYDROTERRA TECHNOLOGIES, LLC. - LAND SURVEY DIVISION - 1129 HUVAL LANE, BREAUX BRIDGE, LA. 70548


DATE: 08/08/09

JOB# 2091028

FILE: GRAND LAKE MAGNETOMETER SURVEY.DWG

SHEET: 3 OF 7



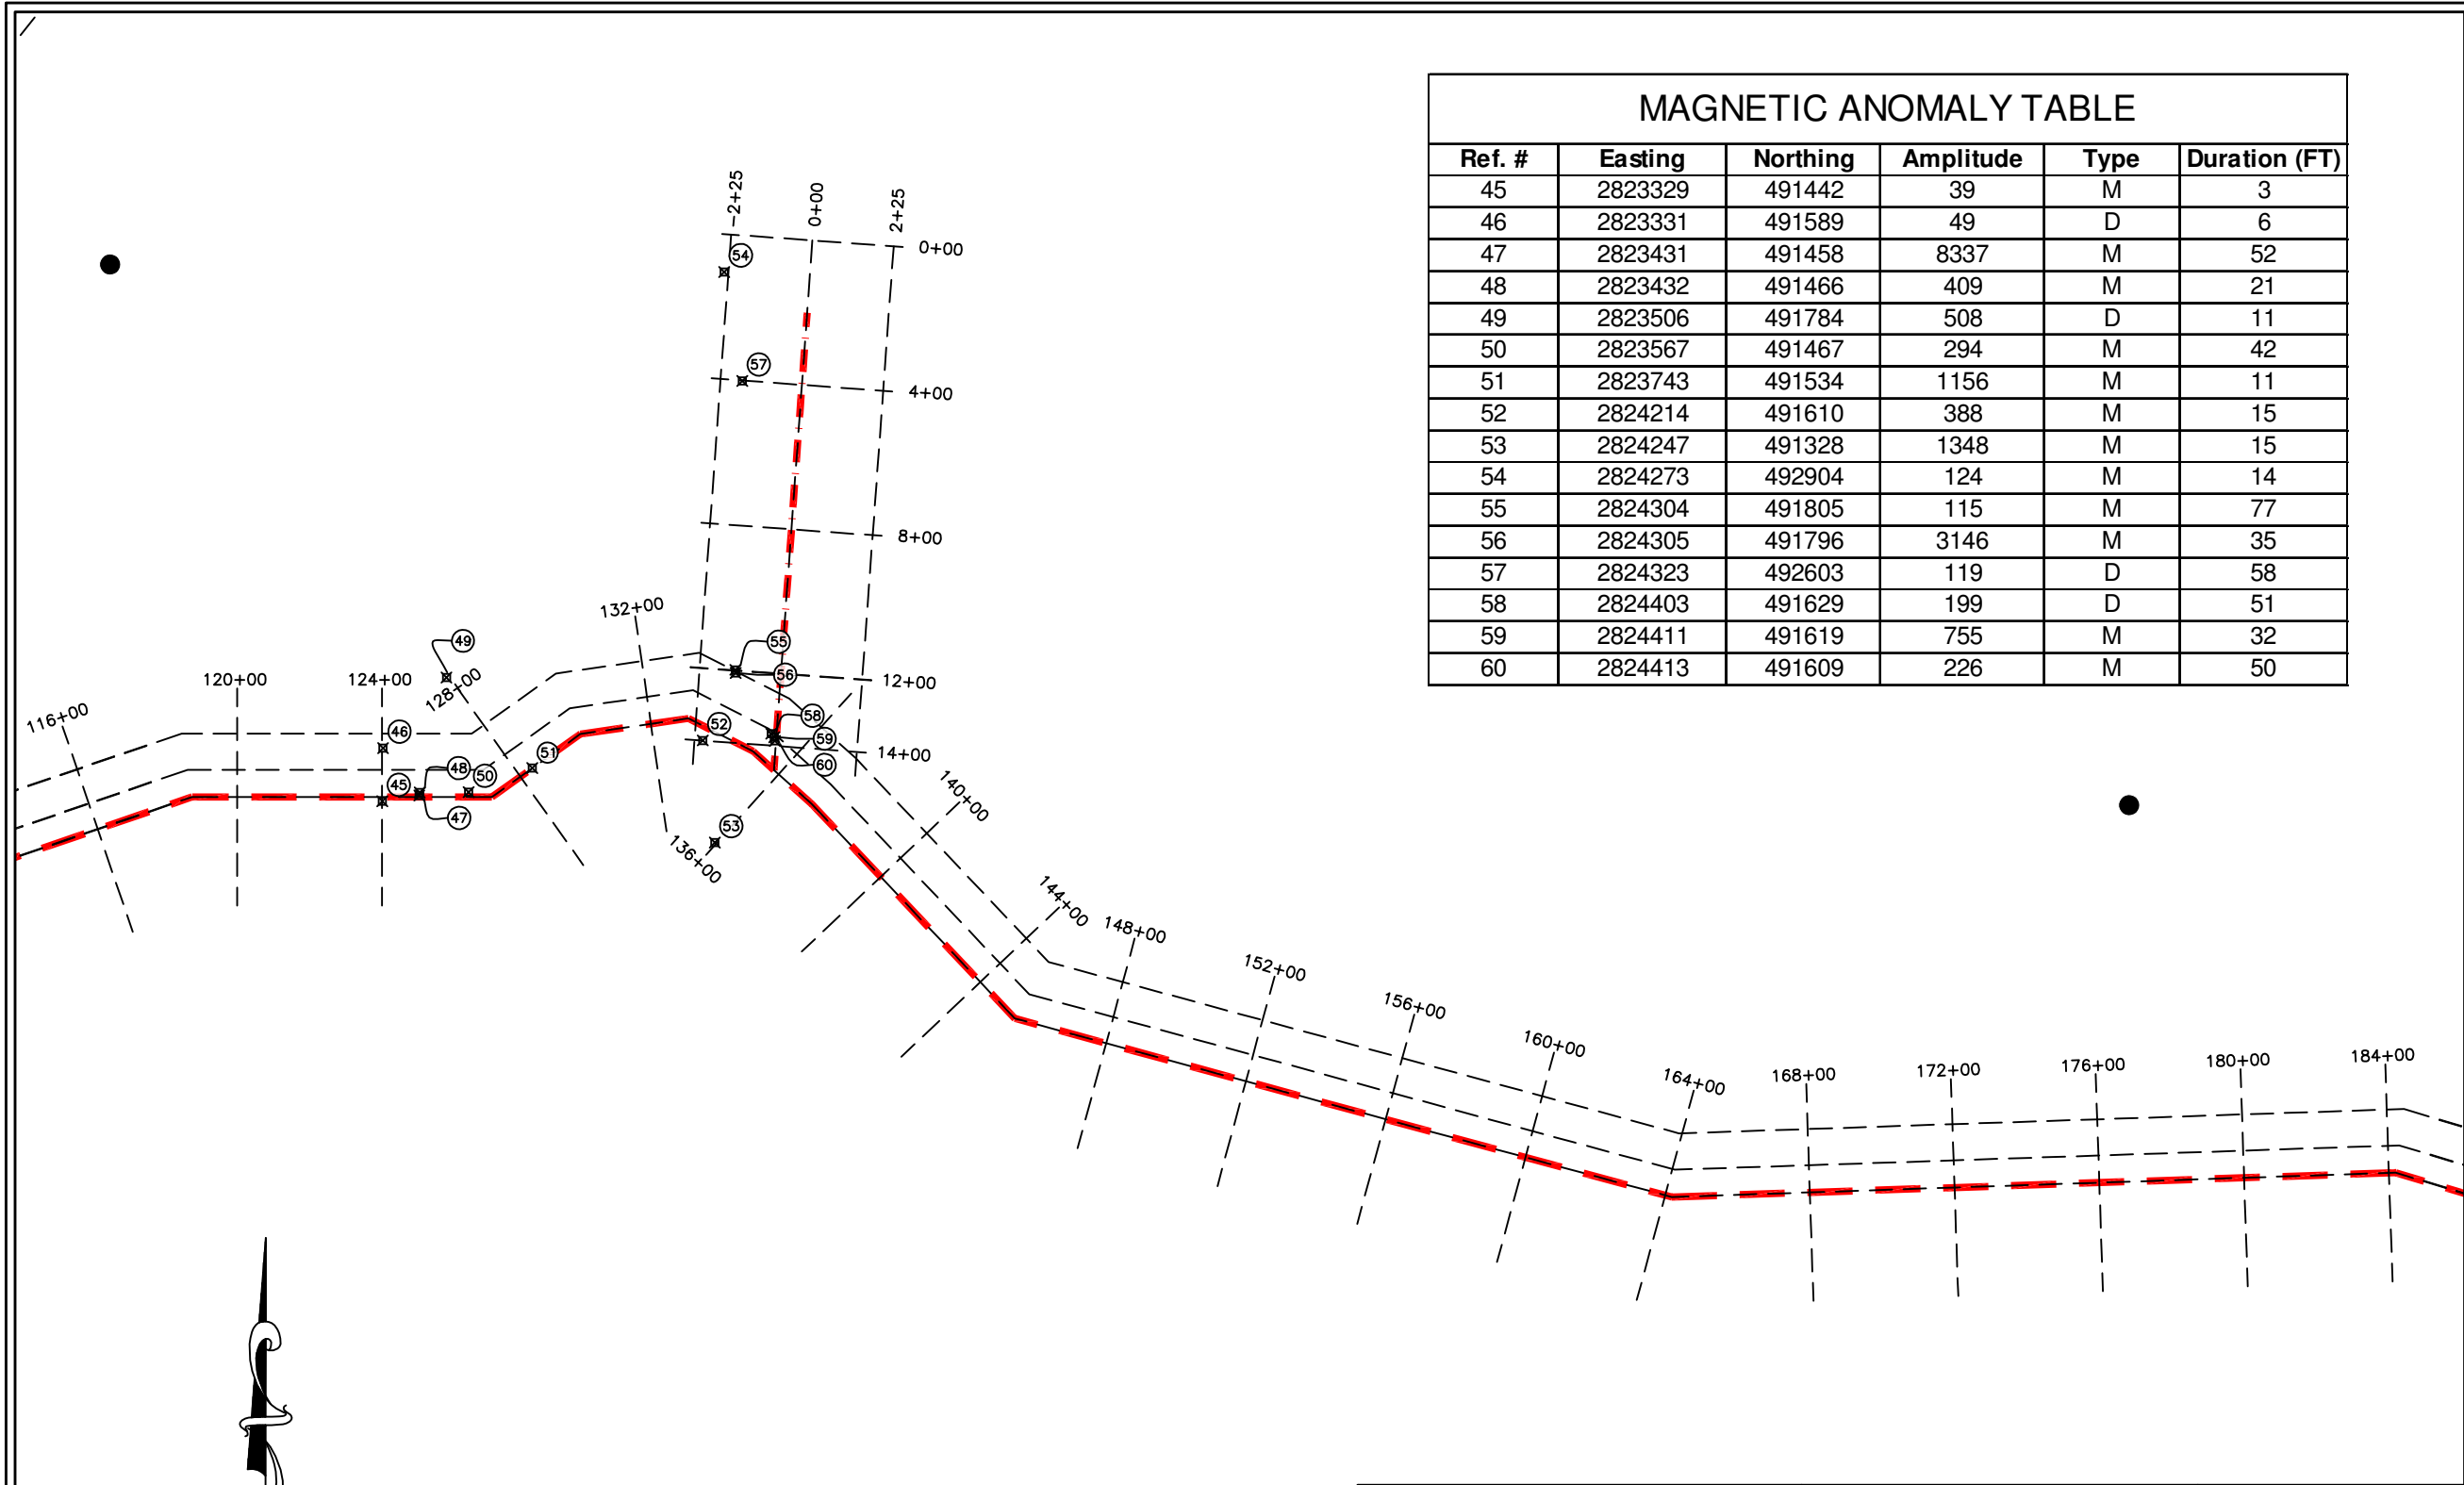

MAGNETIC ANOMALY TABLE


Ref. #	Easting	Northing	Amplitude	Type	Duration (FT)
45	2823329	491442	39	M	3
46	2823331	491589	49	D	6
47	2823431	491458	8337	M	52
48	2823432	491466	409	M	21
49	2823506	491784	508	D	11
50	2823567	491467	294	M	42
51	2823743	491534	1156	M	11
52	2824214	491610	388	M	15
53	2824247	491328	1348	M	15
54	2824273	492904	124	M	14
55	2824304	491805	115	M	77
56	2824305	491796	3146	M	35
57	2824323	492603	119	D	58
58	2824403	491629	199	D	51
59	2824411	491619	755	M	32
60	2824413	491609	226	M	50

LEGEND

- DIGITIZED PIPELINE
- PROPOSED ROCK BREAKWATERS
- PROPOSED ACCESS
- MAG ROUTE
- MAG ANOMALY
- DIGITIZED WELLS

NOTES

- ALL HORIZONTAL COORDINATES ARE BASED ON LOUISIANA SOUTH ZONE - NAD83 HPGN DATUM, US SURVEY FEET, DERIVED FROM KINEMATIC OBSERVATIONS CONSTRAINED TO PROJECT CONTROL (BENCHMARK ME20-SM-01)
- THE PROJECT IS LOCATED IN AN AREA OF HISTORICAL OIL & GAS EXPLORATION ACTIVITY, AND MAY CONTAIN ABANDONED IN PLACE PORTIONS OF PIPELINES THAT WERE UNABLE TO BE VERIFIED DURING THIS SURVEY. EXTREME CAUTION SHOULD BE USED WHEN ESCAVATING.
- THIS DRAWING INDICATES GENERAL CONDITIONS AT THE TIME OF SURVEY.
- MAGNETOMETER SURVEY DATA ACQUISITION WAS PERFORMED AUGUST 4TH, 2009 THROUGH AUGUST 07, 2009. MAGNETIC DATA WAS COLLECTED USING A GEOMETRICS 882 MAGNETOMETER.
- DIGITIZED WELLS AND PIPELINES OBTAINED VIA LADNR SONRIS DATABASE.

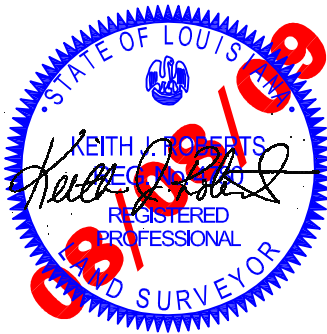

REVISED BY:

DATE:

PLAN SCALE  
SCALE: 1"=500'

500' 0' 250' 500'

LAND SURVEY AND HYDROGRAPHIC SOLUTIONS

GRAND LAKE SHORELINE  
PROTECTION PROJECT (ME-21)  
BEFORE DREDGE MAGNETOMETER SURVEY  
OF ACCESS CHANNELS AND FLOTATION  
CHANNEL AND ROCK BREAKWATERS  
(MAGNETOMETER SURVEY RESULTS)  
CAMERON PARISH, LA.

PREPARED BY: HYDROTERRA TECHNOLOGIES, LLC. - LAND SURVEY DIVISION - 1129 HUVAL LANE, BREAUX BRIDGE, LA. 70548







DATE: 08/08/09

JOB# 2091028



FILE: GRAND LAKE MAGNETOMETER SURVEY.DWG

 
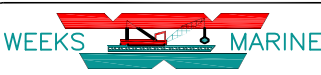
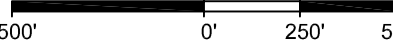
SHEET: 4 OF 7

 
MAGNETIC ANOMALY TABLE					
Ref. #	Easting	Northing	Amplitude	Type	Duration (FT)
61	2831286	489530	221	M	3
62	2834095	488753	185	M	23

LEGEND	
	DIGITIZED PIPELINE
	PROPOSED ROCK BREAKWATERS
	PROPOSED ACCESS
	MAG ROUTE
	MAG ANOMALY
	DIGITIZED WELLS

- NOTES
1. ALL HORIZONTAL COORDINATES ARE BASED ON LOUISIANA SOUTH ZONE - NAD83 HPGN DATUM, US SURVEY FEET, DERIVED FROM KINEMATIC OBSERVATIONS CONSTRAINED TO PROJECT CONTROL (BENCHMARK ME20-SM-01)
  2. THE PROJECT IS LOCATED IN AN AREA OF HISTORICAL OIL & GAS EXPLORATION ACTIVITY, AND MAY CONTAIN ABANDONED IN PLACE PORTIONS OF PIPELINES THAT WERE UNABLE TO BE VERIFIED DURING THIS SURVEY. EXTREME CAUTION SHOULD BE USED WHEN ESCAVATING.
  3. THIS DRAWING INDICATES GENERAL CONDITIONS AT THE TIME OF SURVEY.
  4. MAGNETOMETER SURVEY DATA ACQUISITION WAS PERFORMED AUGUST 4TH, 2009 THROUGH AUGUST 07, 2009. MAGNETIC DATA WAS COLLECTED USING A GEOMETRICS 882 MAGNETOMETER.
  5. DIGITIZED WELLS AND PIPELINES OBTAINED VIA LADNR SONRIS DATABASE.

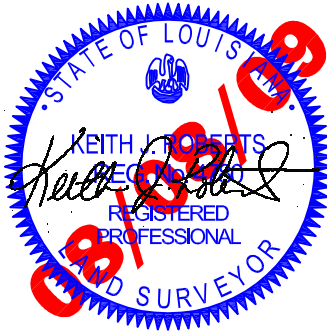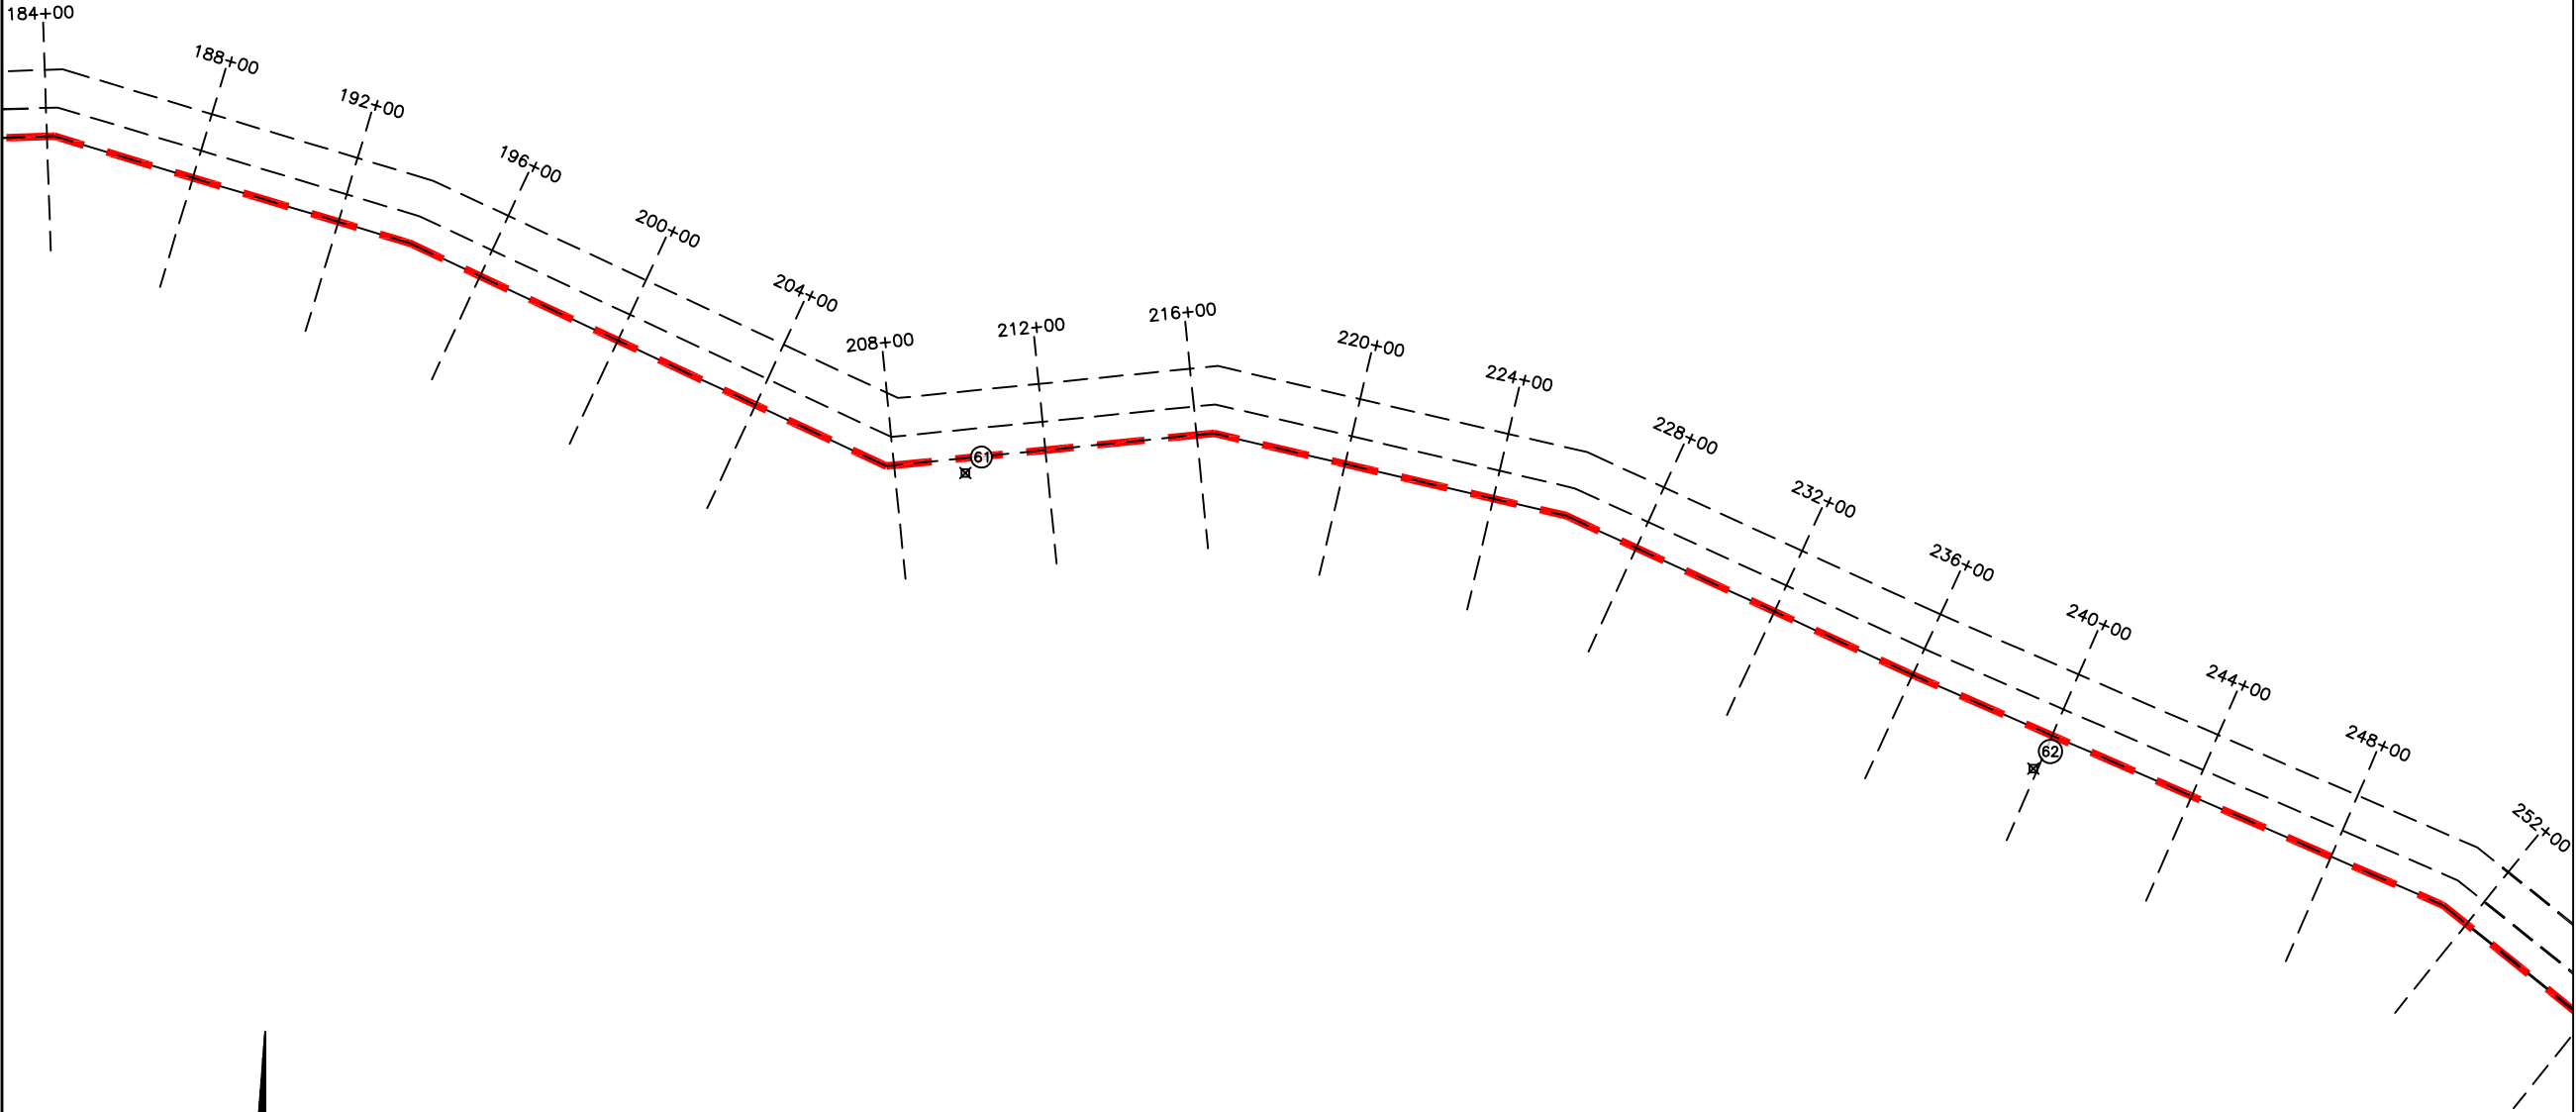

REVISED BY:	DATE:	 	<b>GRAND LAKE SHORELINE PROTECTION PROJECT (ME-21) BEFORE DREDGE MAGNETOMETER SURVEY OF ACCESS CHANNELS AND FLOTATION CHANNEL AND ROCK BREAKWATERS (MAGNETOMETER SURVEY RESULTS) CAMERON PARISH, LA.</b>
<b>PLAN SCALE SCALE: 1"=500'</b> 		PREPARED BY: HYDROTERRA TECHNOLOGIES, LLC. - LAND SURVEY DIVISION - 1129 HUVAL LANE, BREAUX BRIDGE, LA. 70548	
DATE: 08/08/09	JOB# 2091028	FILE: GRAND LAKE MAGNETOMETER SURVEY.DWG	SHEET: 5 OF 7

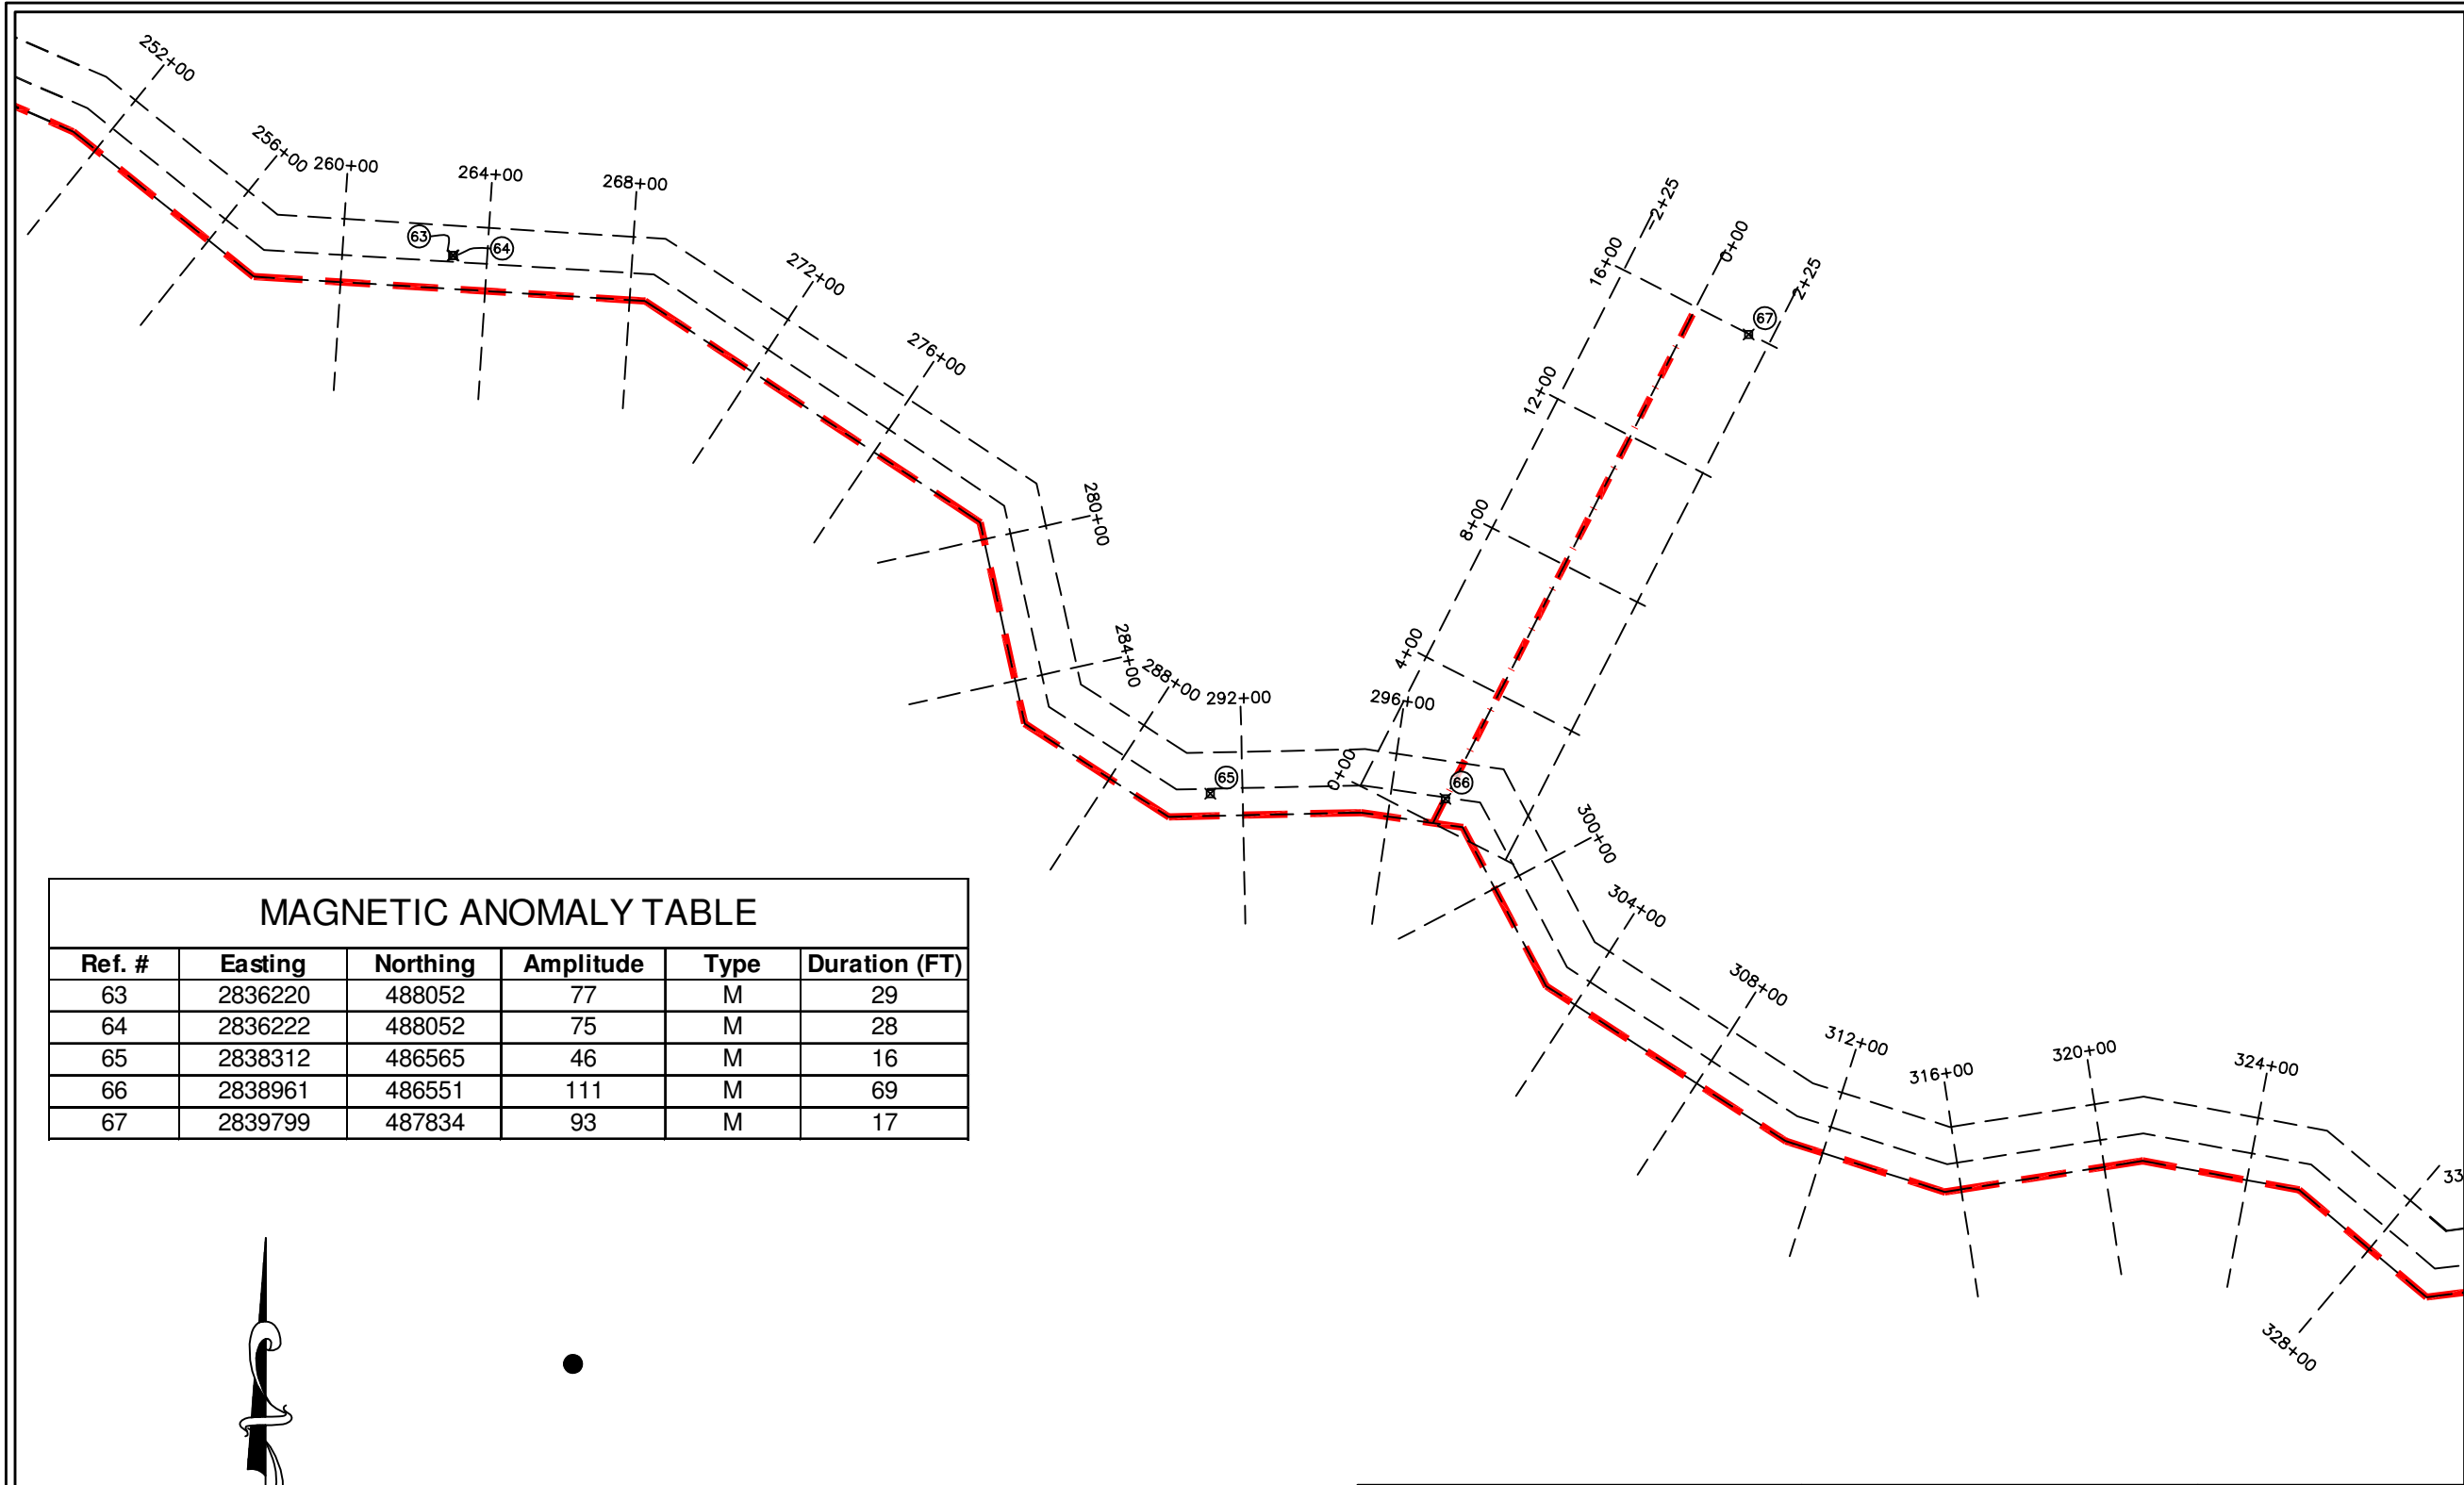

LEGEND

DIGITIZED PIPELINE

PROPOSED ROCK BREAKWATERS

PROPOSED ACCESS

MAG ROUTE

MAG ANOMALY

DIGITIZED WELLS

- NOTES
1. ALL HORIZONTAL COORDINATES ARE BASED ON LOUISIANA SOUTH ZONE - NAD83 HPGN DATUM, US SURVEY FEET, DERIVED FROM KINEMATIC OBSERVATIONS CONSTRAINED TO PROJECT CONTROL (BENCHMARK ME20-SM-01)

2. THE PROJECT IS LOCATED IN AN AREA OF HISTORICAL OIL & GAS EXPLORATION ACTIVITY, AND MAY CONTAIN ABANDONED IN PLACE PORTIONS OF PIPELINES THAT WERE UNABLE TO BE VERIFIED DURING THIS SURVEY. EXTREME CAUTION SHOULD BE USED WHEN ESCAVATING.


3. THIS DRAWING INDICATES GENERAL CONDITIONS AT THE TIME OF SURVEY.

4. MAGNETOMETER SURVEY DATA ACQUISITION WAS PERFORMED AUGUST 4TH, 2009 THROUGH AUGUST 07, 2009. MAGNETIC DATA WAS COLLECTED USING A GEOMETRICS 882 MAGNETOMETER.

5. DIGITIZED WELLS AND PIPELINES OBTAINED VIA LADNR SONRIS DATABASE.

MAGNETIC ANOMALY TABLE

Ref. #	Easting	Northing	Amplitude	Type	Duration (FT)
63	2836220	488052	77	M	29
64	2836222	488052	75	M	28
65	2838312	486565	46	M	16
66	2838961	486551	111	M	69
67	2839799	487834	93	M	17

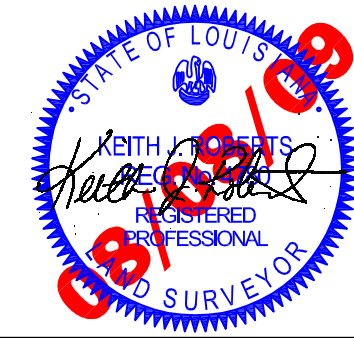

REVISED BY:

DATE:

PLAN SCALE  
SCALE: 1"=500'

500' 0' 250' 500'

HYDROTERRA

TECHNOLOGIES, LLC

LAND SURVEY AND HYDROGRAPHIC SOLUTIONS

WEEKS

MARINE

GRAND LAKE SHORELINE  
PROTECTION PROJECT (ME-21)  
BEFORE DREDGE MAGNETOMETER SURVEY  
OF ACCESS CHANNELS AND FLOTATION  
CHANNEL AND ROCK BREAKWATERS  
(MAGNETOMETER SURVEY RESULTS)  
CAMERON PARISH, LA.


PREPARED BY: HYDROTERRA TECHNOLOGIES, LLC. - LAND SURVEY DIVISION - 1129 HUVAL LANE, BREAUX BRIDGE, LA. 70548

DATE: 08/08/09

JOB# 2091028

FILE: GRAND LAKE MAGNETOMETER SURVEY.DWG

SHEET: 6 OF 7

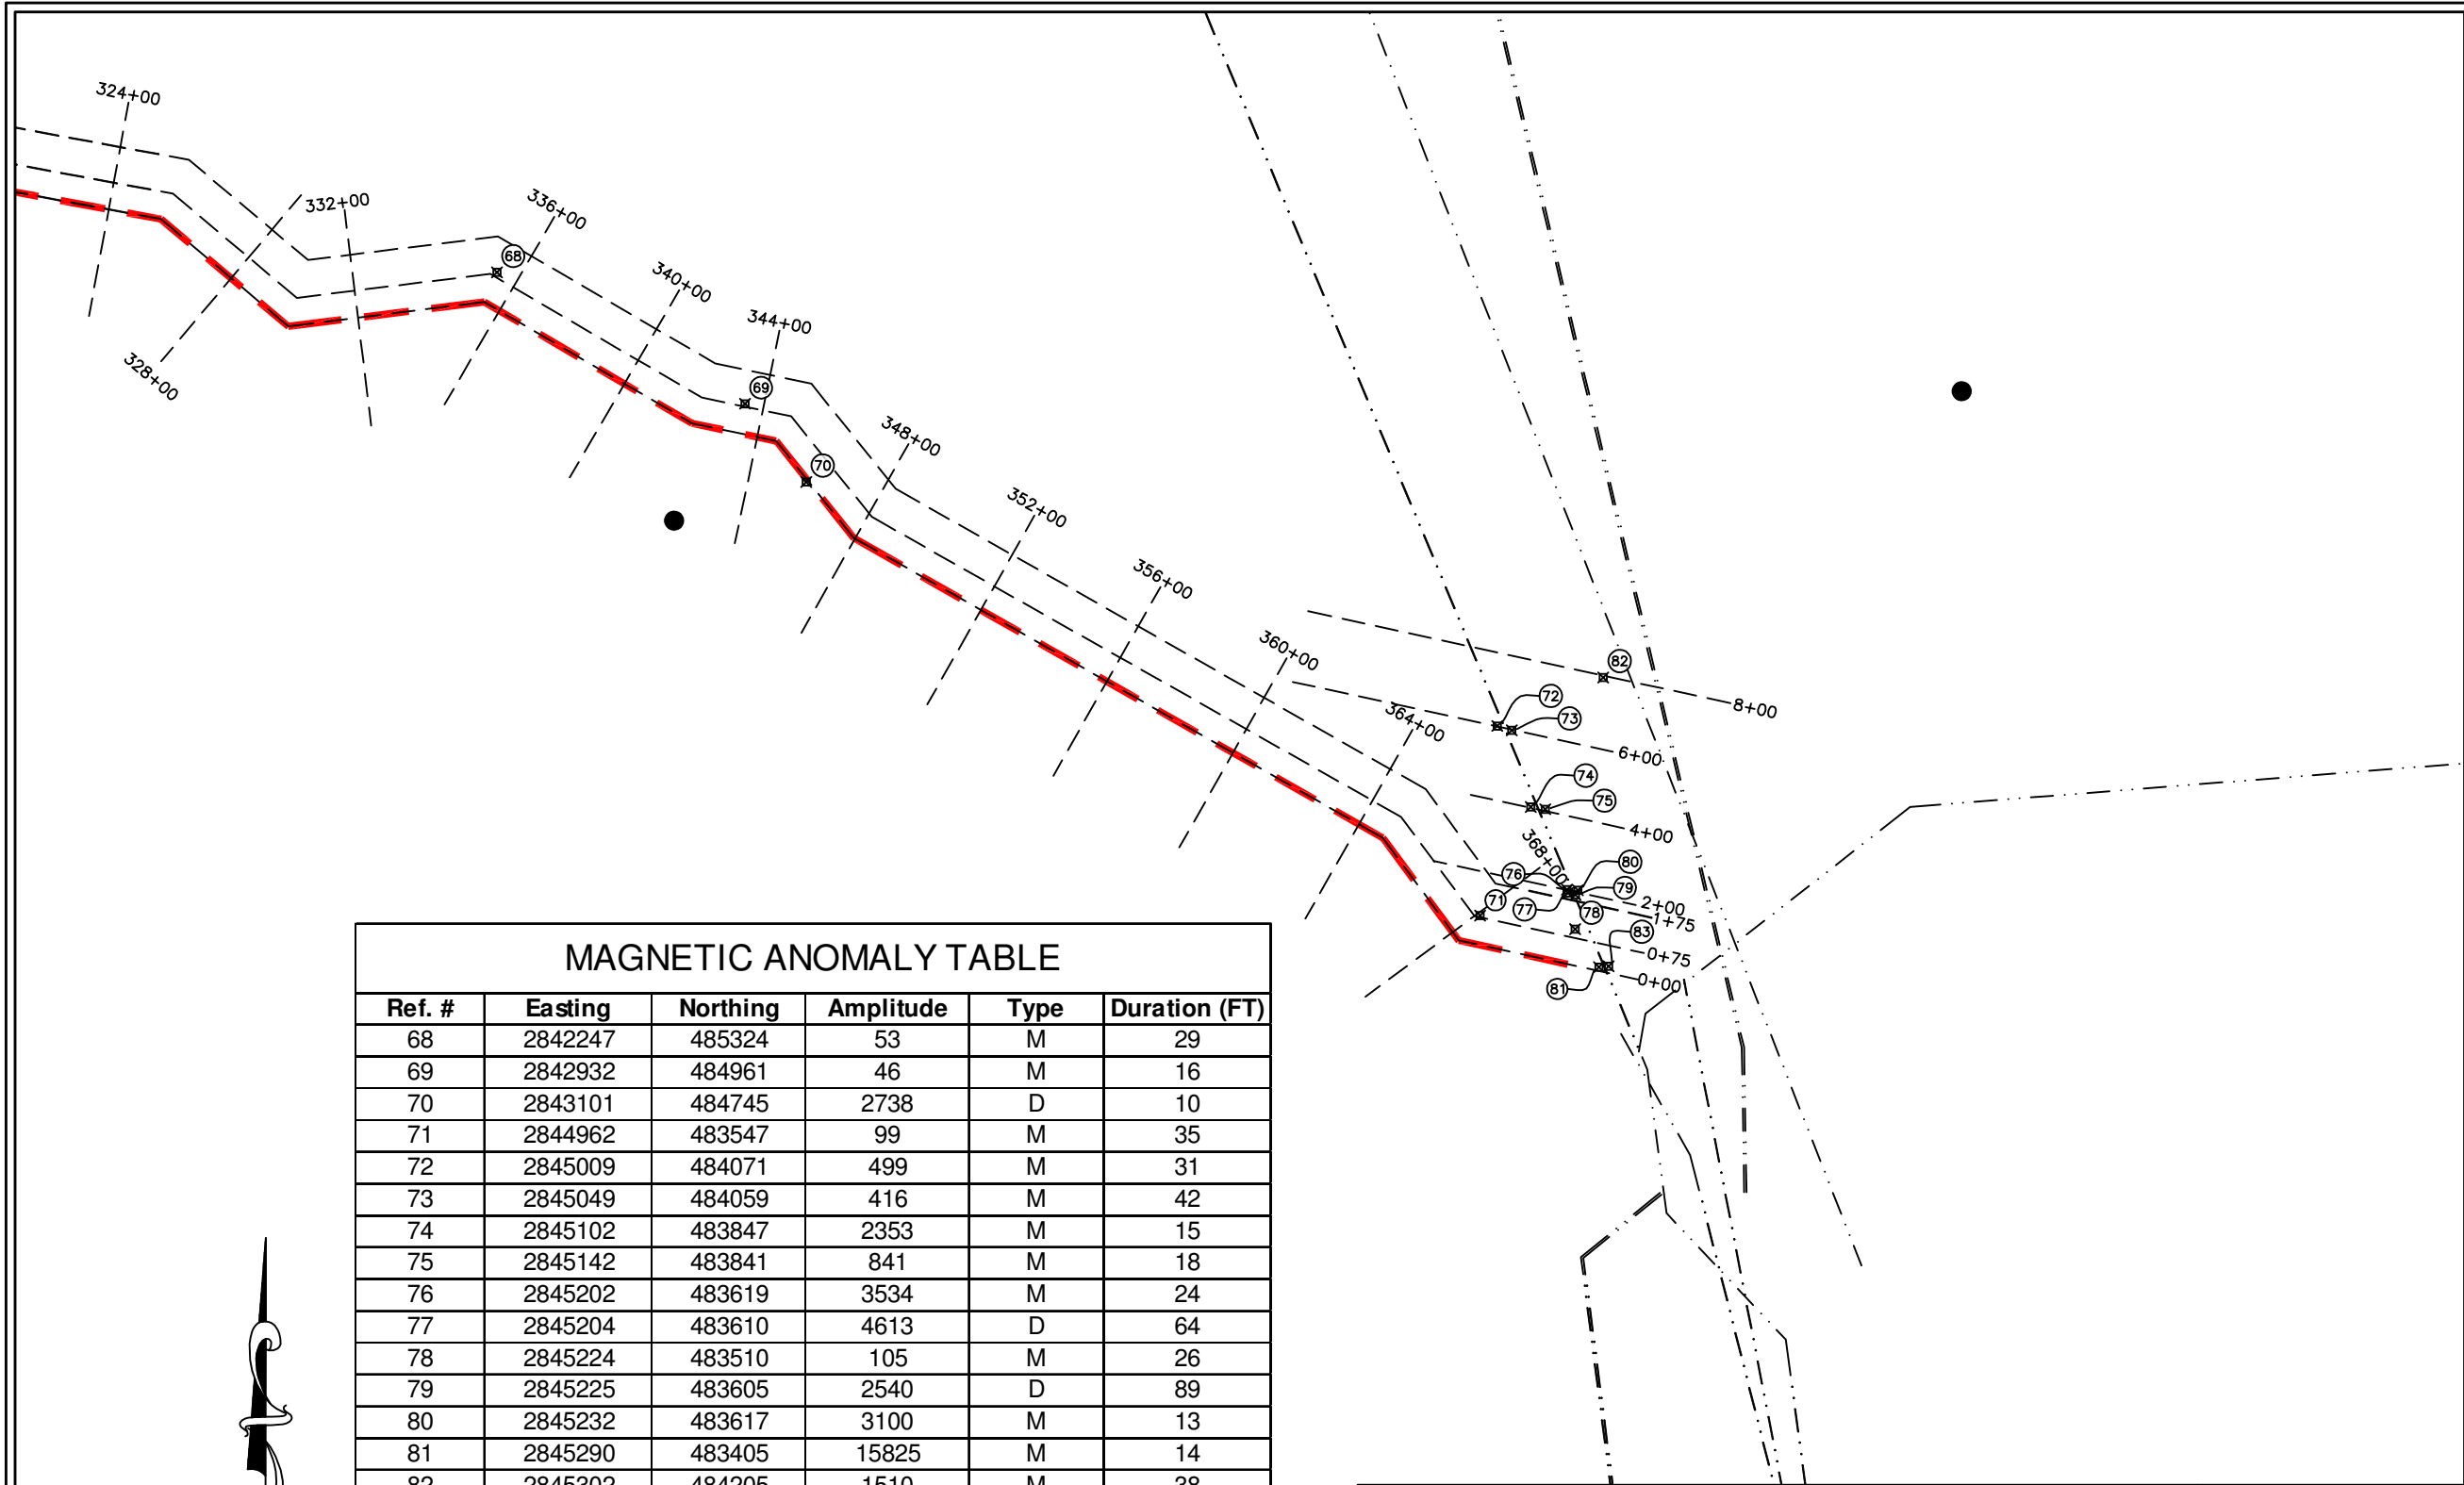


MAGNETIC ANOMALY TABLE

Ref. #	Easting	Northing	Amplitude	Type	Duration (FT)
68	2842247	485324	53	M	29
69	2842932	484961	46	M	16
70	2843101	484745	2738	D	10
71	2844962	483547	99	M	35
72	2845009	484071	499	M	31
73	2845049	484059	416	M	42
74	2845102	483847	2353	M	15
75	2845142	483841	841	M	18
76	2845202	483619	3534	M	24
77	2845204	483610	4613	D	64
78	2845224	483510	105	M	26
79	2845225	483605	2540	D	89
80	2845232	483617	3100	M	13
81	2845290	483405	15825	M	14
82	2845302	484205	1510	M	38
83	2845317	483407	1155	M	6

LEGEND	
	DIGITIZED PIPELINE
	PROPOSED ROCK BREAKWATERS
	PROPOSED ACCESS
	MAG ROUTE
	MAG ANOMALY
	DIGITIZED WELLS

- NOTES
1. ALL HORIZONTAL COORDINATES ARE BASED ON LOUISIANA SOUTH ZONE - NAD83 HPGN DATUM, US SURVEY FEET, DERIVED FROM KINEMATIC OBSERVATIONS CONSTRAINED TO PROJECT CONTROL (BENCHMARK ME20-SM-01)
  2. THE PROJECT IS LOCATED IN AN AREA OF HISTORICAL OIL & GAS EXPLORATION ACTIVITY, AND MAY CONTAIN ABANDONED IN PLACE PORTIONS OF PIPELINES THAT WERE UNABLE TO BE VERIFIED DURING THIS SURVEY. EXTREME CAUTION SHOULD BE USED WHEN ESCAVATING.
  3. THIS DRAWING INDICATES GENERAL CONDITIONS AT THE TIME OF SURVEY.
  4. MAGNETOMETER SURVEY DATA ACQUISITION WAS PERFORMED AUGUST 4TH, 2009 THROUGH AUGUST 07, 2009. MAGNETIC DATA WAS COLLECTED USING A GEOMETRICS 882 MAGNETOMETER.
  5. DIGITIZED WELLS AND PIPELINES OBTAINED VIA LADNR SONRIS DATABASE.

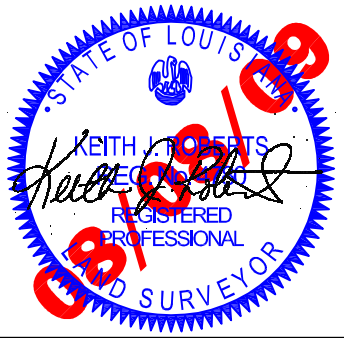

REVISED BY:

DATE:

GRAND LAKE SHORELINE  
PROTECTION PROJECT (ME-21)  
BEFORE DREDGE MAGNETOMETER SURVEY  
OF ACCESS CHANNELS AND FLOTATION  
CHANNEL AND ROCK BREAKWATERS  
(MAGNETOMETER SURVEY RESULTS)  
CAMERON PARISH, LA.

PREPARED BY: HYDROTERRA TECHNOLOGIES, LLC. - LAND SURVEY DIVISION - 1129 HUVAL LANE, BREAUX BRIDGE, LA. 70548

DATE: 08/08/09    JOB# 2091028    FILE: GRAND LAKE MAGNETOMETER SURVEY.DWG    SHEET: 7 OF 7

