

**Scofield Pass Pipeline Location, Survey, and Mapping
For BA-38 Pelican Island Restoration
Contract No. WC133F-05-CQ-1027**

Prepared for:

**U.S. Department of Commerce, NOAA
and
National Marine Fisheries Service
and
Louisiana Department National Resources**

Prepared by:

Coastal Planning & Engineering, Inc.

August 2005

**Scofield Pass Pipeline Location, Survey, and Mapping
For BA-38 Pelican Island Restoration
Contract No. WC133F-05-CQ-1027**

Table of Contents

I. Introduction	1
II. Methods	1
III. Results	4
IV. Recommendations	8

List of Figures

Figure No.

1	RTK GPS and Magnetometer Operations.....	2
2	20-foot PVC Jet Probe Pipe being water-jetted into the ground above the TGP 20" pipeline	3
3	Magnetometer Data and Jet Probe Locations	5
4	Bathymetric Data	6

List of Tables

Table No.

1	Table of Magnetometer Targets.....	7
---	------------------------------------	---

List of Appendices

Appendix No.

1	Field Work Synopsis
2	Tennessee Gas Pipeline Company Completion Drawings: TO-F2-526A-100-3 TO-F2-527A-100-5 TO-F2-527A-100-5A
3	Field Notes

**Scofield Pass Pipeline Location, Survey, and Mapping
For BA-38 Pelican Island Restoration
Contract No. WC133F-05-CQ-1027**

I. Introduction

In support of the Pelican Island Restoration CWPPRA Project, CPE conducted survey and geotechnical investigations in Scofield Pass. These investigations were aimed at locating three existing pipelines that run underneath Scofield Pass in order to determine the feasibility of excavating construction access within the pass. To that end, CPE planned on using a magnetometer and jet probes in order to resolve the location and elevation of these three gas pipelines. Preliminary indications were that Scofield Pass had a water depth of approximately 3 to 4 feet and that the pipelines were buried an additional 3 to 10 feet beneath the seafloor. These conditions would allow wading access to all three Scofield Pass pipeline corridors in order to attempt boat-supported, seafloor-based jet probe investigations. Upon arrival, it was observed that these conditions were not present. In fact, an existing channel, greater than -9.8 feet North American Vertical Datum 1988 (NAVD '88), with a strong tidal current prevented CPE from attempting jet probes within the channel thalweg of Scofield Pass. Based on the conditions present, CPE attempted to locate the pipelines adjacent to the Scofield Pass channel via jet probes and terrestrial magnetometer surveys, and within the Pass via marine magnetometer surveys. In addition, CPE undertook a bathymetric survey of the Pass in order to determine the depth of the existing channel and necessity of excavation for construction access. These investigations resulted in the location of the 26" Tennessee Gas Pipeline (TGP) horizontally and vertically at two separate points, and the magnetic location of the 20" TGP and 8" Promix pipelines, with the minimum elevation of the pipes as being greater than -9.8 feet NAVD '88. In addition, an existing channel within Scofield Pass was found to be greater than -9.8 feet NAVD '88 in depth and ranged from 260 feet to 450 feet wide. These results indicate that excavation of Scofield Pass, above the existing pipelines, may not be necessary for construction access at this time and that a detailed bathymetric survey should be completed prior to construction in order to verify these findings. If, at that time, excavation is needed, it is recommended that dredging does not exceed -9.8 feet NAVD '88 and that any excavation be limited to the existing channel as defined in this survey. This report describes the investigation methods, fieldwork synopsis (Appendix 1), results, and recommendations.

II. Methods

a. Real Time Kinematics (RTK) Global Positioning System (GPS)

An initial reconnaissance of the Pelican Island region found two survey control points; the LDNR "Scofield" monument near Fontanelle Pass (Empire Jetty) at 3831442.9E, 278379.21N, and the LDNR "Shell Island" monument located on Shell Island at 3870459.93E, 266494.79N. The "Scofield" monument was visually inspected and appeared to be in place and undisturbed. An RTK GPS Base Station was then setup on the "Scofield" monument. Once the RTK GPS

system was operational, an iron rod and cap monument (“Pelican Base”) was placed on Scofield Island at 276525.392E, 3845186.2N, to be used as a base station setup point for the survey. Once “Pelican Base” was established, the RTK GPS base station was moved to the point (Figure 1). At that time, the “Scofield” and “Shell Island” LDNR monuments were revisited to check the accuracy of the new Scofield Island survey point. The horizontal and vertical accuracy of this survey was found to be within an acceptable tolerance of 0.4 feet to locate the pipelines. Horizontal positioning checks were conducted at the beginning and end of each day at existing monuments located in the project area to confirm daily accuracy.

b. Bathymetric Survey

A Differential Global Positioning System (DGPS) coupled with water depth readings determined by manual survey rod was input to an onboard computer and the data integrated in real time using the Coastal Oceanographic Hydrographic Data Collection and Processing (HYPACK) program, a state-of-the-art navigation and hydrographic surveying system. These data were tide corrected using manual tide readings.



Figure 1. “Pelican Base” survey point and RTK GPS base station located on Scofield Island (left). Terrestrial based magnetometer survey and magnetic anomalies (right).

c. Magnetometer Survey

To determine the location of the pipeline crossings, a magnetometer was used to find magnetic anomalies within and around Scofield Pass. For the marine magnetometer surveys, a Geometrics 881 Digital Cesium Magnetometer was interfaced to the HYPACK navigation computer and DGPS and towed by the Louisiana Universities Marine Consortium (LUMCON) vessel *Whiskey Pass*. The terrestrial magnetometer surveys utilized the same Geometrics 881 Digital

Cesium Magnetometer being carried on land, with a computer operator marking the magnetic anomalies with survey witness posts (Figure 1).

d. Jet Probing

The jet probing procedure involves water-jetting a 20-foot long PVC pipe into the seafloor using a water pump mounted either on the deck of the *Whiskey Pass* or on the shore (Figure 2). As the probe penetrates sediment on the seafloor, a CPE geologist observes the depth of the probe and the characteristics of the sub-surface sediment. The geologist estimates characteristics of sub-surface sediments from resistance of the probe to penetration, the “feel” of the probe as it penetrates the sediments, and from observation of sediments flushed out of the hole. For this project, the purpose of jet probing was to encounter “refusal” of the PVC jet probe pipe caused by contact with the upper surface of a pipeline. Anticipated refusal of the probe on a pipeline is easily determined when the probe encounters a solid object that curtails penetration.

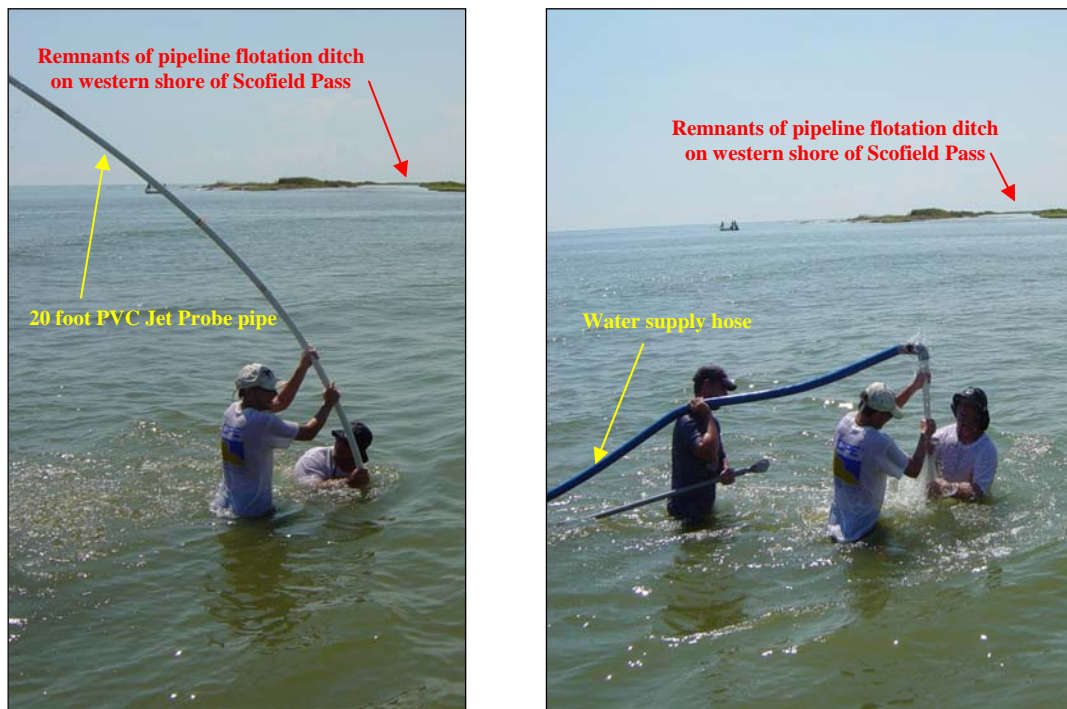


Figure 2. 20-foot PVC Jet Probe Pipe being water-jetted into the ground above the TGP 20” pipeline.

e. Weighted Line Survey

Two individual lines attached to weights were dragged along the channel thalweg by hand from either side of the *Whiskey Pass* at idle speed. The purpose of this survey was to “feel” the channel bottom with the weighted lines in order to determine if the pipelines were exposed or suspended within the water column.

f. Pipeline Company Consultation

The owners of the pipelines were contacted for consultation. In each case, the company representatives were forthcoming and helpful. Mr. Kurt Chermaie (985-223-6417) of Tennessee Gas and Pipeline Co. (TGP) was contacted regarding the existing TGP 20" and 26" pipelines. Mr. Chermaie answered all of the pertinent questions and provided us with Completion Drawings TO-F2-527A-100-5, TO-F2-527A-100-5A, and TO-F2-526A-100-3 (Appendix 2).


Mr. Joel Kohler (225-675-2507) of Promix was consulted regarding the Promix (Wanda) 8" pipeline. Mr. Kohler indicated that this pipeline had been inactive for many years and subsequently abandoned. Since it was abandoned, Promix had done no maintenance on this pipeline and Mr. Kohler stated that its existence may be in question due to long-term degradation and neglect. As a consequence, no engineering or construction drawings were provided to CPE for the Promix 8" pipeline.

III. Results

a. 26" Tennessee Gas Pipeline

The marine and terrestrial magnetometer surveys resulted in several magnetic anomalies (M14 – M16) along the expected pipeline (Figure 3 and Table 1). The magnetic anomalies, coupled with the expected pipeline azimuth, allowed for the successful location of the TGP 26" pipeline via jet probing. The jet probes were located on the low-lying remnants of the pipeline flotation ditch on the eastern edge of Scofield Pass (Figure 3). The first jet probe, located near the shoreline at 3845139E, 276786N, suggested a pipeline elevation of -16.1 feet NAVD, '88. The second jet probe was located further seaward at 3845105E, 276823N, and suggested a pipeline elevation of -21.5 feet NAVD '88.

The bathymetric survey along the TGP 26" pipeline corridor indicated that the Scofield Pass channel thalweg was 450 feet wide at a depth greater than -15 feet NAVD '88, with a maximum depth of -24 feet NAVD '88 (Figure 4 and Profile A). One reconnaissance SCUBA dive in 17 feet of water along with a weighted line survey indicated that this pipeline is not exposed or suspended in the water column.

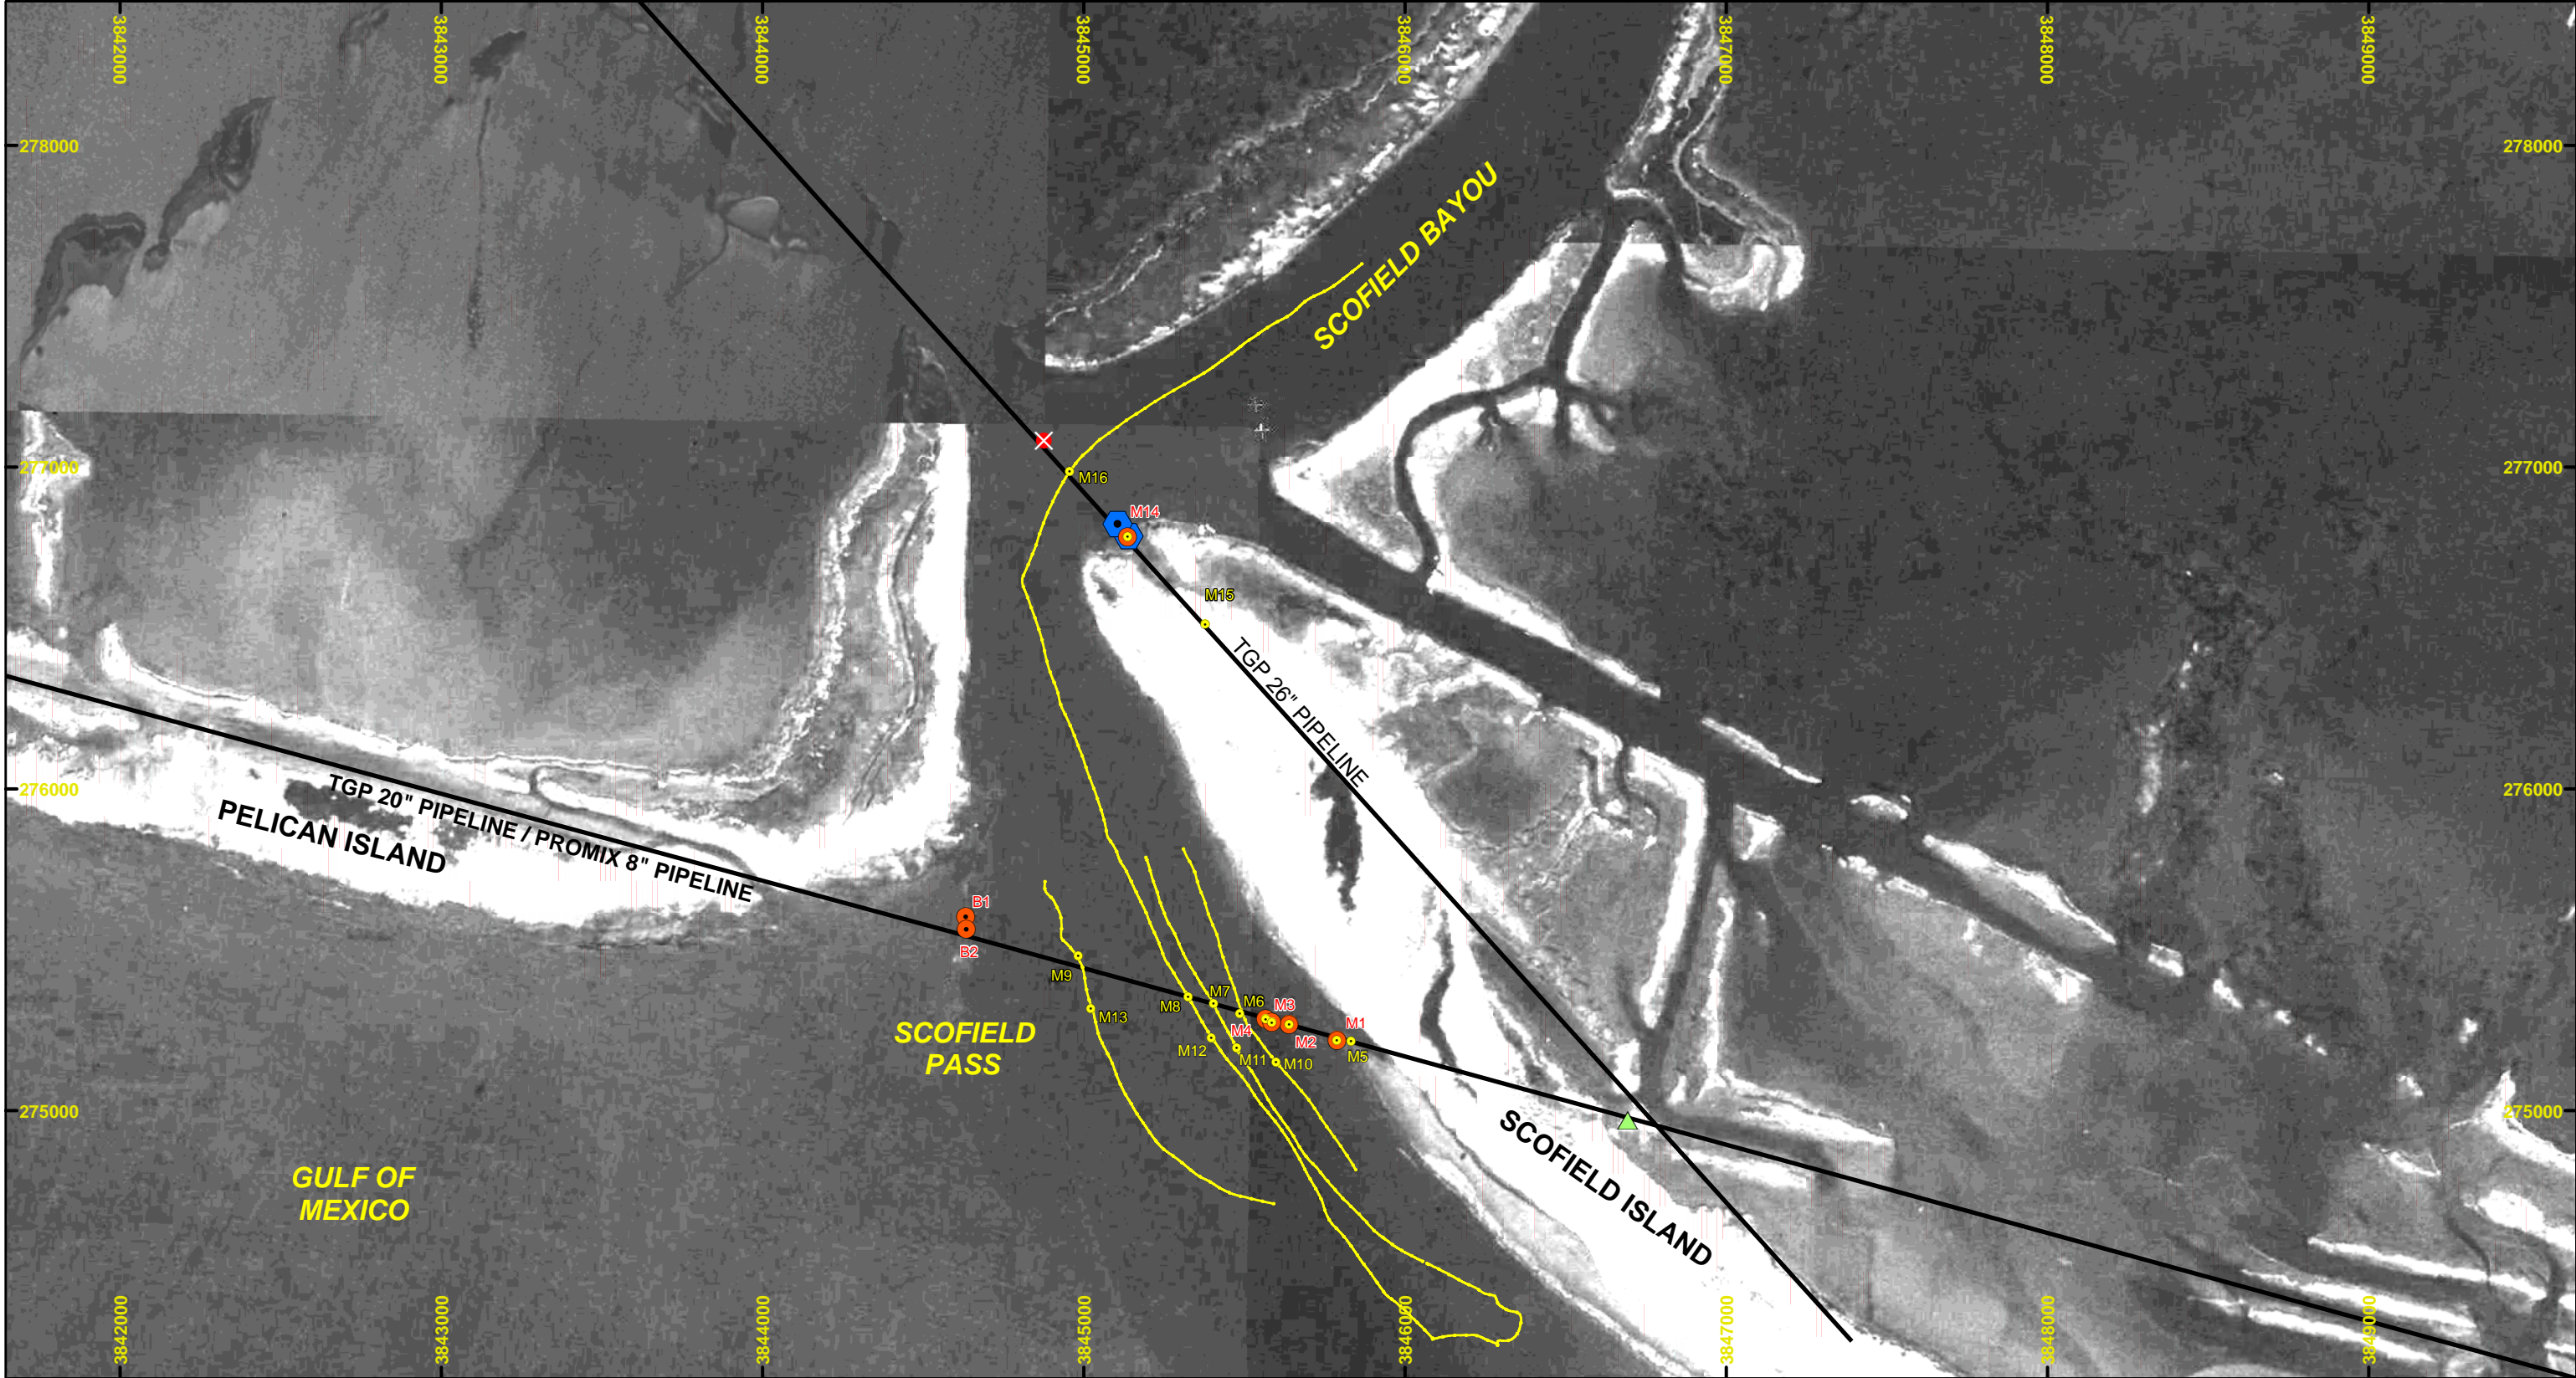


NOTES

1. COORDINATES SHOWN HEREON ARE IN FEET BASED ON THE LOUISIANA STATE PLANE COORDINATE SYSTEM SOUTH ZONE, NORTH AMERICAN DATUM (NAD 1983)
2. DATE OF AERIAL PHOTOGRAPHY: 03/18/2004
3. CPE MAGNETOMETER DATA SHOWN WAS COLLECTED WITH THE GEOMETRICS 881.

LEGEND


- MAGNETOMETER TARGETS
- SCUBA DIVE LOCATION
- JET PROBE LOCATION
- CONFIRMED PIPELINE
- VALVE PLATFORM
- MAGNETOMETER TRACKLINE
- 2003 PUBLISHED PIPELINE LOCATIONS

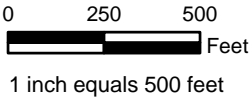

TITLE: **SCOFIELD PASS PIPELINE SURVEY
MAGNETOMETER DATA AND JET
PROBE LOCATIONS**



COASTAL PLANNING & ENGINEERING, INC.
2481 N.W. BOCA RATON BLVD.
BOCA RATON, FL 33431
PH.(561)391-8102
FAX. (561)391-9116

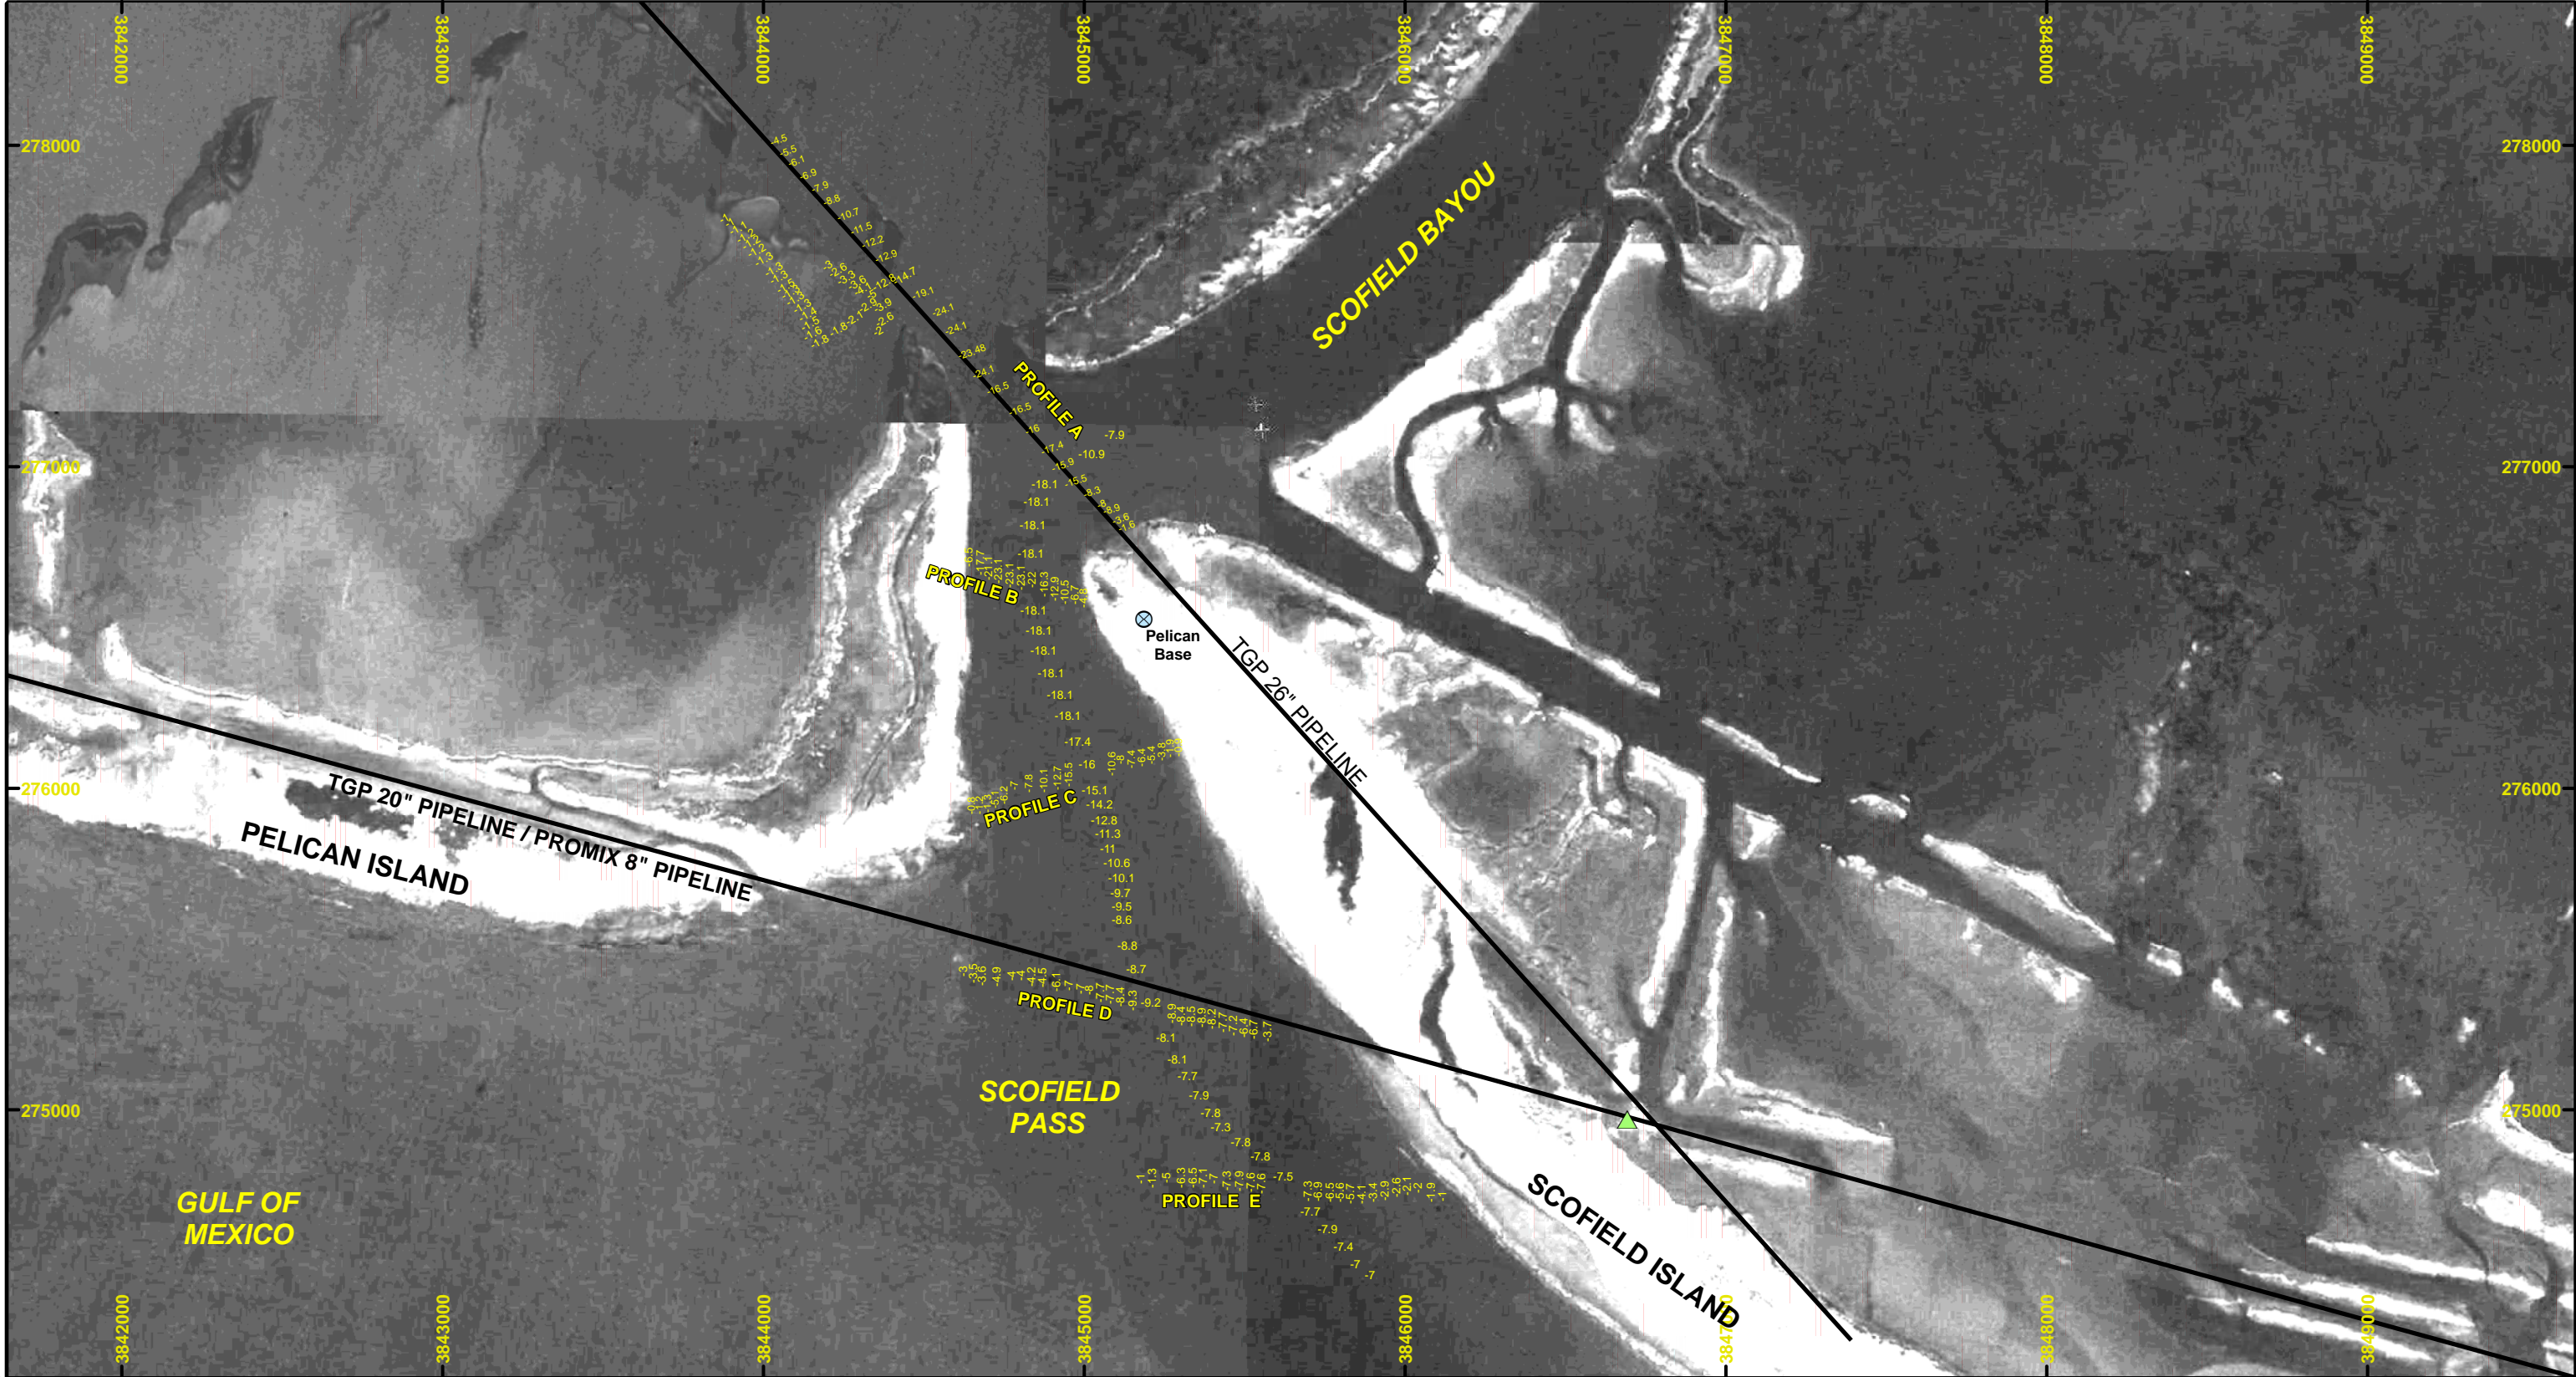


NOTES

- 1. COORDINATES SHOWN HEREON ARE IN FEET BASED ON THE LOUISIANA STATE PLANE COORDINATE SYSTEM SOUTH ZONE, NORTH AMERICAN DATUM (NAD 1983)
- 2. DATE OF AERIAL PHOTOGRAPHY: 03/18/2004
- 3. DEPTHS SHOWN HEREON ARE IN FEET BASED ON THE NORTH AMERICAN VERTICAL DATUM (NAVD 1988)

LEGEND

- ⊗ BASE STATION
- ▲ VALVE PLATFORM
- 2003 PUBLISHED PIPELINE LOCATIONS

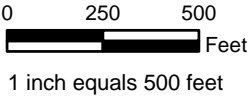

TITLE: **SCOFIELD PASS PIPELINE SURVEY
BATHYMETRIC DATA**



COASTAL PLANNING & ENGINEERING, INC.
2481 N.W. BOCA RATON BLVD.
BOCA RATON, FL 33431
PH.(561)391-8102
FAX. (561)391-9116

G:\Louisiana\726121.mxd\762121_Pipeline_BATHYDATA_072905.mxd

Table 1. Table of Magnetometer Targets

Name	Signature Type	Amplitude	Northing	Easting
M1	Monopolar	~350	275219	3845788
M2	Monopolar	~350	275269	3845639
M3	Monopolar	~350	275275	3845585
M4	Monopolar	~350	275285	3845566
M5	Monopolar	~350	275215	3845832
M6	Monopolar	824	275302	3845485
M7	Monopolar	326	275333	3845404
M8	Monopolar	991	275354	3845325
M9	Monopolar	401	275482	3844983
M10	Monopolar	1403	275151	3845598
M11	Dipolar	1131	275196	3845476
M12	Dipolar	1538	275227	3845397
M13	Monopolar	1892	275317	3845022
M14	Monopolar	~350	276783	3845136
M15	Monopolar	~350	276512	3845377
M16	Monopolar	329	276986	3844956

b. 20” Tennessee Gas Pipeline

The marine and terrestrial magnetometer surveys resulted in the detection of several magnetic anomalies (M1 – M9) along the expected pipeline corridor (Figure 3 and Table 1). Multiple jet probe attempts (>10) were conducted along four lines (approximately 30 feet in length) perpendicular to the expected pipeline corridor on either side of the magnetic anomalies on the eastern shore of Scofield Pass (Figure 3). These jet probes penetrated sediments to -20 and -22 feet NAVD '88 without encountering the pipeline. Additionally, the azimuth of the center-channel magnetic anomalies was extrapolated to the western edge of the channel where numerous jet probes attempts (>15) were completed on a perpendicular line (>30 feet in length) between 3844632E, 275602N, and 3844634E, 275564N, (Figure 3). None of these jet probes located the TGP 20” pipeline. There was consistent refusal of these western jet probes at approximately -15 to -16.5 feet NAVD '88. Even though multiple jet probes penetrated approximately -15 to -22 feet NAVD '88 and did not encounter the buried pipeline, it is not certain if the pipeline is buried deeper than refusal or if these particular jet probe locations failed to locate the top of a shallower pipeline.

The bathymetric survey along the TGP 20” pipeline corridor showed that the Scofield Pass channel thalweg was 260-feet wide and greater than -8 feet NAVD '88 in depth, with a maximum depth of -9.8 feet NAVD '88 (Figure 4 and Profile D). A weighted line survey indicated that this pipeline is not exposed or suspended in the water column through this channel.

c. 8" Promix (Wanda) Pipeline

Earlier conversations with Mr. Joel Kohler of Promix indicated that the 8" pipeline had not been active for many years. Mr. Kohler indicated that Promix had done no maintenance on this pipeline and that its existence may be in question due to long-term degradation and neglect. As a consequence, no engineering or construction drawings were provided to CPE for the Promix 8" pipeline.

Based on the remaining signage within Scofield Pass, the Promix line appeared to have been located within the same right-of-way, but south of the TGP 20" pipeline. The marine magnetometer survey resulted in multiple magnetic anomalies (M10 – M13) along the expected pipeline corridor, parallel and southwest of the TGP 20" pipeline (Figure 3 and Table 1).

Since the Promix line shares the same right-of-way as the TGP 20" line, the Scofield Pass bathymetric survey results were the same, with a 260-foot wide channel thalweg that was greater than -8 feet NAVD '88 in depth and with a maximum depth of -9.8 feet NAVD '88 (Figure 4 and Profile D). A weighted line survey indicated that this pipeline is not exposed or suspended in the water column through this channel.

IV. Recommendations

Based on the above results, it is recommended that a detailed bathymetric survey be conducted within Scofield Pass prior to construction to verify exact water depths. The data collected during this work suggests that the pipelines are buried deeper than -9.8 feet NAVD '88. A detailed, preconstruction bathymetric survey will provide precise channel access depths to the Contractor. If future hydrographic survey data indicate the need for excavation of Scofield Pass, then CPE recommends that, due to the uncertainty of the elevation of the TGP 20" and Promix 8" pipelines, any dredging be limited to -9.8 feet NAVD '88 and be restricted to the existing channel as defined in this survey. Offshore (south) of Scofield Pass may require excavation as some shoaling (<-7.6 feet NAVD '88) is evident (Profile E). This area is south of the pipeline corridors and can be excavated without danger to existing pipeline infrastructure.

Appendix 1
Field Work Synopsis

Appendix 1

Field Work Synopsis

Monday, July 18, 2005

At 8:00 AM the CPE geotechnical crew departed Boca Raton, Florida for Empire, LA. They arrived in New Orleans, LA at 10:00 PM and rendezvoused with two other members of the CPE geotechnical crew.

Tuesday, July 19, 2005

The CPE geotechnical crew departed New Orleans at 7:00 AM for Empire, LA. They arrived at the Empire Inn at 9:30 AM and started mobilizing the *Whiskey Pass*. Part of the survey crew departed the marina at 11:00 AM and proceeded to an existing monument near Empire Pass to begin setting up navigation and elevation control for the survey. A reconnaissance of the Empire Pass monument was conducted to confirm that the survey control was in place and undisturbed. An RTK GPS base station was used to locate and confirm the survey control at Empire Pass. Once the survey control was in place at Empire Pass, the geotechnical crew traveled to Scofield Island where they setup an RTK GPS base station and survey control point for this specific survey. Once this point was established, the RTK GPS crew returned to Empire Pass to ensure the accuracy of the new Scofield Island survey control point, and made way to the marina at 7:00 PM. The other members of the survey crew remained in Empire to calibrate the magnetometer and continue mobilization activities. The crew in Empire completed the mobilization activities and calibration of the magnetometer and met with the other crew at the marina at 7:30 PM.

Wednesday, July 20, 2005

The CPE geotechnical crew departed the marina at 7:00 AM. They arrived on site at 8:30 AM and began to set up the magnetometer and RTK GPS base station. The geotechnical crew then traveled by boat to an existing pipeline valve platform that services both the Tennessee Gas Pipeline (TGP) 26" and 20" pipelines. Earlier research of pipeline engineering plans provided an estimated azimuth for each pipeline. A RTK GPS position was taken on the platform to provide a base point to duplicate this azimuth on the island, resulting in an expected pipeline corridor. The first pipeline survey targeted the TGP 26" gas pipeline. The magnetometer was carried over the expected pipeline corridor in repeated, perpendicular passes. Several of these passes revealed magnetic anomalies which were subsequently marked with survey witness posts. Once the magnetic anomalies and the expected pipeline azimuth were marked, several jet probes were conducted in an attempt to determine the depth to the top of the pipeline. After several unsuccessful attempts, a jet probe conducted at the water's edge, at an elevation of approximately 2.5 feet, successfully located the top of the pipeline at approximately 17 feet beneath the seafloor. A second jet probe was conducted within Scofield Pass in approximately 3 feet of water locating the top of the pipeline at approximately 20 feet

beneath the seafloor. Shortly after completing this jet probe, the survey crew headed back to the marina, arriving at the 7:30 PM.

Thursday, July 21, 2005

The CPE geotechnical crew departed the marina at 7:00 AM. They arrived on site at 7:30 AM and began setting up the magnetometer and the RTK GPS base station. The second pipeline survey targeted the TGP 20" gas pipeline. Several moderate anomalies were detected as the magnetometer passed within the expected pipeline corridor. These anomalies were marked with survey witness posts. Once the magnetic anomalies and the expected pipeline azimuth were marked, multiple jet probes were conducted along the eastern shoreline of Scofield Pass. These jet probes were collected across the expected pipeline corridor in an attempt to determine the depth to the top of the pipeline. None of these jet probe attempts resulted in the location of the pipeline. The CPE geotechnical crew returned to the marina at 7:15 PM.

Friday, July 22, 2005

The CPE geotechnical crew departed the marina at 7:00 AM. They arrived on site at 7:30 AM and began setting up the magnetometer and the RTK GPS base station. Once setup was completed, a bathymetric survey utilizing manual survey rod water depth readings and DGPS was collected from the *Whiskey Pass* along the expected pipeline corridor for the TGP 26" line. Upon completion of the bathymetric survey two CPE members, both certified scientific divers, commenced a 7 minute dive in 17 feet of water to determine if the pipeline was exposed within the water column. After this dive the geotechnical crew received word that diving may not be covered under the contract and no further diving was attempted.

The geotechnical crew then revisited the TGP 20" gas pipeline corridor where further magnetometer operations were undertaken. Several additional moderate anomalies were detected as the magnetometer passed within the expected pipeline corridor. These anomalies were marked with survey witness posts. Once the magnetic anomalies and the expected pipeline azimuth were marked, multiple jet probes were conducted perpendicular to the expected pipeline corridor in an attempt to determine the depth to the top of the pipeline. None of these jet probe attempts resulted in the location of the pipeline.

After the unsuccessful jet probe attempts, the geotechnical crew began a bathymetric survey utilizing direct rod depth measurements and DGPS collected from the *Whiskey Pass* along the expected pipeline corridor for the TGP 20" line. The CPE geotechnical crew returned to the marina at 6:00 PM.

Saturday, July 23, 2005

The CPE geotechnical crew departed the marina at 7:30 AM. Once onsite, the crew setup the RTK GPS and magnetometer. Once this was finished, the crew began a bathymetric

survey utilizing manual survey rod water depth readings and DGPS collected from the *Whiskey Pass* along three intermediate crossing (E-W) lines, two small lines behind Pelican Island, and one line along the main Scofield Pass channel.

Upon completion of the bathymetric survey, the *Whiskey Pass* was mobilized for a marine magnetometer survey. This survey towed the magnetometer behind the boat along the main Scofield Pass channel, crossing the expected pipeline corridors. Magnetic anomalies along all three pipeline corridors were evident. The magnetic anomalies corresponding to the TGP 20" line were recorded using RTK GPS. The azimuth for these magnetic anomalies was extrapolated to the shallow, western edge of the Scofield Pass channel where jet probes were attempted. None of these jet probe attempts resulted in the location of the pipeline.

The geotechnical crew completed jet probe operations and began dragging the main Scofield Pass channel with two weighted lines. The purpose of this weight survey was to verify that no pipeline was exposed within the water column along the main channel. After completion of the weight survey the geotechnical crew demobilized from the island, packed all gear, and returned to the marina at 6:00 PM.


Sunday, July 24, 2005

The CPE geotechnical crew departed Empire, LA at 4:15 AM, arriving in Boca Raton, FL at 10:00 PM

Appendix 2


**Tennessee Gas Pipeline Company
Completion Drawings:
TO-F2-526A-100-3
TO-F2-527A-100-5
TO-F2-527A-100-5A**

TERRAIN	Marsh	Sandy Beach	Water
PROTECTION EASEMENT OWNERSHIP & LINE LIST NO.			
TAX DISTRICT DATA	DARISH WARD LEVEE WATER WORKS WATER	44-5357 F1 PL-5611	Plaquemines - 26,402 F1 W 9 - 23,045 F1 Bureas Basin - 24,402 F1 Bureas - 26,402 F1 Empire - 24,402 F1
OWNERSHIP & LINE LIST NO. L.A. COAST.	Plaquemines Parish Police Jury, et al (Buras Levee District) 599	73-L2-T600-10-146	73-L2-T600-10-146

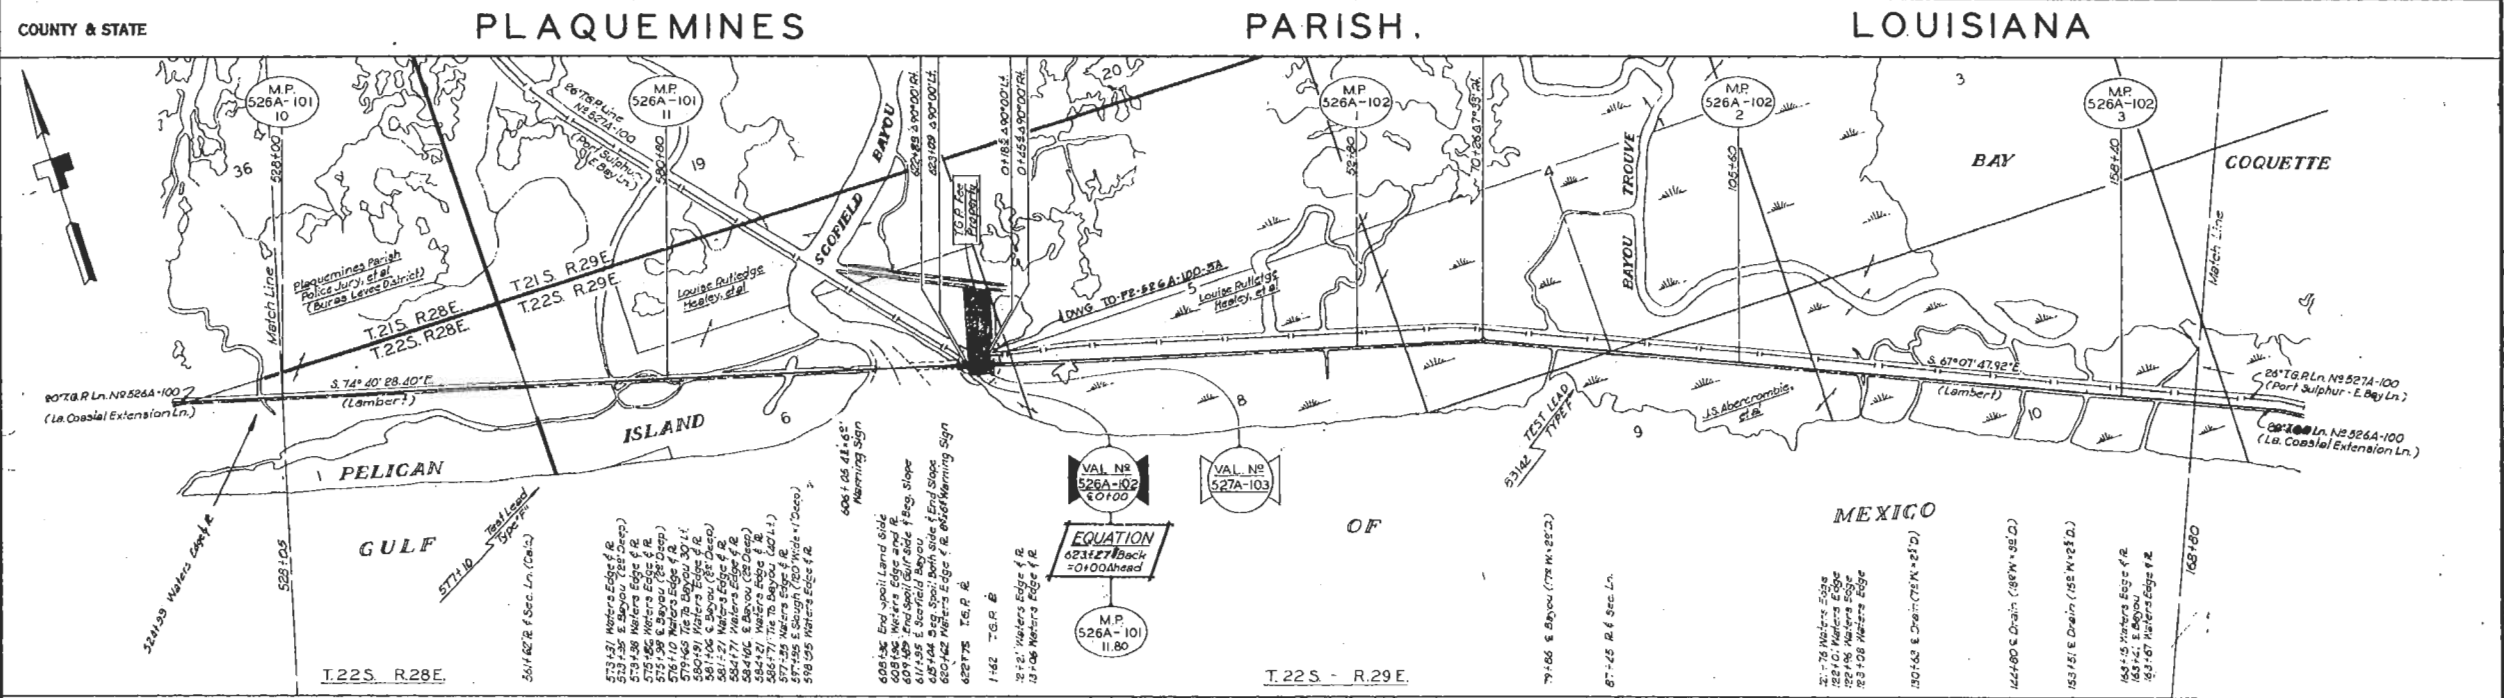

BENDS	FLOTATION DITCH
-------	-----------------

MATERIAL	DETAIL 1 T0-F2-526A-100-3A1 & 3A2
REVISION HISTORY	WARNING SIGN C.O. #5914

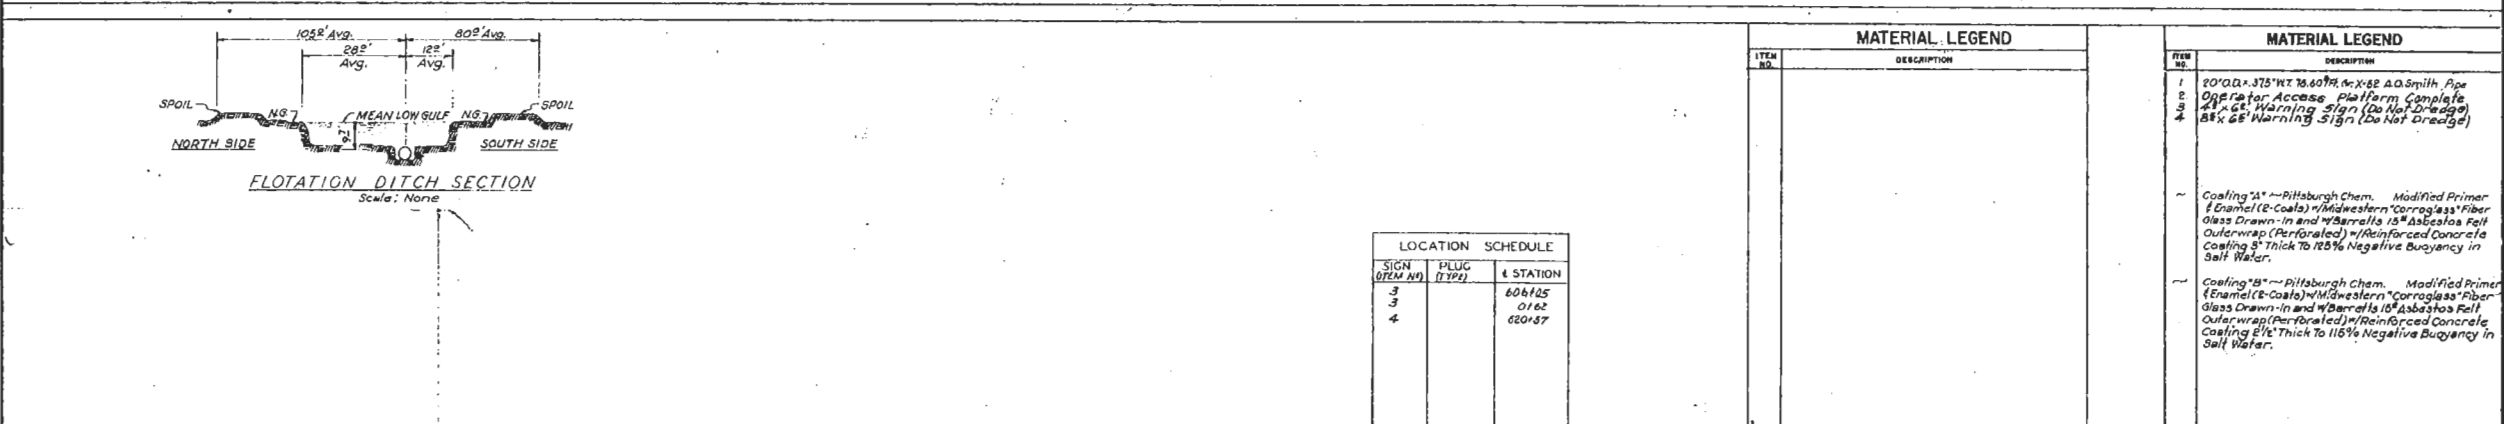

THIS DWG CURRENT THRU
















SCALE: 1" = 100'

ISSUE DATES: ORIGINAL 6-1-97, LAST 6-98

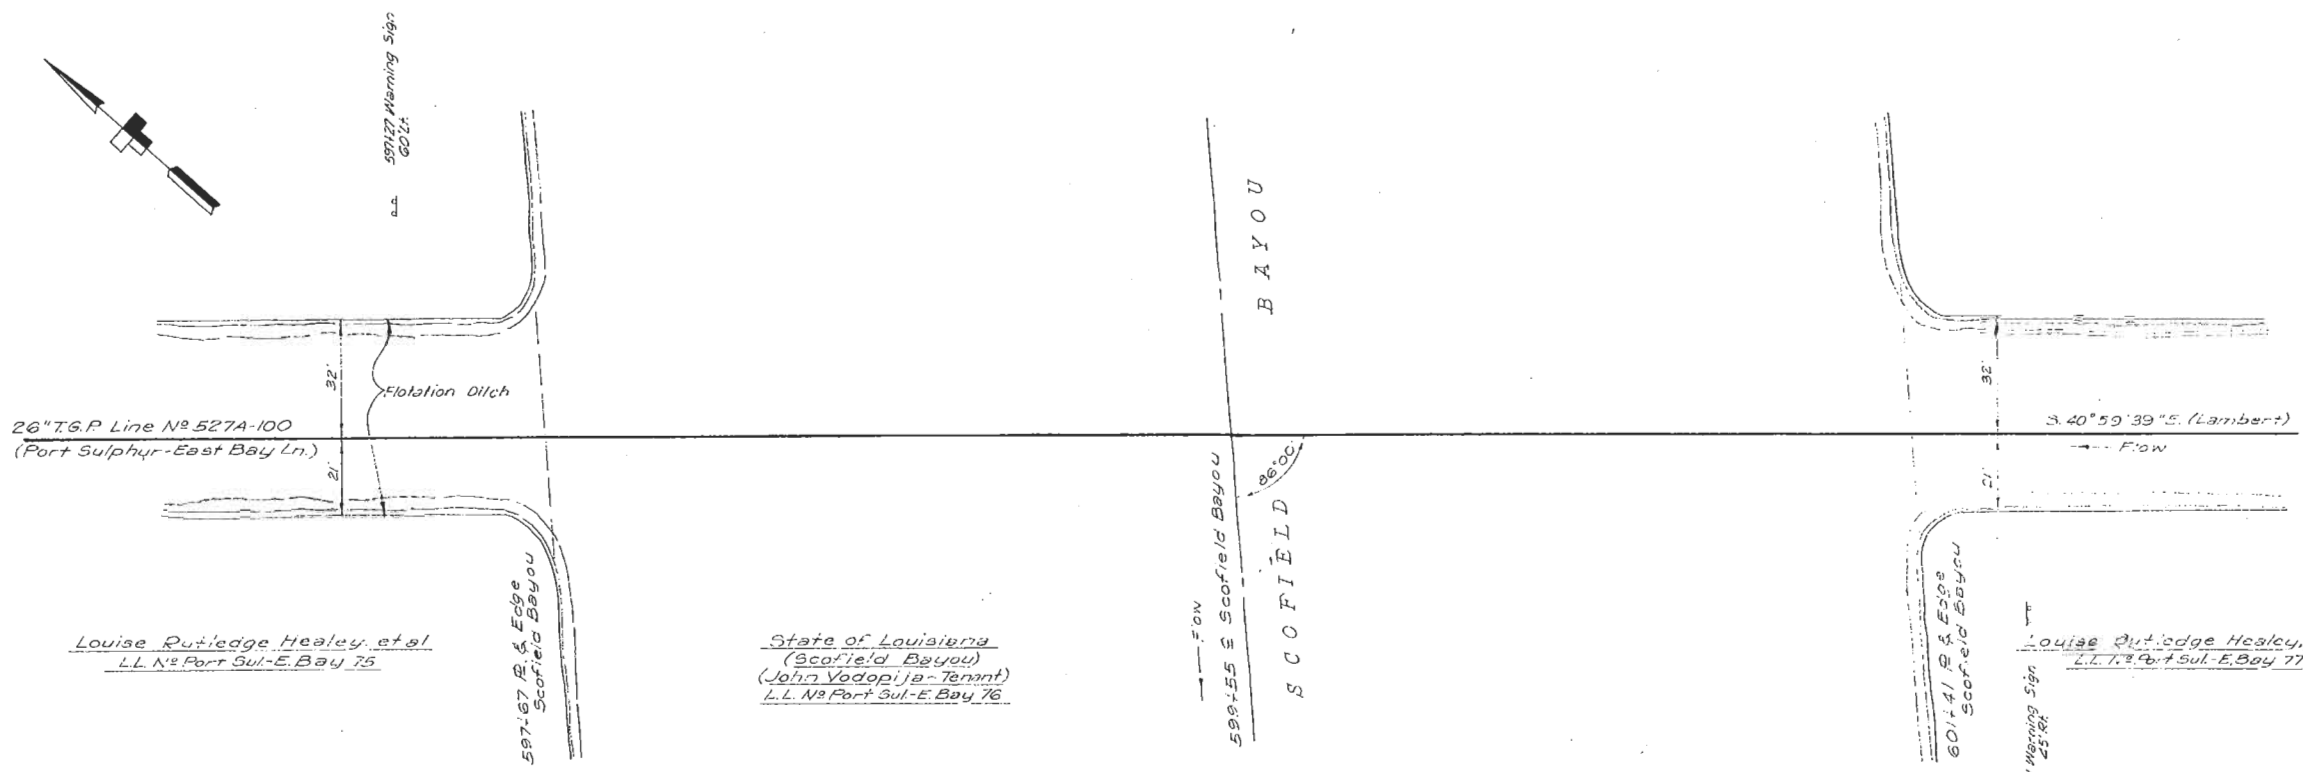


NOTE:
 Staff Gage Under Val. Platform 527A-104.
 Established From Data Taken From U.S.C. & G.S.
 Staff Gage Located At Head of Passes Set
 on M.S.L. & Converted 10.78' To M.L.G.
 Tide Elevation = 1.26 Ft. M.L.G.

State of Louisiana
 (Scofield Bayou)
 (John Vodopija - Tenant)
 L.L. No. Port Sul-E. Bay 76

Louise Rutledge Healey, et al
 L.L. No. Port Sul-E. Bay 77

T22S-R29E
 SECTION 6
 PLAN
 SCALE 1"=20'

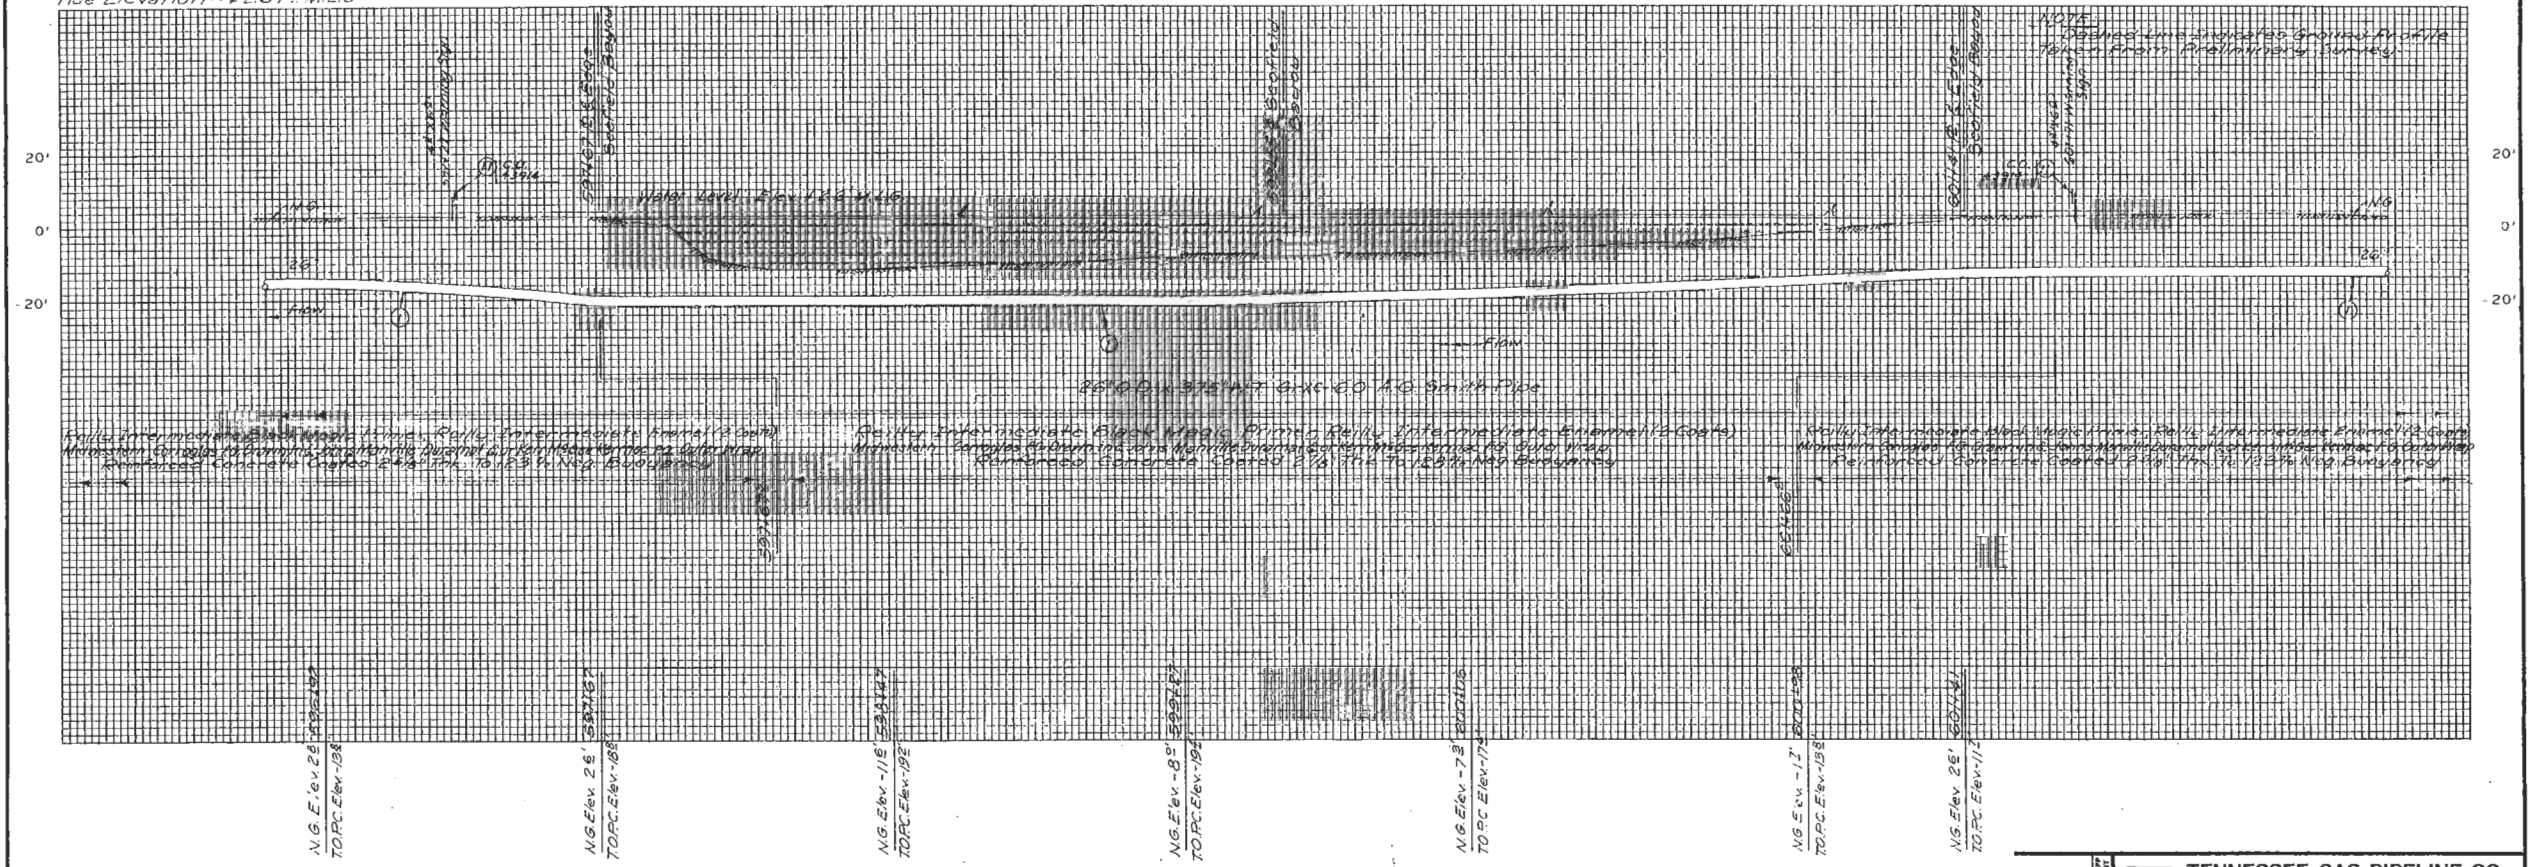

THIS DWG CURRENT THRU	3-30-76
C.O. NUMBERS & DESCRIPTION	See DWG T0-F2-527A-100-5
PRELIM.	22% 12/80
CONSTR.	22% 12/80
FINAL	22% 12/80
ENGINEERS	See DWG T0-F2-527A-100-5
INCHES	See DWG T0-F2-527A-100-5

PROFILE
 SCALE: HORIZONTAL 1"=20'
 SCALE: VERTICAL 1"=20'
 Permit Drawing N^o 13 TS-N2-F527A-100-4
 T8-N2-F527A-100-4E

REFERENCE DRAWING
 Alignment & Material- T0-F2-527A-100-5

TENNESSEE GAS PIPELINE CO. A DIVISION OF TENNESSEE GAS TRANSMISSION CO. ENGINEERING DEPARTMENT HOUSTON, TEXAS PORT SULPHUR-EAST BAY LINE LINE NO. 527A-100 SCOFIELD BAYOU CROSSING PLAQUEMINES PARISH, LOUISIANA		VALVE SECTION BETWEEN VAL. NO. 527A-102 & 527A-103 DRAWN BY: <i>PAINE</i> DATE: 7-8-60 CHECKED BY: <i>PAINE</i> DATE: 11-8-60 CORRECTED BY: <i>PAINE</i> DATE: 2-6-66 APPROVED BY: <i>PAINE</i> DATE: 6-15-66
		COMPLETION DRAWING ISSUE DATES ORIGINAL 8-30-60 LAST 9-79

Appendix 3

Field Notes

Pelican Island Pipeline Survey

7/18/05

KW / BS / JS / GW

08:00 ^{ET} JS / GW depart CPE office in Boca
in route to New Orleans

12:30 ^{ET} BS Arrive @ New Orleans Int. Airport

13:03 ^{ET} KW Arrives @ New Orleans Int. Airport

14:00 - KW / BS pick up supplies for job
@ Home depot / Wal-Mart.

19:00 - KW / BS meet w/ T.C. / E.H. / V.B. / G.T. for
dinner w/ Gregg & Beau of the LACNR.

22:30 - Arrive @ Hotel in New Orleans & meet
JS / GW

7/17/05

07:00 ^{ET} - Depart Hotel to pick off Rental Car

07:30 - Drop off Rental Car

08:15 - Stop in Belle Chase for groceries

09:15 - Depart with Dixie in route to
Empire.

10:30 Arrive @ Empire Inn and meet Sam from LACNR.
Begin Moving Equipment and Brief everyone on
the job

13:00 Put boat in water @ Joshua's Marina in Breaux
& KW / GW head out to Empire Teth, &
Sam, BS / JS working on Mag Setup.

14:15 Arrive @ Teth, to set up ~~the~~ RTK on "Seafeld"

15:05 Depart Base for Seafeld Pass. Turn around, lost
radio @ 3200 feet.

15:20 Go back to check Base. Put radio higher up.

16:05 Stop @ Platform "A" Set "Bot Point" Plot Base

18:00 Arrive @ Seafeld Pass & set FB/C "Pelican
Base" & surveyed the area visually

- 18:40 Arrive @ Empire to Break down Base Took
Shot on Rock for Reference.
- 19:00 Depart Empire Jetty
- 19:30 Arrive @ dock @ Joshua's Marina.
- 20:10 Arrive @ Empire Inn.

7/20/05

- 06:30 - Begin to mob trailer & Boat @ Empire Inn
- 07:00 - Depart Empire Inn for Joshua's Marina.
- 07:15 - Arrive @ Marina & mob boat
- 08:00 - Leave Marina
- 08:45 - Arrive @ Scotfield Pass & Dermob
- 09:45 - Start Base station on "Pelican Base"
Ku/BW Stake out Point station.
BS/JS Set up Map
- 10:45 - Shot Point @ Point station "Point station" for
Stakeout
- 11:30 - Check into Point @ Empire H: 0.079sft
V: 0.046sft
- 11:50 - Ku/BW Return to Scotfield Pass. JS &
BS have Identified 2 targets in line assumed
to be Pipeline.
- 12:30 - Begin Jetting to End Pipeline. (^{landward} ~~shoreward~~)
- 13:30 - Check into Point @ Shell Island H: 0.423
PICTURES TAKEN V: 0.334
- 17:00 - First fact on Landward Pipeline located
w/ set Probe "Landward Point 1"
- 17:40 - 2nd Point located on Landward
Pipeline w/ set Probe "Landward Point 2"
- 18:45 - Depart Scotfield Pass
- 19:30 - Arrive @ Dock & Dermob
- 20:10 - EOD

DATE 7/19/65

TKW	PELICAN	ISLAND	PIPE	NAVD 89		
# GW	PIPE 1					
STA	DEPTH DIST	+	HI	-	ELEV	REMARK FOUND
		4.35	7.35	4.35	3.003	HUB LANDWARD
				4.08	3.27	SS HUB
	16.40			7.04	0.31	TOP OF HOLE 17:00
				4.35	3.00	HUB LANDWARD
		4.87	6.14		3.27	SS HUB
				5.14	3.00	HUB LANDWARD
	20.25	9.22 ✓		9.22 ✓		
	20.25			9.34	-1.2	TOP OF HOLE 17:40
				5.14	3.00	HUB LANDWARD
		4.31	7.58		3.27	SS HUB
				4.58	3.00	HUB LANDWARD
		9.45 ✓		9.45 ✓		
	PIPE 2					
STA	DEPTH	+	HI	-	ELEV	REMARK FOUND
						TOP OF HOLE 12:15

$$\begin{array}{r} 4.35 \\ 5.14 \\ \hline 9.89 \end{array}$$

$$\begin{array}{r} 4.35 \\ 4.87 \\ \hline 9.22 \end{array}$$

$$\begin{array}{r} 4.35 \\ 5.14 \\ \hline 9 \end{array}$$

$$\begin{array}{r} 4.87 \\ 4.35 \\ \hline 9.22 \end{array}$$

$$\begin{array}{r} 4.08 \\ 5.14 \\ \hline 9.22 \end{array}$$

$$4.08$$

$$4.87$$

$$5.14$$

$$4.58$$

$$4.31$$

$$9.45 \checkmark$$

$$9.45 \checkmark$$

PELICAN ISLAND PIPELINE SURVEY

KW/JS/BS/GW

07/21/05

- 06:30 - Mob @ Empire Inn
- 07:00 - Depart Empire Inn.
- 07:30 - Arrive @ Scotfield Pass & Setup
- 08:30 - Set up RTK & Check into Extra Scotfield Point
H: 0.036' "EX CHK SOD 07265"
V: 0.011'
- 09:30 - Check into Empire "Scotfield" Point
H: 0.035' "SCO CHK SOD 072105"
V: 0.009'
- 10:00 KW/JS/BS using Mag to find Pipeline
Detect Anomaly in 2 spots
- 11:00 Set up for JetProbes.
- 12:19 SET HUB ONLINE FOR PIPE2 HUB CALLED "MOUTH HUB PIPE2"
ELEVATION: 4.005 AT NAVD88
- 11:15 JetProbe to 20 Feet 3 times on
either side of Mag Anomaly. Never
found Pipeline @ that location
- 14:00 Restart Mag efforts further seaward and
mark two additional targets - Mag Target 3
- Mag Target 4
- 15:00 Begin JetProbing of Mag Target 4.
@ 20 JetProbes performed in vicinity w/
out successfully detecting pipe
- 17:45 End JetProbing and begin demob
- 18:30 Head for Maring
- 19:15 Arrive @ Maring

KW/05/BS/GW

07/22/05

- 05:30 Mob @ Emile Inn
06:00 Depart Emile Inn
06:30 Arrive @ Marina & Begin Mob Process
07:00 Leave Dock
07:40 Arrive @ Island & Set up RTK
08:00 Set up the carbonate posts to lie up
the azimuth of the landward Pipeline 26"
08:10 SET UP BASE STATION ON "PELICAN BASS"
CHECKED IN ON "ex chK eod 072005" IR/C
POINT STORED AS "ex chK sod 072205"
H: 0049
V: 0.018
09:10 - Pulled across in let for depth measurements
09:30 Leave Shore w/ divers
09:40 Divers in the water for 7 mins to
verify No Pipeline
10:00 Back on shore
10:30 Start Mag operations on 20' shore Parallel
Pipe. Found 2 additional Anomalies
Mag Target 5 / Mag Target 6
11:30 Begin Jettprobe operations Punched 12
holes No Pipe.
12:30 Set up for Bathymetric Survey
13:00 - Strong Rain storm for 4/5 miles
14:15 - Reset for Bathymetric Survey
15:20 - "DGPS SOD" CHK SOD 072205"
16:30 - Start Bathymetric Survey
17:45 - Finish Bathymetric Survey
18:00 - Shoot in tide station & Demob Beach
18:25 - En route to Marina
19:00 - Arrive @ Joshua's Marina

DATE 7/22/05

~~Base OK~~ - faint near base @ Empire Ditch, to make
sure RTK was relatively close to

Bathy Survey Rod & Target Survey
KN/GW 7/22/05

STA	DEPTH	+	HT	-	clm	
		4.48	8.49		4.005	mouth hub
				3.84	4.65	ss stump
				5.16	3.33	ss Tide Stand
				4.48	4.01	Hub (OK) Mouth Hub
				5.17	3.32	ss Tide Stand (check)
				4.49	4.00	Hub OK (Mouth Hub)
		2.92	7.57		4.65	ss Stump
				3.56	4.01	ss Mouth Hub
						Reset Tide Station

7.30 ✓

7.30 ✓


PS	Tide	Shots	
Time	Reading	Tide	in Ft NAVD 88
15:17	1.15	1.53	
15:28	1.13	1.43	Elevation @ Top of Corrosion
15:31	1.10	1.43	Post = 3.33 NAVD 88
15:37	0.99	1.33	Ft.

Reset Tide stand

16:11	2.45	1.13	Elevation @ Top of
16:16	2.41	1.09	Corrosion Post = 1.68 NAVD 88
16:23	2.46	1.14	Ft.
16:27	2.31	0.99	
16:33	2.26	0.94	
16:47	2.18	0.86	

Tide Stand Setup

7/22/05

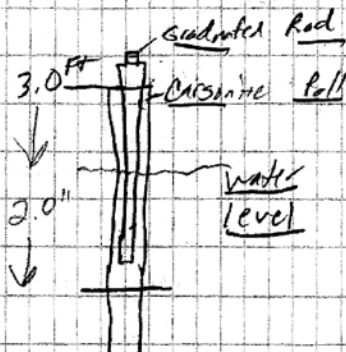

- Reading for tideshot is off the graduated Rod attached to the Carsonite.

- Tide stand shot was taken @ top of carsonite "3.0"

(KW)

Elevation @ Top of Carsonite
Witness Post = 3.33 NAVD83
Ft.

FW/JS/GW Bathymetry Survey Pelican Island 7/22/05

Target	Poll depth					
16:22:17	7.7	16:29.26	6.2		34.31	9.9
16:22:27	8.1	16:29.33	6.3		34.38	9.7
16:22:38	9.0	16:29.38	5.8		34.47	10.2
16:22:46	7.2	16:29.45	6.4		34.55	10.3
16:22:57	9.5	16:29.51	7.5		35.04	10.4
16:23:09	9.6	29.57	8.2		35.12	11.1
16:23:21	9.9	30.03	8.4		35.19	10.5
16:23:31	9.9	30.11	8.9		35.27	10.6
16:23:44	10.0	30.19	9.6		35.36	9.7
16:23:53	10.2	30.27	9.3		35.46	9.0
16:24:02	10.4	30.36	10.1		35.52	9.0
16:24:12	10.5	30.44	10.8		35.59	9.3
16:24:20	10.4	30.52	10.8		36.04	8.3
16:24:31	10.0	31.02	10.3		36.13	8.3
16:24:41	9.3	31.11	10.4		36.19	8.1
16:24:50	8.9	31.20	10.4		36.25	7.4
16:24:59	9.0	31.29	9.8		36.31	7.4
16:25:10	8.3	31.39	9.6		36.37	5.8
16:25:20	8.3	31.47	8.8	1.1	36.43	5.5
16:25:36	8.4	31.56	8.1		36.48	5.3
16:25:41	8.6	32.05	8.7		36.52	5.3
16:25:53	6.4	32.14	7.0			
16:26:02	5.7	32.59	5.2		37.05	6.2
16:26:10	5.7	32.24	3.8		37.13	4.9
16:26:18	5.6				37.17	4.8
16:26:26	5.3	33.37	5.1		37.23	4.3
16:26:38	6.3	33.43	7.1		37.26	4.0 0.99
16:26:47	4.4	33.48	8.1		37.31	2.6
16:26:51	3.7	33.54	7.8			
16:27:03	3.3	34.01	8.6			
16:27:08	2.9	34.08	9.1			
16:27:13	2.6	34.16	9.6			
		34.23	10.3			

20 m Pelican Survey shore Parallel

26" Inshore Pipeline

Time	Pull depth	Time	Pull depth	Time	Pull depth
12.51	9.0	29.58	5.5	17.38.20	5.1
20.03	5.3	30.05	6.5	38.27	5.1
20.09	5.1	30.12	7.1	38.33	5.4
20.17	5.4	30.21	7.9	38.38	5.8
20.22	5.9	30.30	8.9	38.43	6.2
20.27	6.3	30.39	9.7	38.51	6.4
20.33	7.2	30.49	11.6	38.57	6.8
20.39	7.7	31.00	12.4	39.02	6.9
20.47	8.7	31.09	13.1	39.08	7.5
20.54	9.2	31.19	13.8	39.14	7.9
21.01	10.7	31.31	15.6	39.21	8.8
21.10	12.4	31.44	22.0	—	9.6
21.19	13.4	31.58	22.5	39.35	10.5
21.30	14.7	32.08	24.38	39.45	12.5
21.40	17.0	32.21	22.5	39.54	13.7
21.54	24.0	32.35	22.5	40.03	15.5
22.18	18.4	32.46	17.4	40.16	22.1
22.33	17.9	33.00	17.4	40.28	24.8 2.2
22.45	20.2	33.13	16.9	40.47	22.0
22.59	23.6	33.26	18.3	41.03	20.8
23.11	16.8	33.39	16.8	41.19	25.0
23.22	17.6	33.55	16.4	2.26 41.33	16.3
23.34	16.9	34.06	11.3	41.46	16.9
23.45	19.1	2.46 34.15	9.2	42.00	15.9
23.57	16.2	34.24	8.8	42.12	17.9
24.09	17.8	34.33	8.9	42.27	19.4
24.21	13.8	34.42	9.8	42.40	15.5
24.25	13.3	34.51	10.3	42.54	13.5
24.55	10.0	35.02	4.5	43.05	9.2
25.09	11.5	35.15	2.52 2.52	43.13	9.2
25.23	10.7			43.20	9.8
25.37	4.5			43.27	8.8

-40 Ft from
Shore

CONTINUE

RW/GW

7/22/05

Reset Tide Station

STA	DEPTH	+	HI	-	ELEV		Elev
		4.16	8.17		4.005	MOUTH HUB	
				3.52	SS STUMP		4.65
				6.48	SS TIDE STAND		1.69
				6.49	SS Tide Stand		1.68
				4.17	Mouth Hub		4.00
		4.56	9.21		SS STUMP		4.65
				5.49	Mouth Hub		4.02
		8.72		8.71			

Continued

43.35 10.2

43.32 10.8

43.52 8.7

44.08 2.0

Pelican Island Pipeline Survey

7/23/05

06:30	MoB @ Empire Inn
07:00	Depart Empire Inn
07:15	Arrive @ Joshua's Marina
07:35	Depart Marina in route to Scottfield Pass
08:10	Arrive @ Scottfield Pass & set up RTK
	Check & OK H: 0.046
	V: -0.004
08:30	Set range marks for points
	& set up tide stand
09:30	Rain Stop
10:30	Start Bathymetry Survey OK w/ RTK for DGPs
11:30	End Bathymetry Survey & MoB Mag for Boat
	tow
12:15	Start Mag tow lines. Mag layback 70 Feet
13:15	End Mag tow lines Aft.
	GPS OK w/ RTK "DGPS OK OK EOD 0723
14:15	Begin sidescanning of Targeted Area
15:45	End sidescanning & Begin to demob beach
16:00	Check into "Fox Creek" H:
	V:
16:15	- Drag the center channel for Pipeline
	Nothing Found.
16:30	Load Boat
17:00	Depart Scottfield Pass
18:10	Arrive @ Marina
18:40	Arrive @ Empire Inn

DESCR	SOL	MAG	Survey Lines	Direction	Note
PASS 1	13:14	13:41		out channel	000-1314 Row
PASS 2	13:42	13:50		in channel	000-1342 Row
PASS 3	13:52	13:56		out channel	000-13:52 Row
PASS 4	13:59	14:06		in channel	000-13:57 Row

MAG TARGETS

PASS 1

PASS 2

PASS 3

PASS 4

Larger Mag 4.5

AZ 2-3	110° 14' 48"	110° 14'
AZ 2-4	284° 55' 25"	104° 55' 25"
AZ 2-1	291° 25' 31"	181° 25'
AZ 1-3	110° 42' 43"	110° 42'
AZ 1-4	283° 29' 45"	103° 29'
AZ 3-4	286° 04' 36"	106° 04'

Smaller Mag 4.2

AZ 1-2	104° 53' 11"	110	105
1-3	108° 00' 15"	105	108
1-4	290° 31' 10"	111	111
2-3	110° 56' 34"	111	111
2-4	289° 29' 23"	103	109
3-4	287° 43' 34"	106	110
		110 31.14 646	657
		107	
		109 27.5 646	674
		109 43	


7/23/05		Kw/Gw				
Survey	in.	tide	stand			
STA	Dist	+	H:	-	Elev	Rem
		5.26	8.18		2.92	"Hub lowered"
				4.91	3.27	ss stand
				4.64	3.54	Tide stand
				4.69	3.27	Tide stand CHK
				5.25	2.93	Hub CHK
		3.93	7.20		3.27	ss stand
				4.27	2.93	
		7.19 ✓		9.18 ✓		

Tide					
10:18	1.9		10:34	1.9	
10:20	1.9				
10:25	1.9		10:25	1.2	
10:29	1.9				
10:34	1.9				
10:39	2.0				
10:45	2.0				
10:49	1.9				
10:54	1.9				

Rod

Measured point = 3.54 Ft NAVD 88
Rod @ 3.5

concrete

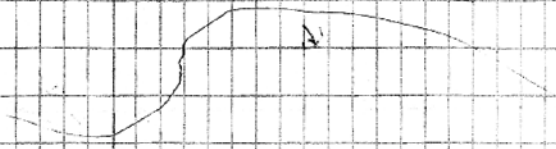

Scotfield	Pass	Throat	Scotfield	Pass	Profile	2
Time	Pass		Time	Pass		
11:19.32	7.2		30:31	2.7	37:18	14.7
11:19.44	8.5		30:38	2.4	37:26	17.5
11:20.14	>20	1.92	30:43	3.0	37:36	18.0
11:20.22	>25		30:49	3.0	37:44	16.1
11:20.36	>25		30:54	3.5	37:54	12.6
11:20.47	>25		30:59	3.5	38:01	10.0
21.01	>25		31:06	7.7	38:07	9.4
21.13	24.2		31:12	8.4	38:14	8.4
21.22	19.5		31:19	8.9	38:21	7.4
21.34	16.0		31:26	9.6	38:28	5.8
21.46	12.7		31:33	11.0	38:35	3.7
21.56	10.9		31:43	14.7	38:41	2.9
22.10	7.9		31:51	3.4		
22.18	6.7		32:02	18.1		
			32:12	16.3		
24.56	5.8		32:23	11.8		
25.03	8.4		32:33	9.7		
25.10	12.8		32:43	8.5		
25.20	19.6		32:50	7.2		
25.33	23.0		32:57	5.7		
25.45	>25	1.93	33:04	3.8		
25.57	>25					
26.08	>25		36:17	2.7		
26.20	23.9		36:23	2.7		
26.32	18.2		36:27	2.7		
26.44	14.8		36:31	3.1		
11:26.56	12.4		36:35	3.3		
27.03	10.7		36:39	7.1		
27.10	8.6		36:48	8.2		
27.17	7.2		36:54	9.0		
27.24	6.7		37:02	9.8		
			37:10	12.1		

Scotfold	Pass	Outside		
44.25	2.9		49.01	3.0
44.34	2.9		49.11	3.5
44.41	2.9		49.19	3.4
44.46	3.1		49.25	3.4
44.56	4.3	2.0	49.31	3.8
44.59	5.6		49.37	3.8
45.04	7.3		49.42	3.9
45.09	7.9		49.47	4.0
45.16	9.1		49.53	4.4
45.23	9.2		49.58	4.5
45.29	9.5		50.04	4.8
45.35	9.5		50.12	5.0
45.42	9.6		50.1	5.3
45.48	9.7		50.23	6.0
45.54	9.4		50.31	7.6
46.01	9.4		50.36	7.5
46.06	9.3		50.43	8.4
46.14	9.4		50.49	8.8
46.19	9.4		50.57	9.2
46.25	8.9		51.04	9.4
46.32	8.5		51.11	9.5
46.39	8.2		51.19	9.4
46.45	7.4		51.27	9.7
46.52	6.6		51.34	9.5
46.57	5.7		51.40	9.5
47.03	5.4		51.47	9.8
47.09	4.8		51.56	9.2
47.15	4.7		52.03	8.9
47.21	4.4		52.10	9.0
47.26	4.1		52.17	8.4
47.35	4.1		52.24	8.2
			52.30	6.9
			52.36	5.5

Scotfield Pass Inlet Profile

Time	Poll						
57:23	8.4		01:13	10:00		06:26	>20
57:33	8.9		01:22	10:3		06:35	>20
57:41	9.1		01:31	10.0		06:44	>20
57:50	8.9		01:39	10.1		06:53	>20
57:58	9.1		01:49	10.4		07:01	>20
58:05	9.1		01:57	11.1		07:12	>20
58:12	9.3		02:05	11.1		07:21	>20
58:20	9.2		02:13	11.4		07:31	>20
58:27	9.6		02:22	10.6		07:41	>20
58:33	9.8		0	10.0		07:54	>20
58:39	9.1		02:39	10.7		08:05	>20
58:45	9.3		02:48	10.1		08:15	>20
58:52	9.6		02:57	10.5		08:25	>20
58:58	9.4		03:06	11.4		08:34	>20
59:04	9.8		03:15	11.6		08:43	>20
59:10	9.3		03:25	12.0		08:54	18.8
59:17	9.4		03:35	12.5		09:05	16.2
59:24	9.4		03:34	12.9		09:16	14.2
59:30	9.5		03:53	13.2		09:25	14.6
59:37	9.6		04:03	14.7		09:34	12.8 193
59:45	9.7		04:14	16.1			
59:52	9.7	1.9	04:24	17.0			
00:00	9.7		04:35	17.4			
00:12	9.6		04:46	18.2			
00:17	9.2		04:55	19.3			
00:22	9.8		05:10	720	1.9		
00:29	9.7		05:19	720			
00:36	9.8		05:29	720			
00:43	9.8		05:38	720			
00:52	9.8		05:47	720			
01:00	9.6		05:57	720			
			06:06	720			
			06:17	>20			

11:12	9.8	16:23	17.4	21.56
11:20	9.4	16:33	15.9	22.05 9.8
11:28	12.3	16:44	15.4	22.14 9.6
11:37	13.6	16:56	14.5	22.25 9.4
11:45	13.7	17:08	13.7	22.34 9.5
11:54	15.6	17:18	13.4	22.24 9.4
12:04	17.8	17:28	12.5	22.53 9.7
12:15	19.4	17:39	12.4	
12:26	> 20	17:50	12.1	
12:35	"	18:01	11.6	
12:44	"	18:11	11.3	
12:53	"	18:22	11.3	
13:01	"	18:32	10.9	
13:09	"	18:42	11.1	
13:17	"	18:52	10.8	
13:26	"	19:01	10.7	
20.	"	19:10	10.4	
13:44	"	19:21	10.5	
13:54	"	19:31	10.7	
14:02	"	19:41	10.6	
14:11	"	19:51	10.6	
14:19	"	20:01	10.1	
14:28	"	20:09	9.9	
14:38	"	20:18	9.7	1.93
14:48	"	20:27	9.6	
14:58	"	20:36	9.7	
15:06	"	20:45	9.7	
15:14	"	20:55	9.6	
15:25	"	21:03	9.8	
15:35	"	21:10	9.8	
15:44	"	21:20	9.5	
15:54	19.1	21:28	9.7	
16:03	18.1	21:37	9.6	
16:13	17.7	21:48	9.2	

Extra Points @ Thru

34.34	7.14	37.47	3.1			
34.44	14.7	37.51	3.1			
34.54	6.5	37.54	3.1			
35.01	6.7	37.59	3.0			
35.08	4.8	38.03	3.0			
35.16	4.0	38.10	2.9			
35.23	3.9	38.15	2.9	1.13		
	3.8					
35.34	3.7					
	3.6	40.00	4.9			
35.45	3.6	40.07	4.5			
35.50	3.7	40.13	5.2			
35.58	3.7	40.20	5.5			
36.06	3.6	40.27	6.0			
36.13	3.5	40.33	6.9			
36.21	3.4	40.40	6.3			
36.27	3.3	40.46	5.8			
36.34	3.4	40.51	5.2			
36.29	3.2	41.00	4.5			
36.35	3.4	41.05	3.9			
36.49	3.2					
	3.2	11.45	1.9			
36.58	3.2					
37.01	3.4					
37.06	3.2					
37.10	3.2					
37.14	3.3					
37.18	3.2					
37.22	3.4					
37.26	3.3					
37.30	3.2					
37.34	3.3					
37.38	3.1					